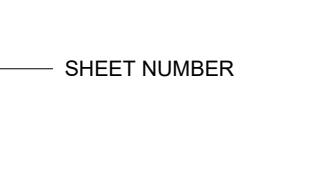
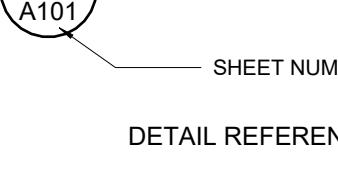
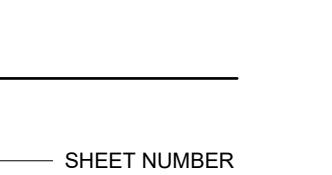
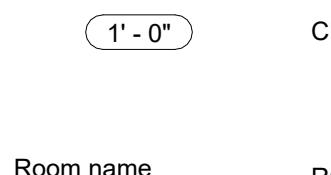
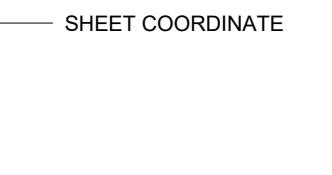
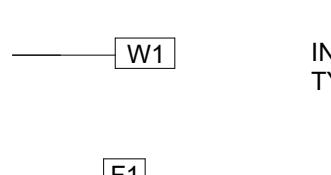
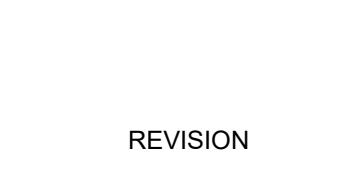
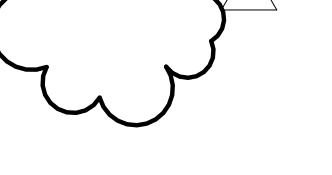
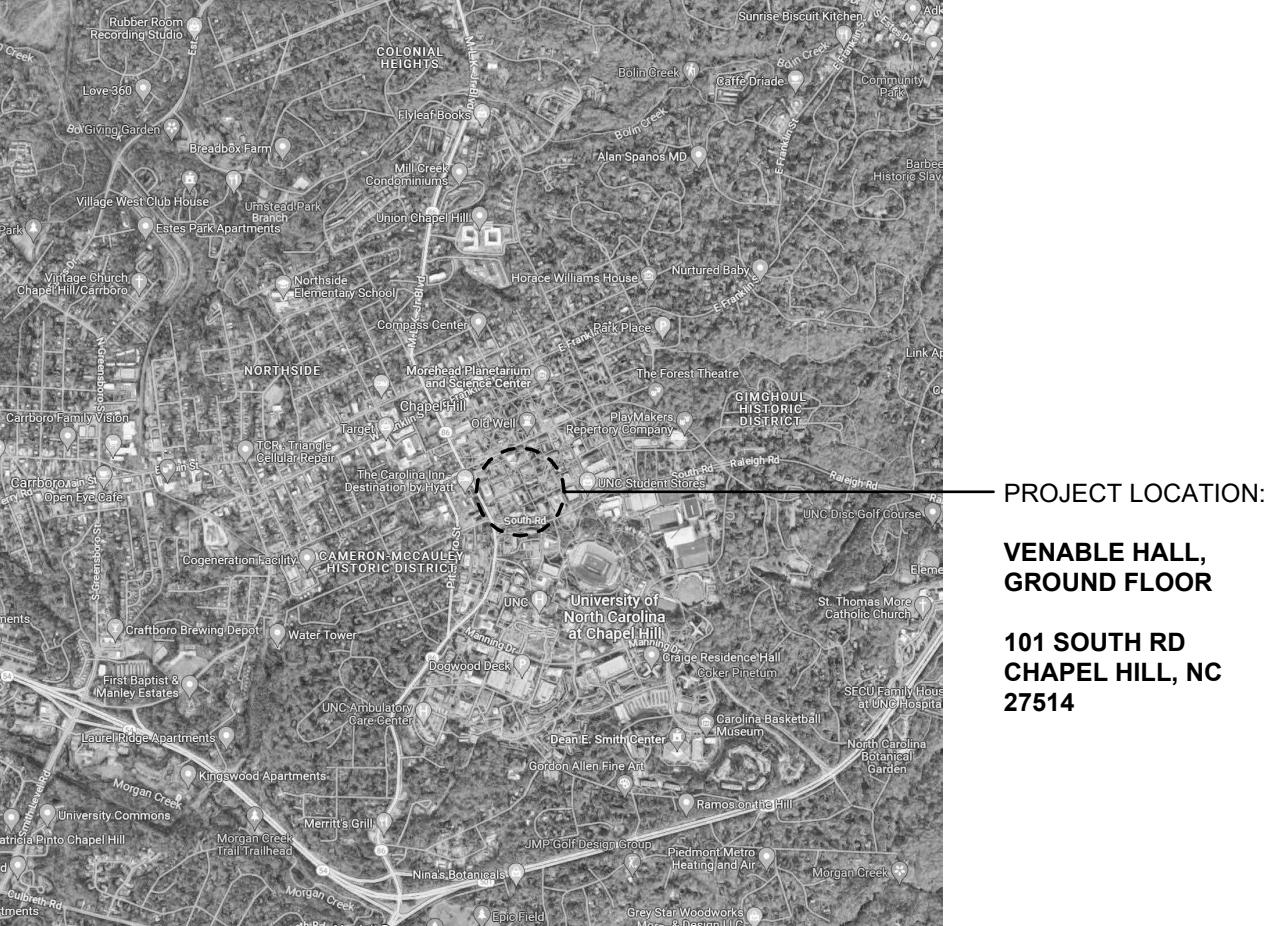
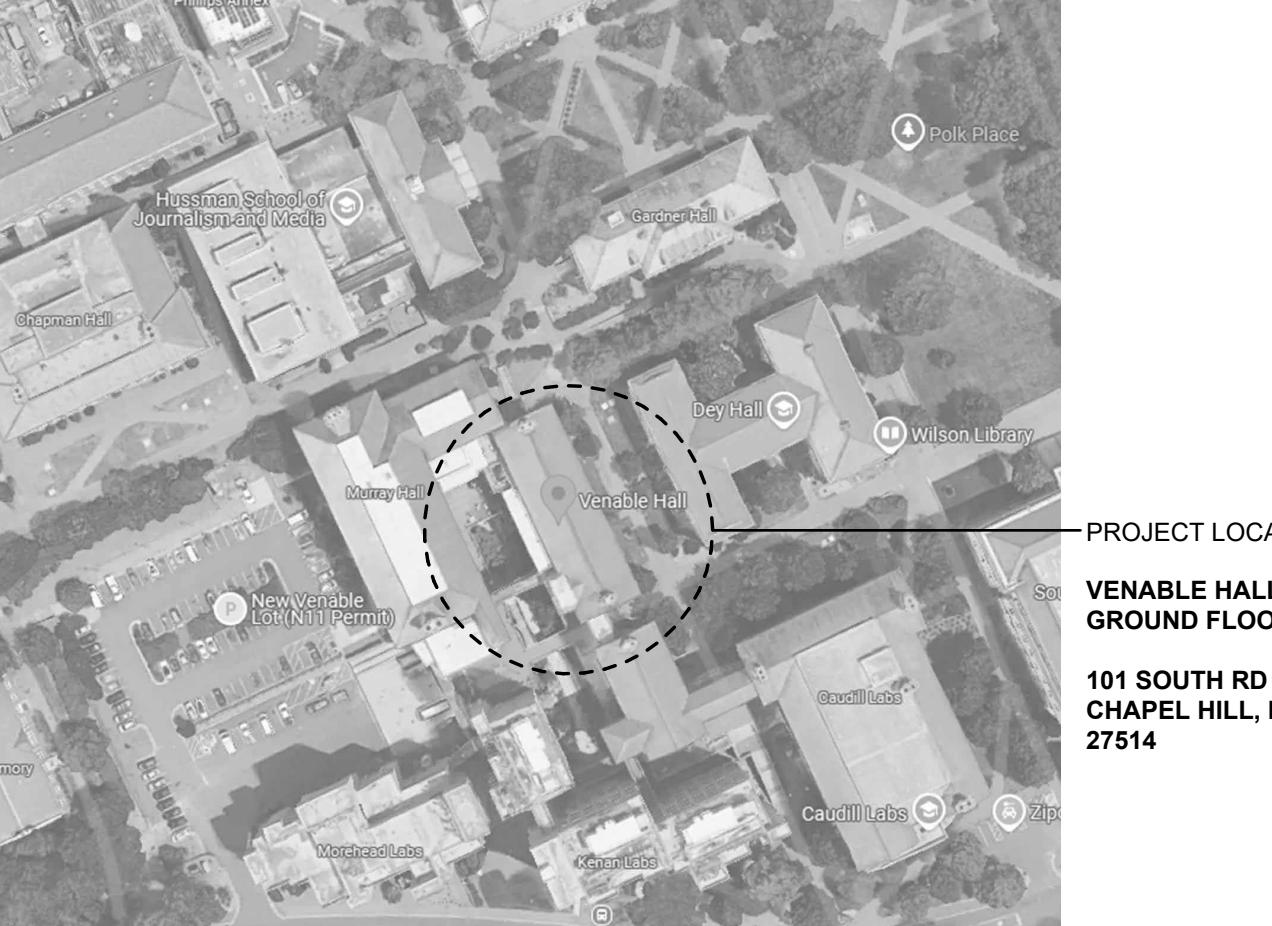
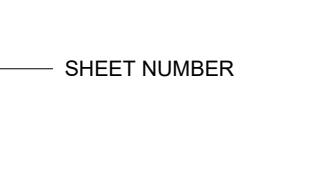
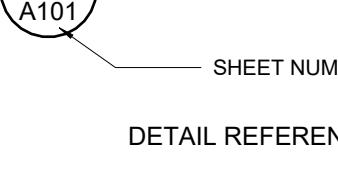
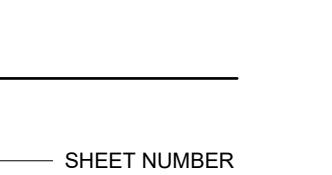
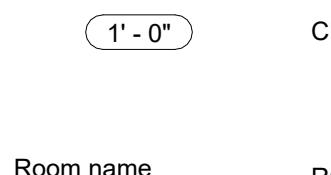
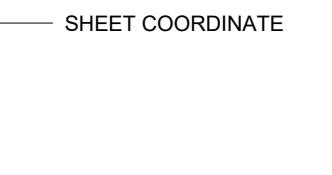
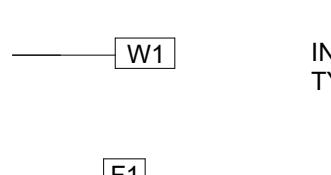
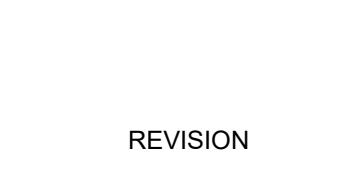
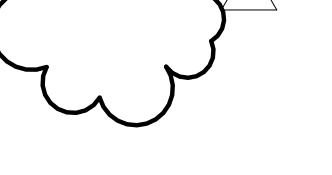
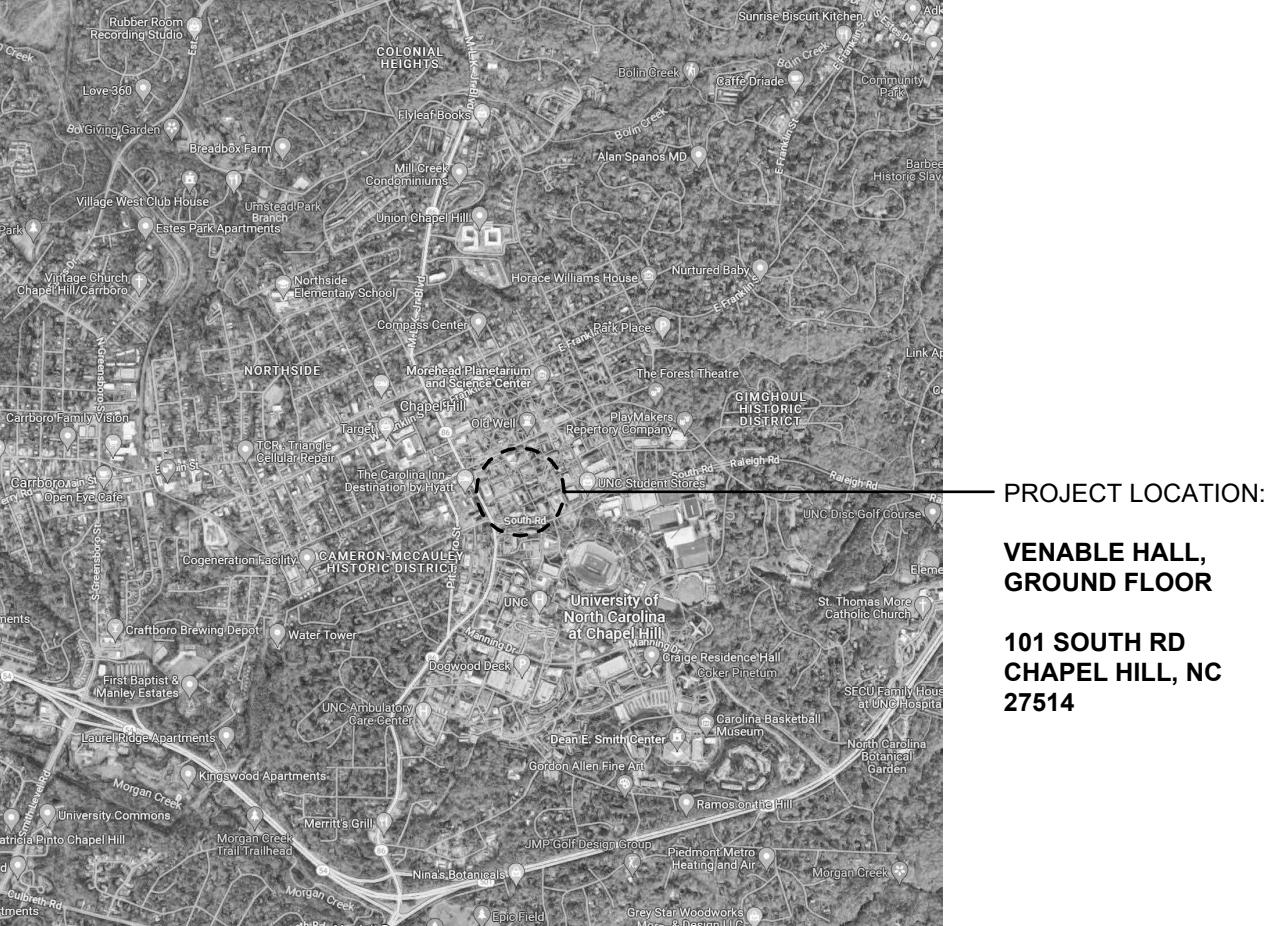
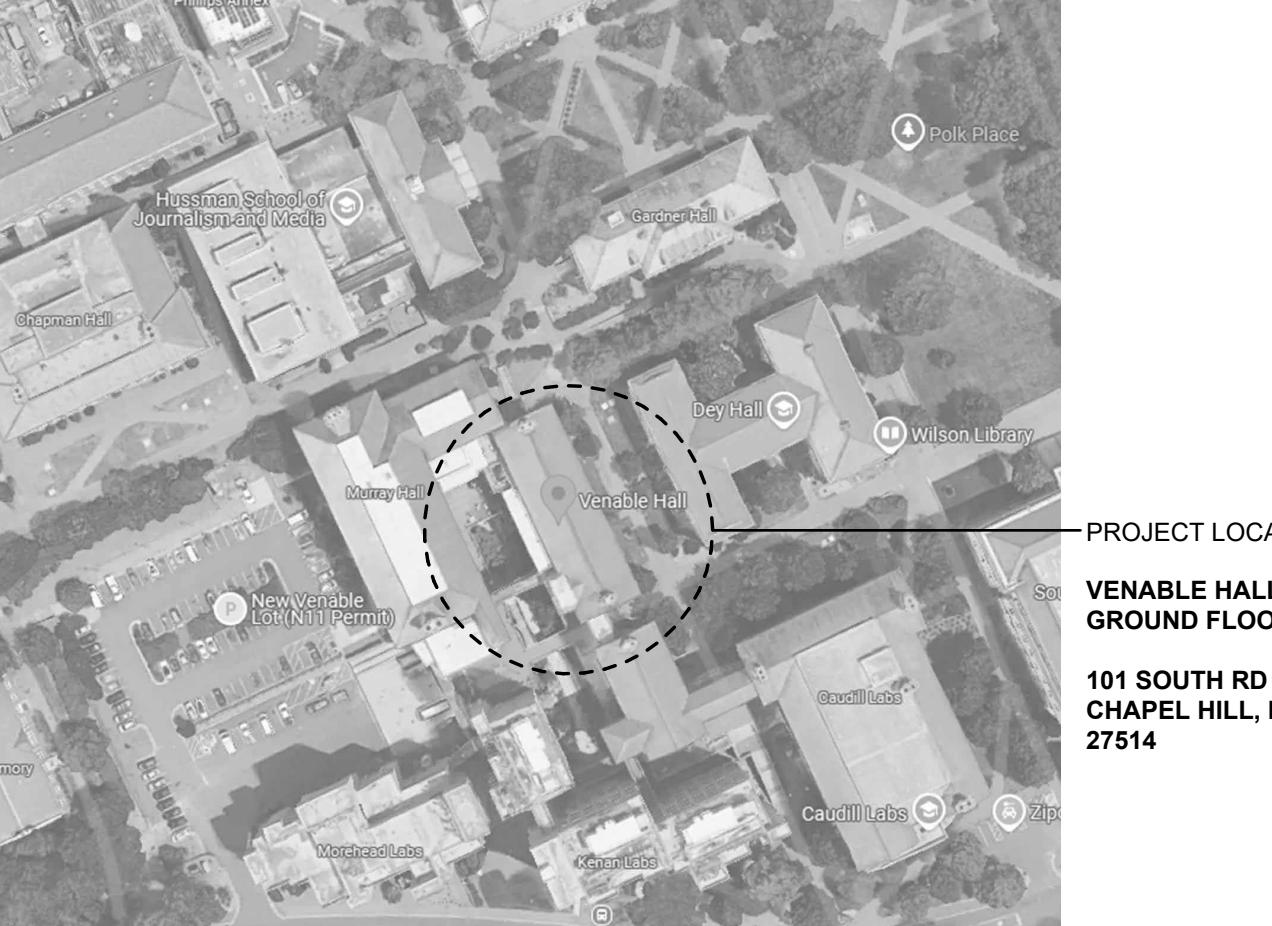
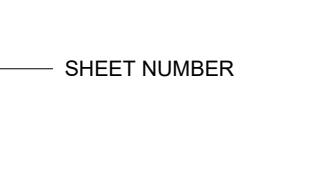
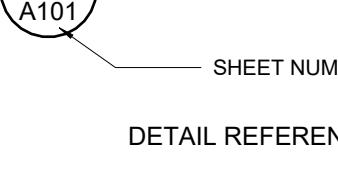
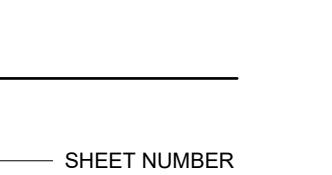
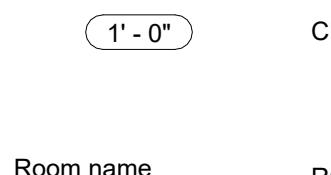
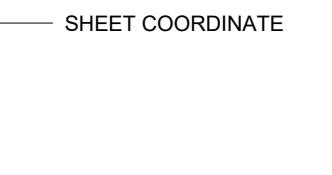
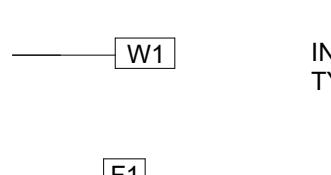
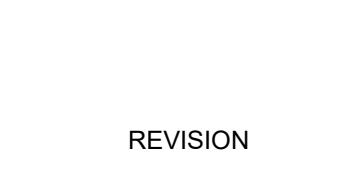
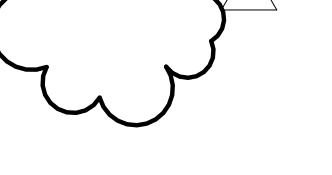
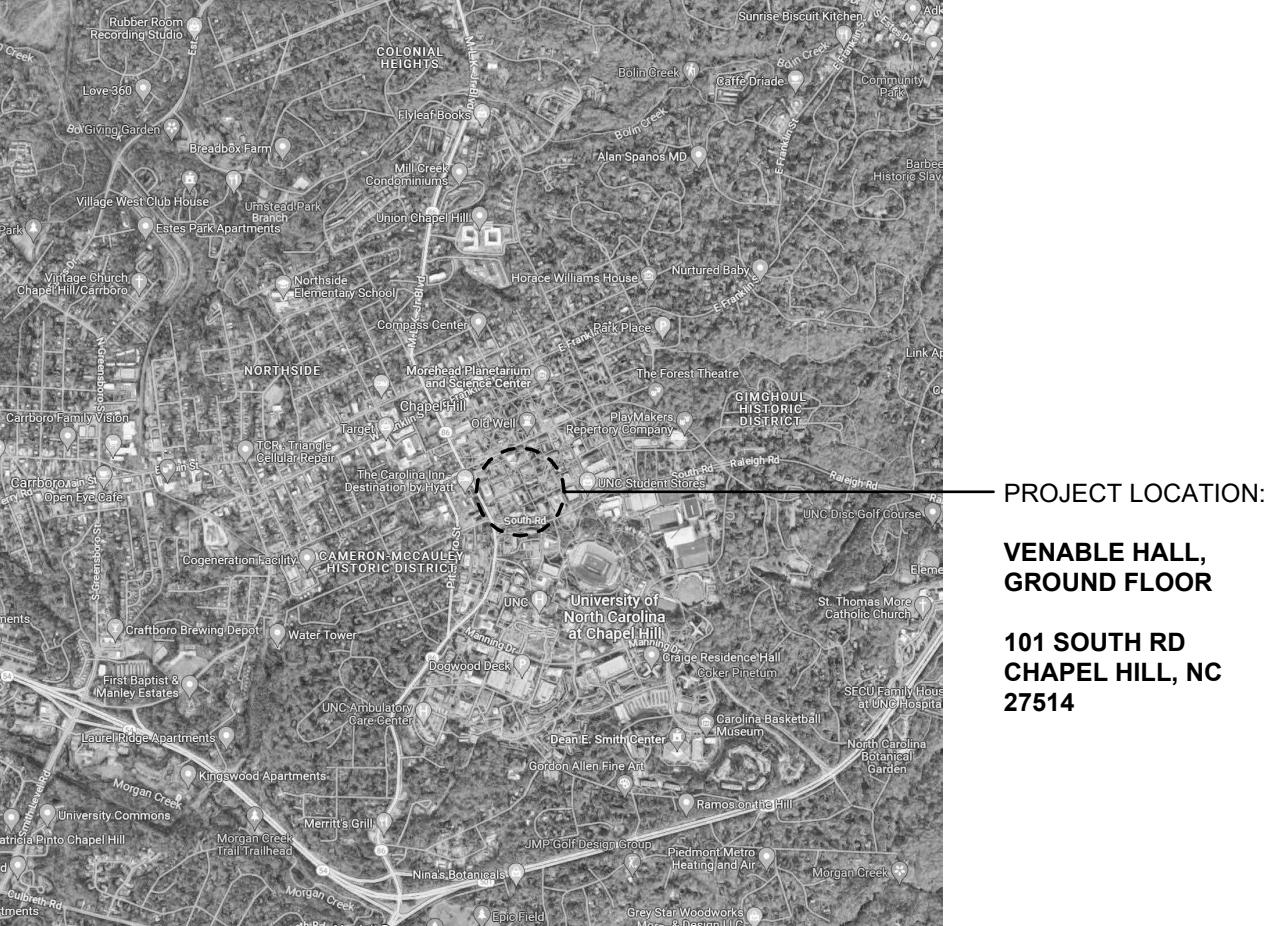
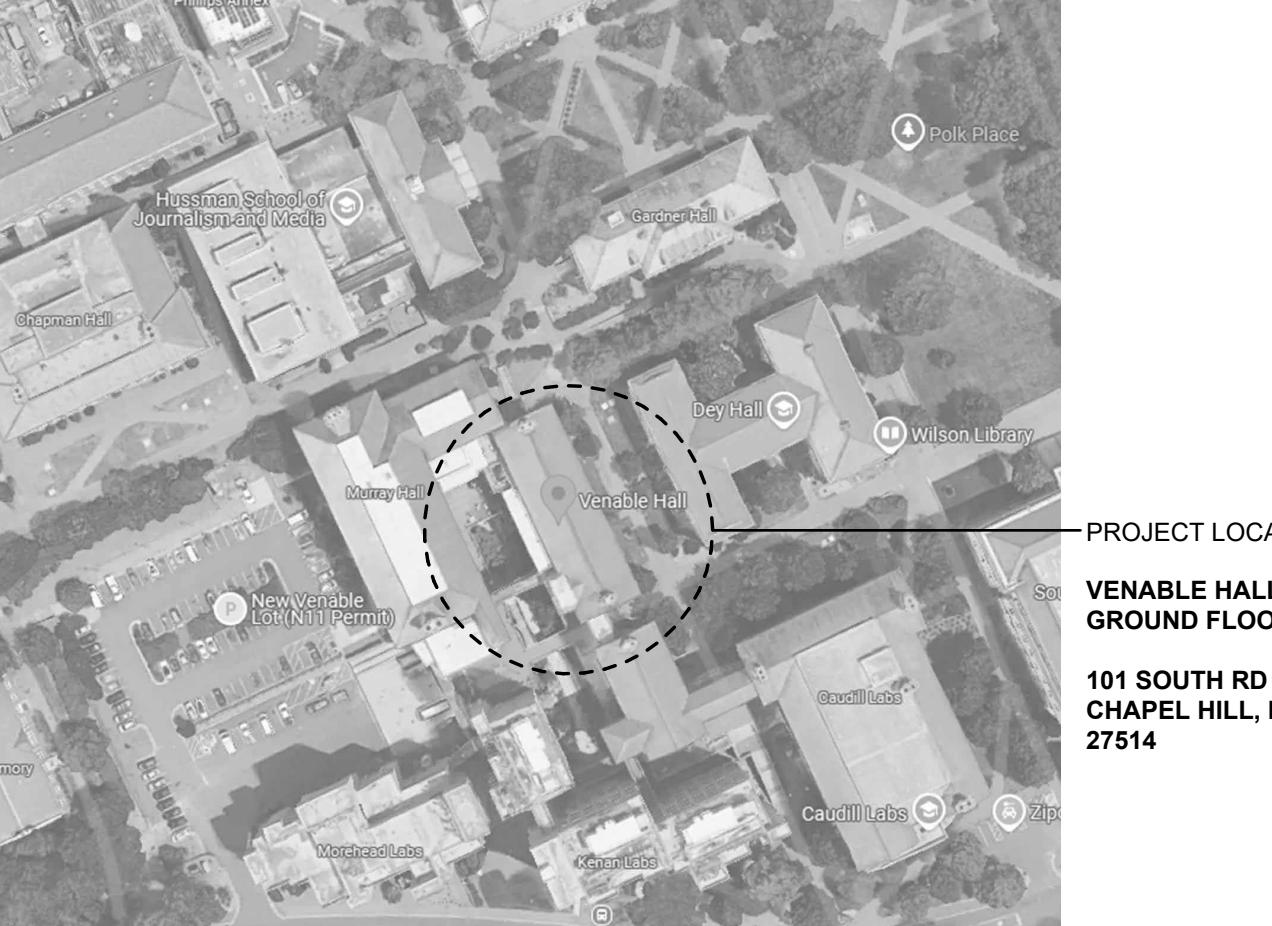


Project Information		Add Alternates										Abbreviations										Construction Set																																																																																																																																																																																																																																																																																																																																																																																																																																																																																																																																																																																																																																																	
<b>Client Name:</b> <b>THE UNIVERSITY OF NORTH CAROLINA AT CHAPEL HILL</b> <b>Job Name:</b> <b>UNC VENABLE HALL LOWER LEVEL UPFIT / CONSTRUCTION SET</b> <b>Issue Date:</b> <b>5-21-25</b> <b>Project Location:</b> <b>VENABLE HALL, GROUND FLOOR</b> <b>101 South Rd</b> <b>Chapel Hill, NC 27514</b> <b>North Carolina State Construction Office No. (SCO Number)</b> <b>24-28389-01A</b> <b>UNC Project Manager Contact Information:</b> <b>Name: Chris Bozzelli</b> <b>Phone: 919.962.9048</b> <b>Email: bozzelli@email.unc.edu</b>		<b>ADD ALTERNATE 01: ADD A SECOND HOOD (FUME HOOD 2), INCLUDING THE DUCTWORK NEEDED TO CONNECT IT, AND ALSO ADD "EMERGENCY SHOWER &amp; EYEWASH ADA COMPLIANT 2" PER PLANS</b> <ul style="list-style-type: none"> <li>SEE 1/A-501 FOR EXACT LOCATION OF SECOND HOOD AND EMERGENCY SHOWER &amp; EYEWASH ADA COMPLIANT 2</li> <li>SEE 2/M-111, M-401, I/E-200, P-311</li> <li>HOOD WILL BE OWNER PROVIDED, CONTRACTOR INSTALLED</li> <li>SAME MODEL AS FUME HOOD 1 (CONTINUOUS SPEED KEWAUNEE TRUVIEW SUPREME AIR, ADA COMPLIANT OPTION)</li> </ul> <p><b>LIST OF ISSUED ADDENDA:</b></p> <ul style="list-style-type: none"> <li>ADDENDUM 1. DATED 1-7-26. REVISION CLOUD NUMBER 1</li> </ul>										<b>ABBREVIATIONS</b> <table border="1"> <tr><td>A &amp; @</td><td>AND AT</td><td>EWK EXISTING</td><td>EWK ELECTRIC WATER HEATER</td><td>K</td><td>KNOCKDOWN</td><td>PLAS PLASTER</td><td>UNO UNLESS NOTED OTHERWISE</td></tr> <tr><td>A/C</td><td>AIR CONDITIONING</td><td>EXP EXPANSION, EXPOSED</td><td>EXT EXTERIOR</td><td>KD</td><td>KILOGRAM</td><td>PLBG PLUMBING</td><td>UTIL UTILITY</td></tr> <tr><td>AB</td><td>ANCHOR BOLT</td><td>F</td><td>F</td><td>KIT KITCHEN</td><td>PLYWD PLYWOOD</td><td>PLWD PLYWOOD</td><td></td></tr> <tr><td>ACOUST</td><td>ACOUSTICAL</td><td>FAC</td><td>FIRE ALARM</td><td>KO</td><td>KNOCKOUT, KNEE OPENING</td><td>POL POLISHED</td><td></td></tr> <tr><td>ACT</td><td>ACOUSTIC CEILING TILE</td><td>FA</td><td>FIRE ALARM CONTROL PANEL</td><td>KS</td><td>KNEE SPACE</td><td>PR PAIR</td><td></td></tr> <tr><td>AD</td><td>AREA DRAIN</td><td>FB</td><td>FIRE BRICK</td><td>L</td><td>LONG, LENGTH</td><td>PSF POUNDS PER SQUARE FOOT</td><td></td></tr> <tr><td>AFF</td><td>ABOVE FINISHED FLOOR</td><td>FD</td><td>FLOOR DRAIN</td><td>LAB LABORATORY</td><td>PSI POUNDS PER SQUARE INCH</td><td>VERT VERTICAL</td><td></td></tr> <tr><td>AHU</td><td>AIR HANDLING UNIT</td><td>FE</td><td>FIRE EXTINGUISHER IN CABINET</td><td>LB LABORATORY</td><td>PT PRESSURE TREATED</td><td>VIF VERIFY IN FIELD</td><td></td></tr> <tr><td>ALT</td><td>ALTERNATE</td><td>FEX</td><td>FIRE EXTINGUISHER ON BRACKET</td><td>LBS LOAD BEARING</td><td>PTD PAINTED</td><td>VTR VENT THROUGH ROOF</td><td></td></tr> <tr><td>ALUM</td><td>ALUMINUM</td><td>FF</td><td>FINISHED FLOOR</td><td>LEV LEVEL</td><td>PTN PARTITION</td><td>VWC VINYL WALL COVERING</td><td></td></tr> <tr><td>APPROX</td><td>APPROXIMATE</td><td>FFE</td><td>FINISHED FLOOR ELEVATION</td><td>LH LEFT HAND</td><td>PVC POLYVINYL CHLORIDE</td><td></td><td></td></tr> <tr><td>ARCH</td><td>ARCHITECTURAL</td><td>FH</td><td>FUME HOOD</td><td>LIN LINOLEUM</td><td>PVG PAVING</td><td></td><td></td></tr> <tr><td>AV</td><td>AUDIO-VISUAL</td><td>FHC</td><td>FIRE HOSE CABINET</td><td>LHR LEFT HAND REVERSE</td><td>PWD PLYWOOD</td><td></td><td></td></tr> <tr><td>Avg</td><td>AVERAGE</td><td>FIN</td><td>FINISH</td><td>LLH LONG LEG HORIZONTAL</td><td>Q QT</td><td>QUARRY TILE</td><td></td></tr> <tr><td>B</td><td>BOARD</td><td>FL</td><td>FLOOR, FLOORING</td><td>LLV LONG LEG VERTICAL</td><td>W W</td><td>WIDTH, WEST</td><td></td></tr> <tr><td>BD</td><td>BRICK EXPANSION JOINT</td><td>FO</td><td>FACE OF</td><td>LP LOW POINT</td><td>W/ WITH</td><td></td><td></td></tr> <tr><td>BLDG</td><td>BUILDING</td><td>FOC</td><td>FACE OF CONCRETE</td><td>LT LIGHT</td><td>WC WATER CLOSET, WALL COVERING</td><td></td><td></td></tr> <tr><td>BLKG</td><td>BLOCKING</td><td>FOM</td><td>FACE OF MASONRY</td><td>LTL LINTEL</td><td>WD WOOD</td><td></td><td></td></tr> <tr><td>BO</td><td>BOTTOM OF</td><td>FOS</td><td>FACE OF STUDS</td><td>LVR LOUVER</td><td>WGL WIRE GLASS</td><td></td><td></td></tr> <tr><td>BOT</td><td>BOTTOM</td><td>FP</td><td>FIREPROOF</td><td>LW LIGHTWEIGHT</td><td>WH WATER HEATER</td><td></td><td></td></tr> <tr><td>BRG</td><td>BEARING</td><td>FR</td><td>FIRE RATED</td><td>REF REFERENCE</td><td>WP WATERPROOFING</td><td></td><td></td></tr> <tr><td>BRK</td><td>BRICK</td><td>FRP</td><td>FIBERGLASS REINFORCED PLASTIC</td><td>REQ'D REQUIRED</td><td>WT WEIGHT</td><td></td><td></td></tr> <tr><td>BSMT</td><td>BASEMENT</td><td>FRT</td><td>FIRE RETARDED TREATED</td><td>M METER</td><td>WWM WELDED WIRE MESH</td><td></td><td></td></tr> <tr><td>BUR</td><td>BUILT-UP ROOF</td><td>FS</td><td>FULL-SIZED</td><td>MAINT MAINTENANCE</td><td></td><td></td><td></td></tr> <tr><td>CAB</td><td>CABINET</td><td>FT</td><td>FOOT, FEET</td><td>MAX MAXIMUM</td><td></td><td></td><td></td></tr> <tr><td>CB</td><td>CATCH BASIN</td><td>FURN</td><td>FURNISH</td><td>MDF MEDIUM DENSITY FIBERBOARD</td><td></td><td></td><td></td></tr> <tr><td>CF</td><td>CUBIC FEET</td><td>FUT</td><td>FUTURE</td><td>MDO MEDIUM DENSITY OVERLAY</td><td></td><td></td><td></td></tr> <tr><td>CFMF</td><td>CUBIC FEET PER MINUTE</td><td>FV</td><td>FIELD VERIFY</td><td>MECH MECHANICAL</td><td></td><td></td><td></td></tr> <tr><td>CJ</td><td>COLD-FORMED METAL FRAMING</td><td>G</td><td>GAS</td><td>MET METAL</td><td></td><td></td><td></td></tr> <tr><td>CL</td><td>CONTROL JOINT</td><td>GA</td><td>GAUGE</td><td>MFG MANUFACTURING</td><td></td><td></td><td></td></tr> <tr><td>CLG</td><td>CENTERLINE</td><td>GALV</td><td>GALVANIZED</td><td>MEZZ MEZZANINE</td><td></td><td></td><td></td></tr> <tr><td>CLOS</td><td>CEILING</td><td>GB</td><td>GRAB BAR</td><td>MIR MIRROR</td><td></td><td></td><td></td></tr> <tr><td>CM</td><td>CLOSET</td><td>GC</td><td>GENERAL CONTRACTOR</td><td>MISC MISCELLANEOUS</td><td></td><td></td><td></td></tr> <tr><td>CMU</td><td>CENTIMETER</td><td>GCMU</td><td>GLAZED CONCRETE MASONRY UNIT</td><td>MM MILLIMETER</td><td></td><td></td><td></td></tr> <tr><td>CO</td><td>CONCRETE MASONRY UNIT</td><td>CO</td><td>CLEAR OPENING, CLEAN OUT</td><td>MNT MOUNT</td><td></td><td></td><td></td></tr> <tr><td>COL</td><td>CONCRETE</td><td>GD</td><td>GRADE</td><td>MO MASONRY OPENING</td><td></td><td></td><td></td></tr> <tr><td>CONF</td><td>CONFERENCE</td><td>GFR</td><td>GLASS FIBER REINFORCED CONCRETE</td><td>MTG MOUNTING</td><td></td><td></td><td></td></tr> <tr><td>CONST</td><td>CONSTRUCTION</td><td>GFRG</td><td>GLASS FIBER REINFORCED GYPSUM</td><td>MTL METAL</td><td></td><td></td><td></td></tr> <tr><td>CONT</td><td>CONTINUOUS</td><td>GYP</td><td>GYPSUM</td><td>MULL MULLION</td><td></td><td></td><td></td></tr> <tr><td>CORR</td><td>CORRIDOR</td><td>GYP</td><td>GYPSUM</td><td>NCSBC 2018 NORTH CAROLINA STATE BUILDING CODE</td><td></td><td></td><td></td></tr> <tr><td>CPT</td><td>CARPET</td><td>GL</td><td>GLASS</td><td>N NORTH</td><td></td><td></td><td></td></tr> <tr><td>CT</td><td>CERAMIC TILE</td><td>GWB</td><td>GYPSUM WALL BOARD</td><td>NE NORTHEAST</td><td></td><td></td><td></td></tr> <tr><td>CW</td><td>CHILLED WATER</td><td>GYP</td><td>GYPSUM</td><td>NO NUMBER</td><td></td><td></td><td></td></tr> <tr><td>CY</td><td>CUBIC YARD</td><td>H</td><td>HOHES BIBB</td><td>NOT IN CONTRACT</td><td></td><td></td><td></td></tr> <tr><td>D</td><td>DEEP</td><td>HC</td><td>HANDICAPPED, HOLLOW CORE</td><td>NO NOMINAL</td><td></td><td></td><td></td></tr> <tr><td>DBL</td><td>DOUBLE</td><td>HD</td><td>HAND</td><td>NOM NOMINAL PIPE SIZE</td><td></td><td></td><td></td></tr> <tr><td>DET</td><td>DETAIL</td><td>HDR</td><td>HEADER</td><td>NTS NOT TO SCALE</td><td></td><td></td><td></td></tr> <tr><td>DF</td><td>DRINKING FOUNTAIN</td><td>HDWD</td><td>HARDWOOD</td><td>NW NORTHWEST</td><td></td><td></td><td></td></tr> <tr><td>DIA</td><td>DIA METER</td><td>HK</td><td>HOOK(S)</td><td>OFFICE OFFICE</td><td></td><td></td><td></td></tr> <tr><td>DIAG</td><td>DIAGONAL</td><td>HM</td><td>HOLLOW METAL</td><td>OFF OWNER FURNISHED OWNER</td><td></td><td></td><td></td></tr> <tr><td>DIM</td><td>DI MENSION</td><td>HORIZ</td><td>HORIZONTAL</td><td>OFF INSTALLED</td><td></td><td></td><td></td></tr> <tr><td>DN</td><td>DN DOWN</td><td>HP</td><td>HIGH POINT, HORSE POWER</td><td>OTH THICK, THICKNESS</td><td></td><td></td><td></td></tr> <tr><td>DR</td><td>DR DOOR</td><td>HR</td><td>HOUR</td><td>OTH OVERHEAD, OPPOSITE HAND</td><td></td><td></td><td></td></tr> <tr><td>DS</td><td>DS DOWNSPOUT</td><td>HS</td><td>HEAT STRENGTHENED</td><td>OPNG OPENING</td><td></td><td></td><td></td></tr> <tr><td>DWG(S)</td><td>DRAWING(S)</td><td>HT</td><td>HEIGHT</td><td>OPP OPPOSITE</td><td></td><td></td><td></td></tr> <tr><td>HVAC</td><td>HVAC</td><td>HVAC</td><td>HEATING VENTILATION AIR CONDITIONING</td><td>OTO OUT-TO-OUT</td><td></td><td></td><td></td></tr> <tr><td>E</td><td>EAST</td><td>HVT</td><td>HOMOGENEOUS VINYL TILE</td><td>P CONTRACTOR INSTALLED</td><td></td><td></td><td></td></tr> <tr><td>EA</td><td>EACH</td><td>I</td><td>INSIDE DIAMETER</td><td>PBD PARTICLE BOARD</td><td></td><td></td><td></td></tr> <tr><td>EF</td><td>EACH FACE</td><td>INSUL</td><td>INSULATION</td><td>PC PRECAST</td><td></td><td></td><td></td></tr> <tr><td>EIFS</td><td>EXTERIOR INSULATION FINISH SYSTEM</td><td>INT</td><td>INTERIOR</td><td>PERF PERFORATED</td><td></td><td></td><td></td></tr> <tr><td>EJ</td><td>EXPANSION JOINT</td><td>INV</td><td>INVERT</td><td>PL PLATE, PROPERTY LINE</td><td></td><td></td><td></td></tr> <tr><td>EL</td><td>ELEVATION</td><td>J</td><td>JANITOR</td><td>PLAM PLASTIC LAMINATE</td><td></td><td></td><td></td></tr> <tr><td>ELEC</td><td>ELECTRICAL</td><td>JAN</td><td>JANITOR CLOSET</td><td>U UNFINISHED</td><td></td><td></td><td></td></tr> <tr><td>ELEV</td><td>ELEVATION</td><td>JC</td><td>JOIST</td><td>UC UNDERCUT</td><td></td><td></td><td></td></tr> <tr><td>EQ</td><td>EQUAL</td><td>JST</td><td>JOINT</td><td>UH UNIT HEATER</td><td></td><td></td><td></td></tr> <tr><td>EQUIP</td><td>EQUIPMENT</td><td>JT</td><td></td><td>UNFIN UNFINISHED</td><td></td><td></td><td></td></tr> <tr><td>EW</td><td>EYE WASH, EACH WAY</td><td></td><td></td><td></td><td></td><td></td><td></td></tr> <tr><td>EWC</td><td>ELECTRIC WATER COOLER</td><td></td><td></td><td></td><td></td><td></td><td></td></tr> <tr><td colspan="10">COORDINATION/INDICATION OF ENGINEERING WORK ON ARCHITECTURAL DRAWINGS:</td><td colspan="10">Symbols</td><td colspan="10">Construction Set</td></tr> <tr> <td colspan="10"> <p>13. WHERE HVAC OR OTHER MECHANICAL, ELECTRICAL AND PLUMBING ITEMS PENETRATE PARTITIONS, STUDS SHALL BE BRACED AND FRAMED TO STRUCTURE AS REQUIRED TO PROVIDE ADEQUATE SUPPORT. ALL PENETRATIONS THROUGH WALLS SHALL BE SEALED TO PROVIDE FIRE, SMOKE AND/OR ACOUSTIC ISOLATION SPACES.</p> <p>14. BEFORE PATCHING ANY FIRE-RATED CMU PARTITION, FILL ANY EXPOSED CELLS SOLID WITH GROUT.</p> <p>15. PROVIDE FINISHED WALL UNDER AND BEHIND WALL EQUIPMENT AND CASEWORK.</p> <p>16. WORK OF ENGINEERING DISCIPLINES IS SHOWN ON ARCHITECTURAL DRAWINGS FOR COORDINATION AND CONVENIENCE PURPOSES ONLY. REFER TO APPROPRIATE DISCIPLINE DRAWINGS FOR COMPLETE AND GOVERNING INFORMATION REGARDING THEIR WORK.</p> <p>17. SEE ARCHITECTURAL REFLECTED CEILING PLANS FOR LOCATION OF CEILING MOUNTED MECHANICAL, ELECTRICAL AND PLUMBING FIXTURES.</p> <p>18. WHERE EXPOSED STRUCTURE CEILING AREAS OCCUR IN ARCHITECTURAL REFLECTED CEILING PLANS, FULL DELINEATION OF STRUCTURAL, MECHANICAL, ELECTRICAL, PLUMBING, AND FIRE PROTECTION SYSTEMS IS NOT PROVIDED. SELECTED ELEMENTS AND DEVICES MAY BE SHOWN FOR LOCATION OR COORDINATION (E.G. LIGHT AND SPRINKLER SPACING).</p> <p>19. FOR ALL ELECTRICAL INSTALLED IN CUSTOM MADE PANELS, FURNITURE, AND OTHER BUILT-INS, ACCEPTANCE BY ELECTRICAL INSPECTOR IS BY NEC 110.2 AND NEC 110.3</p> <p>UNC STANDARD PRACTICES:</p> <p>20. GC TO FOLLOW UNC STORMWATER REQUIREMENTS FOR SMALL CONSTRUCTION PROJECTS, ESPECIALLY WHEN STAGING OR CONDUCTING ANY ACTIVITY OUTSIDE OF THE BUILDING.</p> </td> <td colspan="10">              </td> <td colspan="10">  <p><b>NOTCH DESIGN, PLLC</b> 212 W MAIN ST, SUITE E, CARRBORO, NC</p> <p><a href="http://www.notchdesign.us">www.notchdesign.us</a> <a href="mailto:info@notchdesign.us">info@notchdesign.us</a></p> <p>REVISION: SCO Review 9/15/25 2nd SCO Review 10/24/25 Construction Set 11/17/25 1. Addendum 1 1/7/26</p> <p><b>CONSTRUCTION SET</b></p> <p><b>JOSE R NOVA</b> REGISTERED ARCHITECT 11/17/2025 15566 NORTH CAROLINA CARRBORO, NC</p> <p>© 2025 Notch Design</p> <p><b>CLIENT NAME:</b> THE UNIVERSITY OF NORTH CAROLINA AT CHAPEL HILL <b>JOB NAME:</b> VENABLE HALL LOWER LEVEL UPFIT <b>LOCATION:</b> 101 South Rd <b>CITY:</b> CHAPEL HILL, NC 27514</p> <p><b>ISSUE DATE:</b> 5-21-25 <b>JOB NO.:</b> N092 <b>SCO #:</b> SCO # 24-28389-01A</p> <p><b>A000</b> <b>COVER SHEET</b></p> </td> </tr> <tr> <td colspan="2">  <p><b>VICINITY MAP</b></p> <p><b>PROJECT LOCATION:</b> VENABLE HALL, GROUND FLOOR 101 SOUTH RD CHAPEL HILL, NC 27514</p> </td> <td colspan="10">  <p><b>LOCATION MAP</b></p> <p><b>PROJECT LOCATION:</b> VENABLE HALL, GROUND FLOOR 101 SOUTH RD CHAPEL HILL, NC 27514</p> </td> <td colspan="10"></td> </tr> </table>										A & @	AND AT	EWK EXISTING	EWK ELECTRIC WATER HEATER	K	KNOCKDOWN	PLAS PLASTER	UNO UNLESS NOTED OTHERWISE	A/C	AIR CONDITIONING	EXP EXPANSION, EXPOSED	EXT EXTERIOR	KD	KILOGRAM	PLBG PLUMBING	UTIL UTILITY	AB	ANCHOR BOLT	F	F	KIT KITCHEN	PLYWD PLYWOOD	PLWD PLYWOOD		ACOUST	ACOUSTICAL	FAC	FIRE ALARM	KO	KNOCKOUT, KNEE OPENING	POL POLISHED		ACT	ACOUSTIC CEILING TILE	FA	FIRE ALARM CONTROL PANEL	KS	KNEE SPACE	PR PAIR		AD	AREA DRAIN	FB	FIRE BRICK	L	LONG, LENGTH	PSF POUNDS PER SQUARE FOOT		AFF	ABOVE FINISHED FLOOR	FD	FLOOR DRAIN	LAB LABORATORY	PSI POUNDS PER SQUARE INCH	VERT VERTICAL		AHU	AIR HANDLING UNIT	FE	FIRE EXTINGUISHER IN CABINET	LB LABORATORY	PT PRESSURE TREATED	VIF VERIFY IN FIELD		ALT	ALTERNATE	FEX	FIRE EXTINGUISHER ON BRACKET	LBS LOAD BEARING	PTD PAINTED	VTR VENT THROUGH ROOF		ALUM	ALUMINUM	FF	FINISHED FLOOR	LEV LEVEL	PTN PARTITION	VWC VINYL WALL COVERING		APPROX	APPROXIMATE	FFE	FINISHED FLOOR ELEVATION	LH LEFT HAND	PVC POLYVINYL CHLORIDE			ARCH	ARCHITECTURAL	FH	FUME HOOD	LIN LINOLEUM	PVG PAVING			AV	AUDIO-VISUAL	FHC	FIRE HOSE CABINET	LHR LEFT HAND REVERSE	PWD PLYWOOD			Avg	AVERAGE	FIN	FINISH	LLH LONG LEG HORIZONTAL	Q QT	QUARRY TILE		B	BOARD	FL	FLOOR, FLOORING	LLV LONG LEG VERTICAL	W W	WIDTH, WEST		BD	BRICK EXPANSION JOINT	FO	FACE OF	LP LOW POINT	W/ WITH			BLDG	BUILDING	FOC	FACE OF CONCRETE	LT LIGHT	WC WATER CLOSET, WALL COVERING			BLKG	BLOCKING	FOM	FACE OF MASONRY	LTL LINTEL	WD WOOD			BO	BOTTOM OF	FOS	FACE OF STUDS	LVR LOUVER	WGL WIRE GLASS			BOT	BOTTOM	FP	FIREPROOF	LW LIGHTWEIGHT	WH WATER HEATER			BRG	BEARING	FR	FIRE RATED	REF REFERENCE	WP WATERPROOFING			BRK	BRICK	FRP	FIBERGLASS REINFORCED PLASTIC	REQ'D REQUIRED	WT WEIGHT			BSMT	BASEMENT	FRT	FIRE RETARDED TREATED	M METER	WWM WELDED WIRE MESH			BUR	BUILT-UP ROOF	FS	FULL-SIZED	MAINT MAINTENANCE				CAB	CABINET	FT	FOOT, FEET	MAX MAXIMUM				CB	CATCH BASIN	FURN	FURNISH	MDF MEDIUM DENSITY FIBERBOARD				CF	CUBIC FEET	FUT	FUTURE	MDO MEDIUM DENSITY OVERLAY				CFMF	CUBIC FEET PER MINUTE	FV	FIELD VERIFY	MECH MECHANICAL				CJ	COLD-FORMED METAL FRAMING	G	GAS	MET METAL				CL	CONTROL JOINT	GA	GAUGE	MFG MANUFACTURING				CLG	CENTERLINE	GALV	GALVANIZED	MEZZ MEZZANINE				CLOS	CEILING	GB	GRAB BAR	MIR MIRROR				CM	CLOSET	GC	GENERAL CONTRACTOR	MISC MISCELLANEOUS				CMU	CENTIMETER	GCMU	GLAZED CONCRETE MASONRY UNIT	MM MILLIMETER				CO	CONCRETE MASONRY UNIT	CO	CLEAR OPENING, CLEAN OUT	MNT MOUNT				COL	CONCRETE	GD	GRADE	MO MASONRY OPENING				CONF	CONFERENCE	GFR	GLASS FIBER REINFORCED CONCRETE	MTG MOUNTING				CONST	CONSTRUCTION	GFRG	GLASS FIBER REINFORCED GYPSUM	MTL METAL				CONT	CONTINUOUS	GYP	GYPSUM	MULL MULLION				CORR	CORRIDOR	GYP	GYPSUM	NCSBC 2018 NORTH CAROLINA STATE BUILDING CODE				CPT	CARPET	GL	GLASS	N NORTH				CT	CERAMIC TILE	GWB	GYPSUM WALL BOARD	NE NORTHEAST				CW	CHILLED WATER	GYP	GYPSUM	NO NUMBER				CY	CUBIC YARD	H	HOHES BIBB	NOT IN CONTRACT				D	DEEP	HC	HANDICAPPED, HOLLOW CORE	NO NOMINAL				DBL	DOUBLE	HD	HAND	NOM NOMINAL PIPE SIZE				DET	DETAIL	HDR	HEADER	NTS NOT TO SCALE				DF	DRINKING FOUNTAIN	HDWD	HARDWOOD	NW NORTHWEST				DIA	DIA METER	HK	HOOK(S)	OFFICE OFFICE				DIAG	DIAGONAL	HM	HOLLOW METAL	OFF OWNER FURNISHED OWNER				DIM	DI MENSION	HORIZ	HORIZONTAL	OFF INSTALLED				DN	DN DOWN	HP	HIGH POINT, HORSE POWER	OTH THICK, THICKNESS				DR	DR DOOR	HR	HOUR	OTH OVERHEAD, OPPOSITE HAND				DS	DS DOWNSPOUT	HS	HEAT STRENGTHENED	OPNG OPENING				DWG(S)	DRAWING(S)	HT	HEIGHT	OPP OPPOSITE				HVAC	HVAC	HVAC	HEATING VENTILATION AIR CONDITIONING	OTO OUT-TO-OUT				E	EAST	HVT	HOMOGENEOUS VINYL TILE	P CONTRACTOR INSTALLED				EA	EACH	I	INSIDE DIAMETER	PBD PARTICLE BOARD				EF	EACH FACE	INSUL	INSULATION	PC PRECAST				EIFS	EXTERIOR INSULATION FINISH SYSTEM	INT	INTERIOR	PERF PERFORATED				EJ	EXPANSION JOINT	INV	INVERT	PL PLATE, PROPERTY LINE				EL	ELEVATION	J	JANITOR	PLAM PLASTIC LAMINATE				ELEC	ELECTRICAL	JAN	JANITOR CLOSET	U UNFINISHED				ELEV	ELEVATION	JC	JOIST	UC UNDERCUT				EQ	EQUAL	JST	JOINT	UH UNIT HEATER				EQUIP	EQUIPMENT	JT		UNFIN UNFINISHED				EW	EYE WASH, EACH WAY							EWC	ELECTRIC WATER COOLER							COORDINATION/INDICATION OF ENGINEERING WORK ON ARCHITECTURAL DRAWINGS:										Symbols										Construction Set										<p>13. WHERE HVAC OR OTHER MECHANICAL, ELECTRICAL AND PLUMBING ITEMS PENETRATE PARTITIONS, STUDS SHALL BE BRACED AND FRAMED TO STRUCTURE AS REQUIRED TO PROVIDE ADEQUATE SUPPORT. ALL PENETRATIONS THROUGH WALLS SHALL BE SEALED TO PROVIDE FIRE, SMOKE AND/OR ACOUSTIC ISOLATION SPACES.</p> <p>14. BEFORE PATCHING ANY FIRE-RATED CMU PARTITION, FILL ANY EXPOSED CELLS SOLID WITH GROUT.</p> <p>15. PROVIDE FINISHED WALL UNDER AND BEHIND WALL EQUIPMENT AND CASEWORK.</p> <p>16. WORK OF ENGINEERING DISCIPLINES IS SHOWN ON ARCHITECTURAL DRAWINGS FOR COORDINATION AND CONVENIENCE PURPOSES ONLY. REFER TO APPROPRIATE DISCIPLINE DRAWINGS FOR COMPLETE AND GOVERNING INFORMATION REGARDING THEIR WORK.</p> <p>17. SEE ARCHITECTURAL REFLECTED CEILING PLANS FOR LOCATION OF CEILING MOUNTED MECHANICAL, ELECTRICAL AND PLUMBING FIXTURES.</p> <p>18. WHERE EXPOSED STRUCTURE CEILING AREAS OCCUR IN ARCHITECTURAL REFLECTED CEILING PLANS, FULL DELINEATION OF STRUCTURAL, MECHANICAL, ELECTRICAL, PLUMBING, AND FIRE PROTECTION SYSTEMS IS NOT PROVIDED. SELECTED ELEMENTS AND DEVICES MAY BE SHOWN FOR LOCATION OR COORDINATION (E.G. LIGHT AND SPRINKLER SPACING).</p> <p>19. FOR ALL ELECTRICAL INSTALLED IN CUSTOM MADE PANELS, FURNITURE, AND OTHER BUILT-INS, ACCEPTANCE BY ELECTRICAL INSPECTOR IS BY NEC 110.2 AND NEC 110.3</p> <p>UNC STANDARD PRACTICES:</p> <p>20. GC TO FOLLOW UNC STORMWATER REQUIREMENTS FOR SMALL CONSTRUCTION PROJECTS, ESPECIALLY WHEN STAGING OR CONDUCTING ANY ACTIVITY OUTSIDE OF THE BUILDING.</p>										            										 <p><b>NOTCH DESIGN, PLLC</b> 212 W MAIN ST, SUITE E, CARRBORO, NC</p> <p><a href="http://www.notchdesign.us">www.notchdesign.us</a> <a href="mailto:info@notchdesign.us">info@notchdesign.us</a></p> <p>REVISION: SCO Review 9/15/25 2nd SCO Review 10/24/25 Construction Set 11/17/25 1. Addendum 1 1/7/26</p> <p><b>CONSTRUCTION SET</b></p> <p><b>JOSE R NOVA</b> REGISTERED ARCHITECT 11/17/2025 15566 NORTH CAROLINA CARRBORO, NC</p> <p>© 2025 Notch Design</p> <p><b>CLIENT NAME:</b> THE UNIVERSITY OF NORTH CAROLINA AT CHAPEL HILL <b>JOB NAME:</b> VENABLE HALL LOWER LEVEL UPFIT <b>LOCATION:</b> 101 South Rd <b>CITY:</b> CHAPEL HILL, NC 27514</p> <p><b>ISSUE DATE:</b> 5-21-25 <b>JOB NO.:</b> N092 <b>SCO #:</b> SCO # 24-28389-01A</p> <p><b>A000</b> <b>COVER SHEET</b></p>										 <p><b>VICINITY MAP</b></p> <p><b>PROJECT LOCATION:</b> VENABLE HALL, GROUND FLOOR 101 SOUTH RD CHAPEL HILL, NC 27514</p>		 <p><b>LOCATION MAP</b></p> <p><b>PROJECT LOCATION:</b> VENABLE HALL, GROUND FLOOR 101 SOUTH RD CHAPEL HILL, NC 27514</p>																			
A & @	AND AT	EWK EXISTING	EWK ELECTRIC WATER HEATER	K	KNOCKDOWN	PLAS PLASTER	UNO UNLESS NOTED OTHERWISE																																																																																																																																																																																																																																																																																																																																																																																																																																																																																																																																																																																																																																																																
A/C	AIR CONDITIONING	EXP EXPANSION, EXPOSED	EXT EXTERIOR	KD	KILOGRAM	PLBG PLUMBING	UTIL UTILITY																																																																																																																																																																																																																																																																																																																																																																																																																																																																																																																																																																																																																																																																
AB	ANCHOR BOLT	F	F	KIT KITCHEN	PLYWD PLYWOOD	PLWD PLYWOOD																																																																																																																																																																																																																																																																																																																																																																																																																																																																																																																																																																																																																																																																	
ACOUST	ACOUSTICAL	FAC	FIRE ALARM	KO	KNOCKOUT, KNEE OPENING	POL POLISHED																																																																																																																																																																																																																																																																																																																																																																																																																																																																																																																																																																																																																																																																	
ACT	ACOUSTIC CEILING TILE	FA	FIRE ALARM CONTROL PANEL	KS	KNEE SPACE	PR PAIR																																																																																																																																																																																																																																																																																																																																																																																																																																																																																																																																																																																																																																																																	
AD	AREA DRAIN	FB	FIRE BRICK	L	LONG, LENGTH	PSF POUNDS PER SQUARE FOOT																																																																																																																																																																																																																																																																																																																																																																																																																																																																																																																																																																																																																																																																	
AFF	ABOVE FINISHED FLOOR	FD	FLOOR DRAIN	LAB LABORATORY	PSI POUNDS PER SQUARE INCH	VERT VERTICAL																																																																																																																																																																																																																																																																																																																																																																																																																																																																																																																																																																																																																																																																	
AHU	AIR HANDLING UNIT	FE	FIRE EXTINGUISHER IN CABINET	LB LABORATORY	PT PRESSURE TREATED	VIF VERIFY IN FIELD																																																																																																																																																																																																																																																																																																																																																																																																																																																																																																																																																																																																																																																																	
ALT	ALTERNATE	FEX	FIRE EXTINGUISHER ON BRACKET	LBS LOAD BEARING	PTD PAINTED	VTR VENT THROUGH ROOF																																																																																																																																																																																																																																																																																																																																																																																																																																																																																																																																																																																																																																																																	
ALUM	ALUMINUM	FF	FINISHED FLOOR	LEV LEVEL	PTN PARTITION	VWC VINYL WALL COVERING																																																																																																																																																																																																																																																																																																																																																																																																																																																																																																																																																																																																																																																																	
APPROX	APPROXIMATE	FFE	FINISHED FLOOR ELEVATION	LH LEFT HAND	PVC POLYVINYL CHLORIDE																																																																																																																																																																																																																																																																																																																																																																																																																																																																																																																																																																																																																																																																		
ARCH	ARCHITECTURAL	FH	FUME HOOD	LIN LINOLEUM	PVG PAVING																																																																																																																																																																																																																																																																																																																																																																																																																																																																																																																																																																																																																																																																		
AV	AUDIO-VISUAL	FHC	FIRE HOSE CABINET	LHR LEFT HAND REVERSE	PWD PLYWOOD																																																																																																																																																																																																																																																																																																																																																																																																																																																																																																																																																																																																																																																																		
Avg	AVERAGE	FIN	FINISH	LLH LONG LEG HORIZONTAL	Q QT	QUARRY TILE																																																																																																																																																																																																																																																																																																																																																																																																																																																																																																																																																																																																																																																																	
B	BOARD	FL	FLOOR, FLOORING	LLV LONG LEG VERTICAL	W W	WIDTH, WEST																																																																																																																																																																																																																																																																																																																																																																																																																																																																																																																																																																																																																																																																	
BD	BRICK EXPANSION JOINT	FO	FACE OF	LP LOW POINT	W/ WITH																																																																																																																																																																																																																																																																																																																																																																																																																																																																																																																																																																																																																																																																		
BLDG	BUILDING	FOC	FACE OF CONCRETE	LT LIGHT	WC WATER CLOSET, WALL COVERING																																																																																																																																																																																																																																																																																																																																																																																																																																																																																																																																																																																																																																																																		
BLKG	BLOCKING	FOM	FACE OF MASONRY	LTL LINTEL	WD WOOD																																																																																																																																																																																																																																																																																																																																																																																																																																																																																																																																																																																																																																																																		
BO	BOTTOM OF	FOS	FACE OF STUDS	LVR LOUVER	WGL WIRE GLASS																																																																																																																																																																																																																																																																																																																																																																																																																																																																																																																																																																																																																																																																		
BOT	BOTTOM	FP	FIREPROOF	LW LIGHTWEIGHT	WH WATER HEATER																																																																																																																																																																																																																																																																																																																																																																																																																																																																																																																																																																																																																																																																		
BRG	BEARING	FR	FIRE RATED	REF REFERENCE	WP WATERPROOFING																																																																																																																																																																																																																																																																																																																																																																																																																																																																																																																																																																																																																																																																		
BRK	BRICK	FRP	FIBERGLASS REINFORCED PLASTIC	REQ'D REQUIRED	WT WEIGHT																																																																																																																																																																																																																																																																																																																																																																																																																																																																																																																																																																																																																																																																		
BSMT	BASEMENT	FRT	FIRE RETARDED TREATED	M METER	WWM WELDED WIRE MESH																																																																																																																																																																																																																																																																																																																																																																																																																																																																																																																																																																																																																																																																		
BUR	BUILT-UP ROOF	FS	FULL-SIZED	MAINT MAINTENANCE																																																																																																																																																																																																																																																																																																																																																																																																																																																																																																																																																																																																																																																																			
CAB	CABINET	FT	FOOT, FEET	MAX MAXIMUM																																																																																																																																																																																																																																																																																																																																																																																																																																																																																																																																																																																																																																																																			
CB	CATCH BASIN	FURN	FURNISH	MDF MEDIUM DENSITY FIBERBOARD																																																																																																																																																																																																																																																																																																																																																																																																																																																																																																																																																																																																																																																																			
CF	CUBIC FEET	FUT	FUTURE	MDO MEDIUM DENSITY OVERLAY																																																																																																																																																																																																																																																																																																																																																																																																																																																																																																																																																																																																																																																																			
CFMF	CUBIC FEET PER MINUTE	FV	FIELD VERIFY	MECH MECHANICAL																																																																																																																																																																																																																																																																																																																																																																																																																																																																																																																																																																																																																																																																			
CJ	COLD-FORMED METAL FRAMING	G	GAS	MET METAL																																																																																																																																																																																																																																																																																																																																																																																																																																																																																																																																																																																																																																																																			
CL	CONTROL JOINT	GA	GAUGE	MFG MANUFACTURING																																																																																																																																																																																																																																																																																																																																																																																																																																																																																																																																																																																																																																																																			
CLG	CENTERLINE	GALV	GALVANIZED	MEZZ MEZZANINE																																																																																																																																																																																																																																																																																																																																																																																																																																																																																																																																																																																																																																																																			
CLOS	CEILING	GB	GRAB BAR	MIR MIRROR																																																																																																																																																																																																																																																																																																																																																																																																																																																																																																																																																																																																																																																																			
CM	CLOSET	GC	GENERAL CONTRACTOR	MISC MISCELLANEOUS																																																																																																																																																																																																																																																																																																																																																																																																																																																																																																																																																																																																																																																																			
CMU	CENTIMETER	GCMU	GLAZED CONCRETE MASONRY UNIT	MM MILLIMETER																																																																																																																																																																																																																																																																																																																																																																																																																																																																																																																																																																																																																																																																			
CO	CONCRETE MASONRY UNIT	CO	CLEAR OPENING, CLEAN OUT	MNT MOUNT																																																																																																																																																																																																																																																																																																																																																																																																																																																																																																																																																																																																																																																																			
COL	CONCRETE	GD	GRADE	MO MASONRY OPENING																																																																																																																																																																																																																																																																																																																																																																																																																																																																																																																																																																																																																																																																			
CONF	CONFERENCE	GFR	GLASS FIBER REINFORCED CONCRETE	MTG MOUNTING																																																																																																																																																																																																																																																																																																																																																																																																																																																																																																																																																																																																																																																																			
CONST	CONSTRUCTION	GFRG	GLASS FIBER REINFORCED GYPSUM	MTL METAL																																																																																																																																																																																																																																																																																																																																																																																																																																																																																																																																																																																																																																																																			
CONT	CONTINUOUS	GYP	GYPSUM	MULL MULLION																																																																																																																																																																																																																																																																																																																																																																																																																																																																																																																																																																																																																																																																			
CORR	CORRIDOR	GYP	GYPSUM	NCSBC 2018 NORTH CAROLINA STATE BUILDING CODE																																																																																																																																																																																																																																																																																																																																																																																																																																																																																																																																																																																																																																																																			
CPT	CARPET	GL	GLASS	N NORTH																																																																																																																																																																																																																																																																																																																																																																																																																																																																																																																																																																																																																																																																			
CT	CERAMIC TILE	GWB	GYPSUM WALL BOARD	NE NORTHEAST																																																																																																																																																																																																																																																																																																																																																																																																																																																																																																																																																																																																																																																																			
CW	CHILLED WATER	GYP	GYPSUM	NO NUMBER																																																																																																																																																																																																																																																																																																																																																																																																																																																																																																																																																																																																																																																																			
CY	CUBIC YARD	H	HOHES BIBB	NOT IN CONTRACT																																																																																																																																																																																																																																																																																																																																																																																																																																																																																																																																																																																																																																																																			
D	DEEP	HC	HANDICAPPED, HOLLOW CORE	NO NOMINAL																																																																																																																																																																																																																																																																																																																																																																																																																																																																																																																																																																																																																																																																			
DBL	DOUBLE	HD	HAND	NOM NOMINAL PIPE SIZE																																																																																																																																																																																																																																																																																																																																																																																																																																																																																																																																																																																																																																																																			
DET	DETAIL	HDR	HEADER	NTS NOT TO SCALE																																																																																																																																																																																																																																																																																																																																																																																																																																																																																																																																																																																																																																																																			
DF	DRINKING FOUNTAIN	HDWD	HARDWOOD	NW NORTHWEST																																																																																																																																																																																																																																																																																																																																																																																																																																																																																																																																																																																																																																																																			
DIA	DIA METER	HK	HOOK(S)	OFFICE OFFICE																																																																																																																																																																																																																																																																																																																																																																																																																																																																																																																																																																																																																																																																			
DIAG	DIAGONAL	HM	HOLLOW METAL	OFF OWNER FURNISHED OWNER																																																																																																																																																																																																																																																																																																																																																																																																																																																																																																																																																																																																																																																																			
DIM	DI MENSION	HORIZ	HORIZONTAL	OFF INSTALLED																																																																																																																																																																																																																																																																																																																																																																																																																																																																																																																																																																																																																																																																			
DN	DN DOWN	HP	HIGH POINT, HORSE POWER	OTH THICK, THICKNESS																																																																																																																																																																																																																																																																																																																																																																																																																																																																																																																																																																																																																																																																			
DR	DR DOOR	HR	HOUR	OTH OVERHEAD, OPPOSITE HAND																																																																																																																																																																																																																																																																																																																																																																																																																																																																																																																																																																																																																																																																			
DS	DS DOWNSPOUT	HS	HEAT STRENGTHENED	OPNG OPENING																																																																																																																																																																																																																																																																																																																																																																																																																																																																																																																																																																																																																																																																			
DWG(S)	DRAWING(S)	HT	HEIGHT	OPP OPPOSITE																																																																																																																																																																																																																																																																																																																																																																																																																																																																																																																																																																																																																																																																			
HVAC	HVAC	HVAC	HEATING VENTILATION AIR CONDITIONING	OTO OUT-TO-OUT																																																																																																																																																																																																																																																																																																																																																																																																																																																																																																																																																																																																																																																																			
E	EAST	HVT	HOMOGENEOUS VINYL TILE	P CONTRACTOR INSTALLED																																																																																																																																																																																																																																																																																																																																																																																																																																																																																																																																																																																																																																																																			
EA	EACH	I	INSIDE DIAMETER	PBD PARTICLE BOARD																																																																																																																																																																																																																																																																																																																																																																																																																																																																																																																																																																																																																																																																			
EF	EACH FACE	INSUL	INSULATION	PC PRECAST																																																																																																																																																																																																																																																																																																																																																																																																																																																																																																																																																																																																																																																																			
EIFS	EXTERIOR INSULATION FINISH SYSTEM	INT	INTERIOR	PERF PERFORATED																																																																																																																																																																																																																																																																																																																																																																																																																																																																																																																																																																																																																																																																			
EJ	EXPANSION JOINT	INV	INVERT	PL PLATE, PROPERTY LINE																																																																																																																																																																																																																																																																																																																																																																																																																																																																																																																																																																																																																																																																			
EL	ELEVATION	J	JANITOR	PLAM PLASTIC LAMINATE																																																																																																																																																																																																																																																																																																																																																																																																																																																																																																																																																																																																																																																																			
ELEC	ELECTRICAL	JAN	JANITOR CLOSET	U UNFINISHED																																																																																																																																																																																																																																																																																																																																																																																																																																																																																																																																																																																																																																																																			
ELEV	ELEVATION	JC	JOIST	UC UNDERCUT																																																																																																																																																																																																																																																																																																																																																																																																																																																																																																																																																																																																																																																																			
EQ	EQUAL	JST	JOINT	UH UNIT HEATER																																																																																																																																																																																																																																																																																																																																																																																																																																																																																																																																																																																																																																																																			
EQUIP	EQUIPMENT	JT		UNFIN UNFINISHED																																																																																																																																																																																																																																																																																																																																																																																																																																																																																																																																																																																																																																																																			
EW	EYE WASH, EACH WAY																																																																																																																																																																																																																																																																																																																																																																																																																																																																																																																																																																																																																																																																						
EWC	ELECTRIC WATER COOLER																																																																																																																																																																																																																																																																																																																																																																																																																																																																																																																																																																																																																																																																						
COORDINATION/INDICATION OF ENGINEERING WORK ON ARCHITECTURAL DRAWINGS:										Symbols										Construction Set																																																																																																																																																																																																																																																																																																																																																																																																																																																																																																																																																																																																																																																			
<p>13. WHERE HVAC OR OTHER MECHANICAL, ELECTRICAL AND PLUMBING ITEMS PENETRATE PARTITIONS, STUDS SHALL BE BRACED AND FRAMED TO STRUCTURE AS REQUIRED TO PROVIDE ADEQUATE SUPPORT. ALL PENETRATIONS THROUGH WALLS SHALL BE SEALED TO PROVIDE FIRE, SMOKE AND/OR ACOUSTIC ISOLATION SPACES.</p> <p>14. BEFORE PATCHING ANY FIRE-RATED CMU PARTITION, FILL ANY EXPOSED CELLS SOLID WITH GROUT.</p> <p>15. PROVIDE FINISHED WALL UNDER AND BEHIND WALL EQUIPMENT AND CASEWORK.</p> <p>16. WORK OF ENGINEERING DISCIPLINES IS SHOWN ON ARCHITECTURAL DRAWINGS FOR COORDINATION AND CONVENIENCE PURPOSES ONLY. REFER TO APPROPRIATE DISCIPLINE DRAWINGS FOR COMPLETE AND GOVERNING INFORMATION REGARDING THEIR WORK.</p> <p>17. SEE ARCHITECTURAL REFLECTED CEILING PLANS FOR LOCATION OF CEILING MOUNTED MECHANICAL, ELECTRICAL AND PLUMBING FIXTURES.</p> <p>18. WHERE EXPOSED STRUCTURE CEILING AREAS OCCUR IN ARCHITECTURAL REFLECTED CEILING PLANS, FULL DELINEATION OF STRUCTURAL, MECHANICAL, ELECTRICAL, PLUMBING, AND FIRE PROTECTION SYSTEMS IS NOT PROVIDED. SELECTED ELEMENTS AND DEVICES MAY BE SHOWN FOR LOCATION OR COORDINATION (E.G. LIGHT AND SPRINKLER SPACING).</p> <p>19. FOR ALL ELECTRICAL INSTALLED IN CUSTOM MADE PANELS, FURNITURE, AND OTHER BUILT-INS, ACCEPTANCE BY ELECTRICAL INSPECTOR IS BY NEC 110.2 AND NEC 110.3</p> <p>UNC STANDARD PRACTICES:</p> <p>20. GC TO FOLLOW UNC STORMWATER REQUIREMENTS FOR SMALL CONSTRUCTION PROJECTS, ESPECIALLY WHEN STAGING OR CONDUCTING ANY ACTIVITY OUTSIDE OF THE BUILDING.</p>										            										 <p><b>NOTCH DESIGN, PLLC</b> 212 W MAIN ST, SUITE E, CARRBORO, NC</p> <p><a href="http://www.notchdesign.us">www.notchdesign.us</a> <a href="mailto:info@notchdesign.us">info@notchdesign.us</a></p> <p>REVISION: SCO Review 9/15/25 2nd SCO Review 10/24/25 Construction Set 11/17/25 1. Addendum 1 1/7/26</p> <p><b>CONSTRUCTION SET</b></p> <p><b>JOSE R NOVA</b> REGISTERED ARCHITECT 11/17/2025 15566 NORTH CAROLINA CARRBORO, NC</p> <p>© 2025 Notch Design</p> <p><b>CLIENT NAME:</b> THE UNIVERSITY OF NORTH CAROLINA AT CHAPEL HILL <b>JOB NAME:</b> VENABLE HALL LOWER LEVEL UPFIT <b>LOCATION:</b> 101 South Rd <b>CITY:</b> CHAPEL HILL, NC 27514</p> <p><b>ISSUE DATE:</b> 5-21-25 <b>JOB NO.:</b> N092 <b>SCO #:</b> SCO # 24-28389-01A</p> <p><b>A000</b> <b>COVER SHEET</b></p>																																																																																																																																																																																																																																																																																																																																																																																																																																																																																																																																																																																																																																																			
 <p><b>VICINITY MAP</b></p> <p><b>PROJECT LOCATION:</b> VENABLE HALL, GROUND FLOOR 101 SOUTH RD CHAPEL HILL, NC 27514</p>		 <p><b>LOCATION MAP</b></p> <p><b>PROJECT LOCATION:</b> VENABLE HALL, GROUND FLOOR 101 SOUTH RD CHAPEL HILL, NC 27514</p>																																																																																																																																																																																																																																																																																																																																																																																																																																																																																																																																																																																																																																																																					

**2018 APPENDIX B**  
**BUILDING CODE SUMMARY FOR ALL COMMERCIAL PROJECTS**  
**(EXCEPT 1 AND 2-FAMILY DWELLINGS AND TOWNHOUSES)**  
 (Reproduce the following data on the building plans sheet 1 or 2)

Name of Project: UNC VENABLE HALL LOWER LEVEL UPFIT SCO # 24-28389-01A  
 Address: VENABLE HALL, GROUND FLOOR, 101 SOUTH ROAD, CHAPEL HILL, NC Zip Code 27514  
 Owner/Authorized Agent: CHRIS BOZZELLI Phone # ( 919 ) 962 - 9048 E-Mail bozzelli@email.unc.edu  
 Owned By:  City/County  Private  State  
 Code Enforcement Jurisdiction:  City  County  State

**CONTACT:**  
 DESIGNER FIRM NAME LICENSE # TELEPHONE # E-MAIL  
 Architectural Notch Design, PLLC Jose Noya 15566 (919) 260-5709 jose@notchdesign.us  
 Civil  
 Electrical McKim and Creed Jesse C. Alonzo 053121 (919) 233-8091 JAlonzo@mckimreed.com  
 Fire Alarm McKim and Creed Jesse C. Alonzo 053121 (919) 233-8091 JAlonzo@mckimreed.com  
 Plumbing McKim and Creed Mitchell A. Brown, PE 019692 (919) 233-8091 MBrown@mckimreed.com  
 Mechanical McKim and Creed Mitchell A. Brown, PE 019692 (919) 233-8091 MBrown@mckimreed.com  
 Sprinkler-Standpipe McKim and Creed Mitchell A. Brown, PE 019692 (919) 233-8091 MBrown@mckimreed.com  
 Structural  
 Retaining Walls >5' High  
 Other  
 ("Other" should include firms and individuals such as truss, precast, pre-engineered, interior designers, etc.)

**2018 NC BUILDING CODE:**  New Building  Addition  Renovation  
 1st Time Interior Completion  
 Shell/Core - Contact the local inspection jurisdiction for possible additional procedures and requirements  
 Phased Construction - Shell/Core- Contact the local inspection jurisdiction for possible additional procedures and requirements

**2018 NC EXISTING BUILDING CODE:** EXISTING:  Prescriptive  Repair  Chapter 14  
 Alteration:  Level I  Level II  Level III  
 Historic Property  Change of Use

**CONSTRUCTED:** (date) 2011 **CURRENT OCCUPANCY(S) (Ch. 3):** (B) - Business  
**RENOVATED:** (date)  **PROPOSED OCCUPANCY(S) (Ch. 3):** (B) - Business

**RISK CATEGORY (Table 1604.5):** Current:  I  II  III  IV  
 Proposed:  I  II  III  IV

**BASIC BUILDING DATA**  
 Construction Type:  I-A  II-A  III-A  IV  V-A  
 (check all that apply)  I-B  II-B  III-B  V-B  
 Sprinklers:  No  Partial  Yes  NFPA 13  NFPA 13R  NFPA 13D  
 Standpipes:  No  Yes Class  I  II  III  Wet  Dry  
 Fire District:  No  Yes Flood Hazard Area:  No  Yes  
 Special Inspections Required:  No  Yes (Contact the local inspection jurisdiction for additional procedures and requirements.)

Building Height (feet): 88.6  
 Number of Stories: 6  
 Mezzanine: No  
 High Rise: Yes

**SEISMIC DESIGN CATEGORY= B**

Gross building area: 160,458 SF  
 Area of work: 4,864 SF

FLOOR	EXISTING (SQ FT)	NEW (SQ FT)	SUB-TOTAL
Penthouse	15,9332	0	15,9332
Floor 4	25,780	0	25,780
Floor 3	27,952	0	27,952
Floor 2	27,867	0	27,867
Floor 1	29,856	0	29,856
Floor G	33,071	0	33,071
<b>TOTAL</b>	<b>160,458</b>	<b>0</b>	<b>160,458</b>

**SEE A-002 FOR OCCUPANT LOAD CALCULATIONS**

FIRE PROTECTION REQUIREMENTS						
BUILDING ELEMENT	FIRE SEPARATION DISTANCE (FEET)	REQ'D	RATING PROVIDED (W/ REDUCTION)	DETAIL # AND SHEET #	DESIGN # FOR RATED ASSEMBLY	Sheet # for rated penetration
Structural Frame, including columns, girders, trusses		2-Hr	1-Hr roof only (601 "a")	No new structural frame construction		
Bearing Walls		2-Hr		No new bearing wall construction		
Exterior		2-Hr				
North		2-Hr				
East		2-Hr				
West		2-Hr				
South		2-Hr				
Interior		2-Hr		No new bearing wall construction		
Nonbearing Walls and Partitions		0-Hr		No new rated wall construction		
Exterior walls		0-Hr				
North		0-Hr				
East		0-Hr				
West		0-Hr				
South		0-Hr				
Interior walls and partitions		0-Hr		No new rated partition construction		
Floor Construction		2-Hr		No new floor construction		
Including supporting beams and joists		2-Hr				
Floor/Ceiling Assembly		2-Hr				
Columns Supporting Floors		2-Hr				
Roof Construction, including supporting beams and joists		1-Hr		No new roof construction		
Roof/Ceiling Assembly		1-Hr				
Columns Supporting Roof		1-Hr				
Shaft Enclosures - Exit		2-Hr				
Shaft Enclosures - Other		2-Hr		No new shaft construction		
Corridor Separation		1-Hr	0 (1020.1 "c")	N/A	N/A	N/A
Occupancy/Fire Barrier Separation		N/A	N/A	N/A	N/A	N/A
Party/Fire Wall Separation		N/A	N/A	N/A	N/A	N/A
Smoke Barrier Separation		N/A	N/A	N/A	N/A	N/A
Smoke Partition		N/A	N/A	N/A	N/A	N/A
Tenant/Dwelling Unit/Sleeping Unit Separation		N/A	N/A	N/A	N/A	N/A
Incidental Use Separation		N/A	N/A	N/A	N/A	N/A

\* Indicate section number permitting reduction

**LIFE SAFETY SYSTEM REQUIREMENTS**

Emergency Lighting:  No  Yes  
 Exit Signs:  No  Yes  
 Fire Alarm:  No  Yes  
 Smoke Detection Systems:  No  Yes  Partial \_\_\_\_\_  
 Carbon Monoxide Detection:  No  Yes

**LIFE SAFETY PLAN REQUIREMENTS**

Life Safety Plan Sheet #: A002

- Fire and/or smoke rated wall locations (Chapter 7)
- Assumed and real property line locations (if not on the site plan) **(N/A to this interior renovation)**
- Exterior wall opening area with respect to distance to assumed property lines (705.8) **(N/A to this interior renovation)**
- Occupancy Use for each area as it relates to occupant load calculation (Table 1004.1.2) **(N/A to this interior renovation)**
- Occupant loads for each area **(see A-002)**
- Exit sign locations (1013) **(see 2E-200)**
- Exit access travel distances (1017) **(No exit travel path changes)**
- Common path of travel distances (Tables 1006.2.1 & 1006.3.2(1)) **(No exit travel path changes)**
- Dead end lengths (1020.4) **(No exit travel path changes)**
- Clear exit widths for each exit door **(see A-002)**
- Maximum calculated occupant load capacity each exit door can accommodate based on egress width (1005.3) **(see A-002)**
- Actual occupant load for each exit door **(see A-002)**
- A separate schematic plan indicating where fire rated floor/ceiling and/or roof structure is provided for purposes of occupancy separation **(N/A)**
- Location of doors with panic hardware (1010.1.10) **(see A-002)**
- Location of doors with delayed egress locks and the amount of delay (1010.1.9.7) **(N/A)**
- Location of doors with electromagnetic egress locks (1010.1.9.9) **(N/A)**
- Location of doors equipped with hold-open devices **(N/A)**
- Location of emergency escape windows (1030) **(N/A)**
- The square footage of each fire area (202) **(N/A, no changes to building fire areas)**
- The square footage of each smoke compartment for Occupancy Classification I-2 (407.5) **(N/A)**
- Note any code exceptions or table notes that may have been utilized regarding the items above

**ACCESSIBLE DWELLING UNITS**  
 (SECTION 1107)  
**(Not applicable)**

**ACCESSIBLE PARKING**  
 (SECTION 1106)  
**(N/A)**

**PLUMBING FIXTURE REQUIREMENTS**  
 (TABLE 2902.1)  
**(Unchanged)**

**SPECIAL APPROVALS**  
**(No special approvals required at this time)**

**ENERGY SUMMARY**  
**(Not applicable, no changes to thermal envelope by this interior renovation)**

**2018 APPENDIX B**  
**BUILDING CODE SUMMARY FOR ALL COMMERCIAL PROJECTS**

MECHANICAL DESIGN

(PROVIDE ON THE MECHANICAL SHEETS IF APPLICABLE)

**(SEE M001)**

**2018 APPENDIX B**  
**BUILDING CODE SUMMARY FOR ALL COMMERCIAL PROJECTS**

ELECTRICAL DESIGN

(PROVIDE ON THE ELECTRICAL SHEETS IF APPLICABLE)

**(SEE E002)**



NOTCH DESIGN, PLLC  
 212 W MAIN ST, SUITE E,  
 CARRBORO, NC  
 www.notchdesign.us  
 info@notchdesign.us

© 2025  
 Notch Design

THE UNIVERSITY OF NORTH CAROLINA AT CHAPEL HILL  
 101 South Rd  
 CHAPEL HILL, NC 27514  
 ISSUE DATE: 5-21-25  
 JOB NO: N092  
 SCO # 24-28389-01A

A001  
 APPENDIX B





NOTCH DESIGN, PLLC  
212 W MAIN ST, SUITE E,  
CARRBORO, NC

www.notchdesign.us  
info@notchdesign.us

REVISION:  
SCO Review 9/15/25  
2nd SCO Review 10/24/25  
Construction Set 11/17/25

## CONSTRUCTION SET




© 2025  
Notch Design

CLIENT NAME: THE UNIVERSITY OF NORTH CAROLINA AT CHAPEL HILL  
PROJ. NAME: UNC VENABLE HALL LOWER LEVEL UPGRADE  
LOCATION: VENABLE HALL LOWER LEVEL  
101 South Rd  
CHAPEL HILL, NC 27514

ISSUE DATE: 5-21-25  
JOB NO.: N092  
SCO # 24-28389-01A

**A100**  
GROUND FLOOR  
EXISTING PLAN

1 GROUND FLOOR PLAN EXISTING

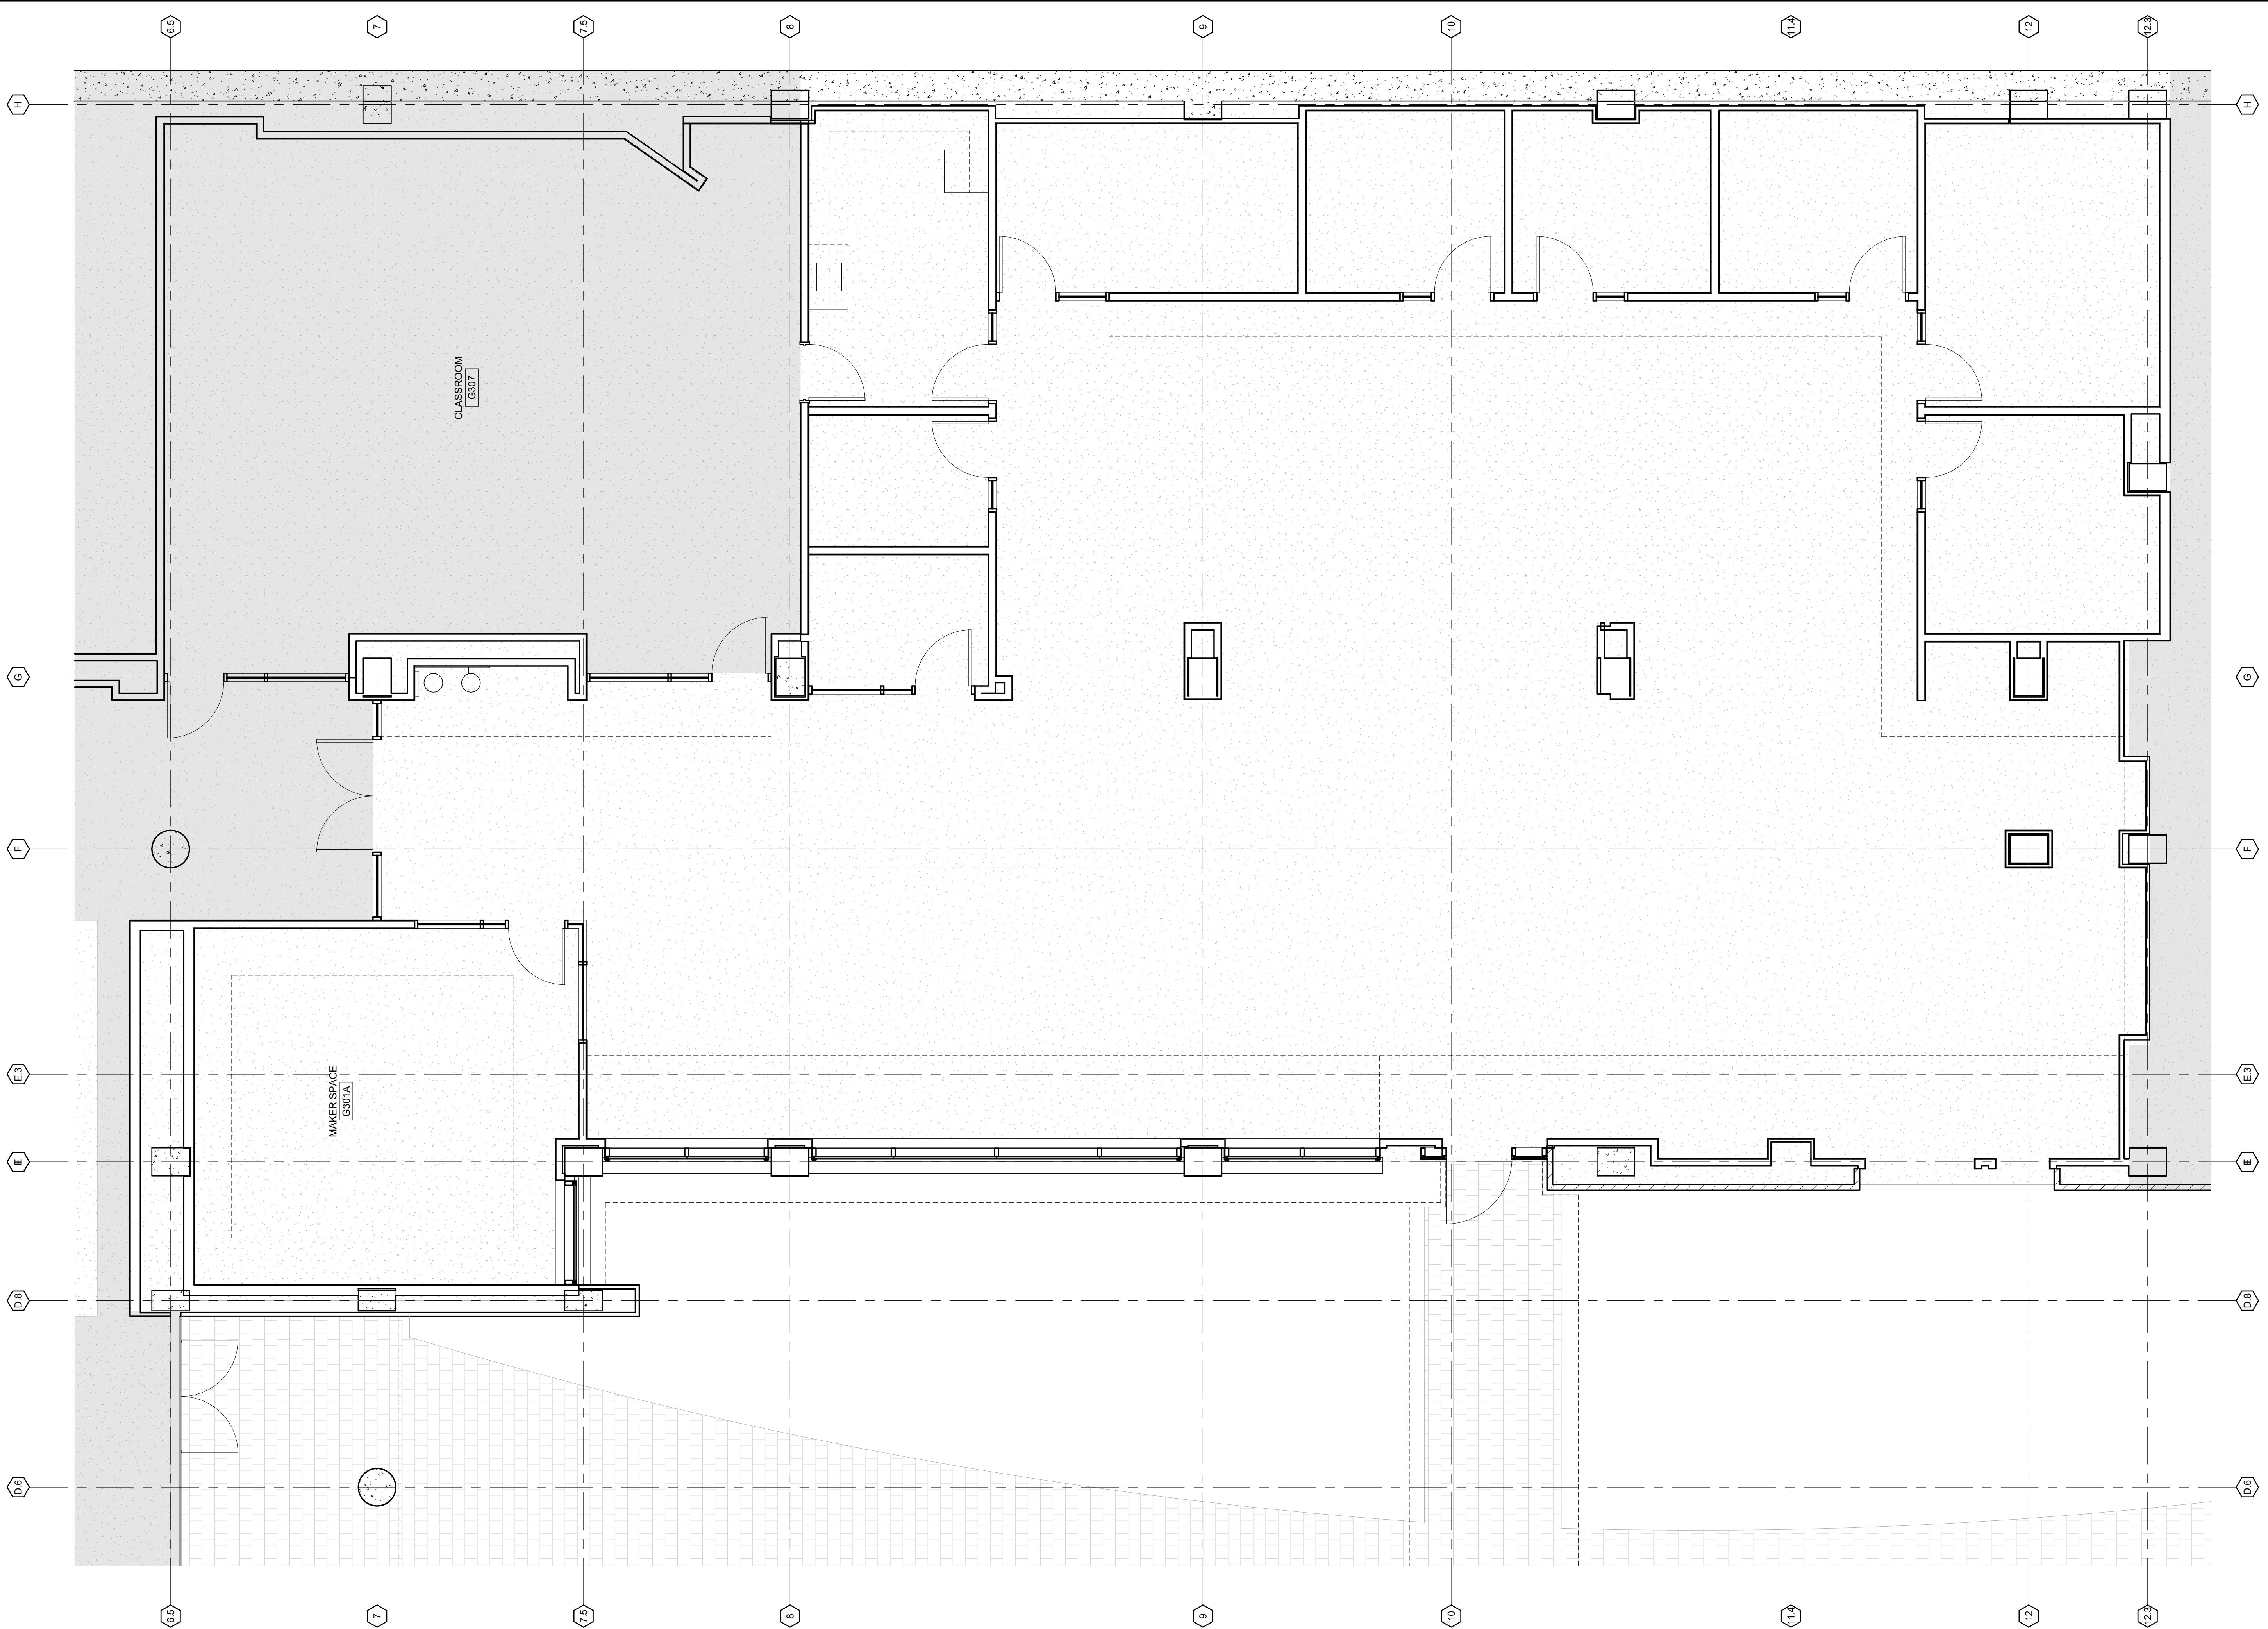




NOTCH DESIGN, PLLC  
212 W MAIN ST, SUITE E,  
CARRBORO, NC

[www.notchdesign.us](http://www.notchdesign.us)  
[info@notchdesign.us](mailto:info@notchdesign.us)

REVISION:  
SCO Review 9/15/25  
2nd SCO Review 10/24/25  
Construction Set 11/17/25

## CONSTRUCTION SET

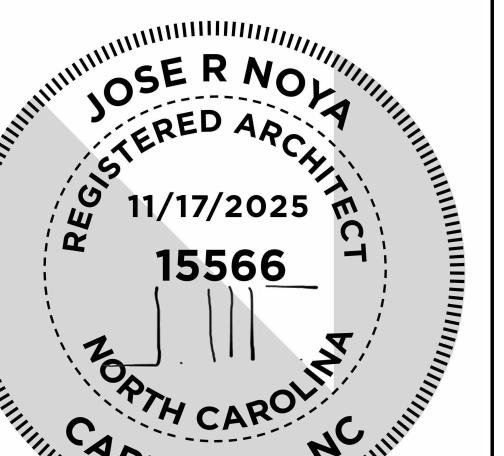

© 2025  
Notch Design


CLIENT NAME: THE UNIVERSITY OF NORTH CAROLINA AT CHAPEL HILL  
PROJ. NAME: UNC VENABLE HALL LOWER LEVEL  
LOCATION: 101 South Rd  
CHAPEL HILL, NC 27514

ISSUE DATE: 5-21-25  
JOB NO.: N092  
SCO # 24-28389-01A

**A100.1**

GROUND FLOOR  
EXISTING RCP

1 GROUND FLOOR EXISTING RCP

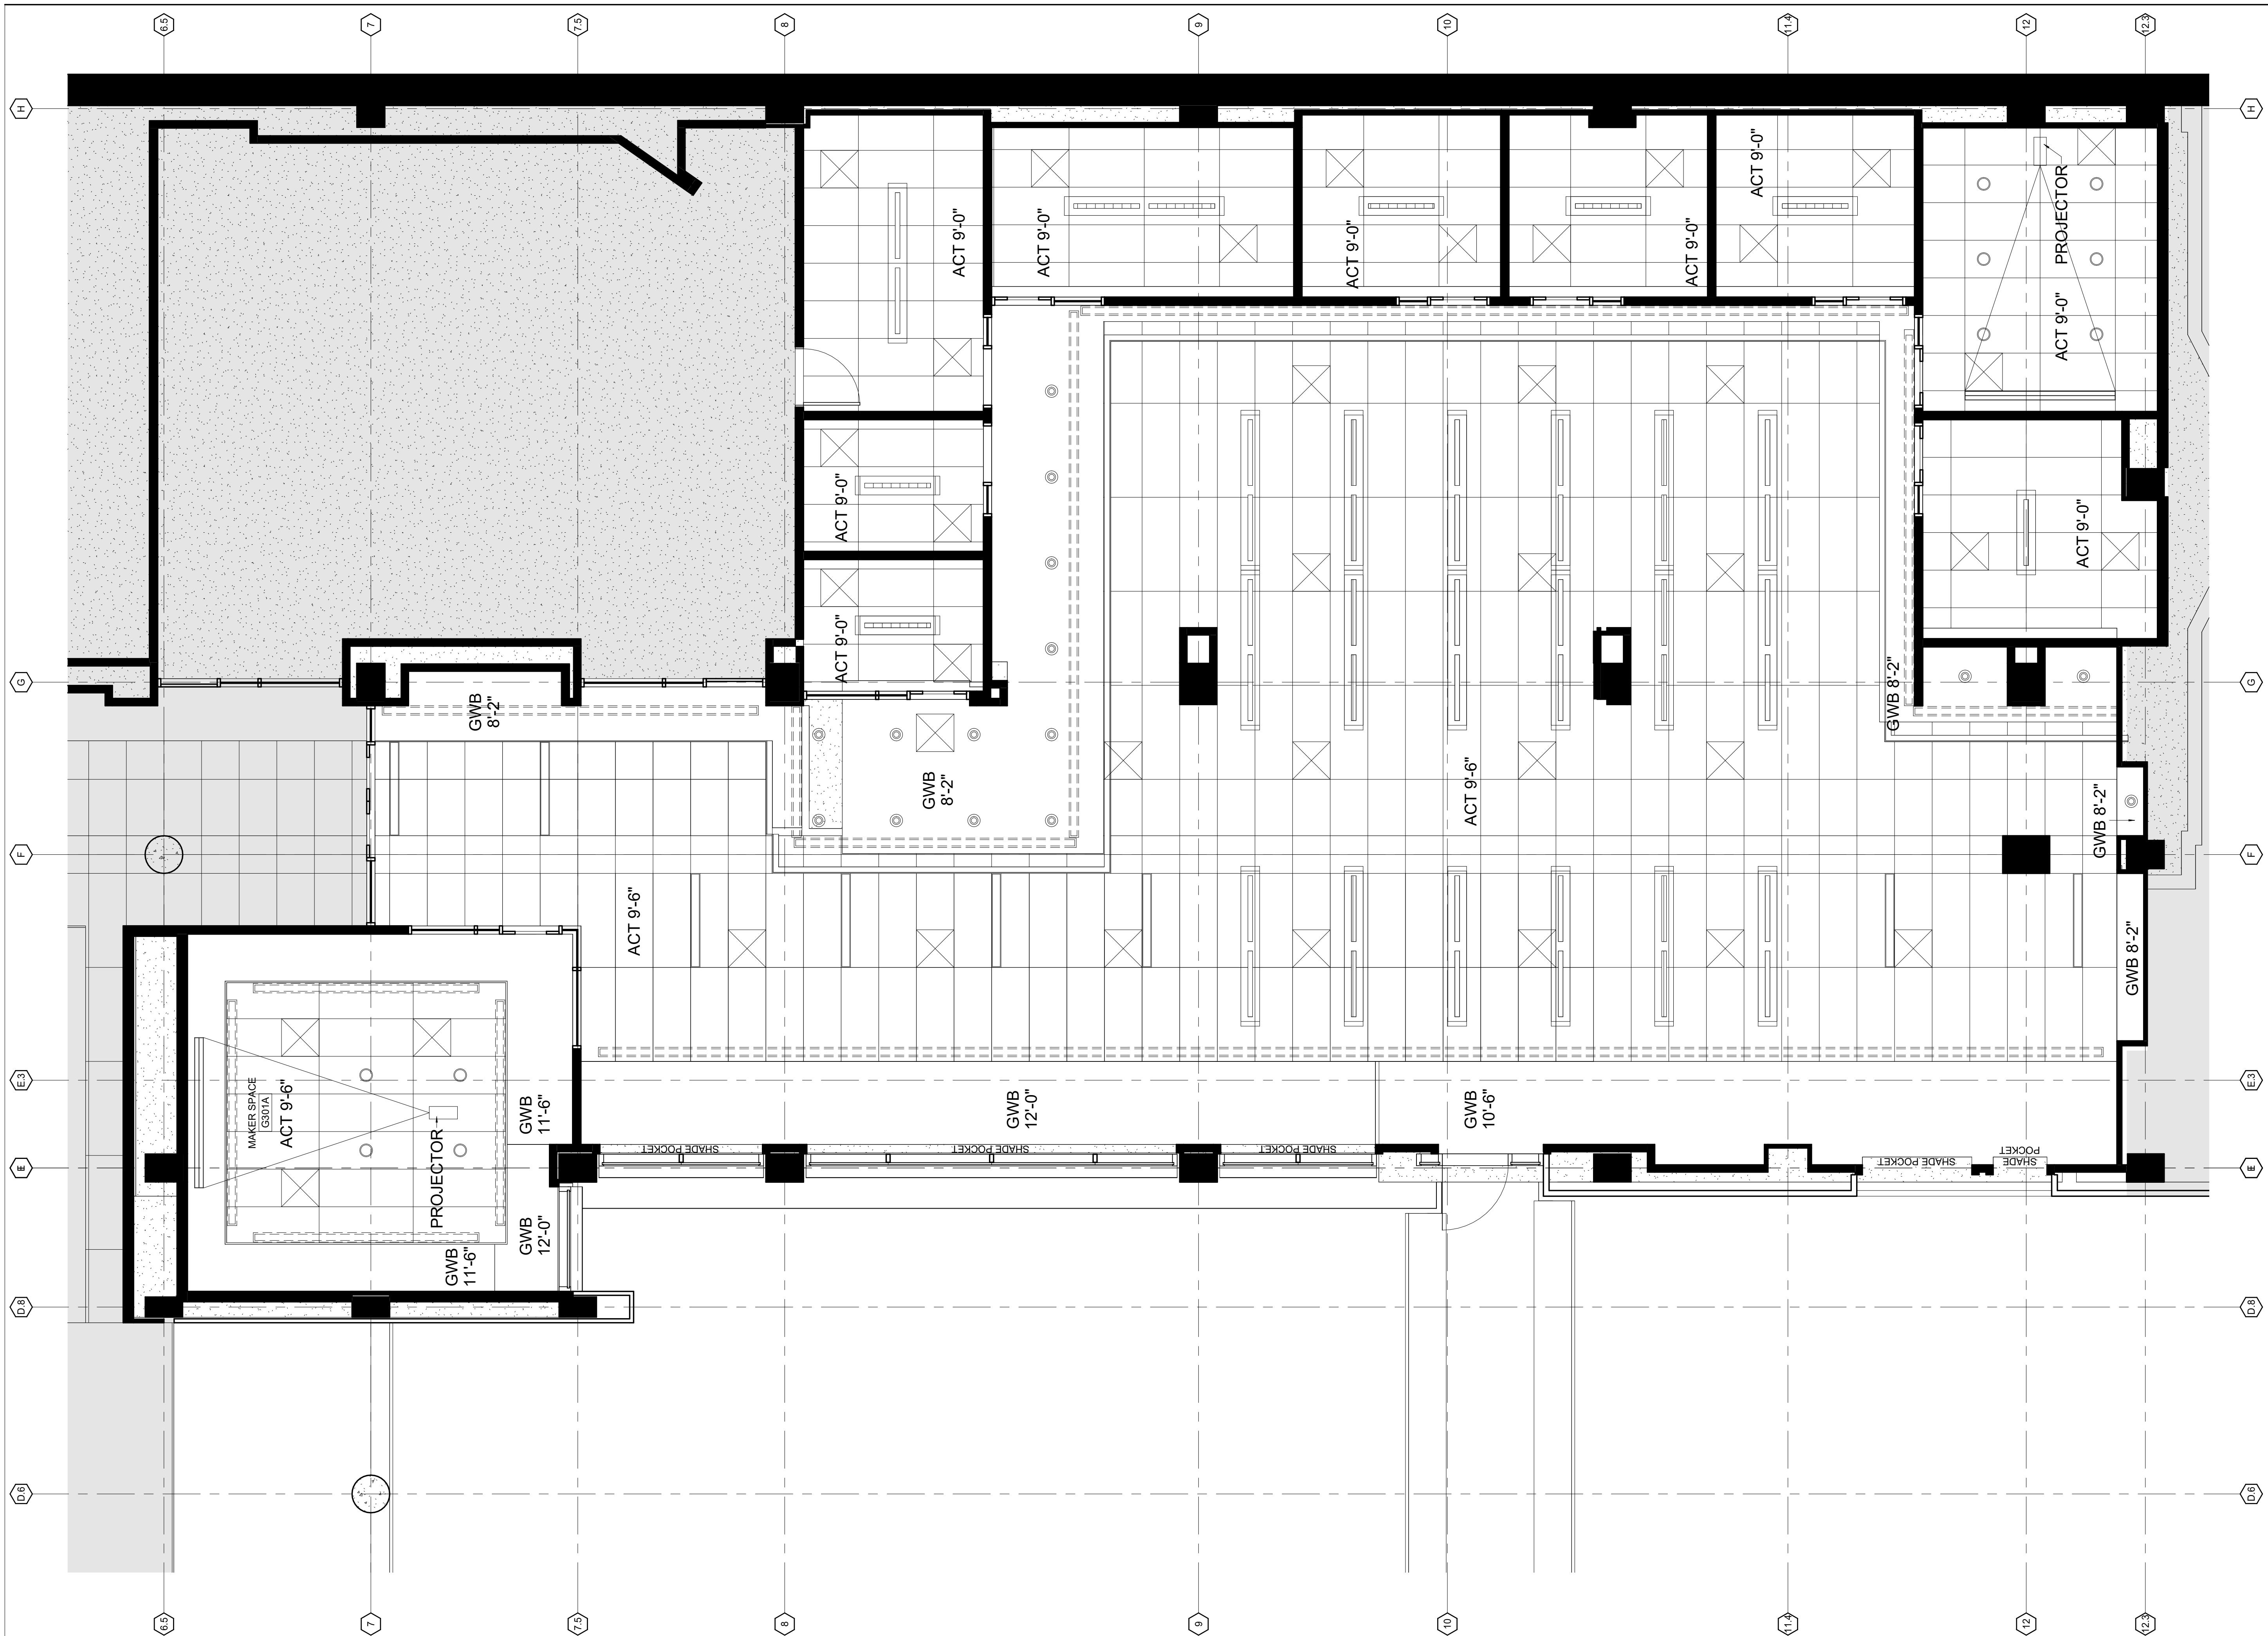








NOTCH DESIGN, PLLC  
212 W MAIN ST, SUITE E,  
CARRBORO, NC

www.notchdesign.us  
info@notchdesign.us

REVISION:  
SCO Review 9/15/25  
2nd SCO Review 10/24/25  
Construction Set 11/17/25  
1 Addendum 1 1/7/26

## CONSTRUCTION SET

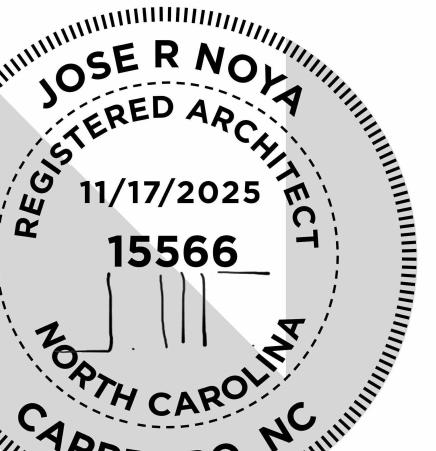

© 2025  
Notch Design

THE UNIVERSITY OF NORTH CAROLINA AT CHAPEL HILL  
UNC VENABLE HALL LOWER LEVEL UPGRADE  
VENABLE HALL LOWER LEVEL  
101 South Rd  
CHAPEL HILL, NC 27514

CLIENT NAME: THE UNIVERSITY OF NORTH CAROLINA AT CHAPEL HILL  
JOB NO.: NO92  
SCO # 24-28389-01A


ISSUE DATE: 5-21-25  
JOB NO.: NO92  
SCO # 24-28389-01A

A102

NEW WORK PLAN

DIMENSIONS TO FINISHED FACE U.N.O.

1	NEW WORK PLAN
	1/4" = 1'-0"

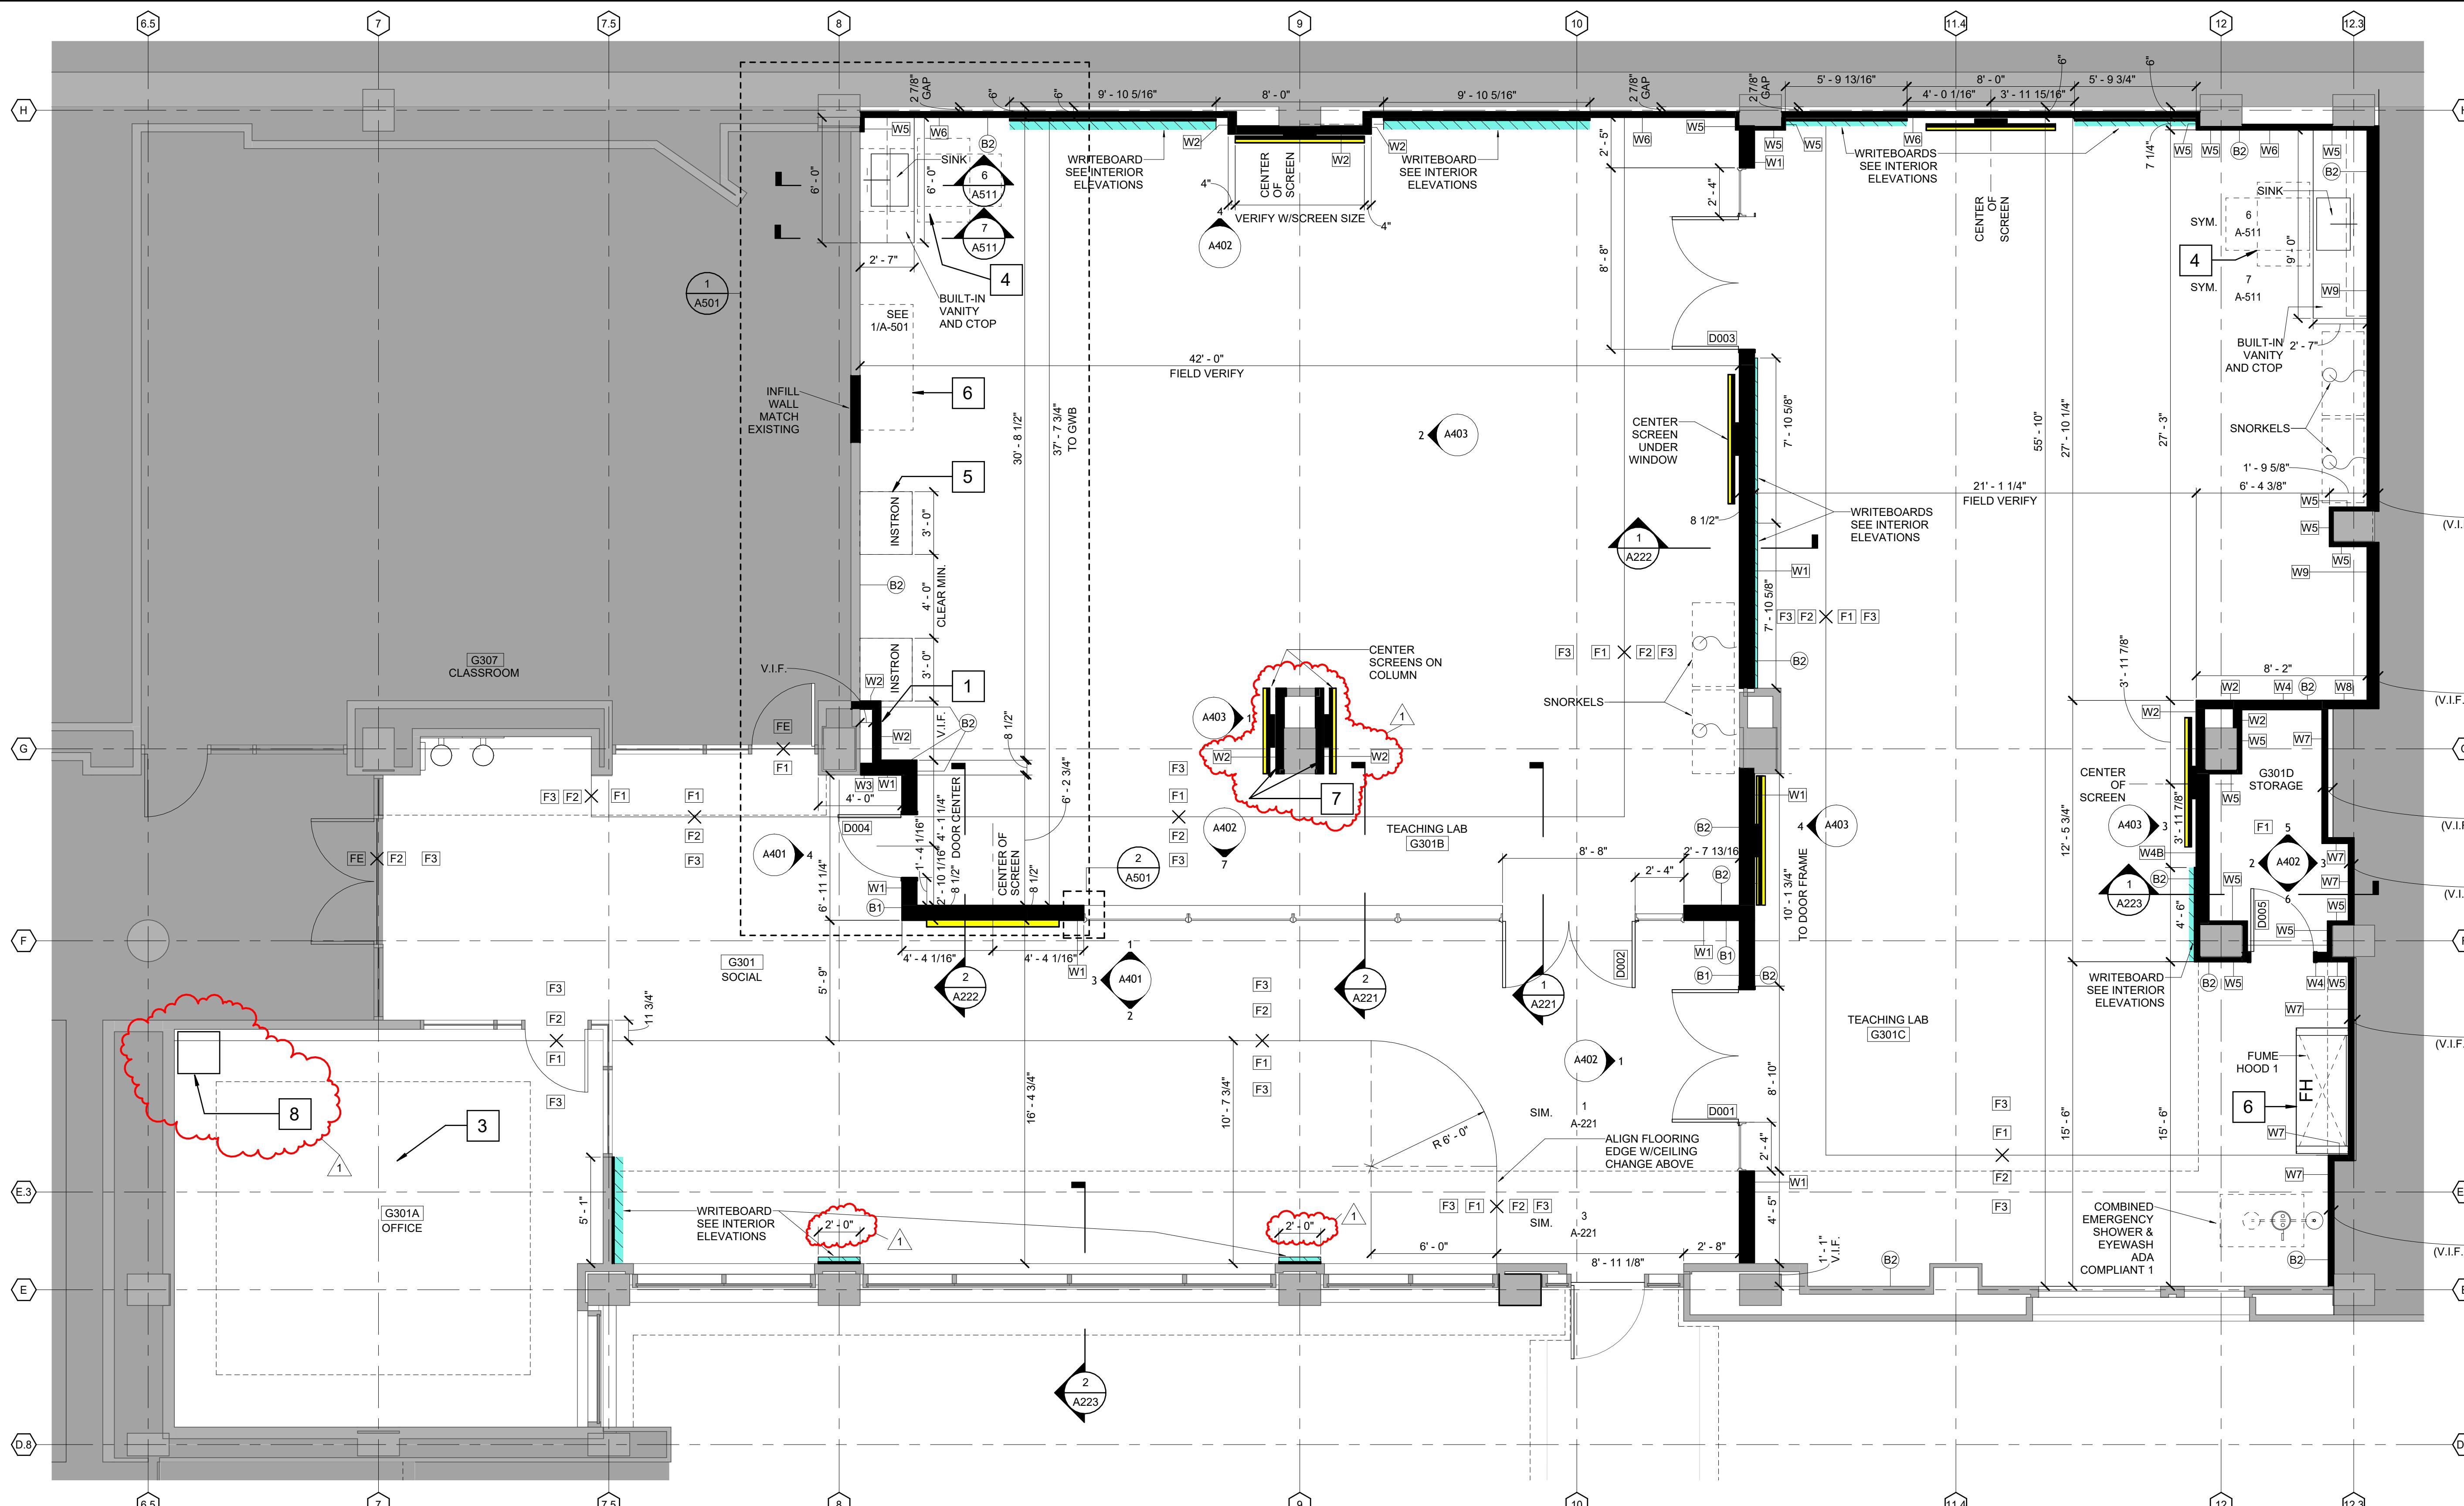

### FLOOR PLAN GENERAL NOTES


- ALL EXISTING CONDITIONS AND DIMENSIONS TO BE FIELD VERIFIED
- SEE A-601 FOR INTERIOR WALL TYPES
- SEE A-601 FOR WINDOW SCHEDULE
- SEE A-601 FOR DOOR SCHEDULE
- SEE A-601 FOR FLOOR AND WALL FINISH SCHEDULE
- SEE A-601 FOR BASE SCHEDULE
- REFER TO 3A-501 FOR FINAL FLOORING PATTERN
- ALL EXISTING AND NEW PARTITION AND FERRING WALLS WITHIN THE OPEN-CEILING AREAS TO BE EXTENDED AND FINISHED UP TO THE BOTTOM OF STRUCTURAL SLAB ABOVE.
- FURNITURE SHOWN FOR INFORMATIONAL PURPOSES ONLY, FF&E NOT IN SCOPE OF THIS PLAN
- ALL EXISTING WALLS TO RECEIVE NEW PAINT
- OWNER TO PROVIDE SPECS FOR DISPLAY SCREENS. COORDINATE MOUNTING LOCATIONS WITH ARCHITECT AND POWER AND DATA NEEDS WITH ARCHITECT AND MEP ENGINEER. DISPLAY SCREENS OR OTHER OBJECTS SHOULD NOT ENCRAGE MORE THAN 4 INCHES FROM ADA COMPLIANCE
- PROVIDE BLOCKING AS REQD. FOR DISPLAY SCREENS, WRITEBOARDS AND ANY OTHER WALL-MOUNTED ITEMS
- FUME HOOD PROVIDED BY OWNER. CONTRACTOR INSTALLED. MODEL: CONTINUOUS SPEED KEWAUNEE TRUVIEW
- SNORKELS AND INSTRUMENTS ARE FF&E ITEMS OWNER PROVIDED. SHOWING HERE FOR REFERENCE
- INTERIOR AND EXTERIOR SIGNS IDENTIFYING PERMANENT ROOMS AND SPACES SHALL HAVE BOTH THE NAME AND NUMBER IN RAISED LETTERS AND BRAILLE THAT COMPLIES WITH THE CURRENT ACCESSIBILITY CODES.
- A MINIMUM OF ONE EACH TYPE OF EQUIPMENT PROVIDED IN EACH LABORATORY MUST BE ACCESSIBLE
- A MINIMUM OF ONE EACH TYPE OF STORAGE PROVIDED IN EACH LABORATORY MUST BE ACCESSIBLE
- PROVIDE ACCESSIBLE FURNITURE AS REQUIRED BY NCBC CHAPTER 11 AND ICC A117.1

### PLAN KEYED NOTES

- 1 FURR AS NEEDED TO ACCOMMODATE NEW DRAIN LEADER ADJACENT TO COLUMN, REFER TO PLUMBING SANITARY GROUND PLAN (P111).
- 2 REVERSE SWING
- 3 PAINT EXISTING OFFICE'S WALLS AND BASEBOARDS TO MATCH G301 SOCIAL AND TEACHING LABS.
- 4 ADA COMPLIANT CLEAR FLOOR SPACE PROVIDED PER NCBC CHAPTER 11 AND ICC A117.1. SHOWN AS DASHED LINE
- 5 INSTRON MACHINE TO BE ADA COMPLIANT / ICC A117.1
- 6 HOOD MODEL: KEWAUNEE TRUVIEW SUPREME AIR, ADA COMPLIANT OPTION / ICC A117.1
- 7 SEE KEYED PLAN NOTE 7 ON 1A101 - NEW STUDS MAY NOT BE REQUIRED IF EXISTING DEPTH IS ENOUGH. FIELD VERIFY BEFORE DEMO
- 8 FUTURE LOCATION OF IT/AV RACK. SEE ELECTRICAL DRAWINGS

### FLOOR PLAN LEGEND


- EXISTING WALLS
- NEW WALLS
- DISPLAY SCREEN W/ OPTIONAL FLEXIBLE ARM, ADA COMPLIANT
- GLASS WRITABLE SURFACE
- INSTRON
- INSTRON TESTING MACHINE ON TABLE, 115" TOTAL HEAD CLEARANCE NEEDED

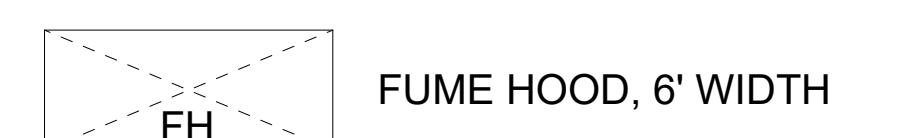

FUME HOOD, 6' WIDTH



SNORKEL WORK AREA  
4' WIDTH

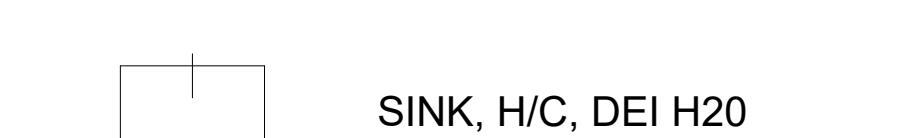

COMBINED  
EYEWASH  
AND SHOWER  
ADA  
COMPLIANT



SINK, H/C, DEI H20



DIGITAL DISPLAY, FLUSH  
MOUNTED, ADA COMPLIANT




NOTCH DESIGN, PLLC  
212 W MAIN ST, SUITE E,  
CARRBORO, NC

www.notchdesign.us  
info@notchdesign.us

REVISION:  
SCO Review 9/15/25  
2nd SCO Review 10/24/25  
Construction Set 11/17/25  
1 Addendum 1 1/7/26

## CONSTRUCTION SET

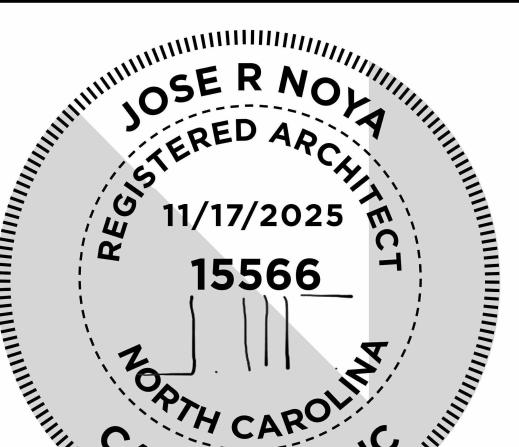

© 2025  
Notch Design


THE UNIVERSITY OF NORTH CAROLINA AT CHAPEL HILL

UNC VENABLE HALL LOWER LEVEL

VENABLE HALL LOWER LEVEL

101 South Rd

CHAPEL HILL, NC 27514

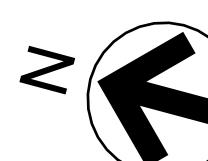


CLIENT NAME: THE UNIVERSITY OF NORTH CAROLINA AT CHAPEL HILL  
PROJ. NAME: UNC VENABLE HALL LOWER LEVEL  
LOCATION: 101 South Rd, CHAPEL HILL, NC 27514

ISSUE DATE: 5-21-25  
JOB NO.: N092  
SCO # 24-28389-01A

A102.1

NEW WORK RCP

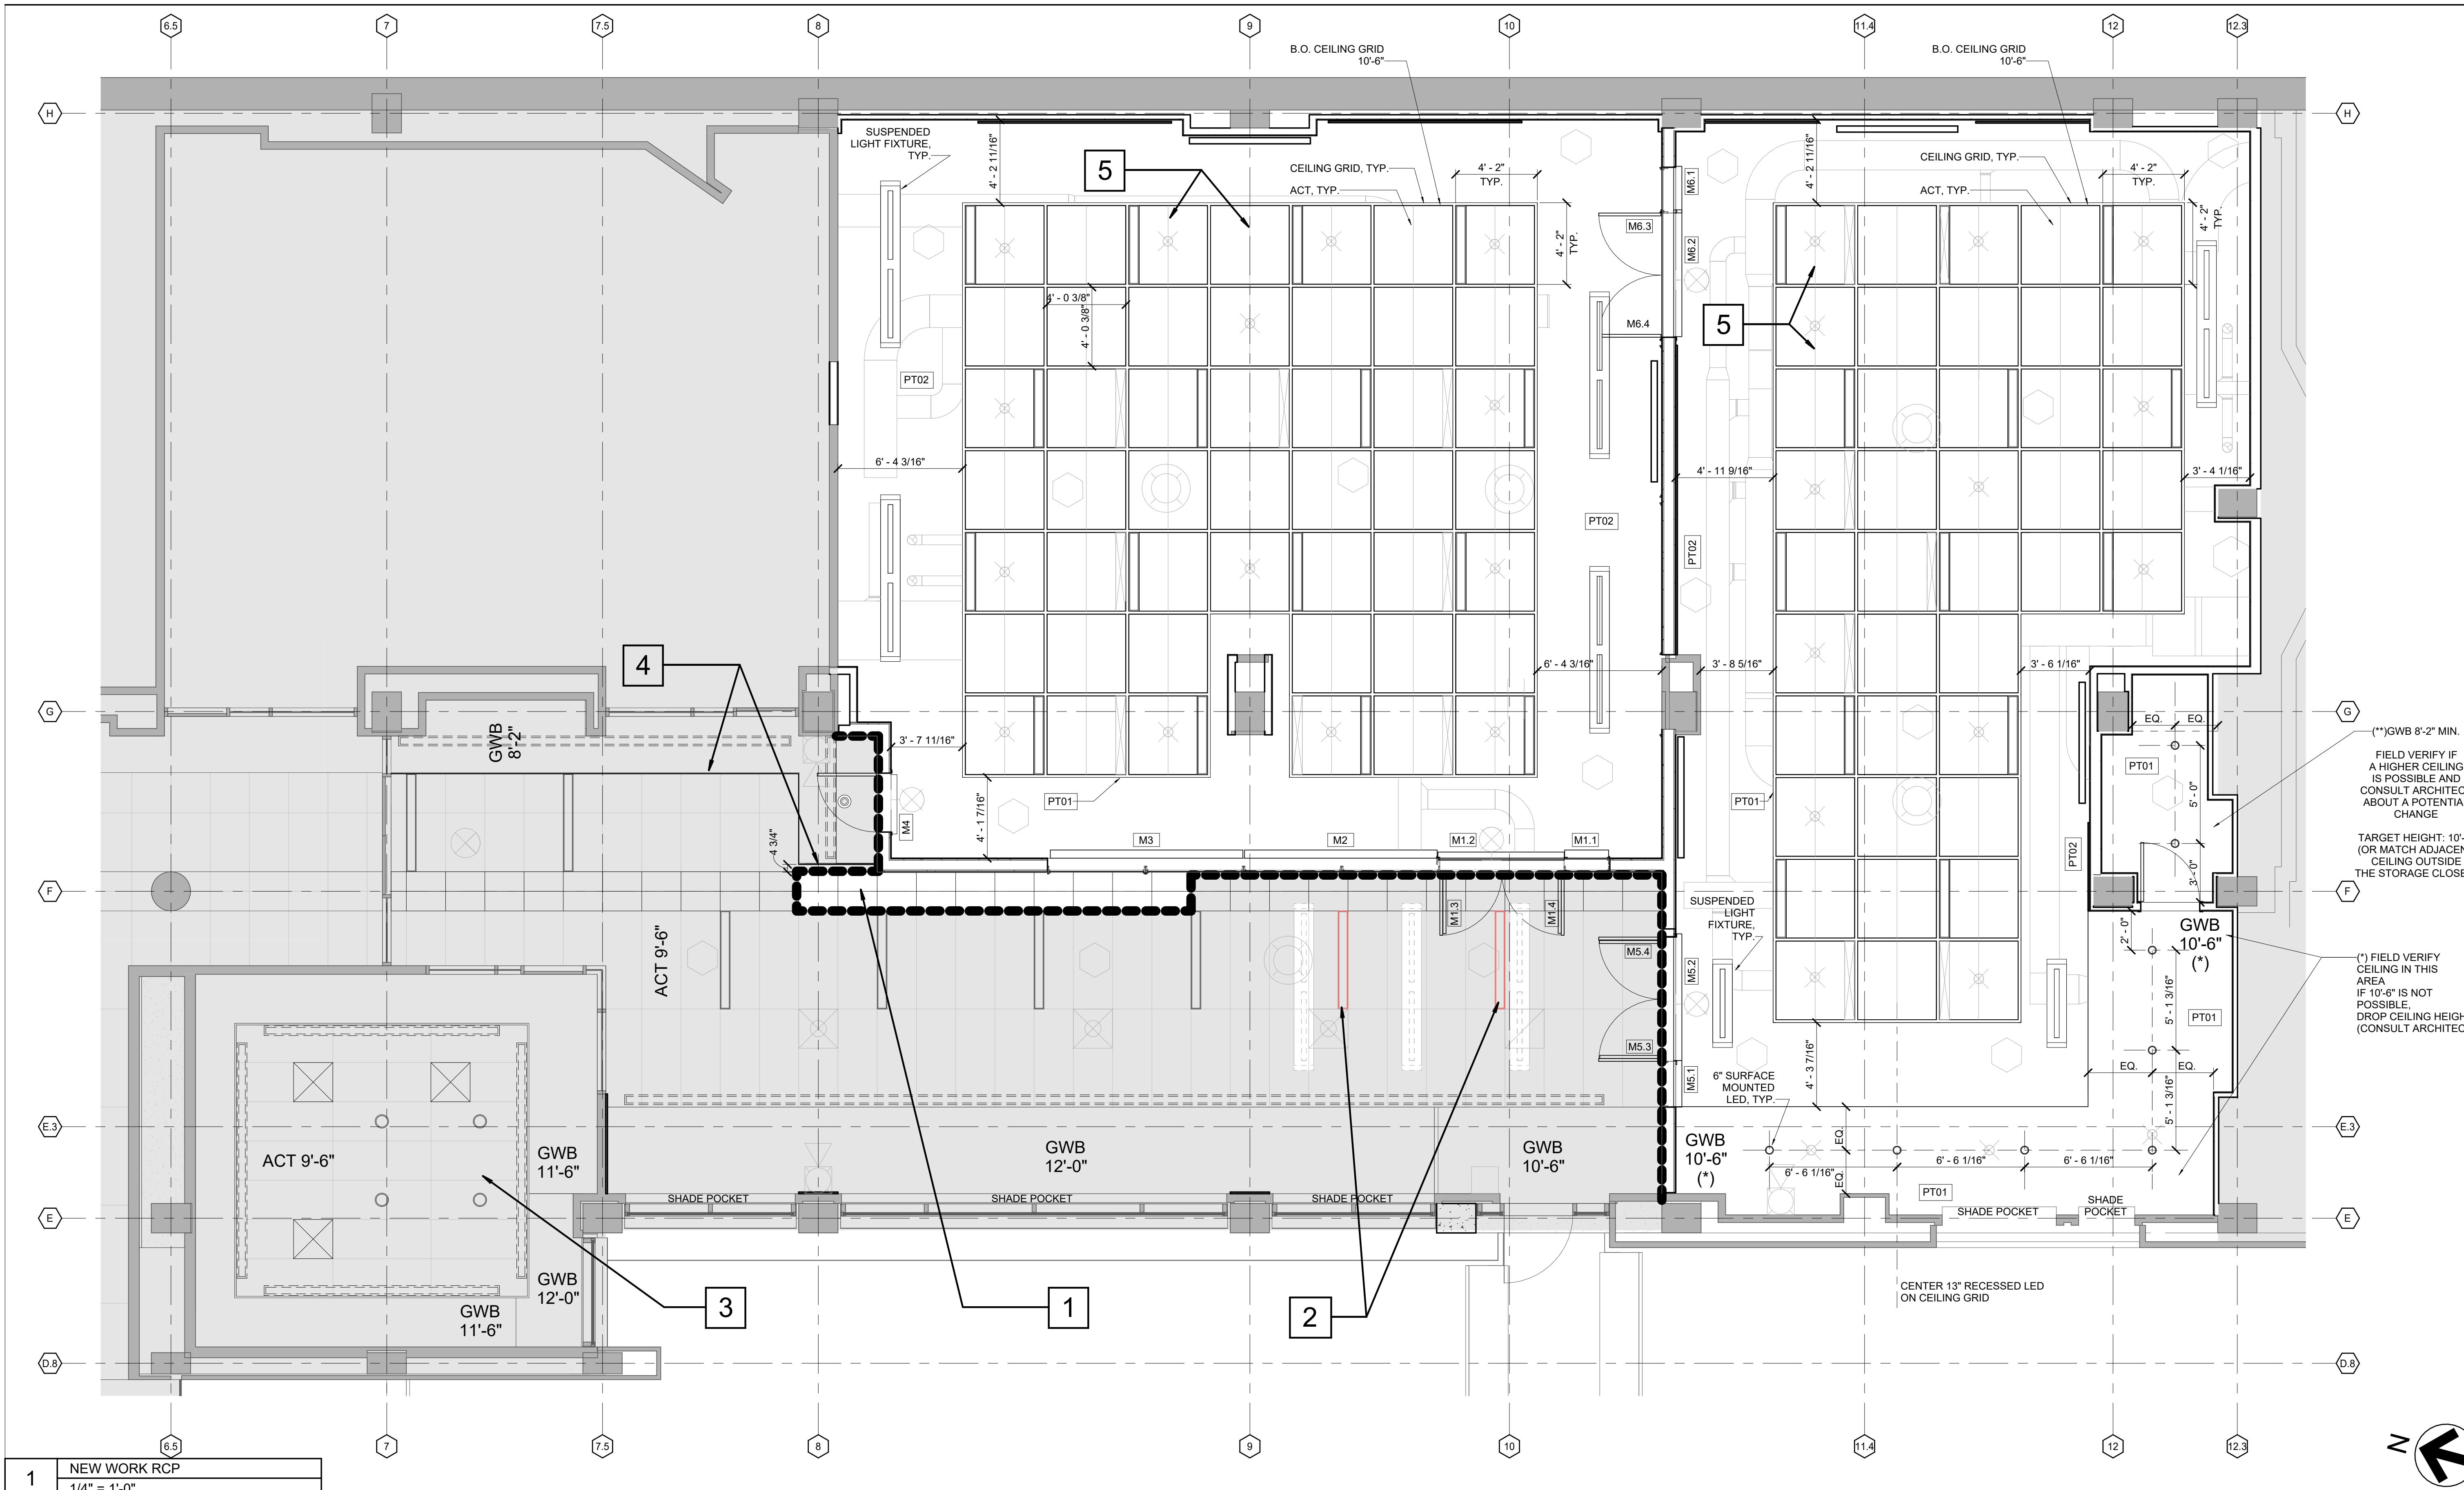

1 NEW WORK RCP  
1/4" = 1'-0"

### REFLECTED CEILING PLAN GENERAL NOTES

- ALL EXISTING CONDITIONS AND DIMENSIONS TO BE FIELD VERIFIED
- NEW PARTITION TO BE FINISHED WITH DRYWALL UP TO THE BOTTOM OF SLAB ABOVE WITHIN LAB 1 AND LAB 2
- GEN. CONTRACTOR IS RESPONSIBLE TO HIRE UNISTRUT SUBCONTRACTOR TO DESIGN AND INSTALL UNISTRUT GRID SYSTEM. CONTACT MATT FRALICK WITH UNISTRUT MIDWEST 216-804-1912
- SEE A-601 FOR MANUAL SPRINKLER SHADERS SCHEDULE
- SEE A-601 FOR SCHEDULES
- BOTTOM OF SUSPENDED LIGHT FIXTURES IN ROOMS G301B AND G301C TO MATCH THE BOTTOM OF THE CEILING GRID. FIELD VERIFY / COORDINATE WITH ARCHITECT
- LOCATE FIRE DETECTION DEVICES A MINIMUM OF THREE FEET FROM SUPPLY OR RETURN DIFFUSERS. SEE FIRE PROTECTION, FIRE ALARM, ELECTRICAL AND MECHANICAL DRAWINGS
- SEE FIRE PROTECTION DRAWINGS FOR FINAL LOCATIONS OF SPRINKLER HEADS. SMALL ADJUSTMENTS MAY BE NEEDED AT THE SITE TO COORDINATE HEADS WITH THE FINAL ACT CEILING LAYOUT. GC TO SUBMIT COORDINATED SHOP DRAWINGS FOR ACT CEILING AND SPRINKLER HEADS FOR ARCHITECT'S REVIEW

### REFLECTED CEILING PLAN KEYED NOTES

- INFILL AREA WITH ACT TO MATCH EXISTING ADJACENT PANELS. PROVIDE NEW TILES TO MATCH THE EXISTING OR G.C. TO ASSESS IF REUSING SOME OF THE EXISTING TILES IS POSSIBLE.
- NEW LINE FIXTURES TO MATCH EXISTING IN ADJACENT CEILING AREAS. REFER TO ELECTRICAL DRAWINGS AND SPECIFICATIONS. RE-USE THE EXISTING LIGHT FIXTURES IF POSSIBLE PER A101.1/ PLAN KEYED NOTE 5
- PATCH AND REPAIRS REQUIRED TO MATCH THE EXISTING CEILING. SEE A101.1/ PLAN KEYED NOTE 5
- MATCH EXISTING CLOUD CEILING EDGE DETAIL. STOP 4 1/2" SHORT BEFORE THE NEW WALL PER DIMENSION CALLED OUT ON THE PLAN
- LIGHT GRAY LINE INDICATES TYPICAL ACT JOINT. 2X NOMINAL ACT TILES. ATTACH ACT CHANNELS TO STRUCTURAL CEILING GRID. CUT TILES THAT ARE ADJACENT TO LIGHT FIXTURE AS NEEDED TO KEEP THE LINEAR PATTERN CONSISTENT.

NEW WORK RCP




# NOTCH

**NOTCH DESIGN, PLLC**  
1212 W MAIN ST, SUITE E,  
CARRBORO, NC

www.notchdesign.us  
info@notchdesign.us

N:  
iew 9/15/25  
Review 10/24/25  
ion Set 11/17/25

# CONSTRUCTION SET

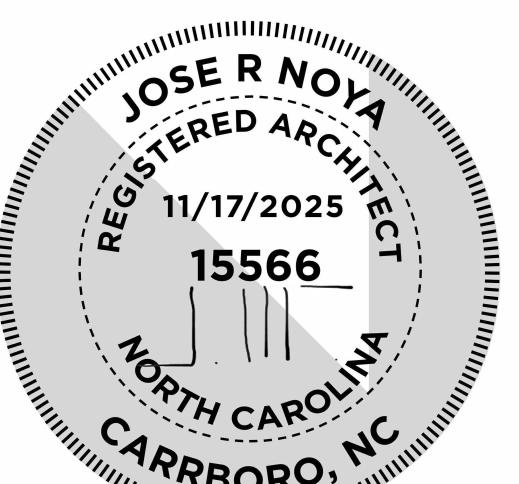


© 2025  
Notch Design

† NAME \_\_\_\_\_  
THE UNIVERSITY OF NORTH CAROLINA AT CHAPEL HILL  
AME  
C VENABLE HALL LOWER LEVEL UPGRADE  
TION  
ENABLE HALL LOWER LEVEL  
1 South Rd  
APEL HILL, NC 27514

CLIENT NAME	THE UNIV
JOB NAME	UNC VEN
LOCATION	VENABLE
ISSUE DATE	101 South Chapel I
JOB. NO.	5-21-25
SCO #	24-28389-01A

**A221**


## WALL SECTIONS 1

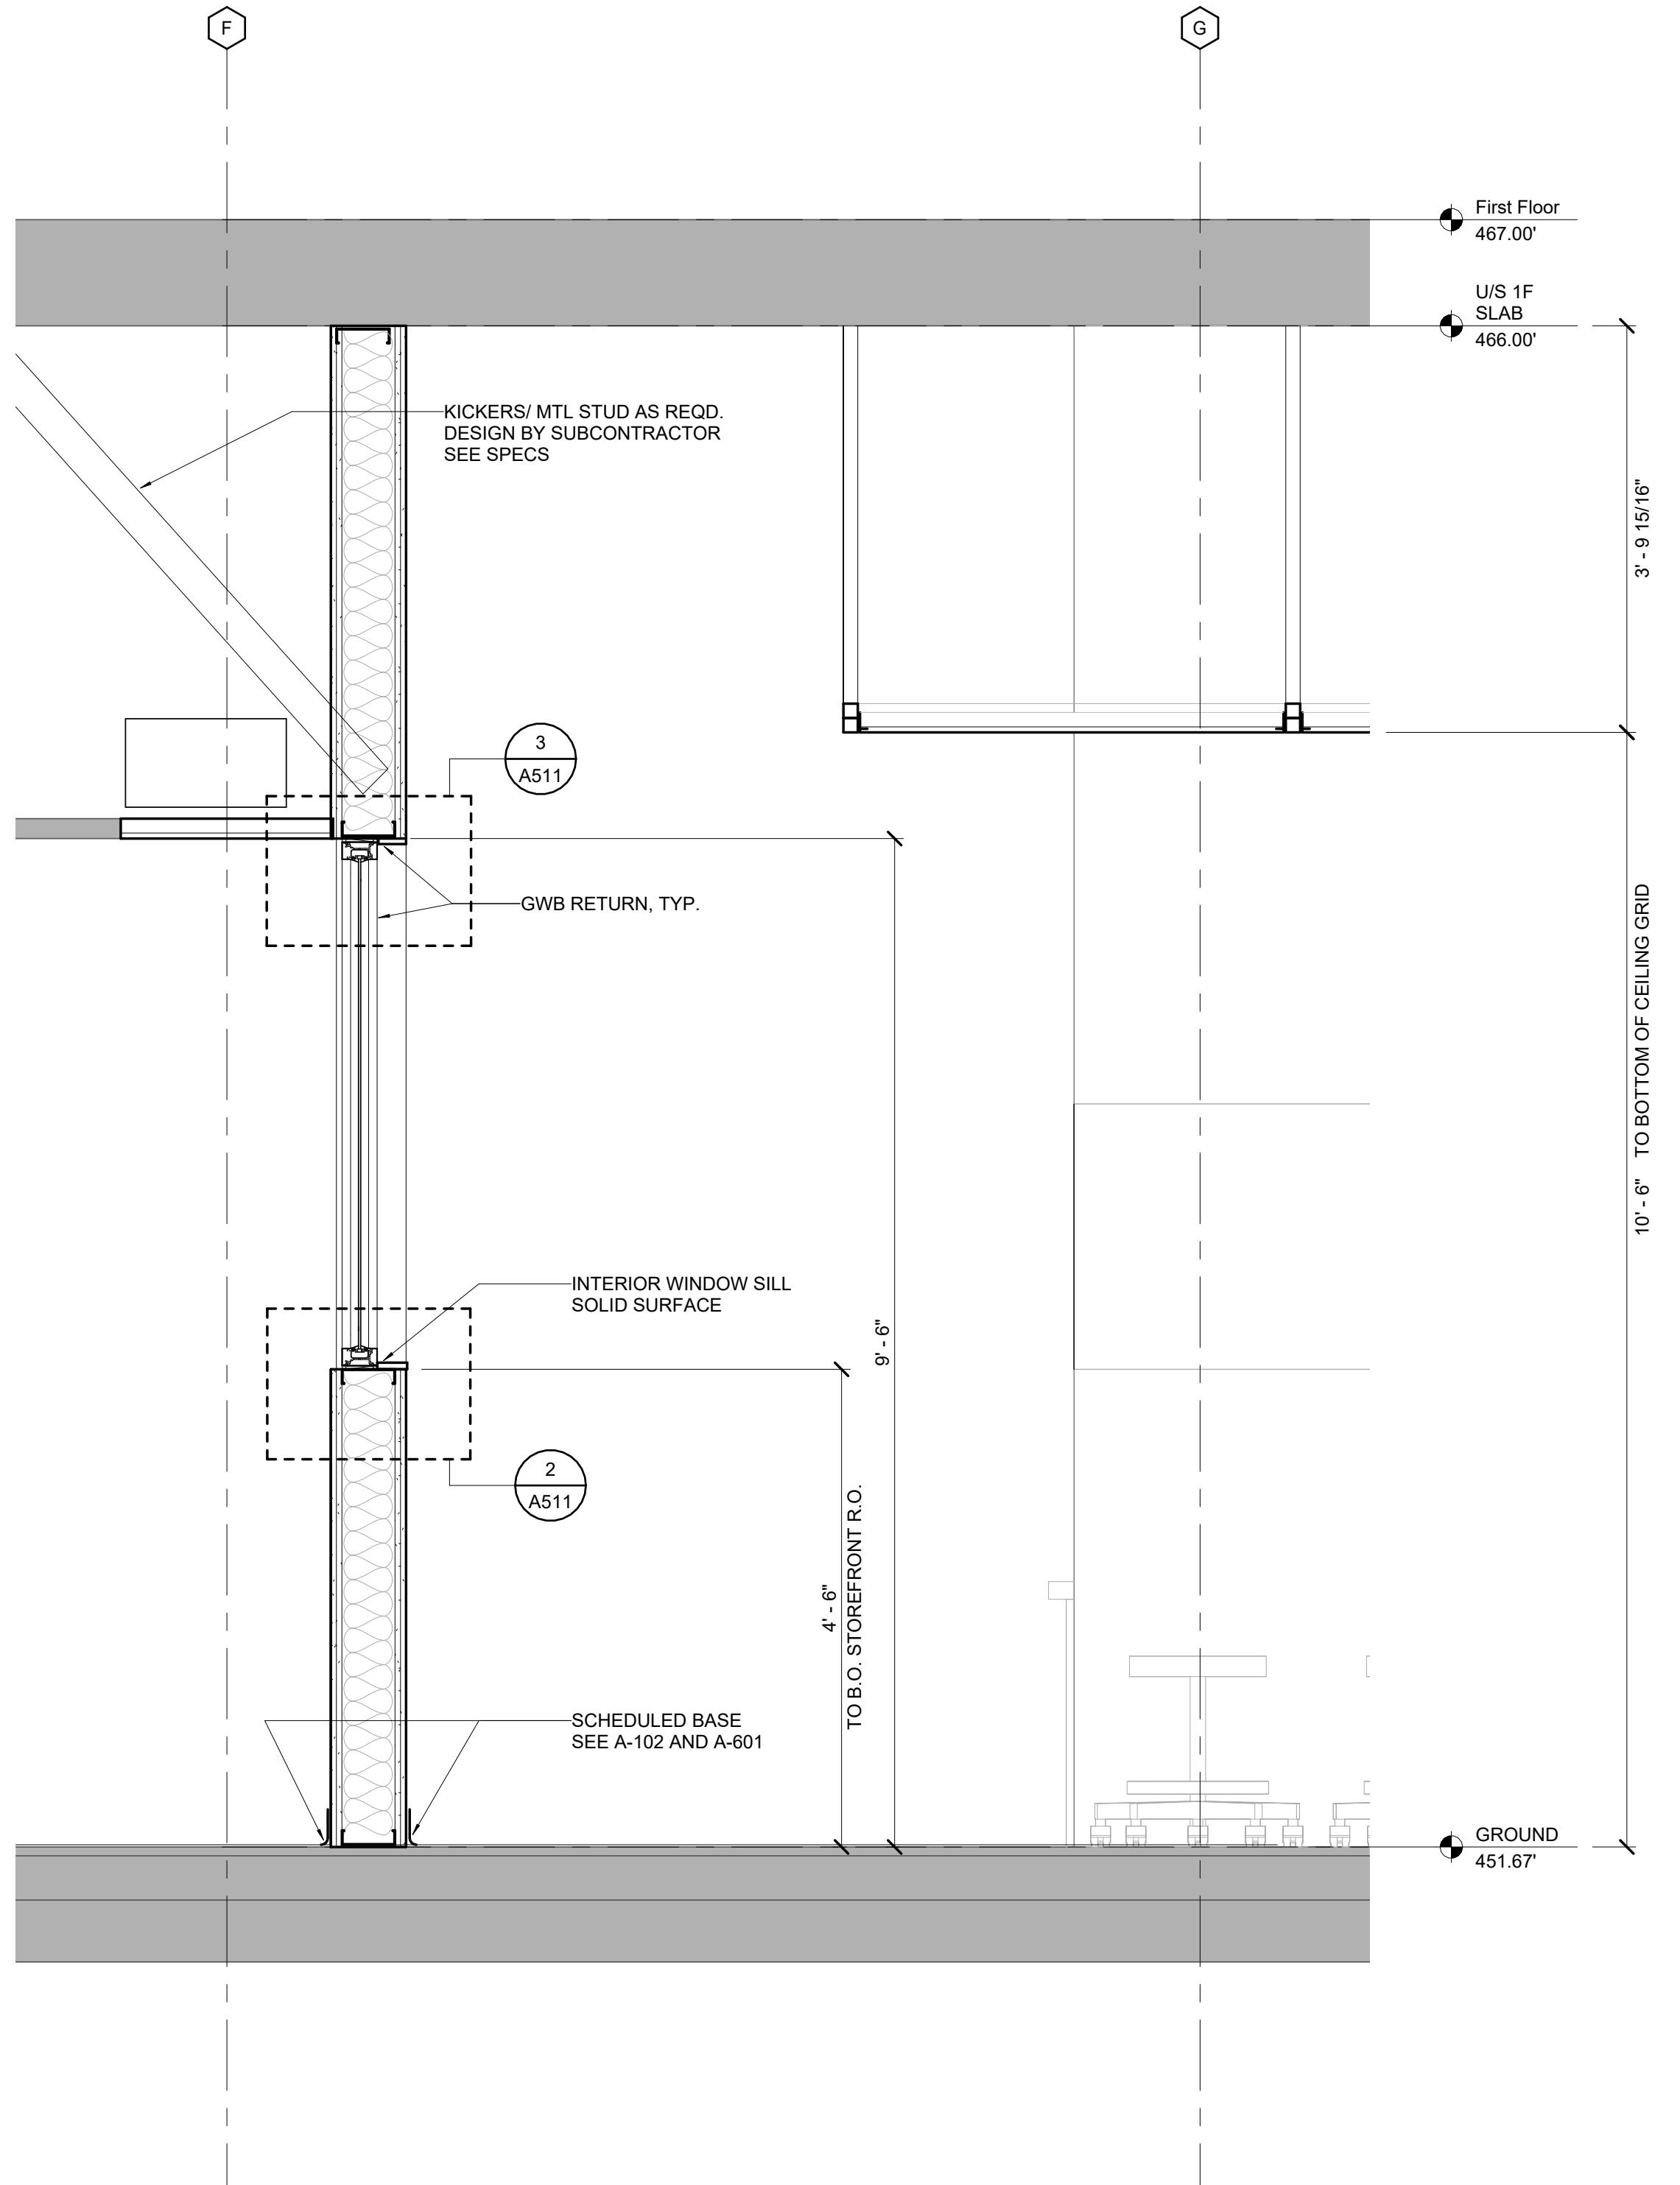

REFER TO 1/A221 FOR TYPICAL  
NOTES AND DIMENSIONS

## SECTION 02

$$\frac{3}{4} = 1 - 0$$

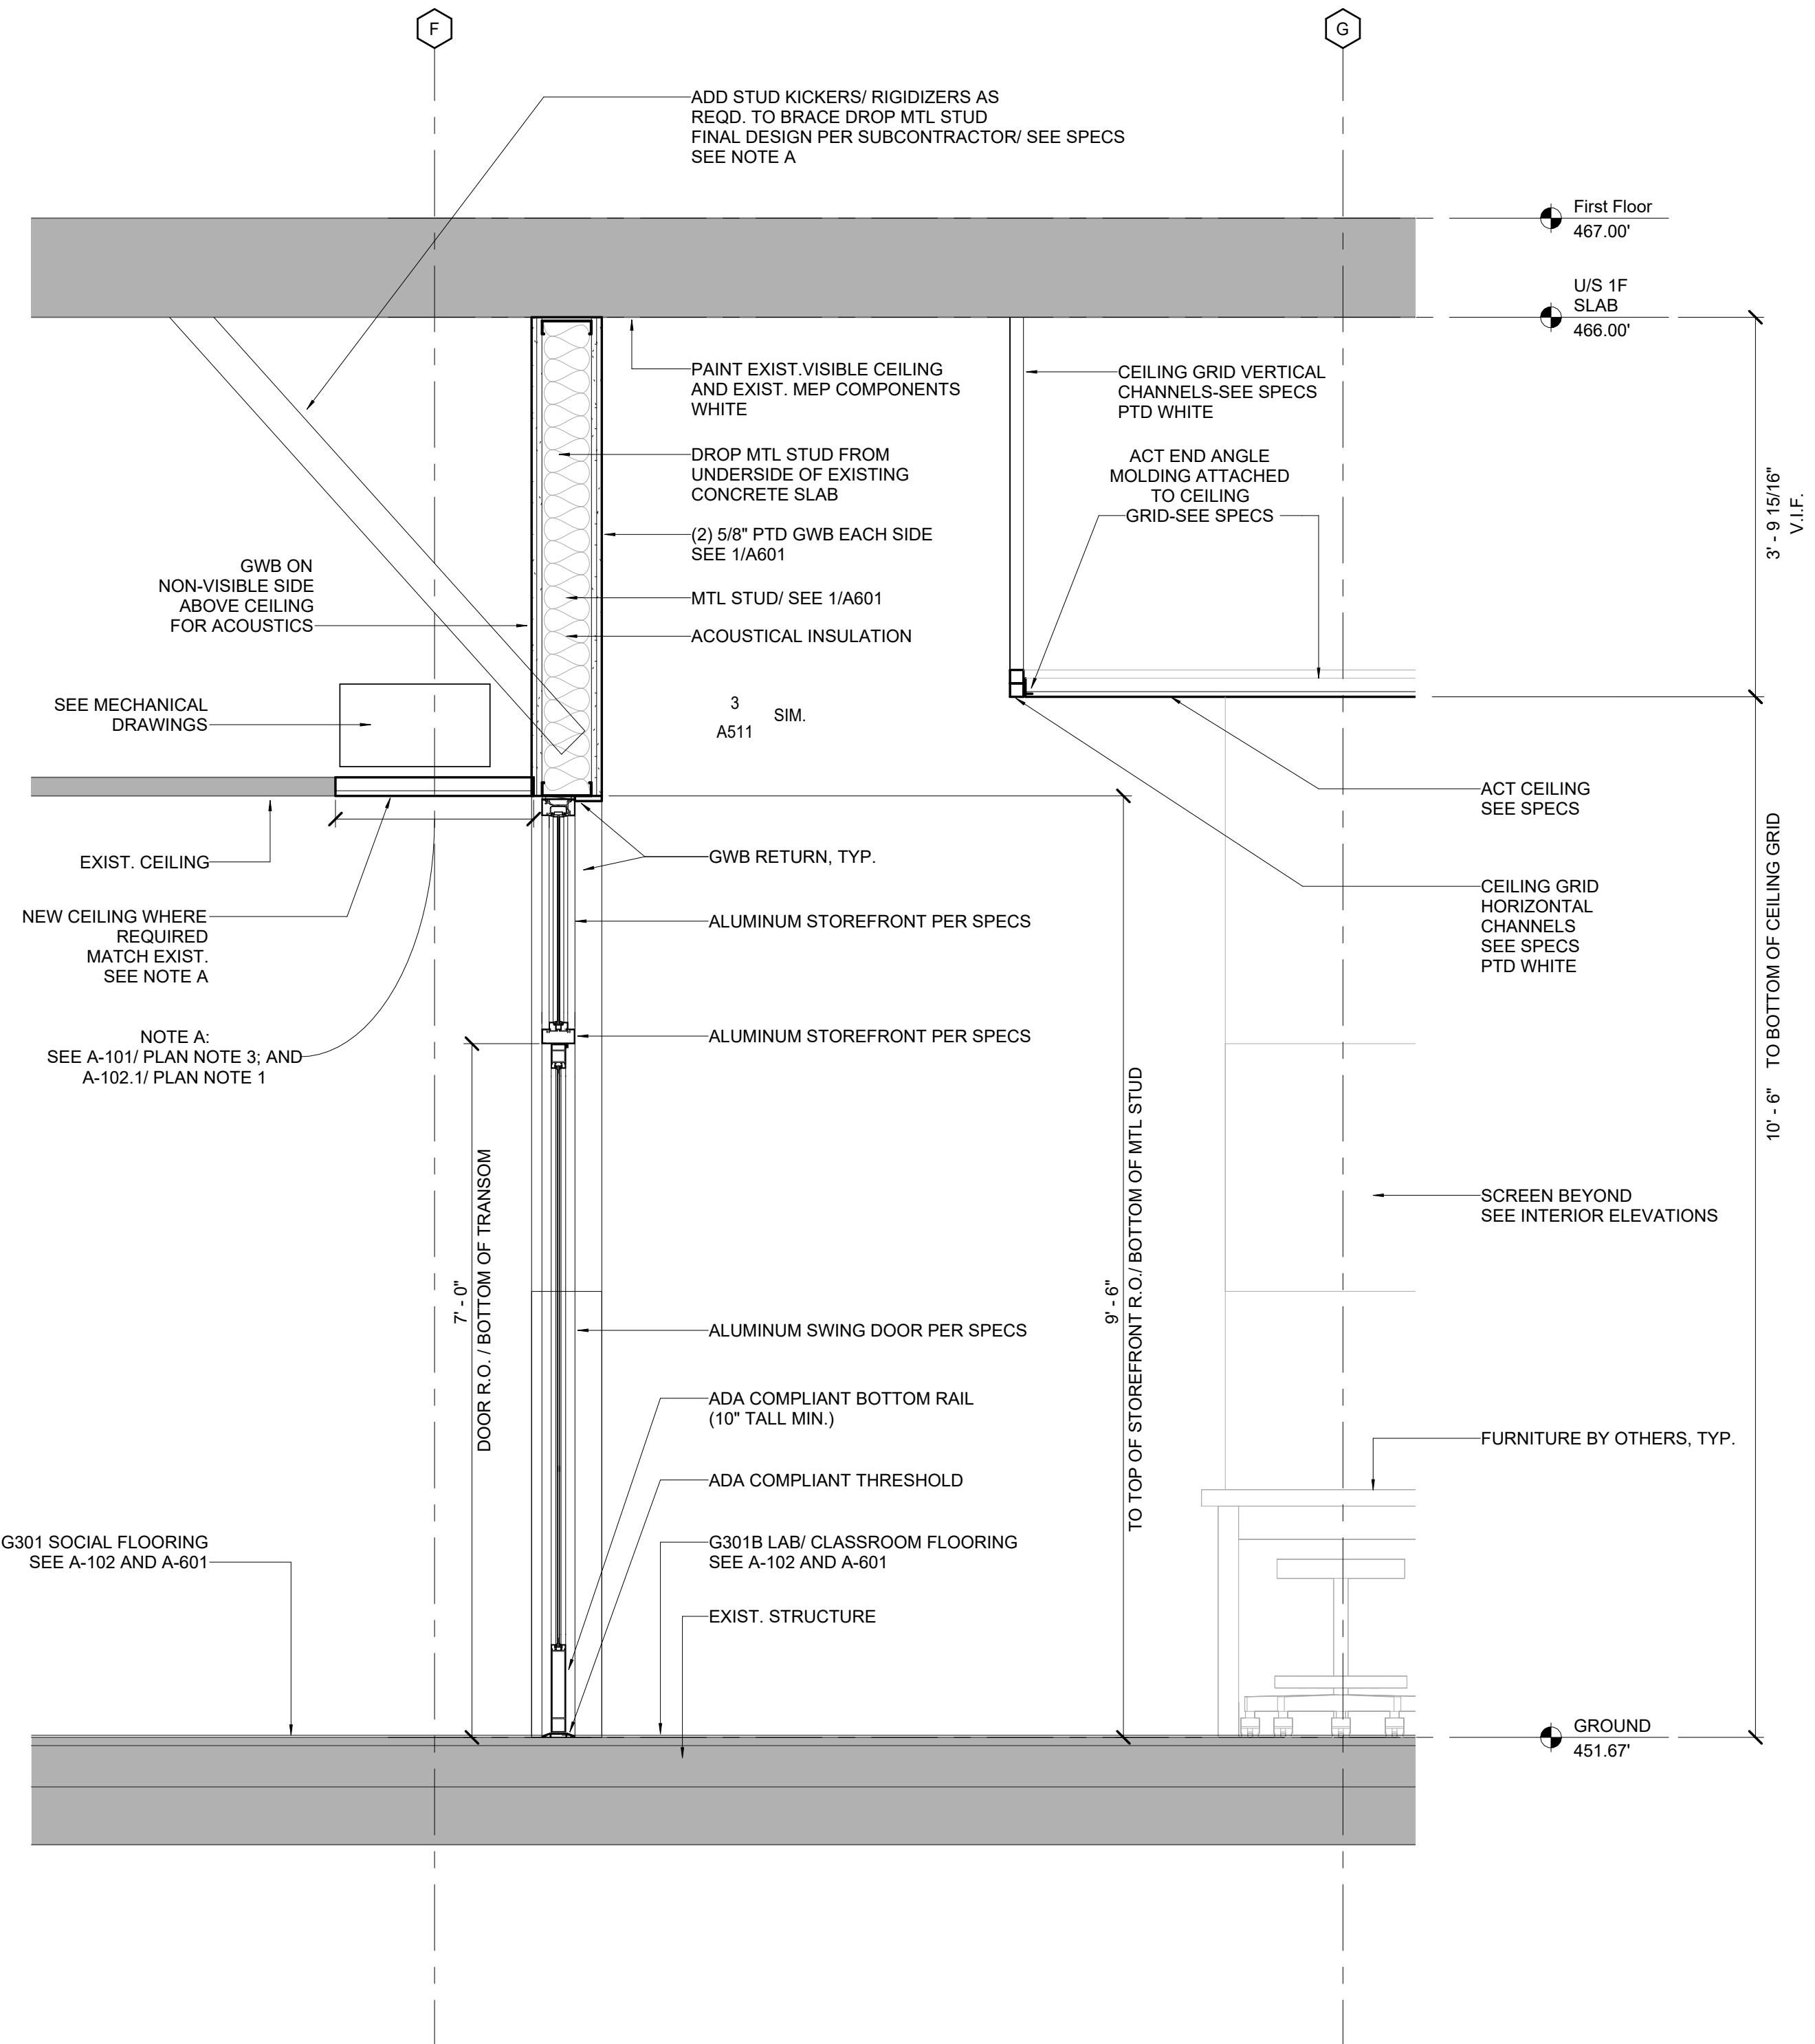

1	SECTION 01
	3/4" = 1' - 0"

$$\frac{3}{4} = 1 - 0$$



NOTCH DESIGN, PLLC  
212 W MAIN ST, SUITE E,  
CARRBORO, NC

www.notchdesign.us  
info@notchdesign.us

REVISION:  
SCO Review 9/15/25  
2nd SCO Review 10/24/25  
Construction Set 11/17/25

## CONSTRUCTION SET




© 2025  
Notch Design

THE UNIVERSITY OF NORTH CAROLINA AT CHAPEL HILL  
PRO NAME: UNC VENABLE HALL LOWER LEVEL UPLIFT  
LOCATION: 101 South Rd  
CARRBORO, NC 27514


CLIENT NAME: THE UNIVERSITY OF NORTH CAROLINA AT CHAPEL HILL  
PRO NAME: UNC VENABLE HALL LOWER LEVEL UPLIFT  
LOCATION: 101 South Rd  
CARRBORO, NC 27514  
ISSUE DATE: 5-21-25  
JOB NO: N092  
SCO # 24-28389-01A

**A222**


WALL SECTIONS 2

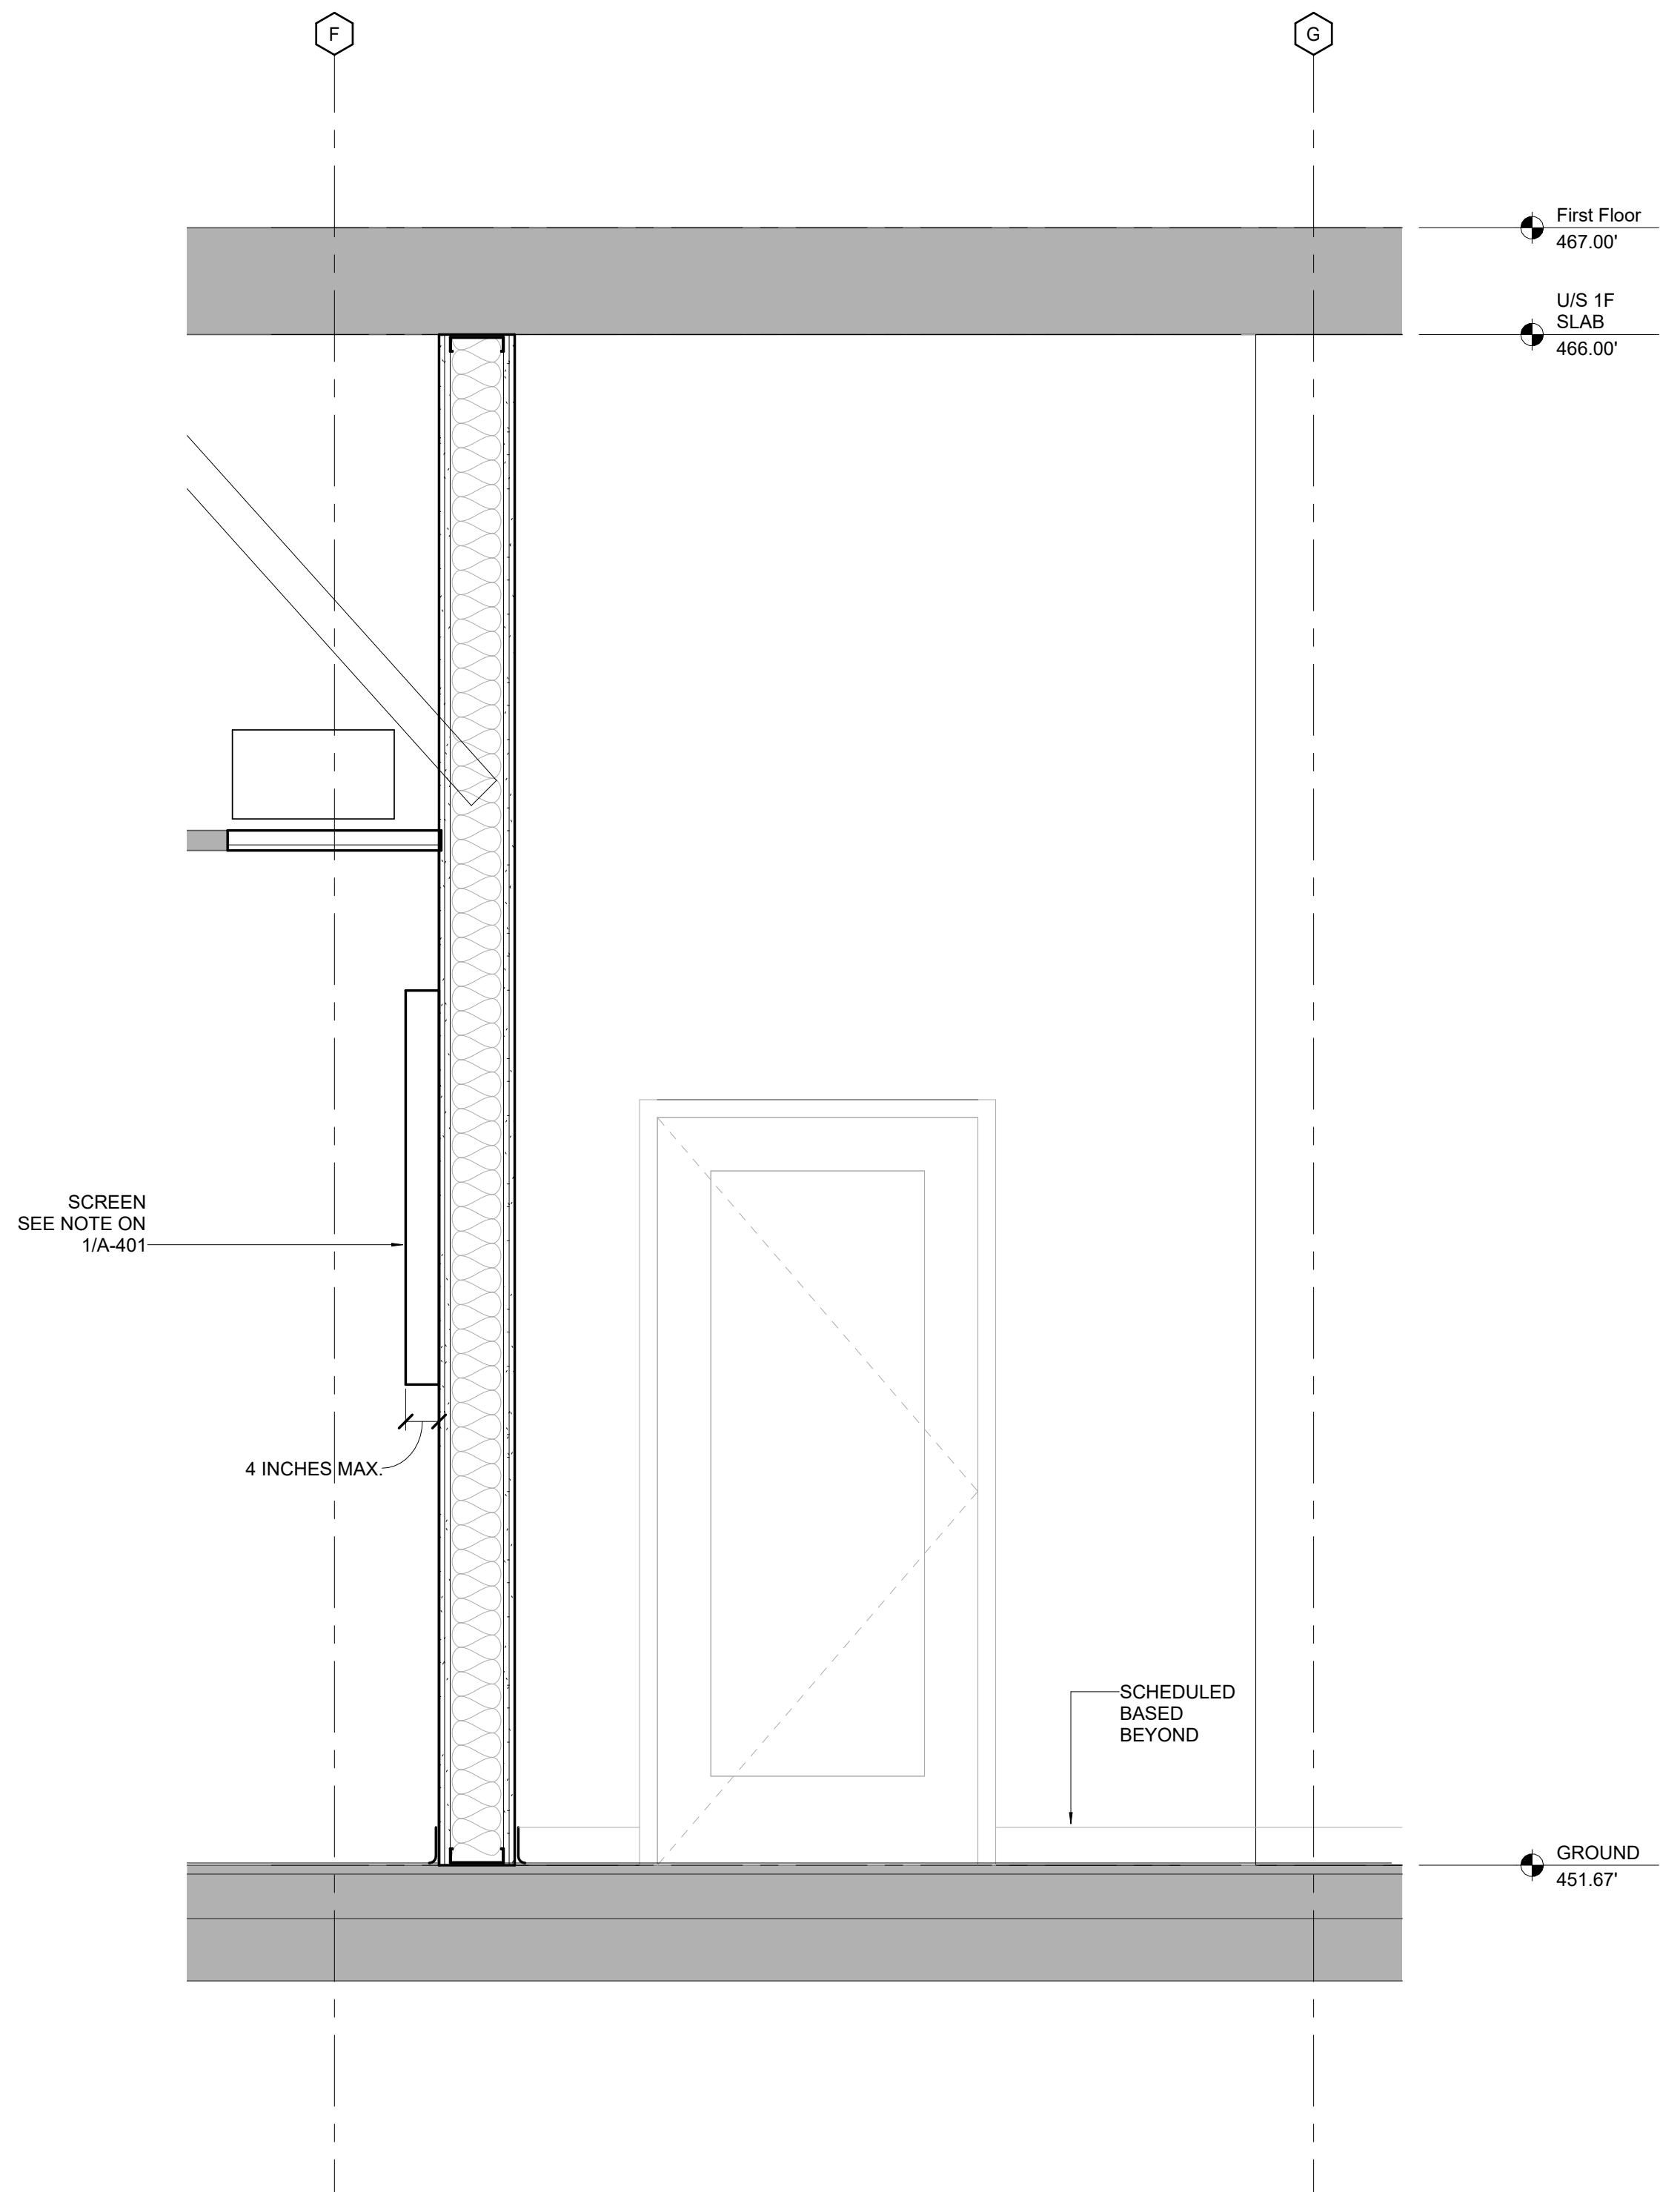

0 2 4FT  
SECTION 03  
3/4" = 1' - 0"  
2

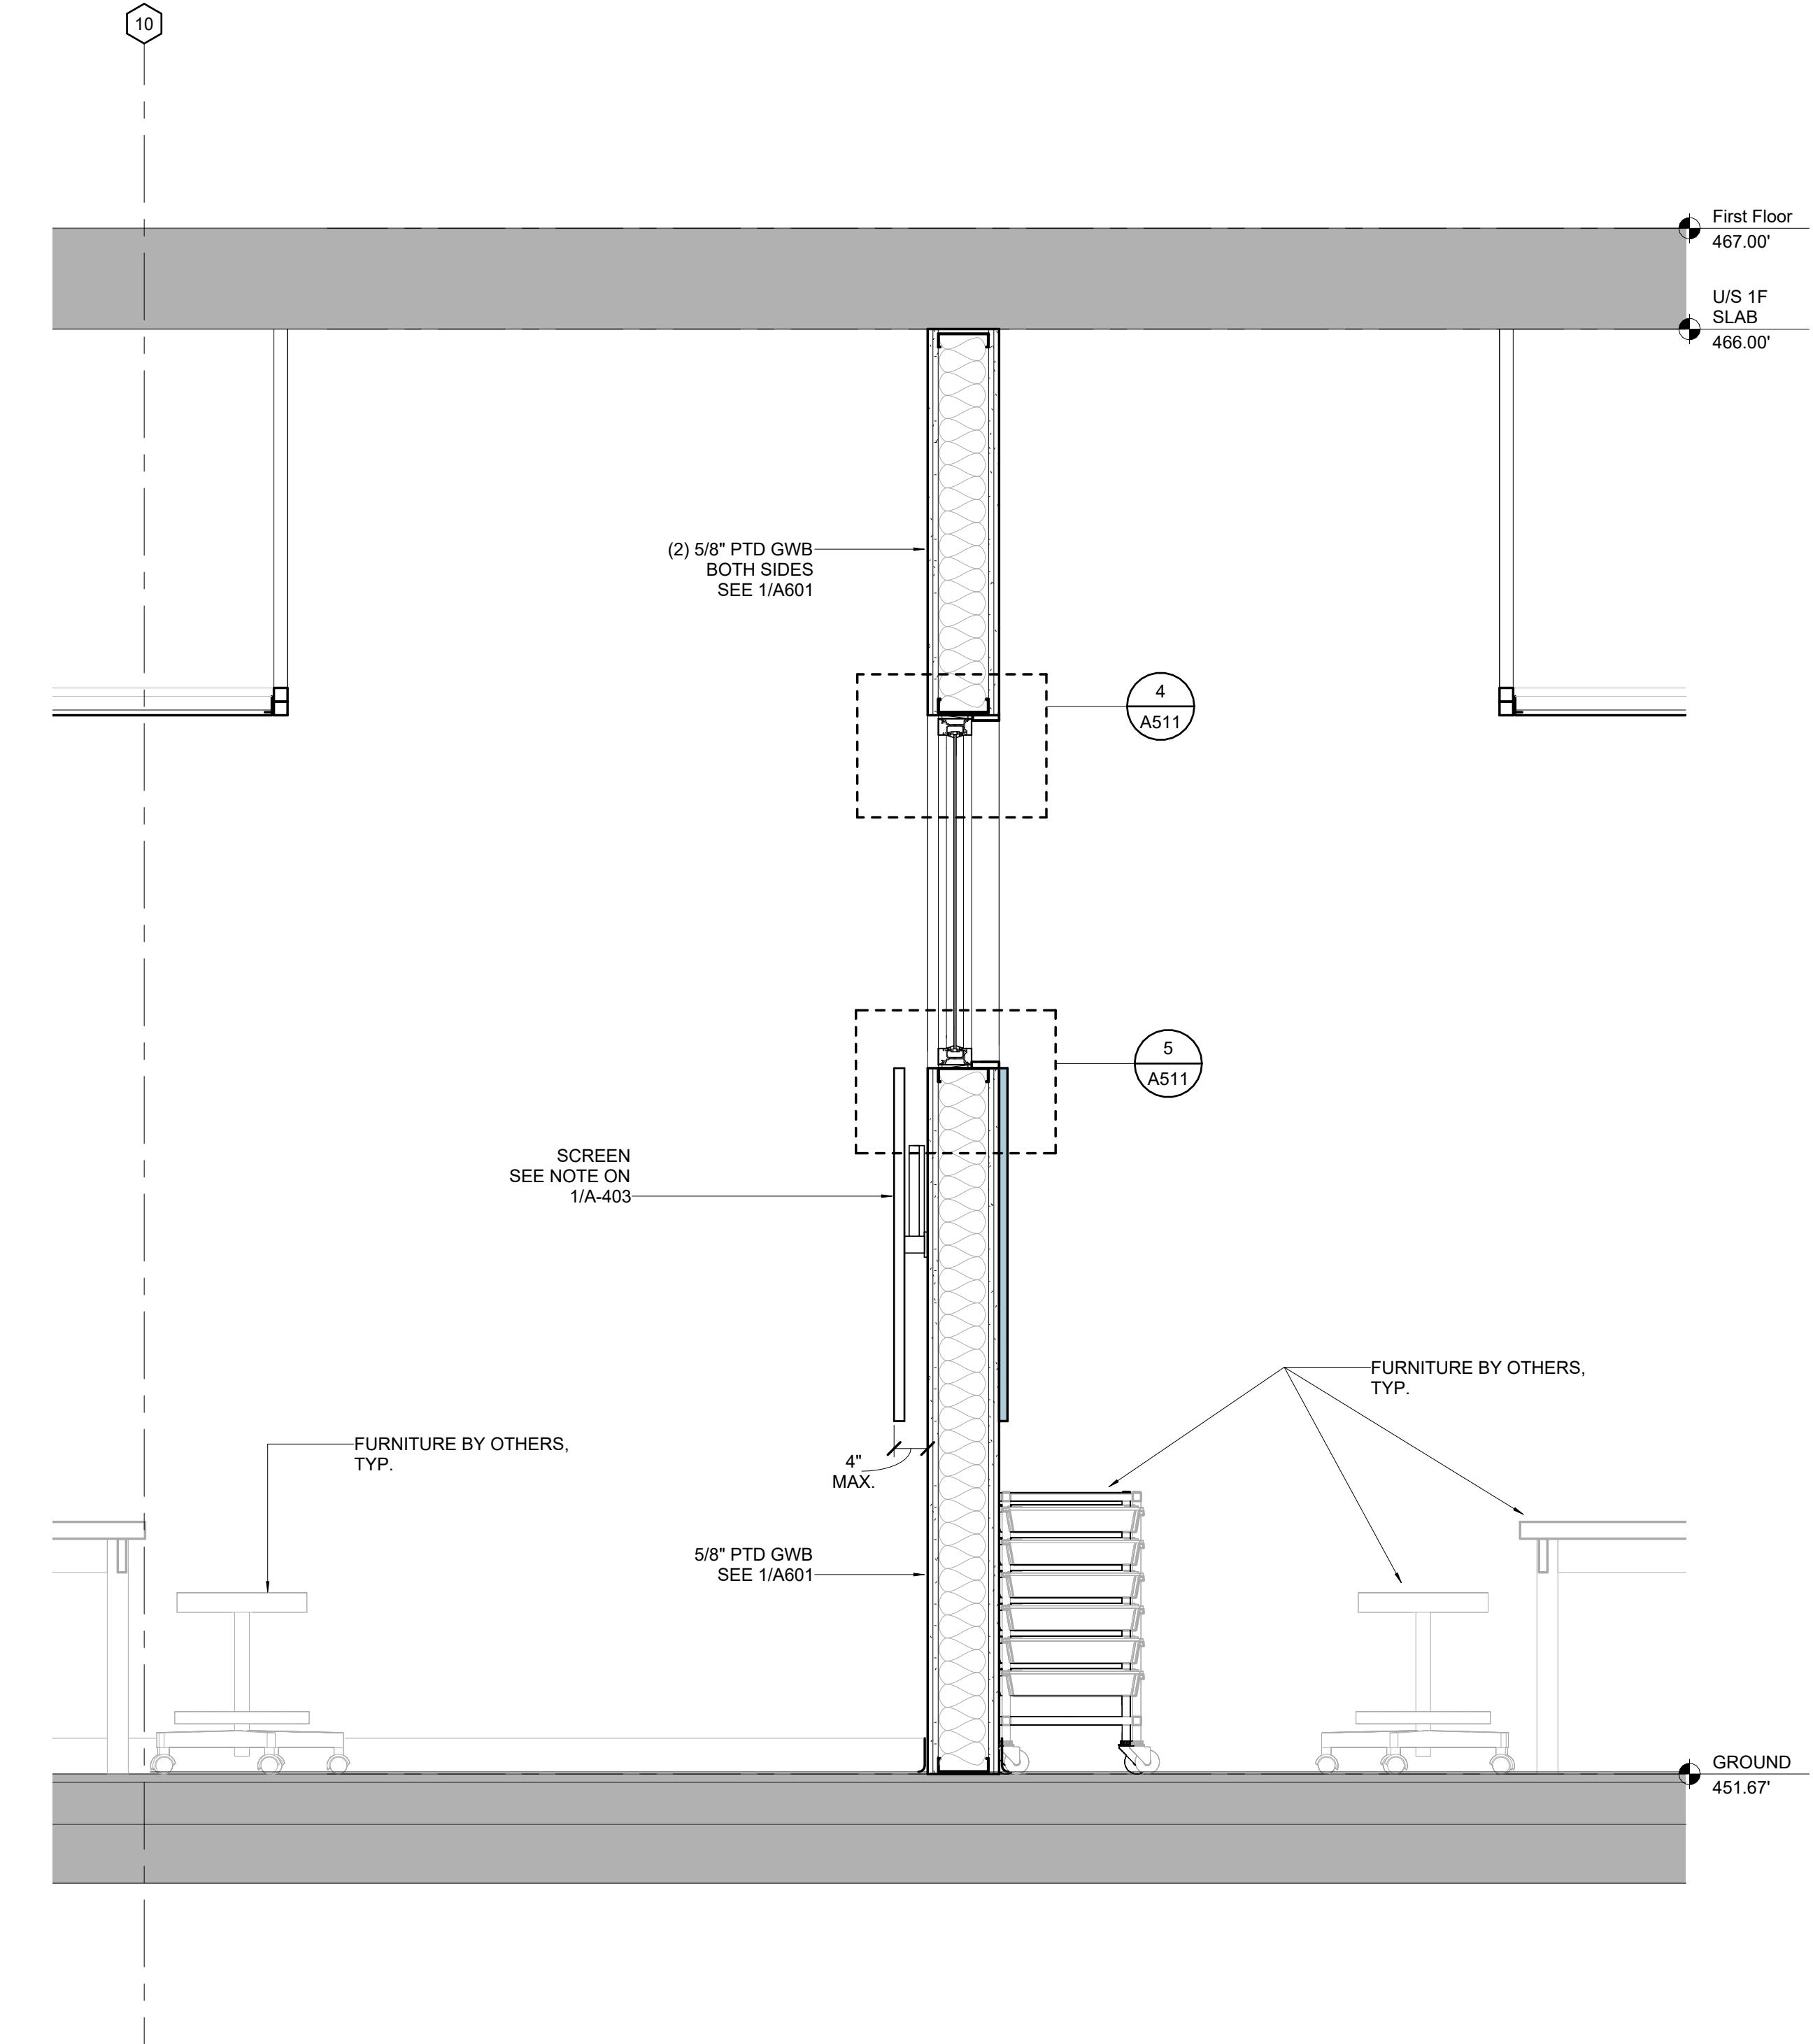

0 2 4FT  
SECTION 04  
3/4" = 1' - 0"  
1

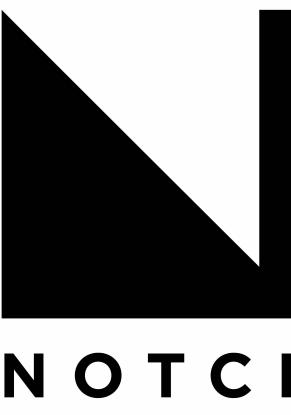


NOTCH DESIGN, PLLC  
212 W MAIN ST, SUITE E,  
CARRBORO, NC

www.notchdesign.us  
info@notchdesign.us

REVISION:  
SCO Review 9/15/25  
2nd SCO Review 10/24/25  
Construction Set 11/17/25

## CONSTRUCTION SET

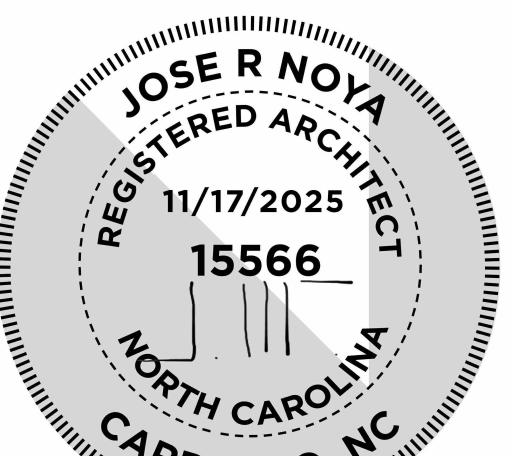


© 2025  
Notch Design

CLIENT NAME: THE UNIVERSITY OF NORTH CAROLINA AT CHAPEL HILL  
PRO. NAME: UNC VENABLE HALL LOWER LEVEL UPGIFT  
LOCATION: 101 South Rd  
CARRBORO, NC 27514  
ISSUE DATE: 5-21-25  
JOB NO: N092  
SCO # 24-28389-01A

## A223


WALL SECTIONS 3

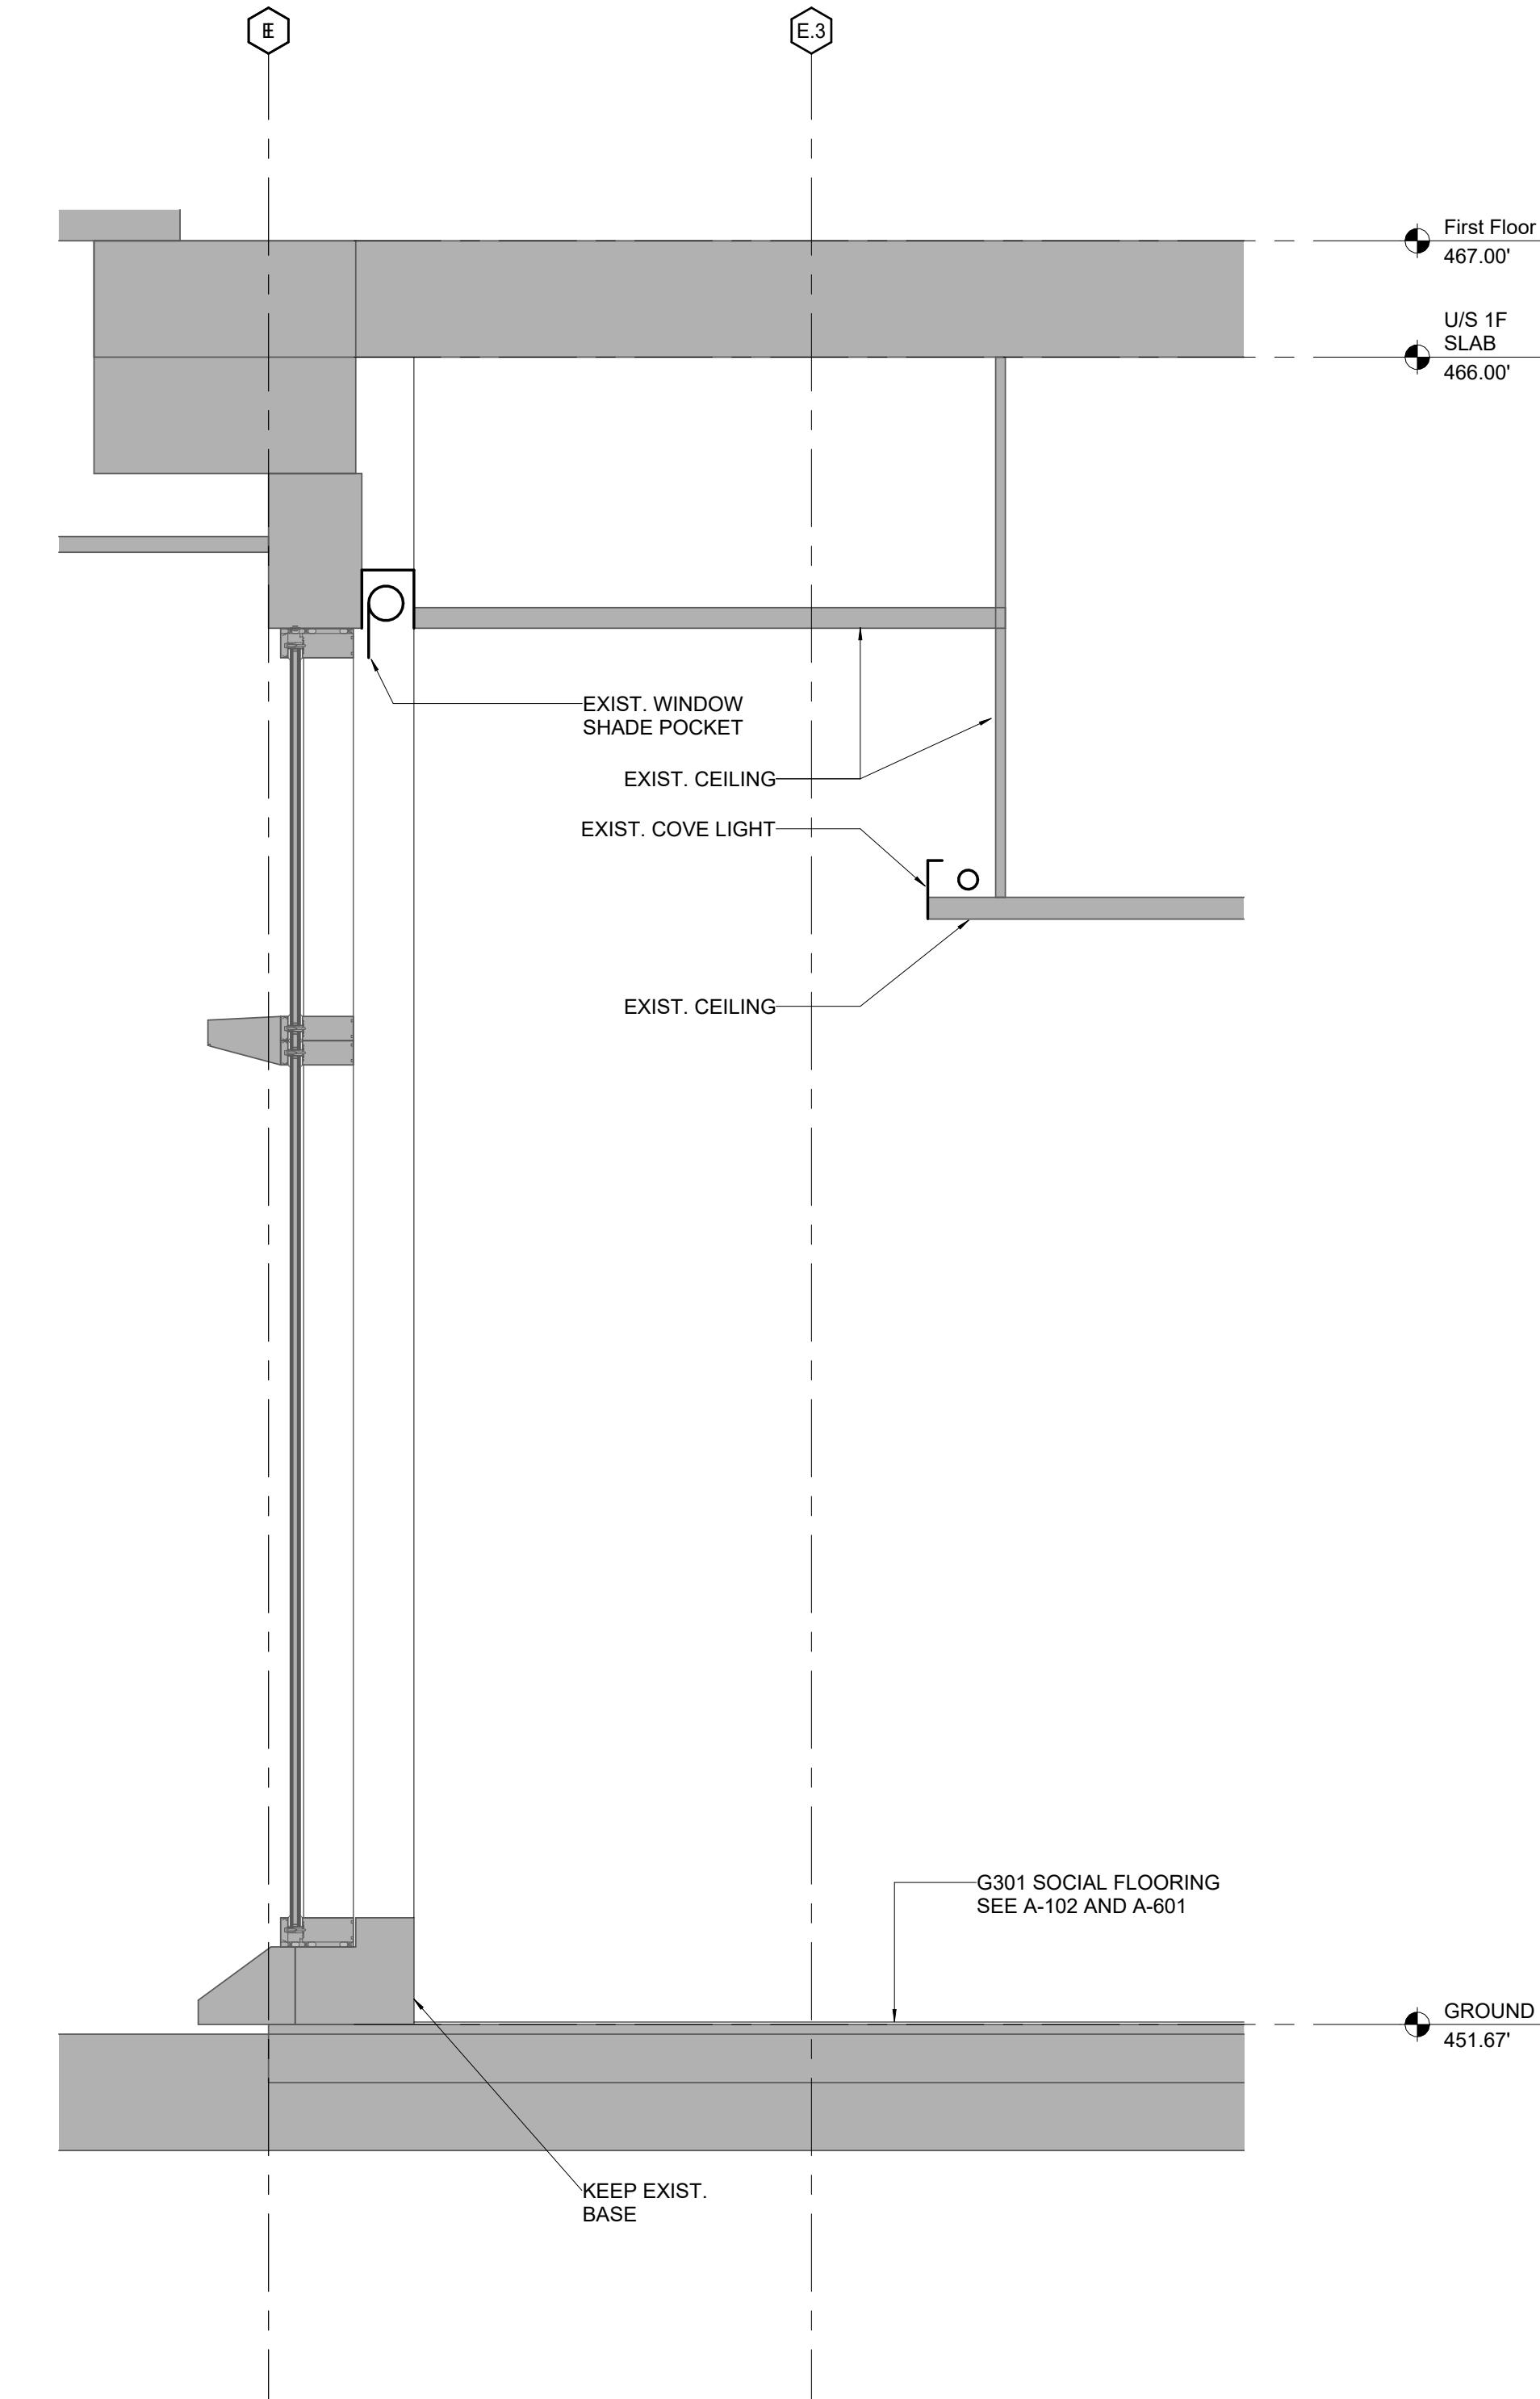

REFER TO 1/A221 FOR TYPICAL  
NOTES AND DIMENSIONS

2

SECTION 06  
3/4" = 1' - 0"

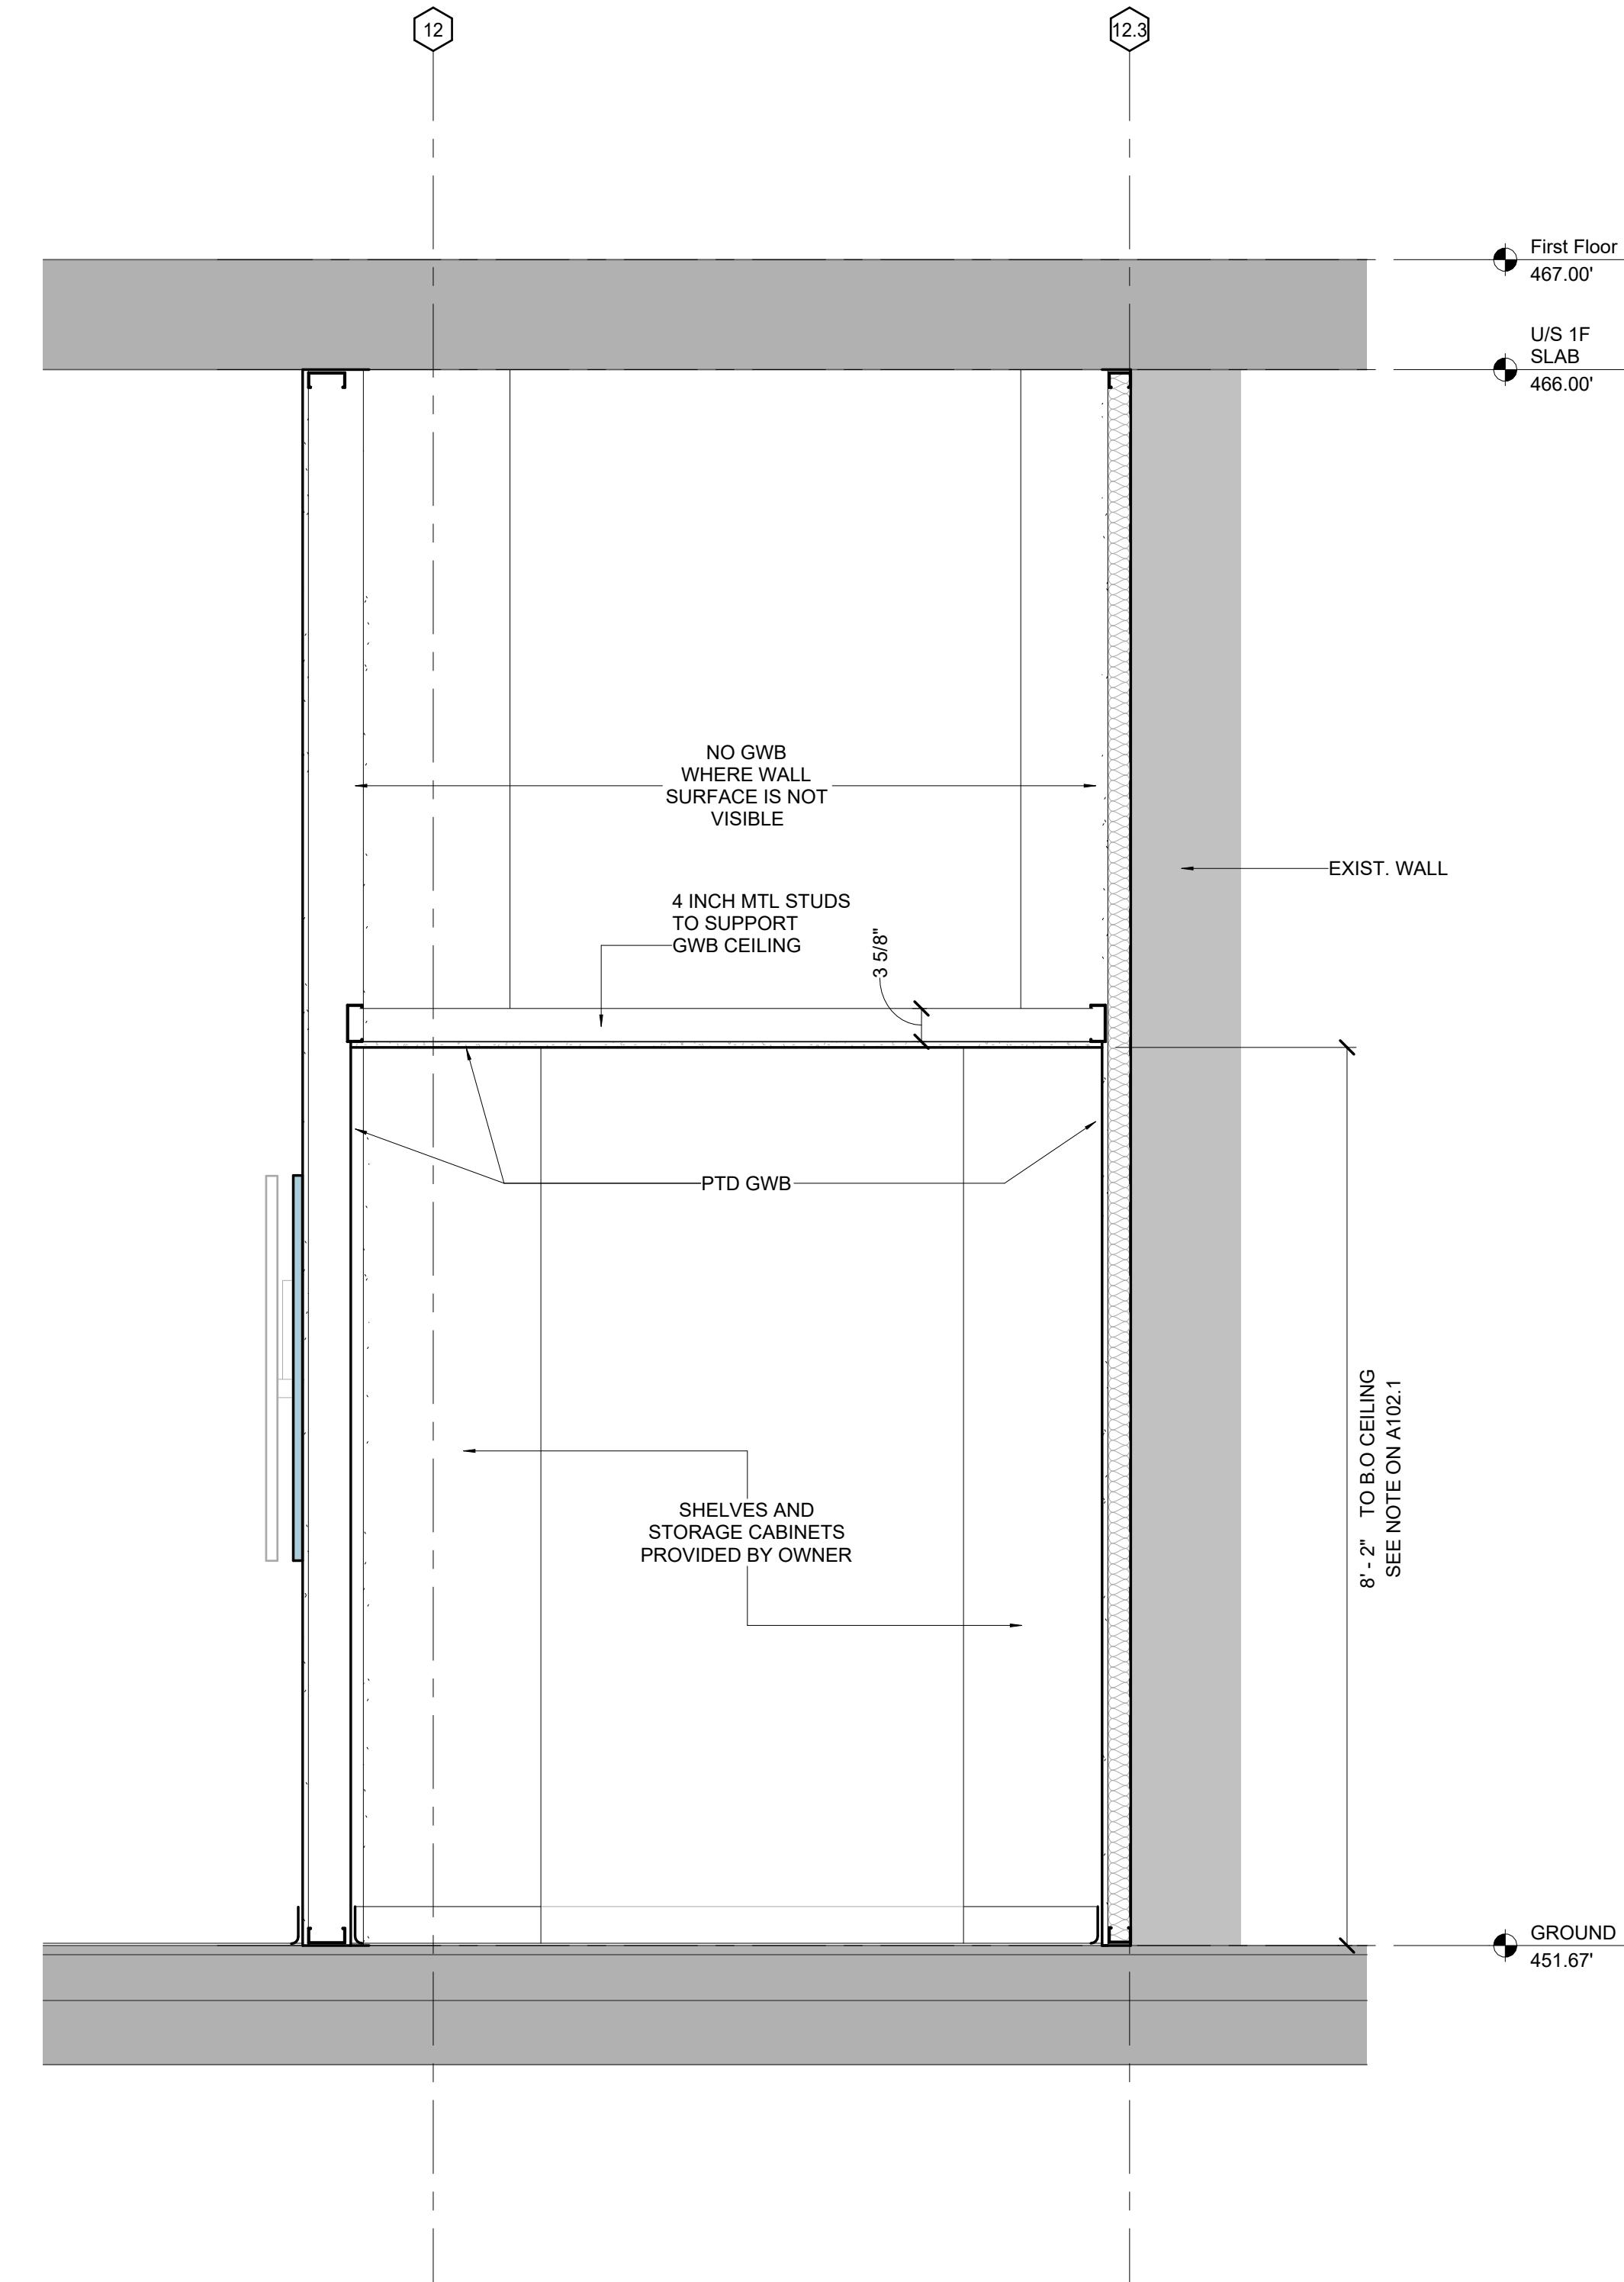

REFER TO 1/A221 FOR TYPICAL  
NOTES AND DIMENSIONS

1

SECTION 05  
3/4" = 1' - 0"

0

2


4FT



NOTCH DESIGN, PLLC  
212 W MAIN ST, SUITE E,  
CARRBORO, NC

www.notchdesign.us  
info@notchdesign.us

REVISION:  
SCO Review 9/15/25  
2nd SCO Review 10/24/25  
Construction Set 11/17/25  
1 Addendum 1 1/7/26

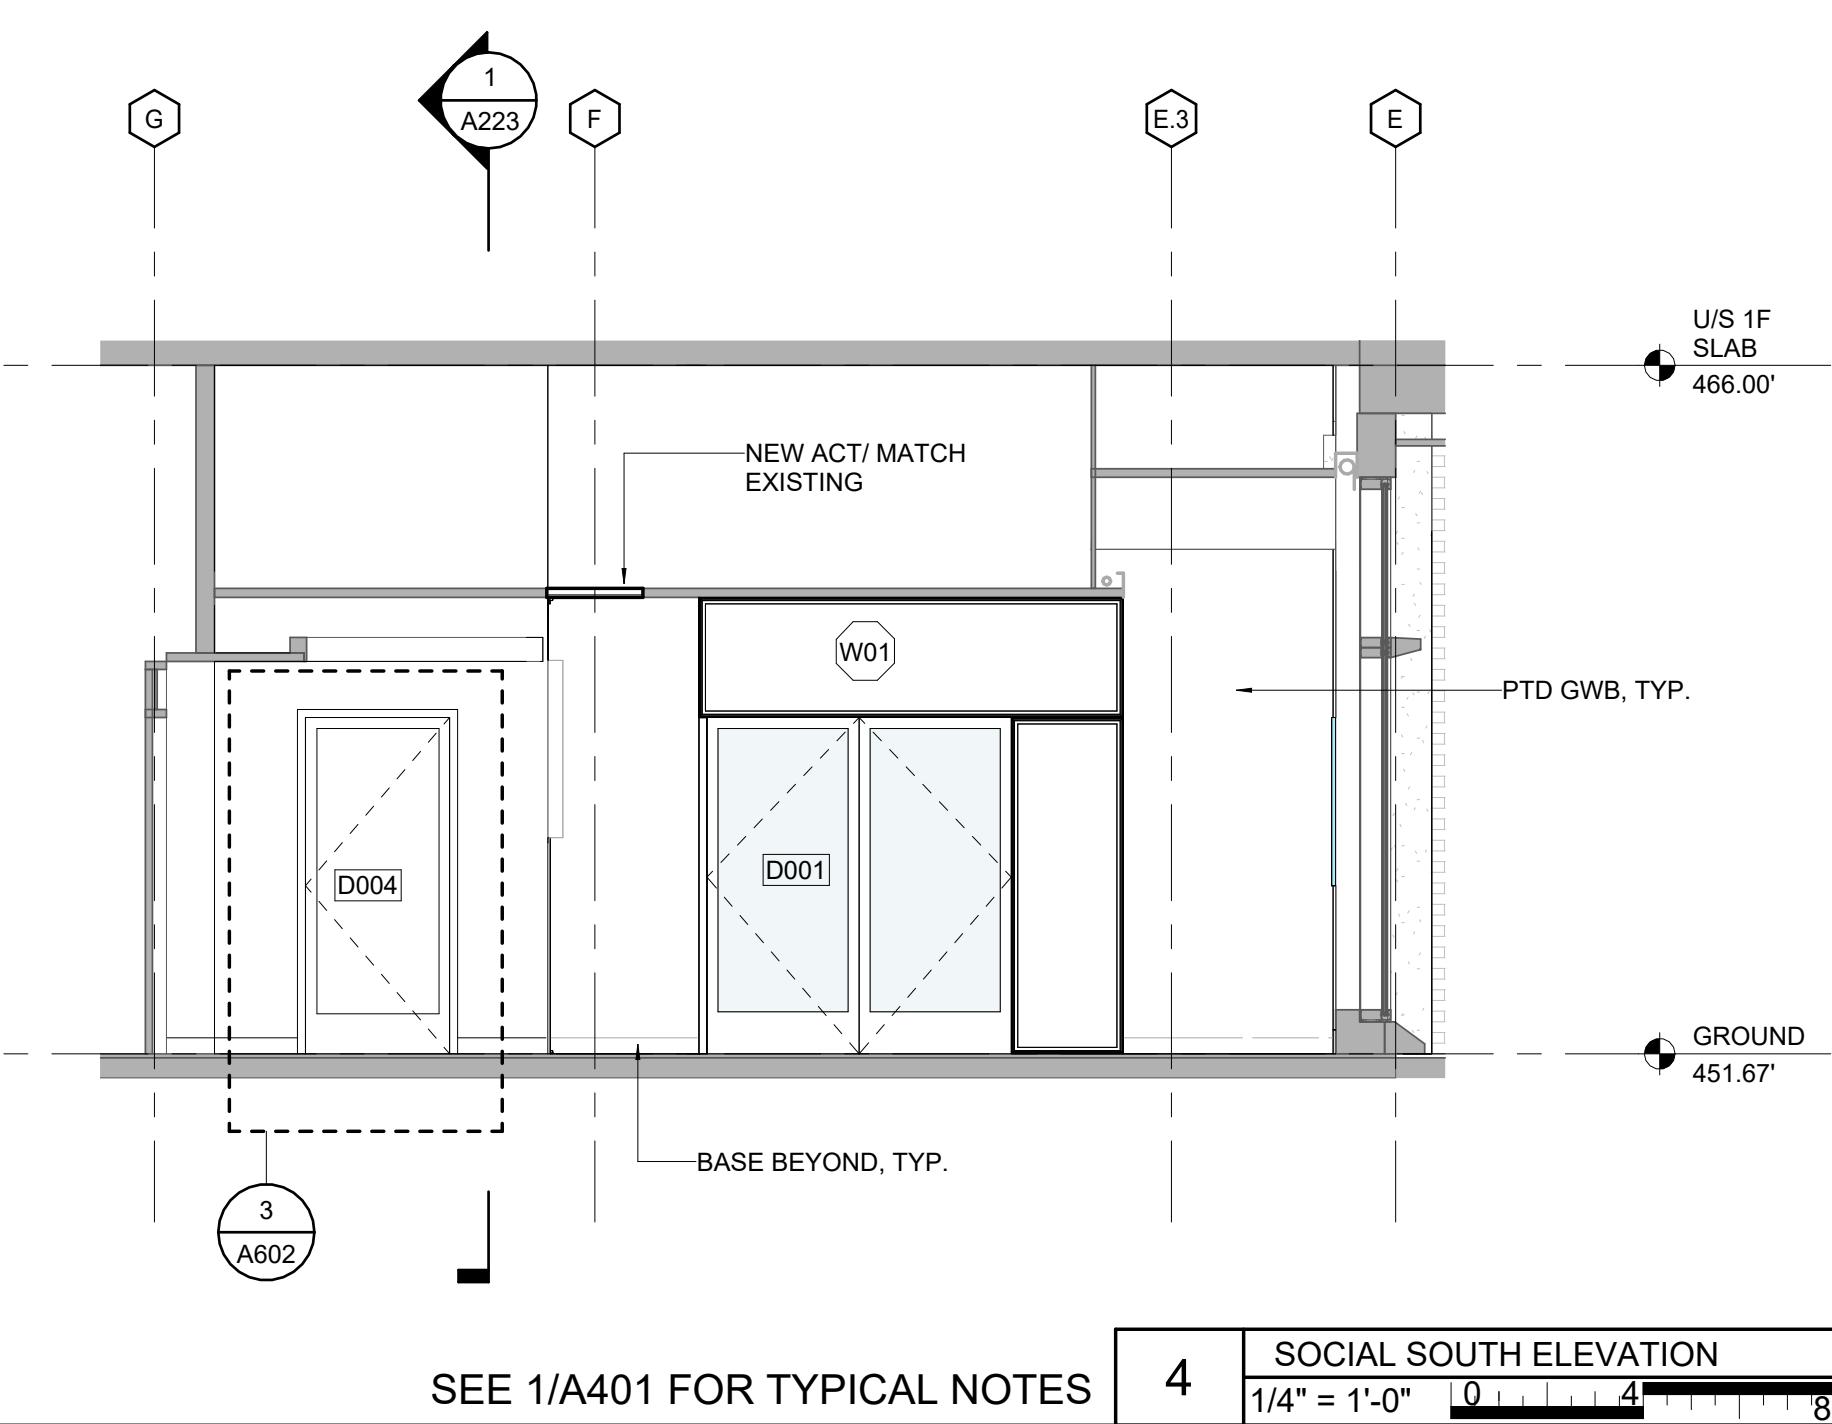


SEE 1/A401 FOR TYPICAL NOTES

4

SOCIAL SOUTH ELEVATION

1/4" = 1'-0" 0 1 2 3 4 5 6 7 8 FT

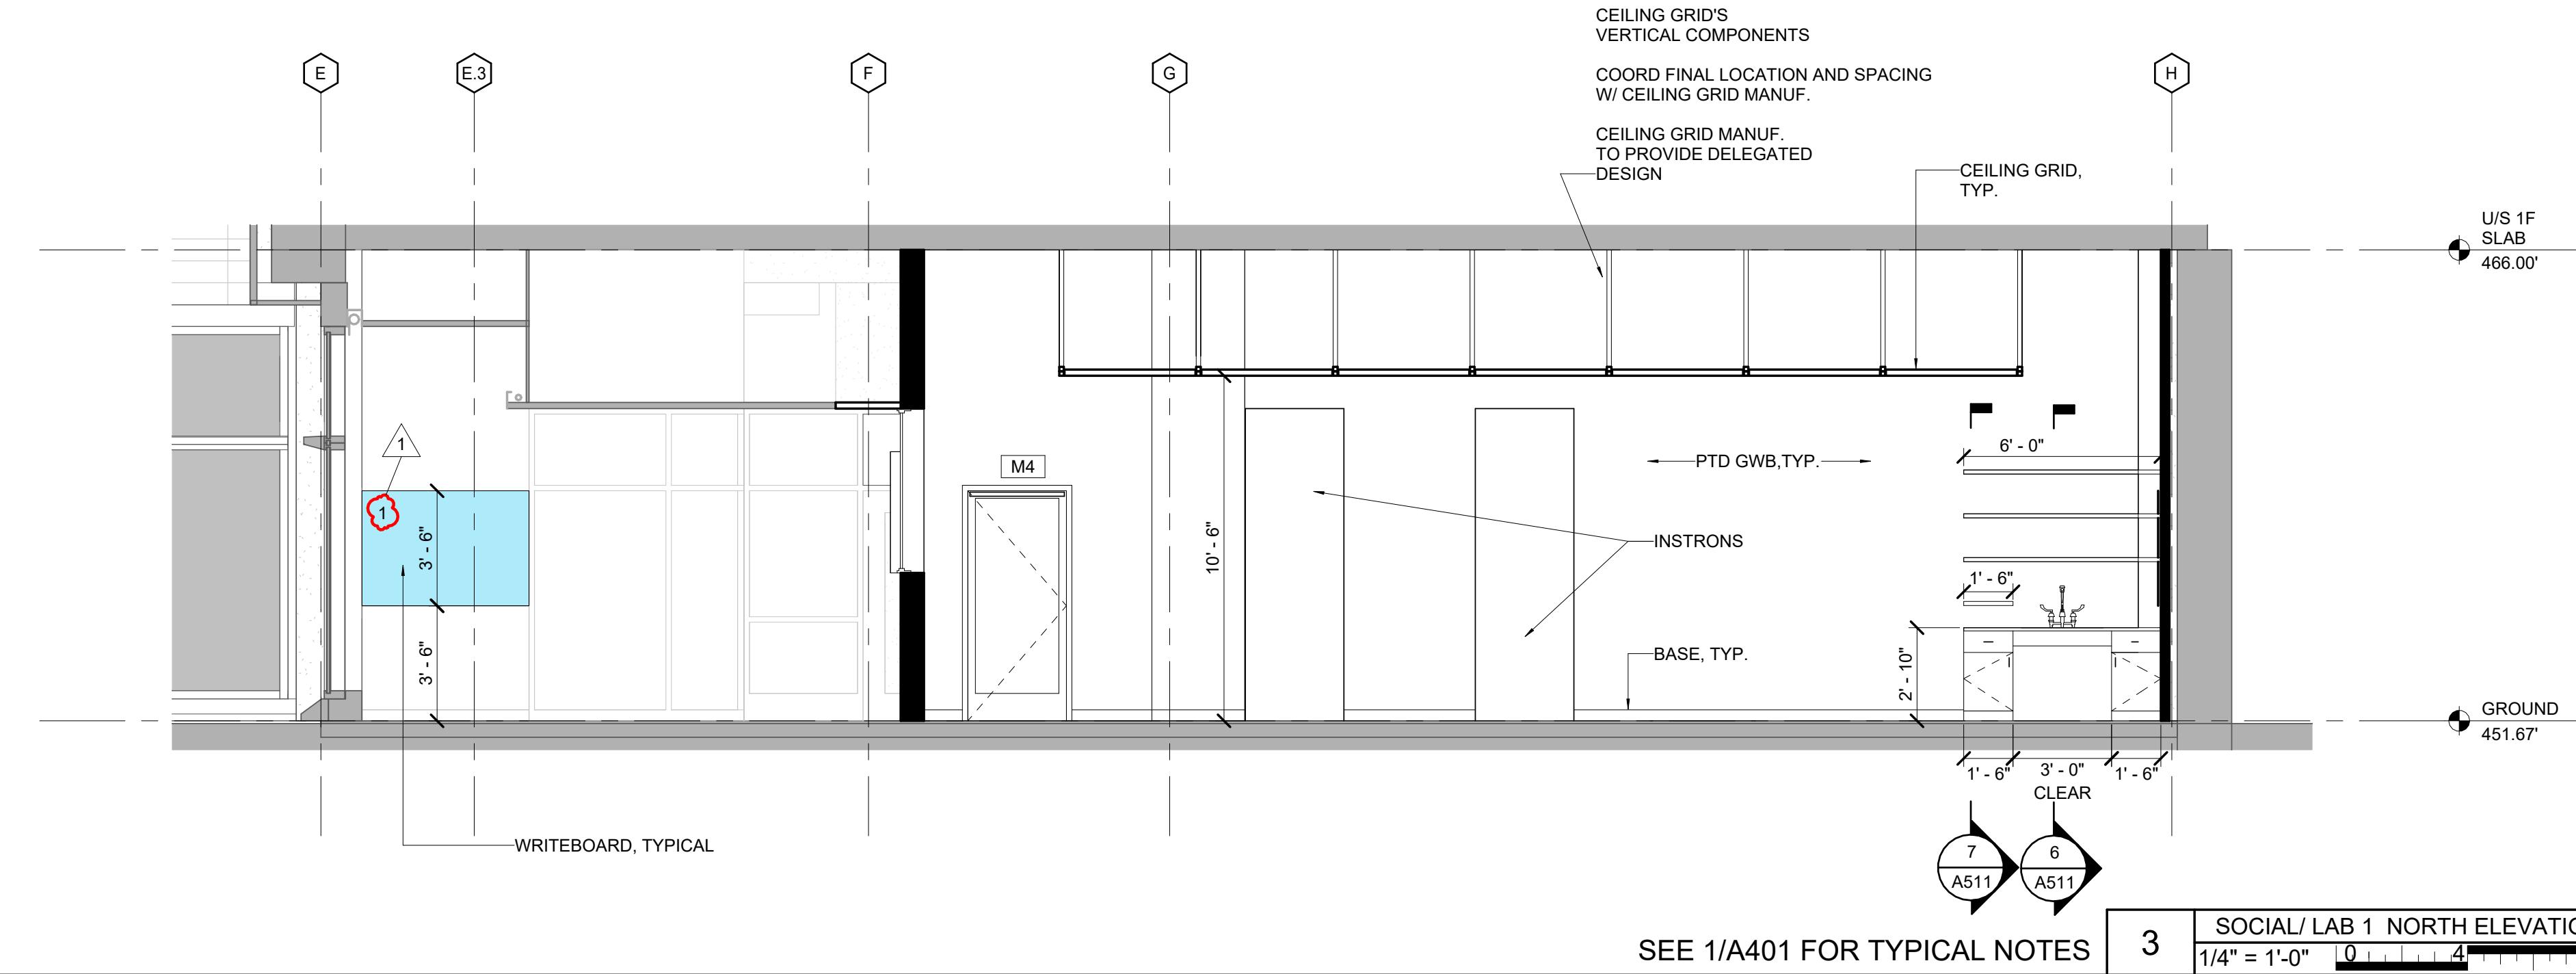


SEE 1/A401 FOR TYPICAL NOTES

3


SOCIAL/LAB 1 NORTH ELEVATION

1/4" = 1'-0" 0 1 2 3 4 5 6 7 8 FT

## CONSTRUCTION SET

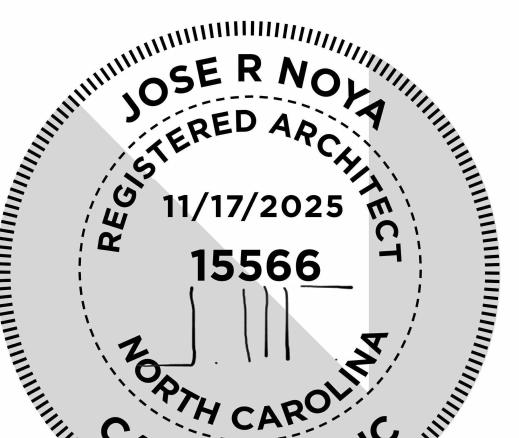

© 2025  
Notch Design

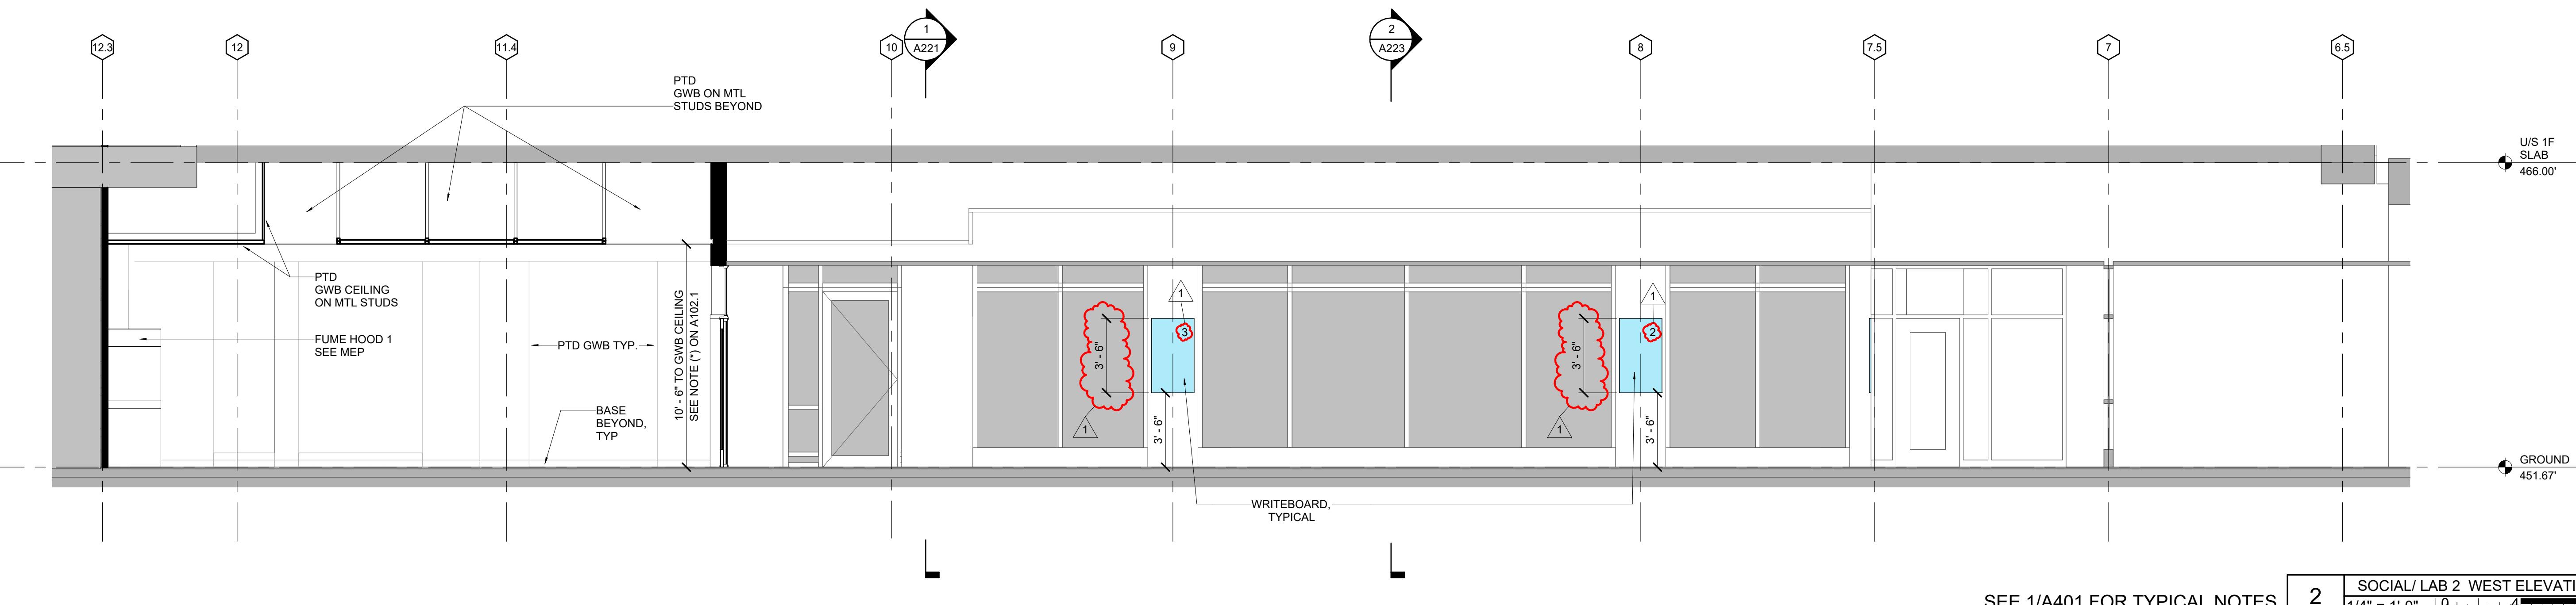


SEE 1/A401 FOR TYPICAL NOTES

2

SOCIAL/LAB 2 WEST ELEVATION

1/4" = 1'-0" 0 1 2 3 4 5 6 7 8 FT

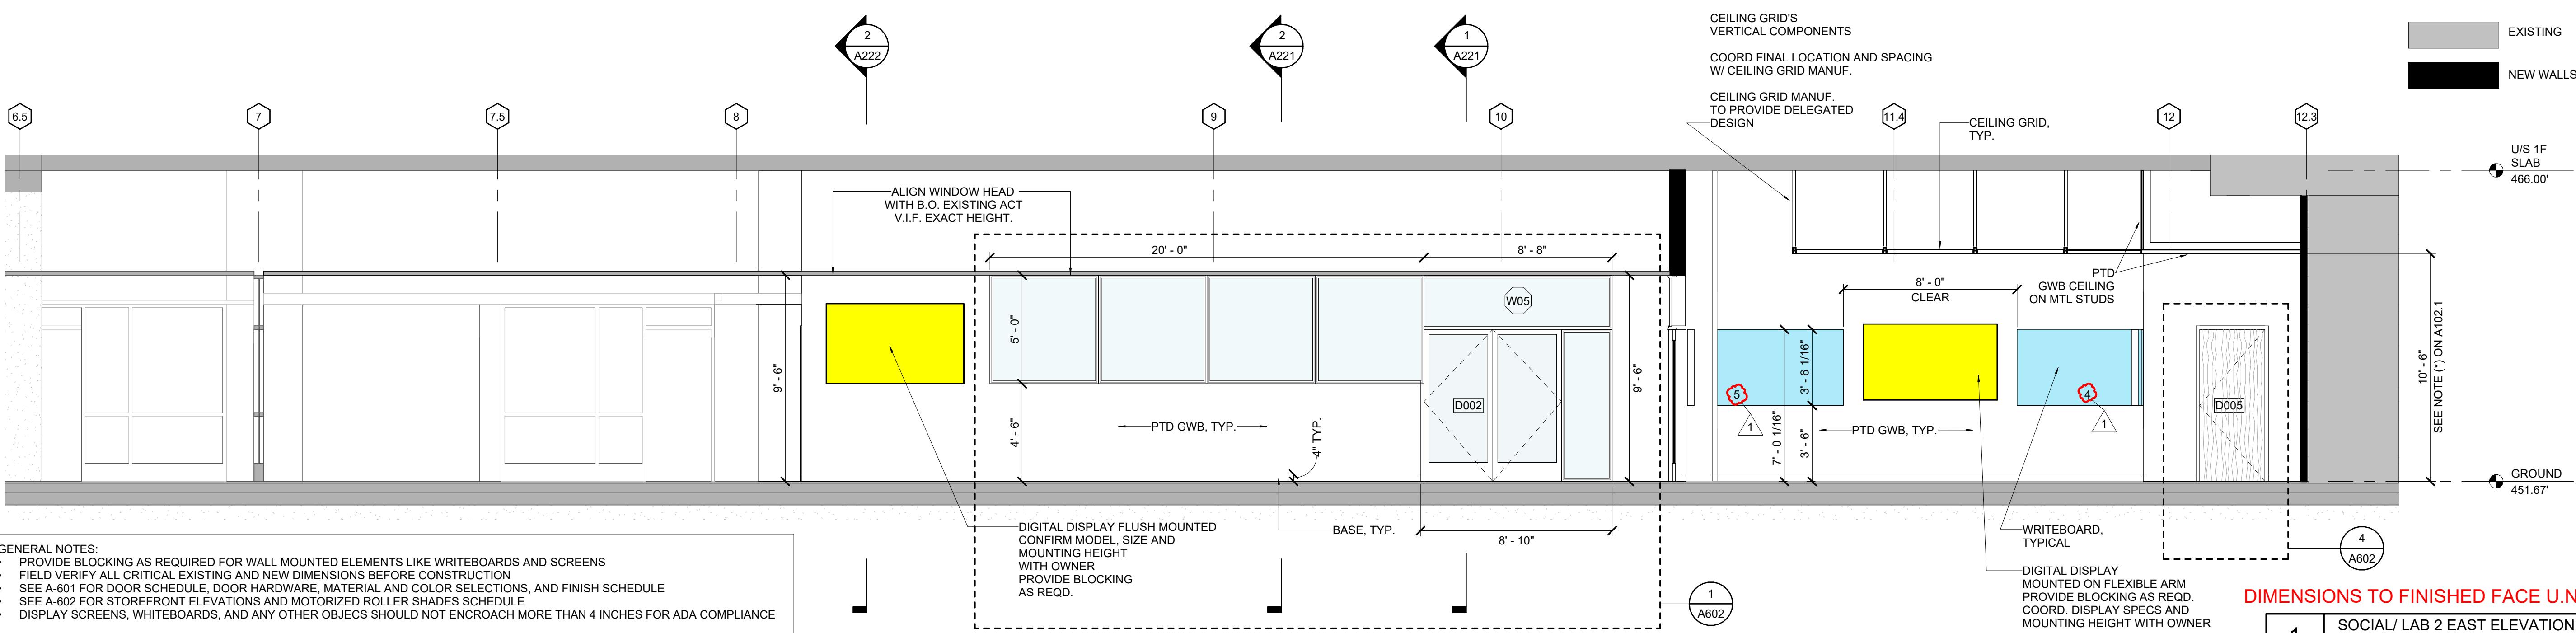

GENERAL NOTES:  
• PROVIDE BLOCKING AS REQUIRED FOR WALL MOUNTED ELEMENTS LIKE WRITEBOARDS AND SCREENS  
• FIELD VERIFY ALL CRITICAL EXISTING AND NEW DIMENSIONS BEFORE CONSTRUCTION  
• SEE A-601 FOR DOOR SCHEDULE, DOOR HARDWARE, MATERIAL AND COLOR SELECTIONS, AND FINISH SCHEDULE  
• SEE A-602 FOR STOREFRONT ELEVATIONS AND MOTORIZED ROLLER SHADES SCHEDULE  
• DISPLAY SCREENS, WHITEBOARDS, AND ANY OTHER OBJECTS SHOULD NOT ENCROACH MORE THAN 4 INCHES FOR ADA COMPLIANCE

DIMENSIONS TO FINISHED FACE U.N.O.

1

SOCIAL/LAB 2 EAST ELEVATION


1/4" = 1'-0" 0 1 2 3 4 5 6 7 8 FT

CLIENT NAME: THE UNIVERSITY OF NORTH CAROLINA AT CHAPEL HILL  
PROJ. NAME: UNC VENABLE HALL LOWER LEVEL UPLIFT  
LOCATION: 101 South Rd, CHAPEL HILL, NC 27514

ISSUE DATE: 5-21-25  
JOB NO.: N092  
SCO # 24-28389-01A

A401

INTERIOR  
ELEVATIONS 1

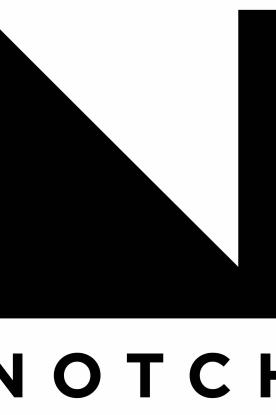


NOTCH DESIGN, PLLC  
212 W MAIN ST, SUITE E,  
CARRBORO, NC


www.notchdesign.us  
info@notchdesign.us

REVISION:  
SCO Review 9/15/25  
2nd SCO Review 10/24/25  
Construction Set 11/17/25  
1 Addendum 1 1/7/26


SEE 1&2/A401 AND 1&6/A402 FOR TYPICAL NOTES 7 LAB2/LAB1/SOCIAL WEST ELEV.

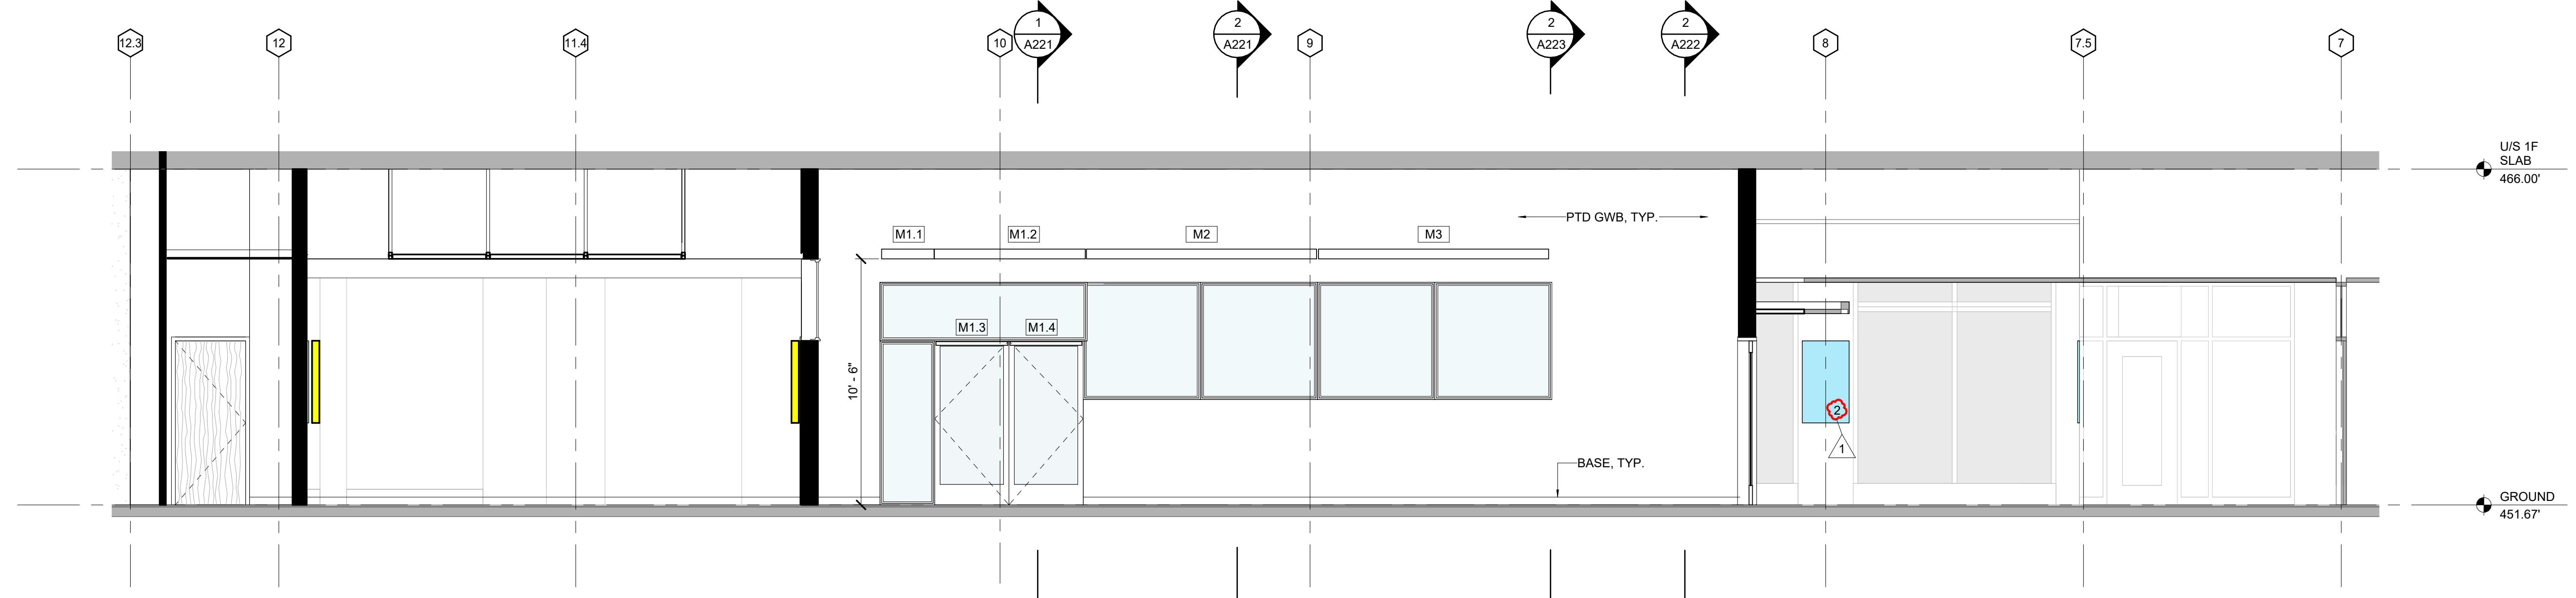

## CONSTRUCTION SET

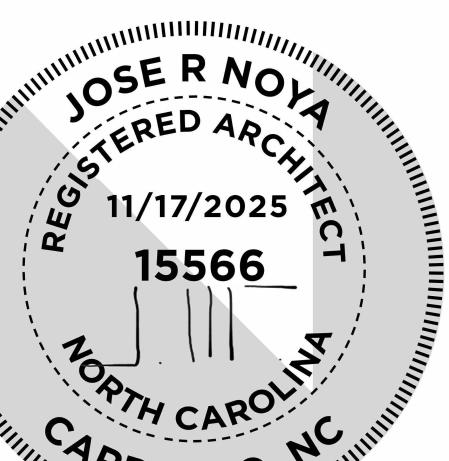

© 2025  
Notch Design

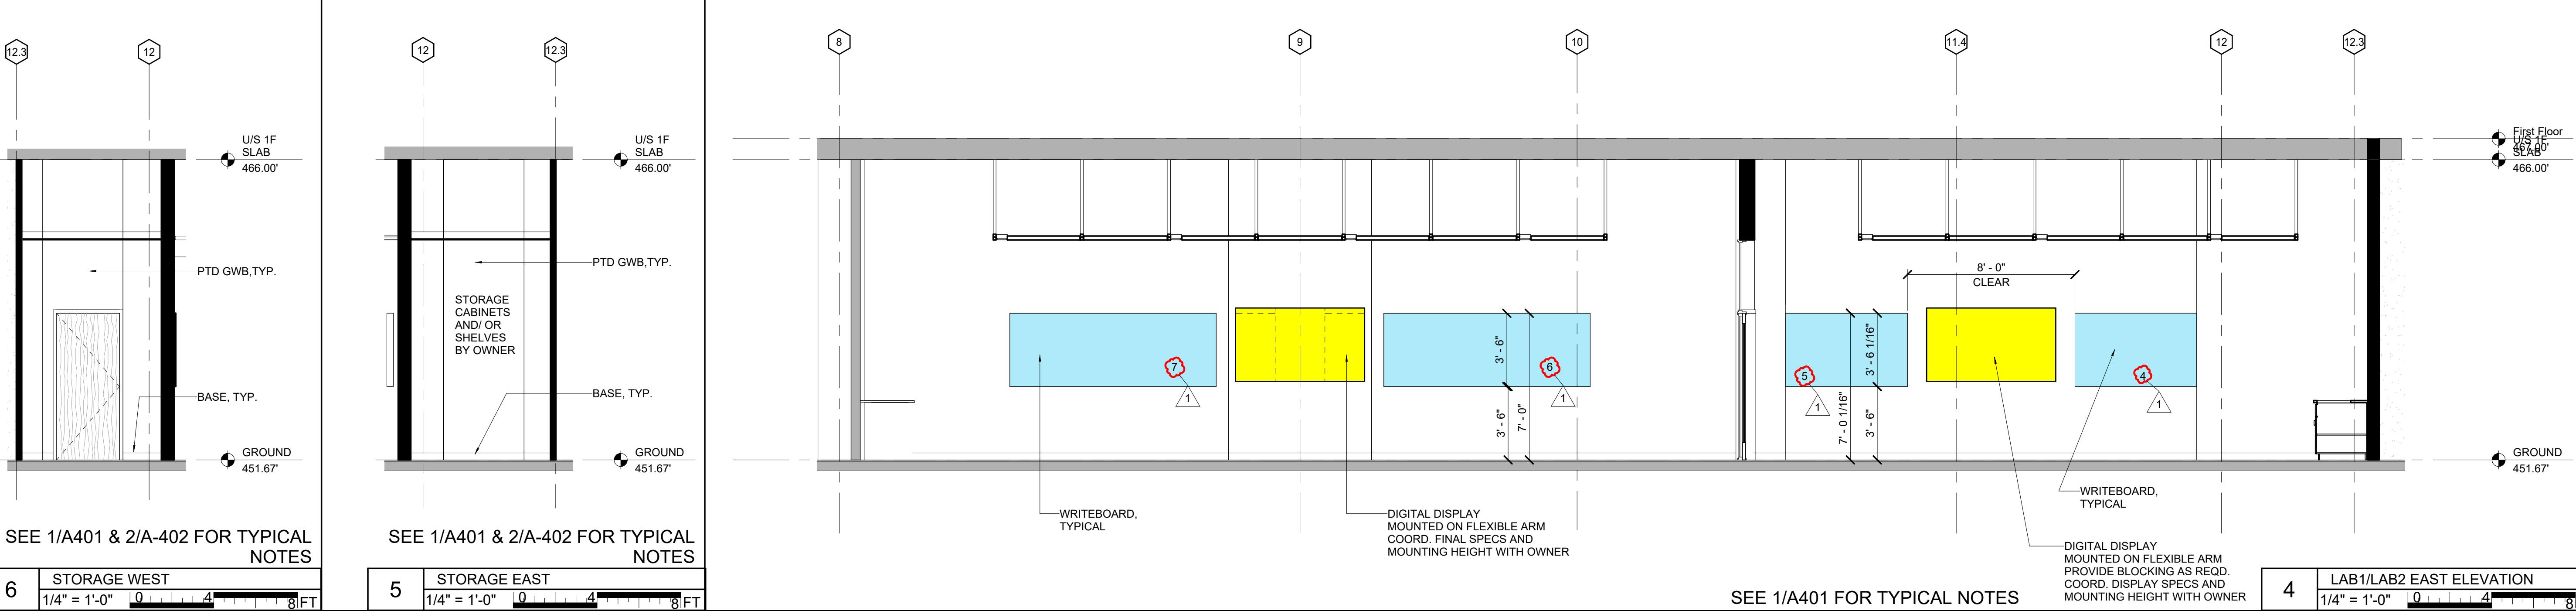

SEE 1/A401 & 2/A-402 FOR TYPICAL NOTES


6 STORAGE WEST  
1/4" = 1'-0" 0 4 8 FT

SEE 1/A401 & 2/A-402 FOR TYPICAL NOTES

5 STORAGE EAST  
1/4" = 1'-0" 0 4 8 FT

SEE 1/A401 FOR TYPICAL NOTES

4 LAB1/LAB2 EAST ELEVATION  
1/4" = 1'-0" 0 4 8 FT

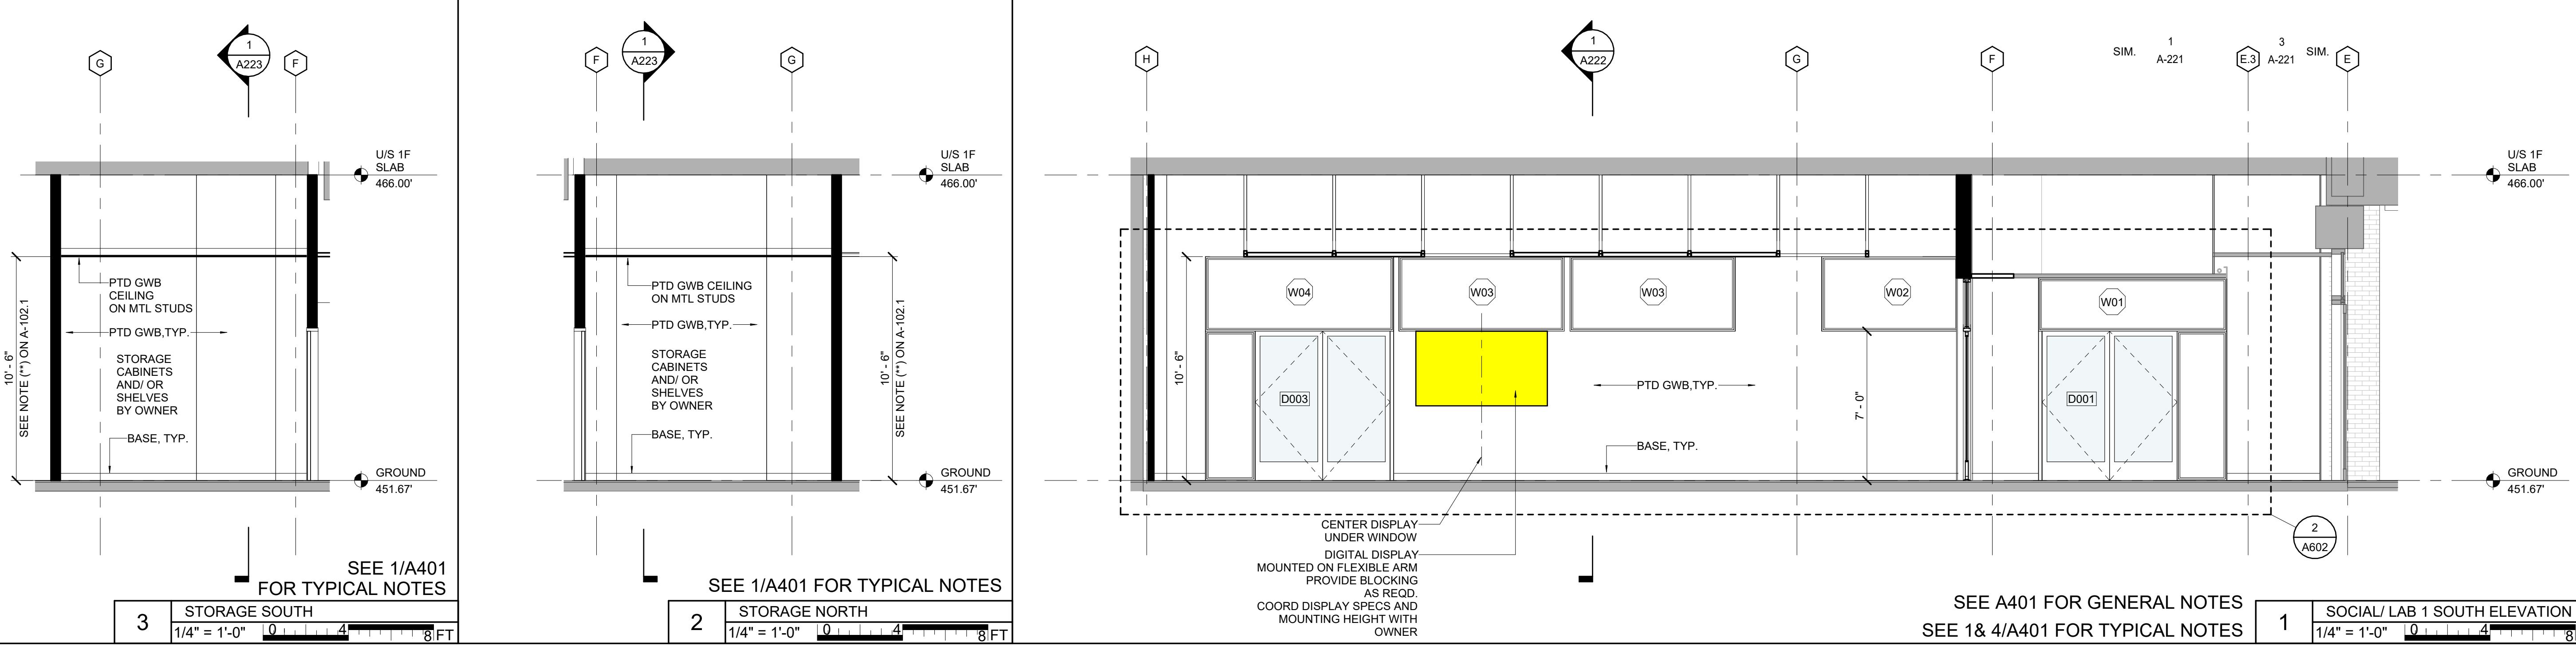

SEE 1/A401  
FOR TYPICAL NOTES

3 STORAGE SOUTH  
1/4" = 1'-0" 0 4 8 FT

SEE 1/A401 FOR TYPICAL NOTES

2 STORAGE NORTH  
1/4" = 1'-0" 0 4 8 FT

SEE A401 FOR GENERAL NOTES  
SEE 1 & 4/A401 FOR TYPICAL NOTES

1 SOCIAL/LAB 1 SOUTH ELEVATION  
1/4" = 1'-0" 0 4 8 FT

CLIENT NAME: THE UNIVERSITY OF NORTH CAROLINA AT CHAPEL HILL  
SCO NAME: UNC VENABLE HALL LOWER LEVEL UPLIFT  
LOCATION: 101 South Rd, CHAPEL HILL, NC 27514  
ISSUE DATE: 5-21-25  
JOB NO.: N092  
SCO #: 24-28389-01A

A402


INTERIOR  
ELEVATIONS 2




NOTCH DESIGN, PLLC  
212 W MAIN ST, SUITE E,  
CARRBORO, NC

www.notchdesign.us  
info@notchdesign.us


REVISION:  
SCO Review 9/15/25  
2nd SCO Review 10/24/25  
Construction Set 11/17/25  
1 Addendum 1 1/7/26

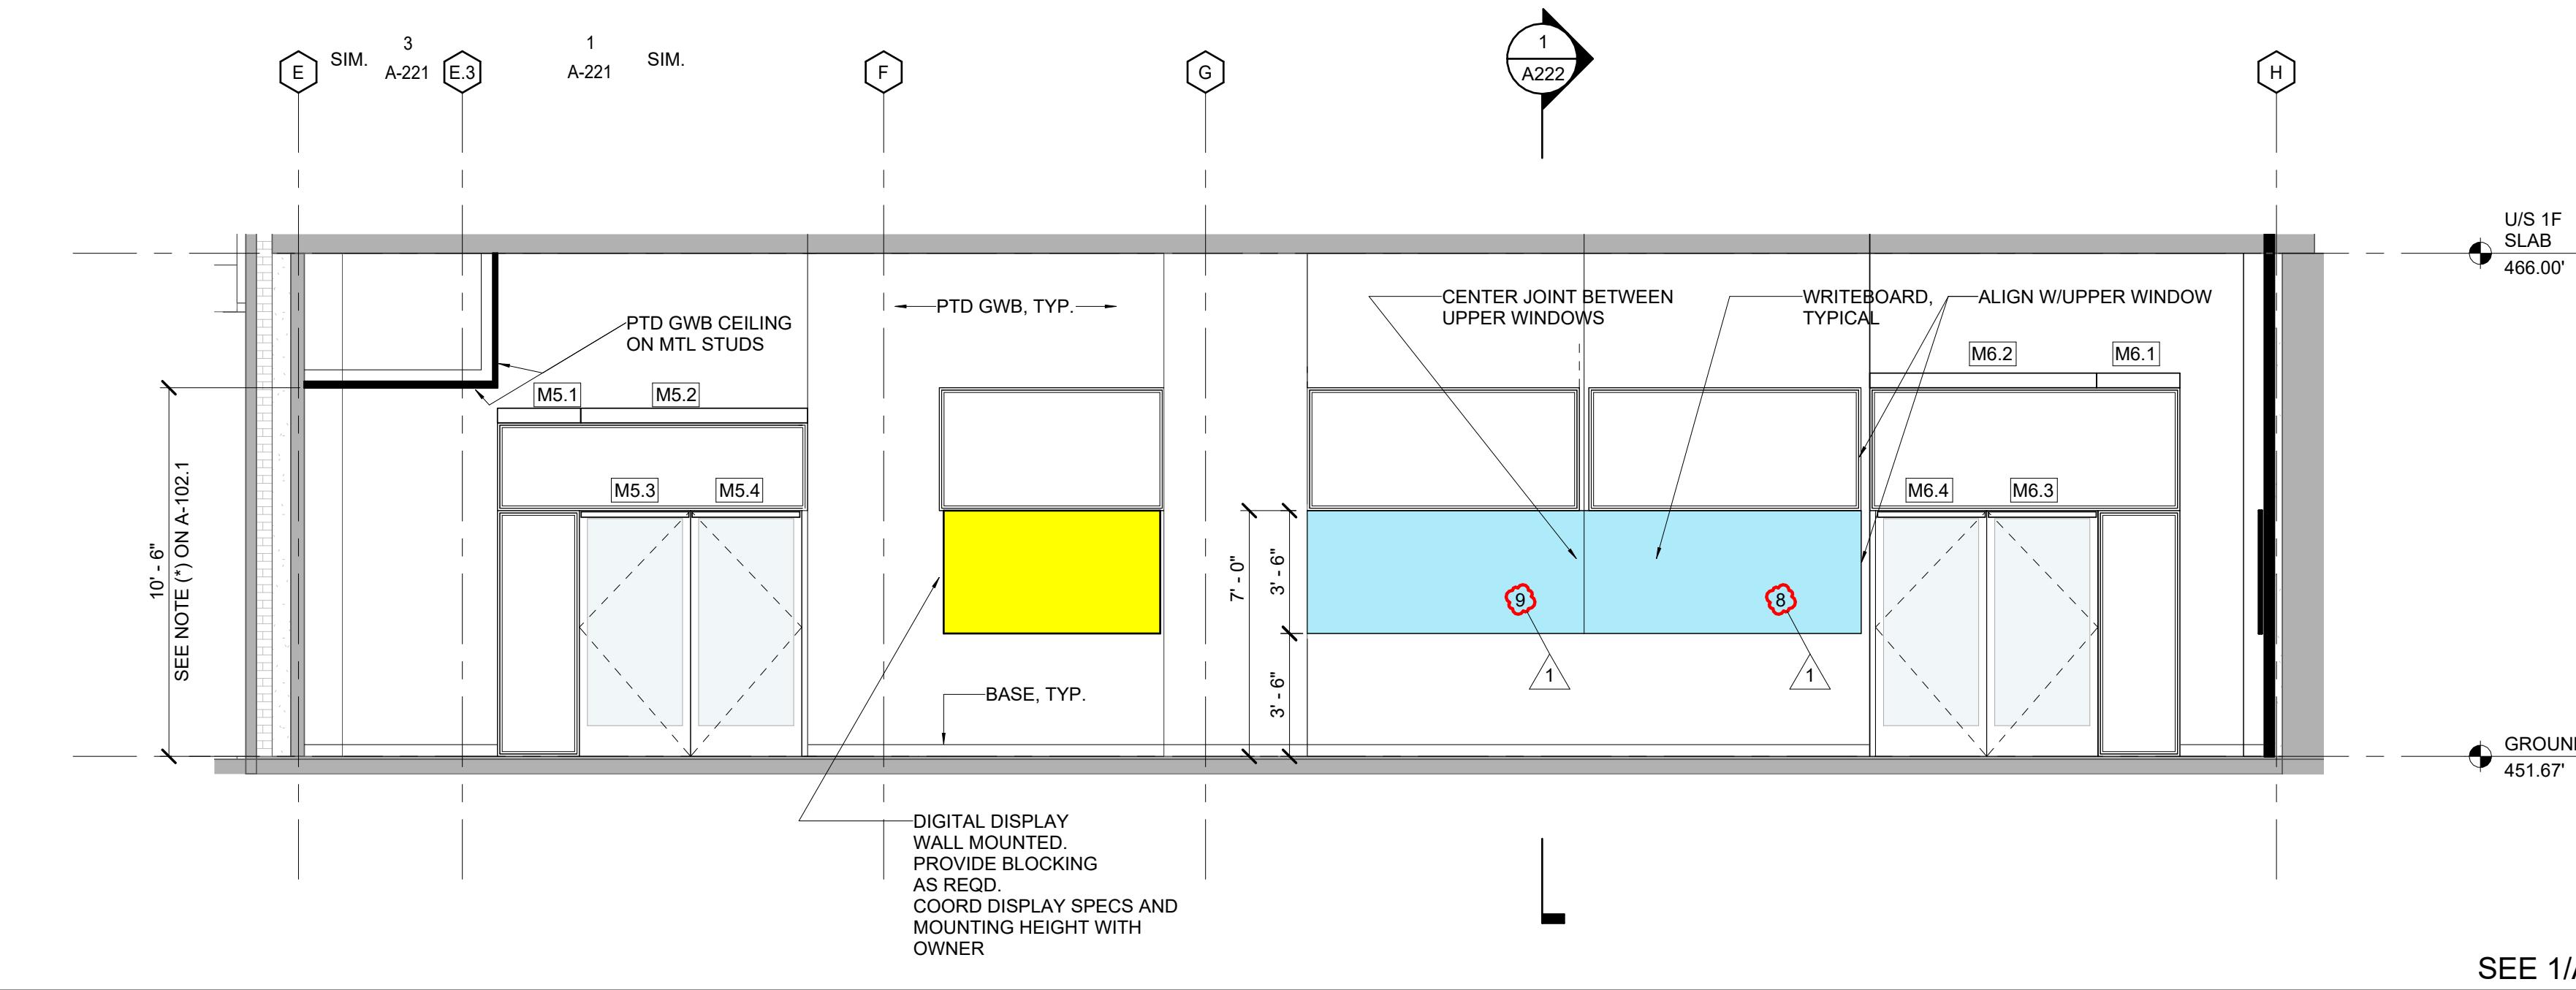



## CONSTRUCTION SET

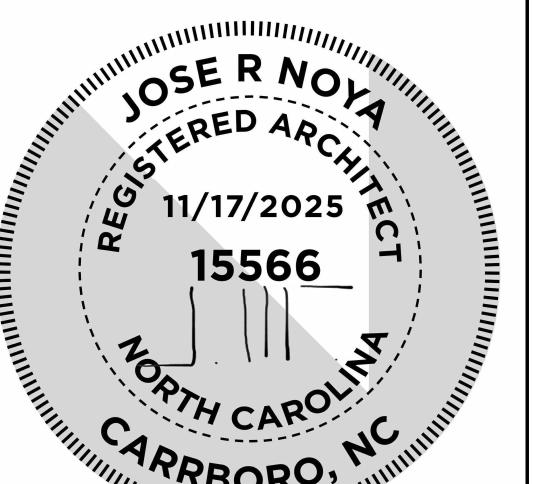

© 2025  
Notch Design

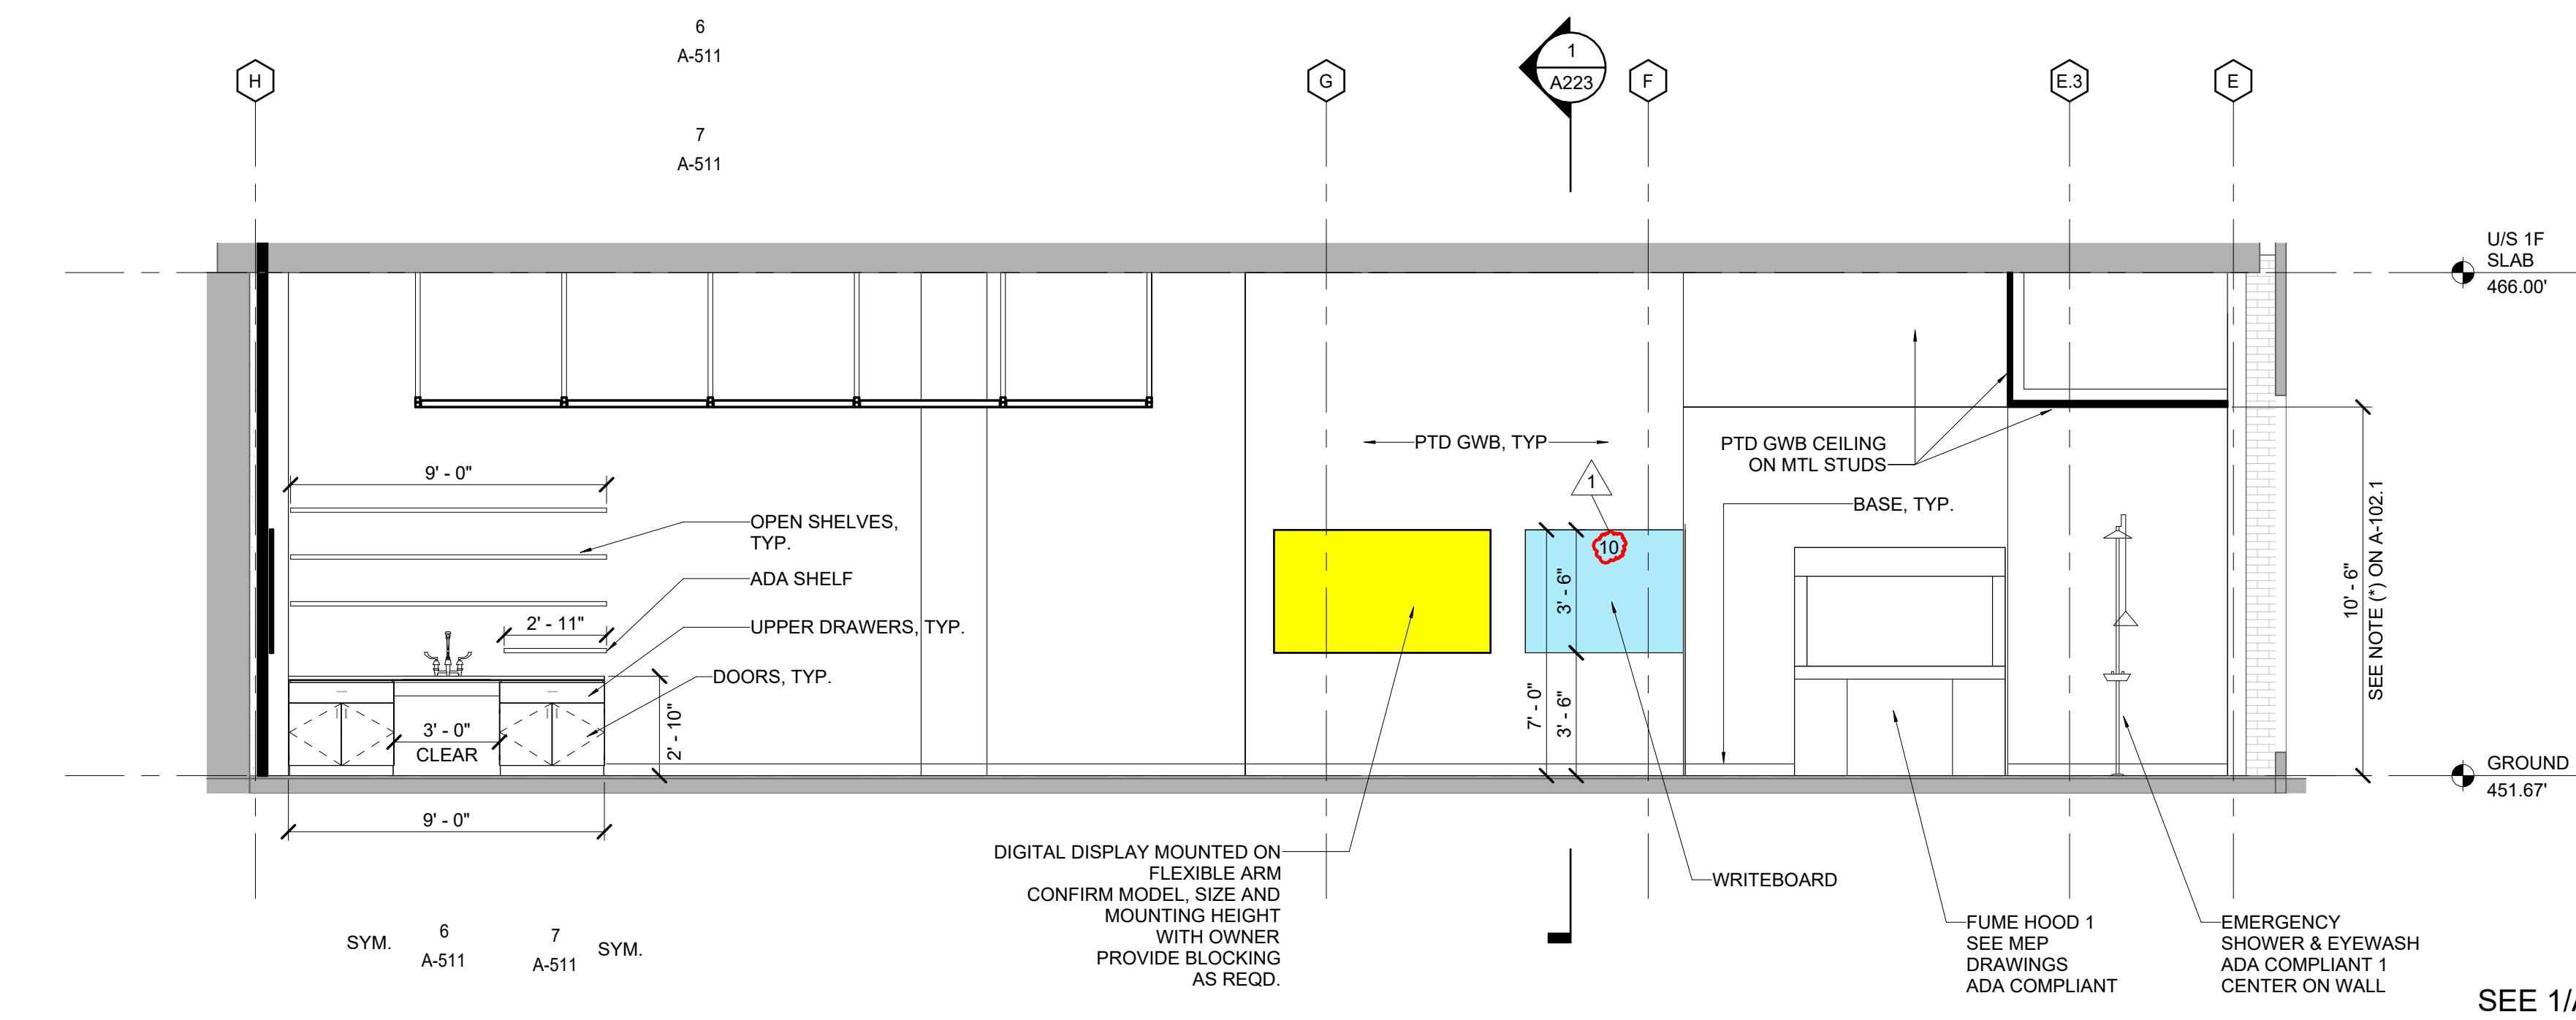

CLIENT NAME: THE UNIVERSITY OF NORTH CAROLINA AT CHAPEL HILL  
PRO. NAME: UNC VENABLE HALL LOWER LEVEL UPLIFT  
LOCATION: 101 South Rd  
CHAPEL HILL, NC 27514  
ISSUE DATE: 5-21-25  
JOB NO.: N092  
SCO # 24-28389-01A

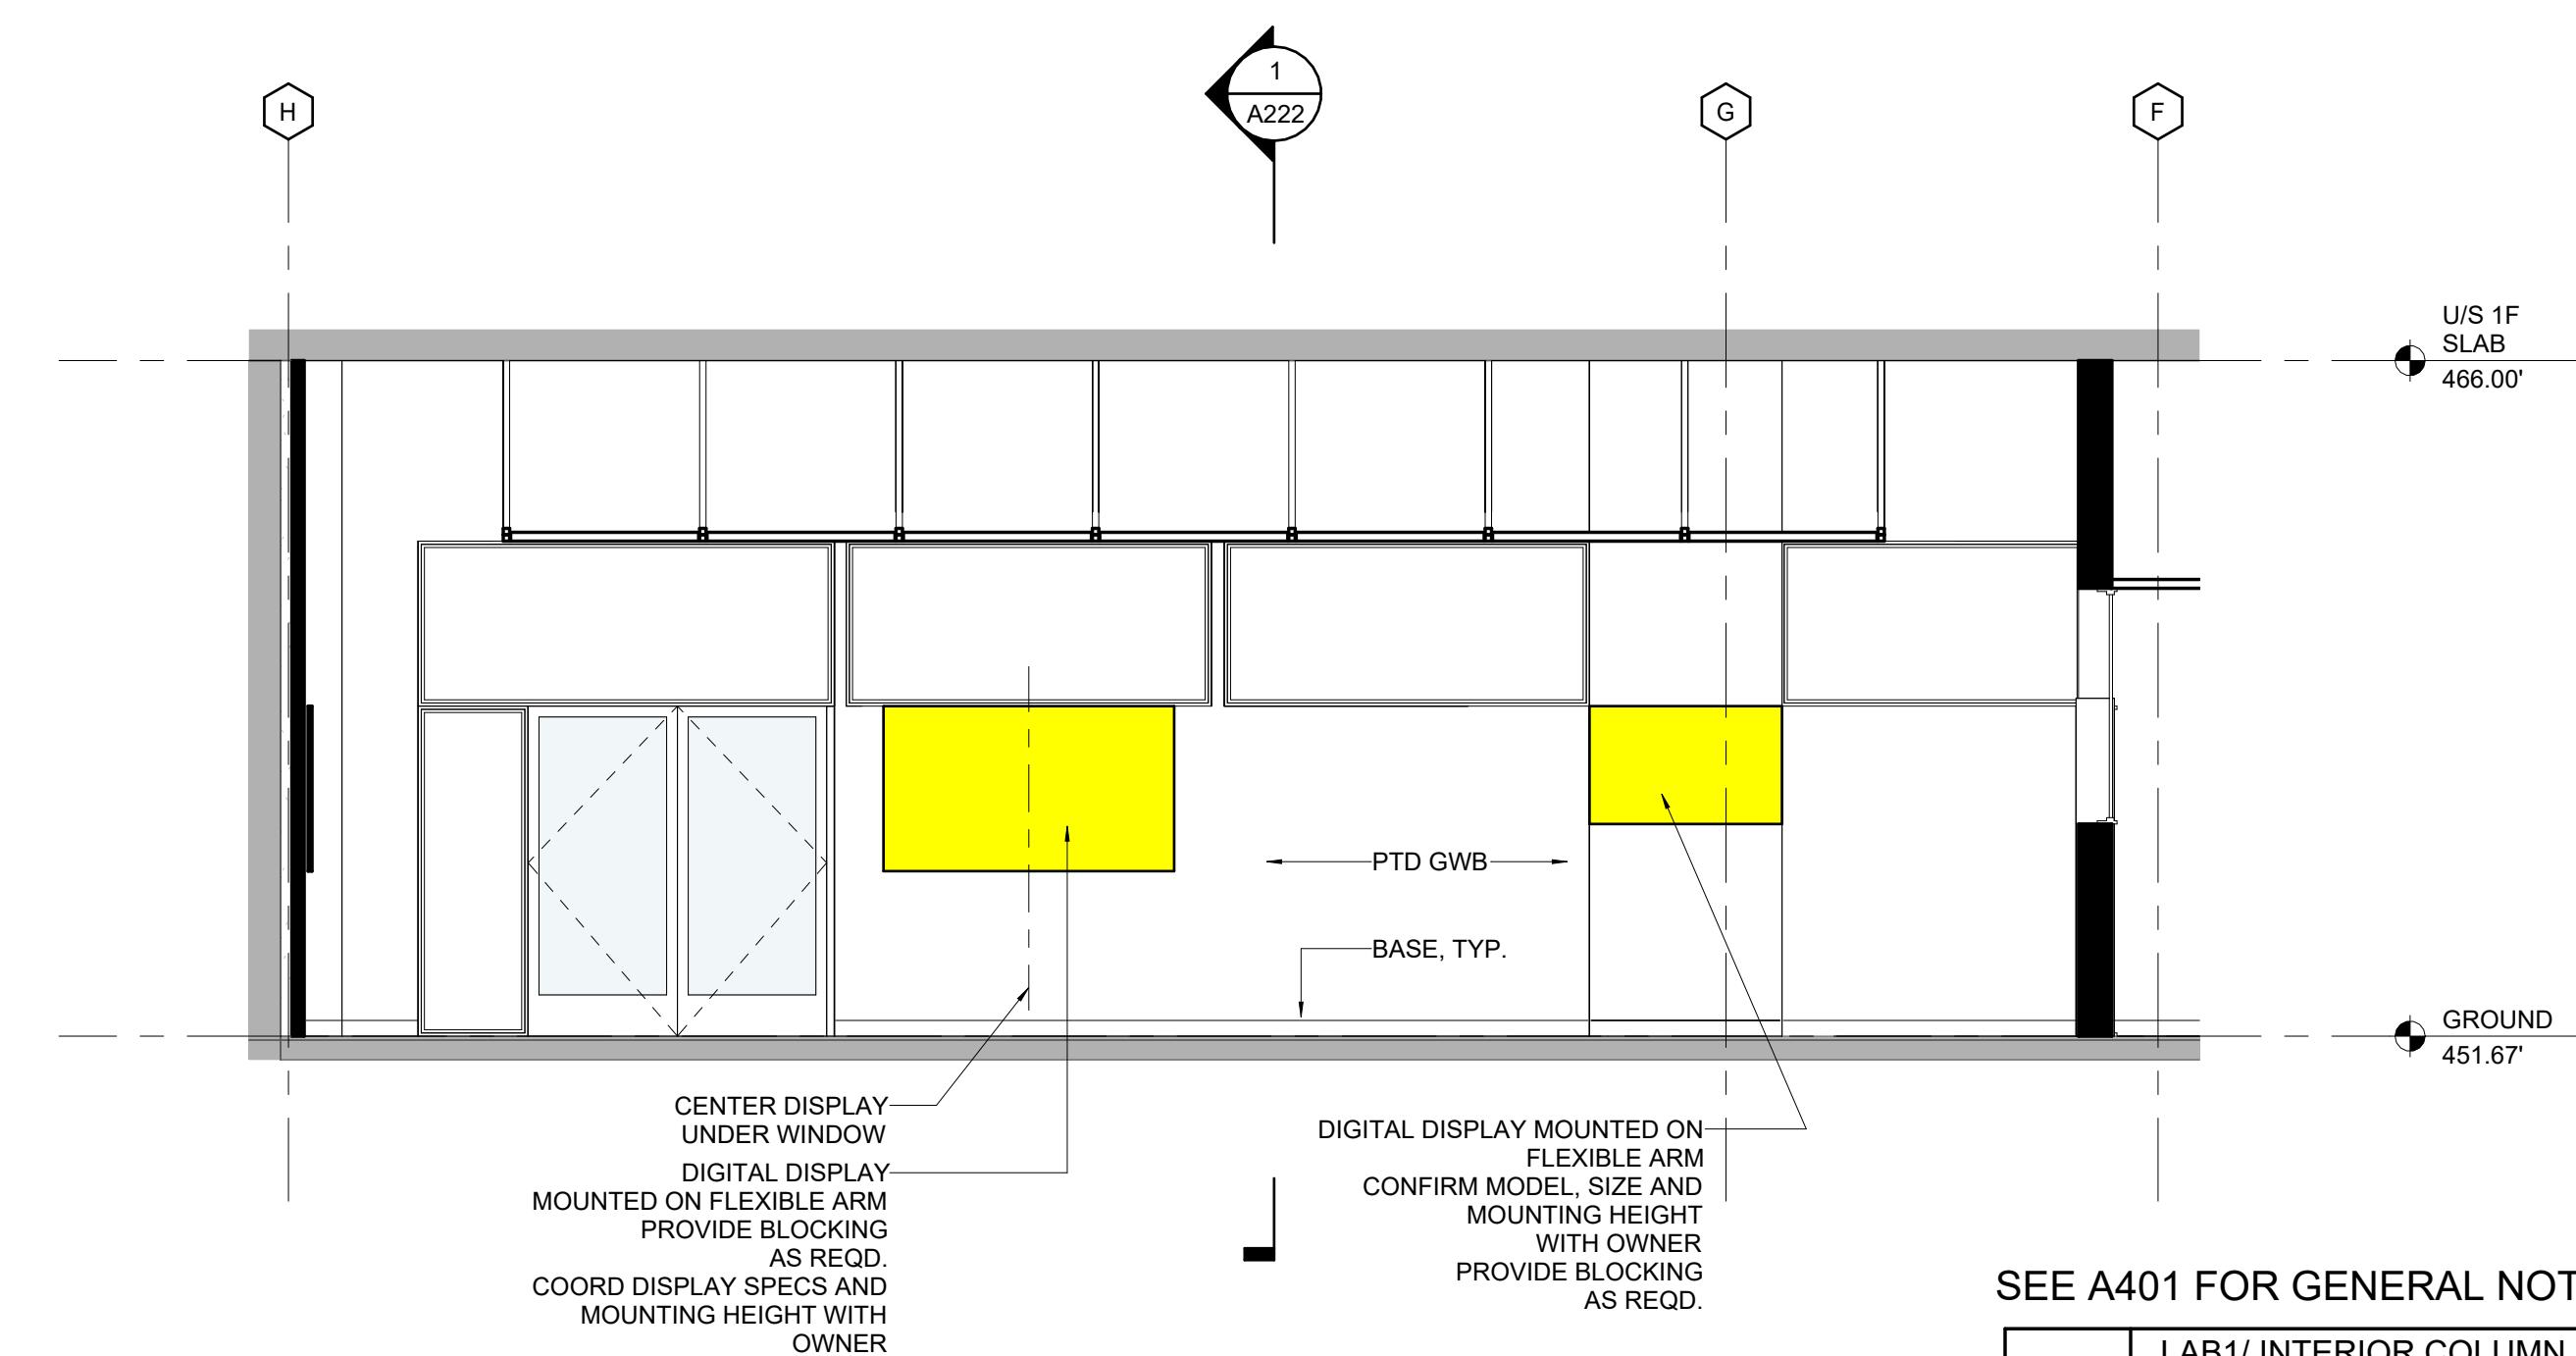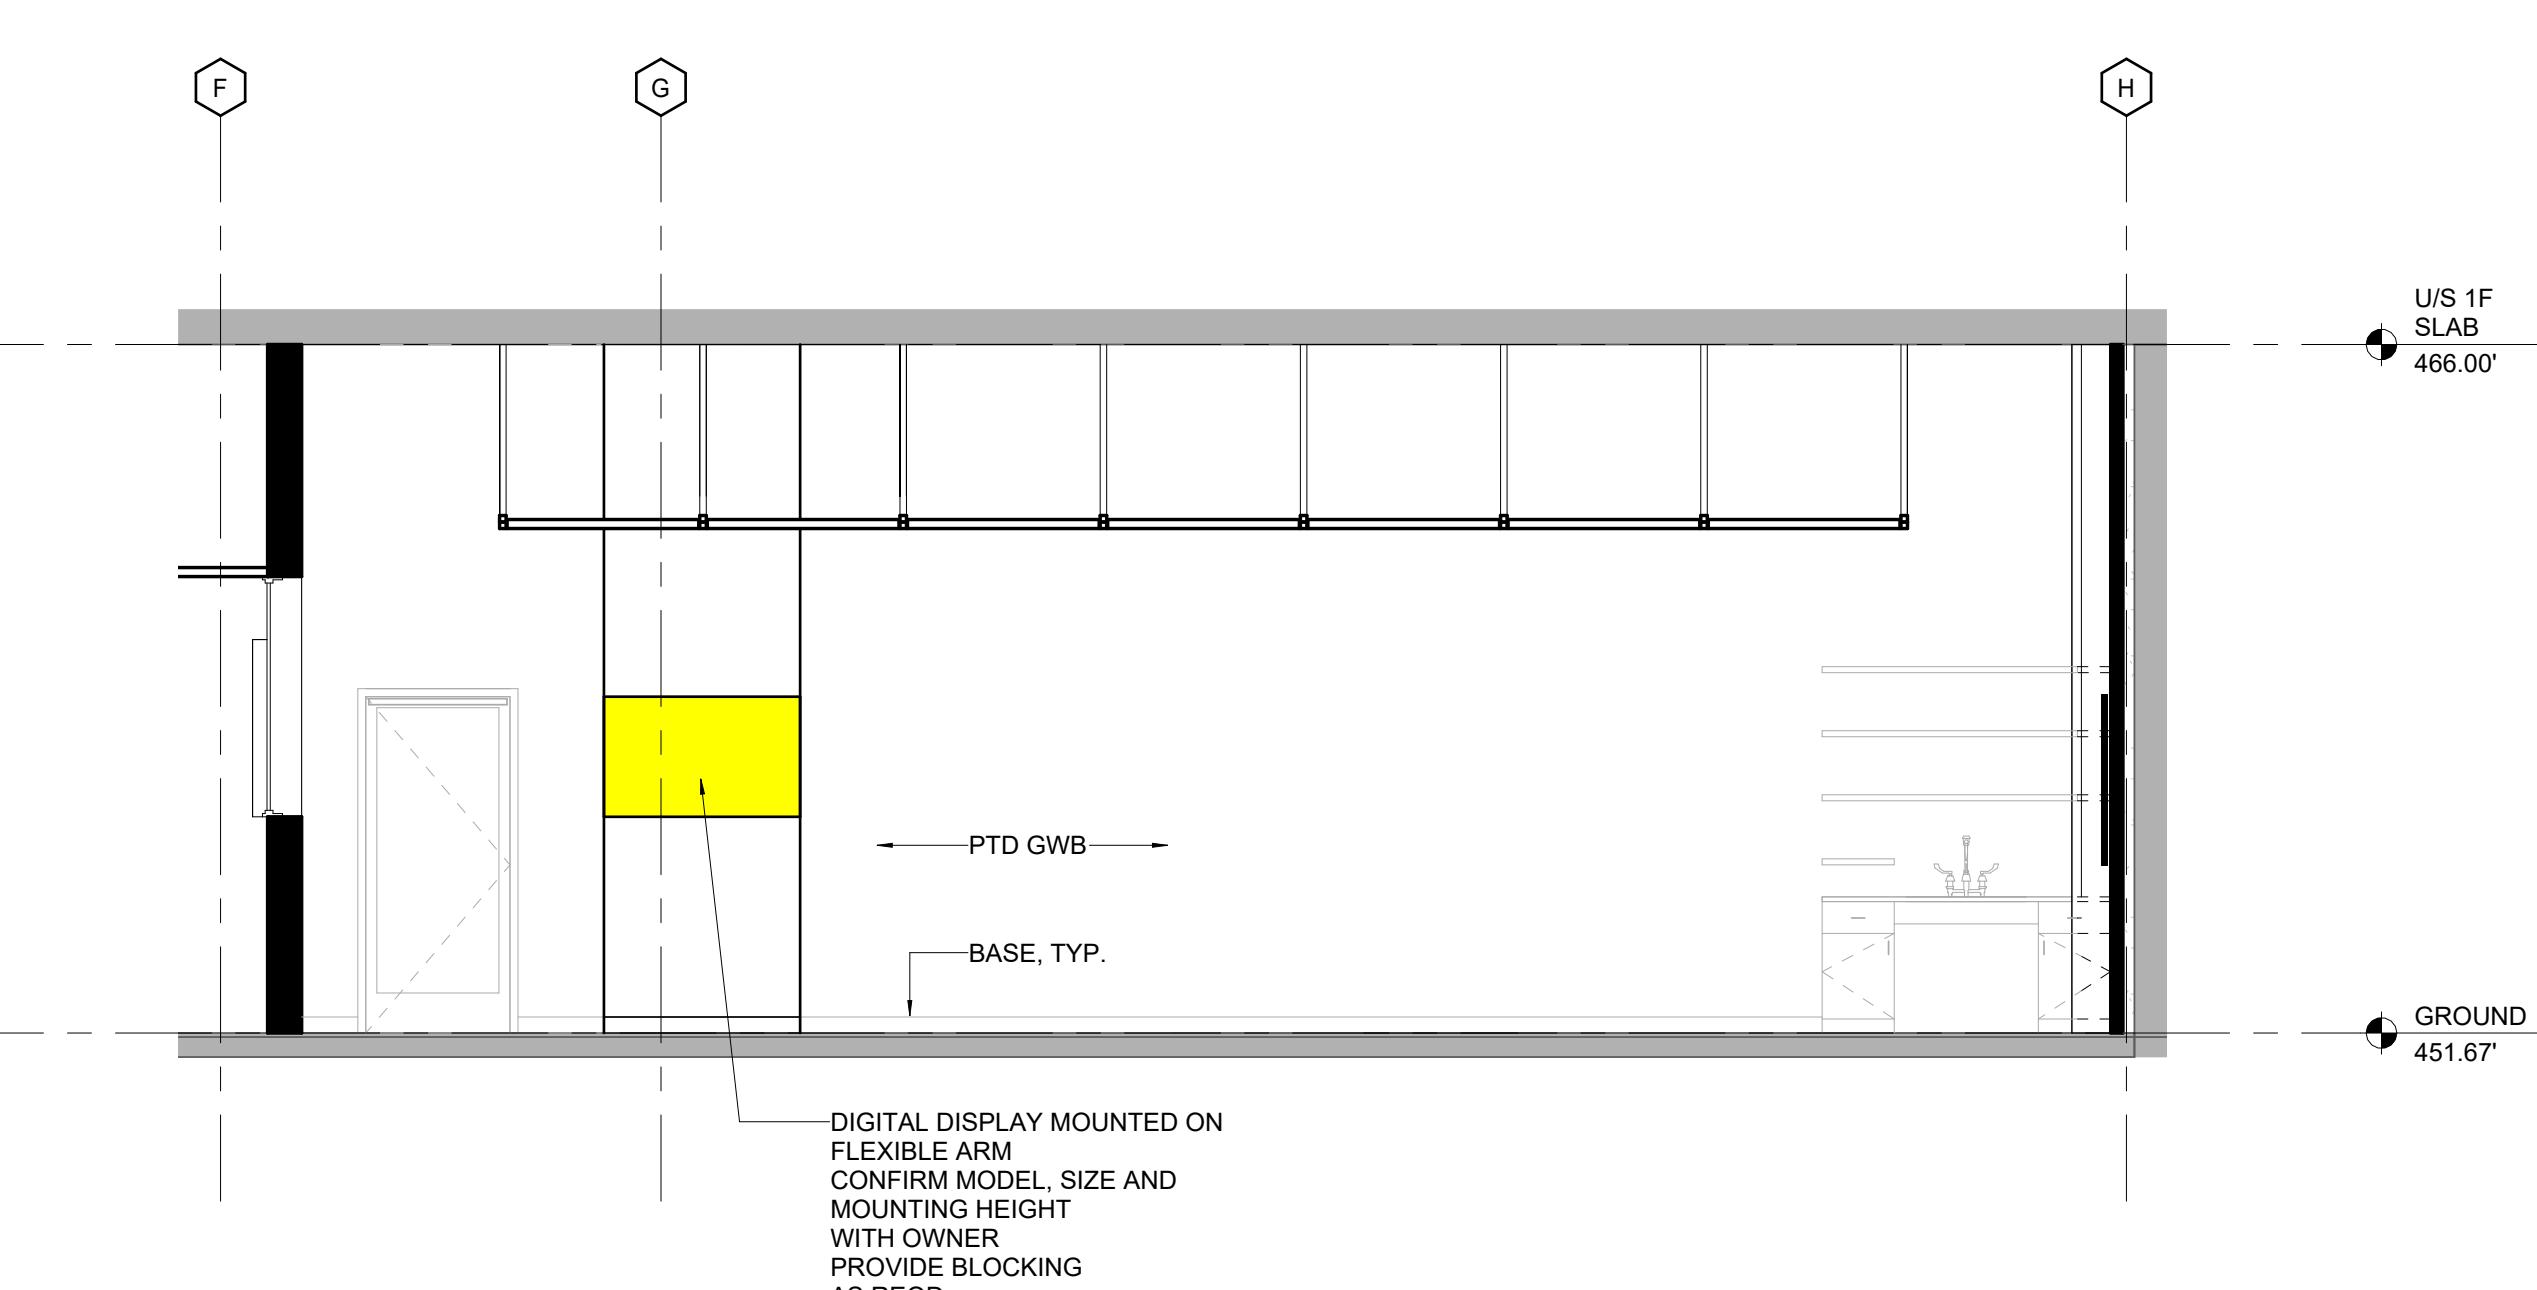

A403  
INTERIOR  
ELEVATIONS 3



NOTCH DESIGN, PLLC  
212 W MAIN ST, SUITE E,  
CARRBORO, NC


www.notchdesign.us  
info@notchdesign.us

REVISION:  
SCO Review 9/15/25  
2nd SCO Review 10/24/25  
Construction Set 11/17/25

## CONSTRUCTION SET




© 2025  
Notch Design

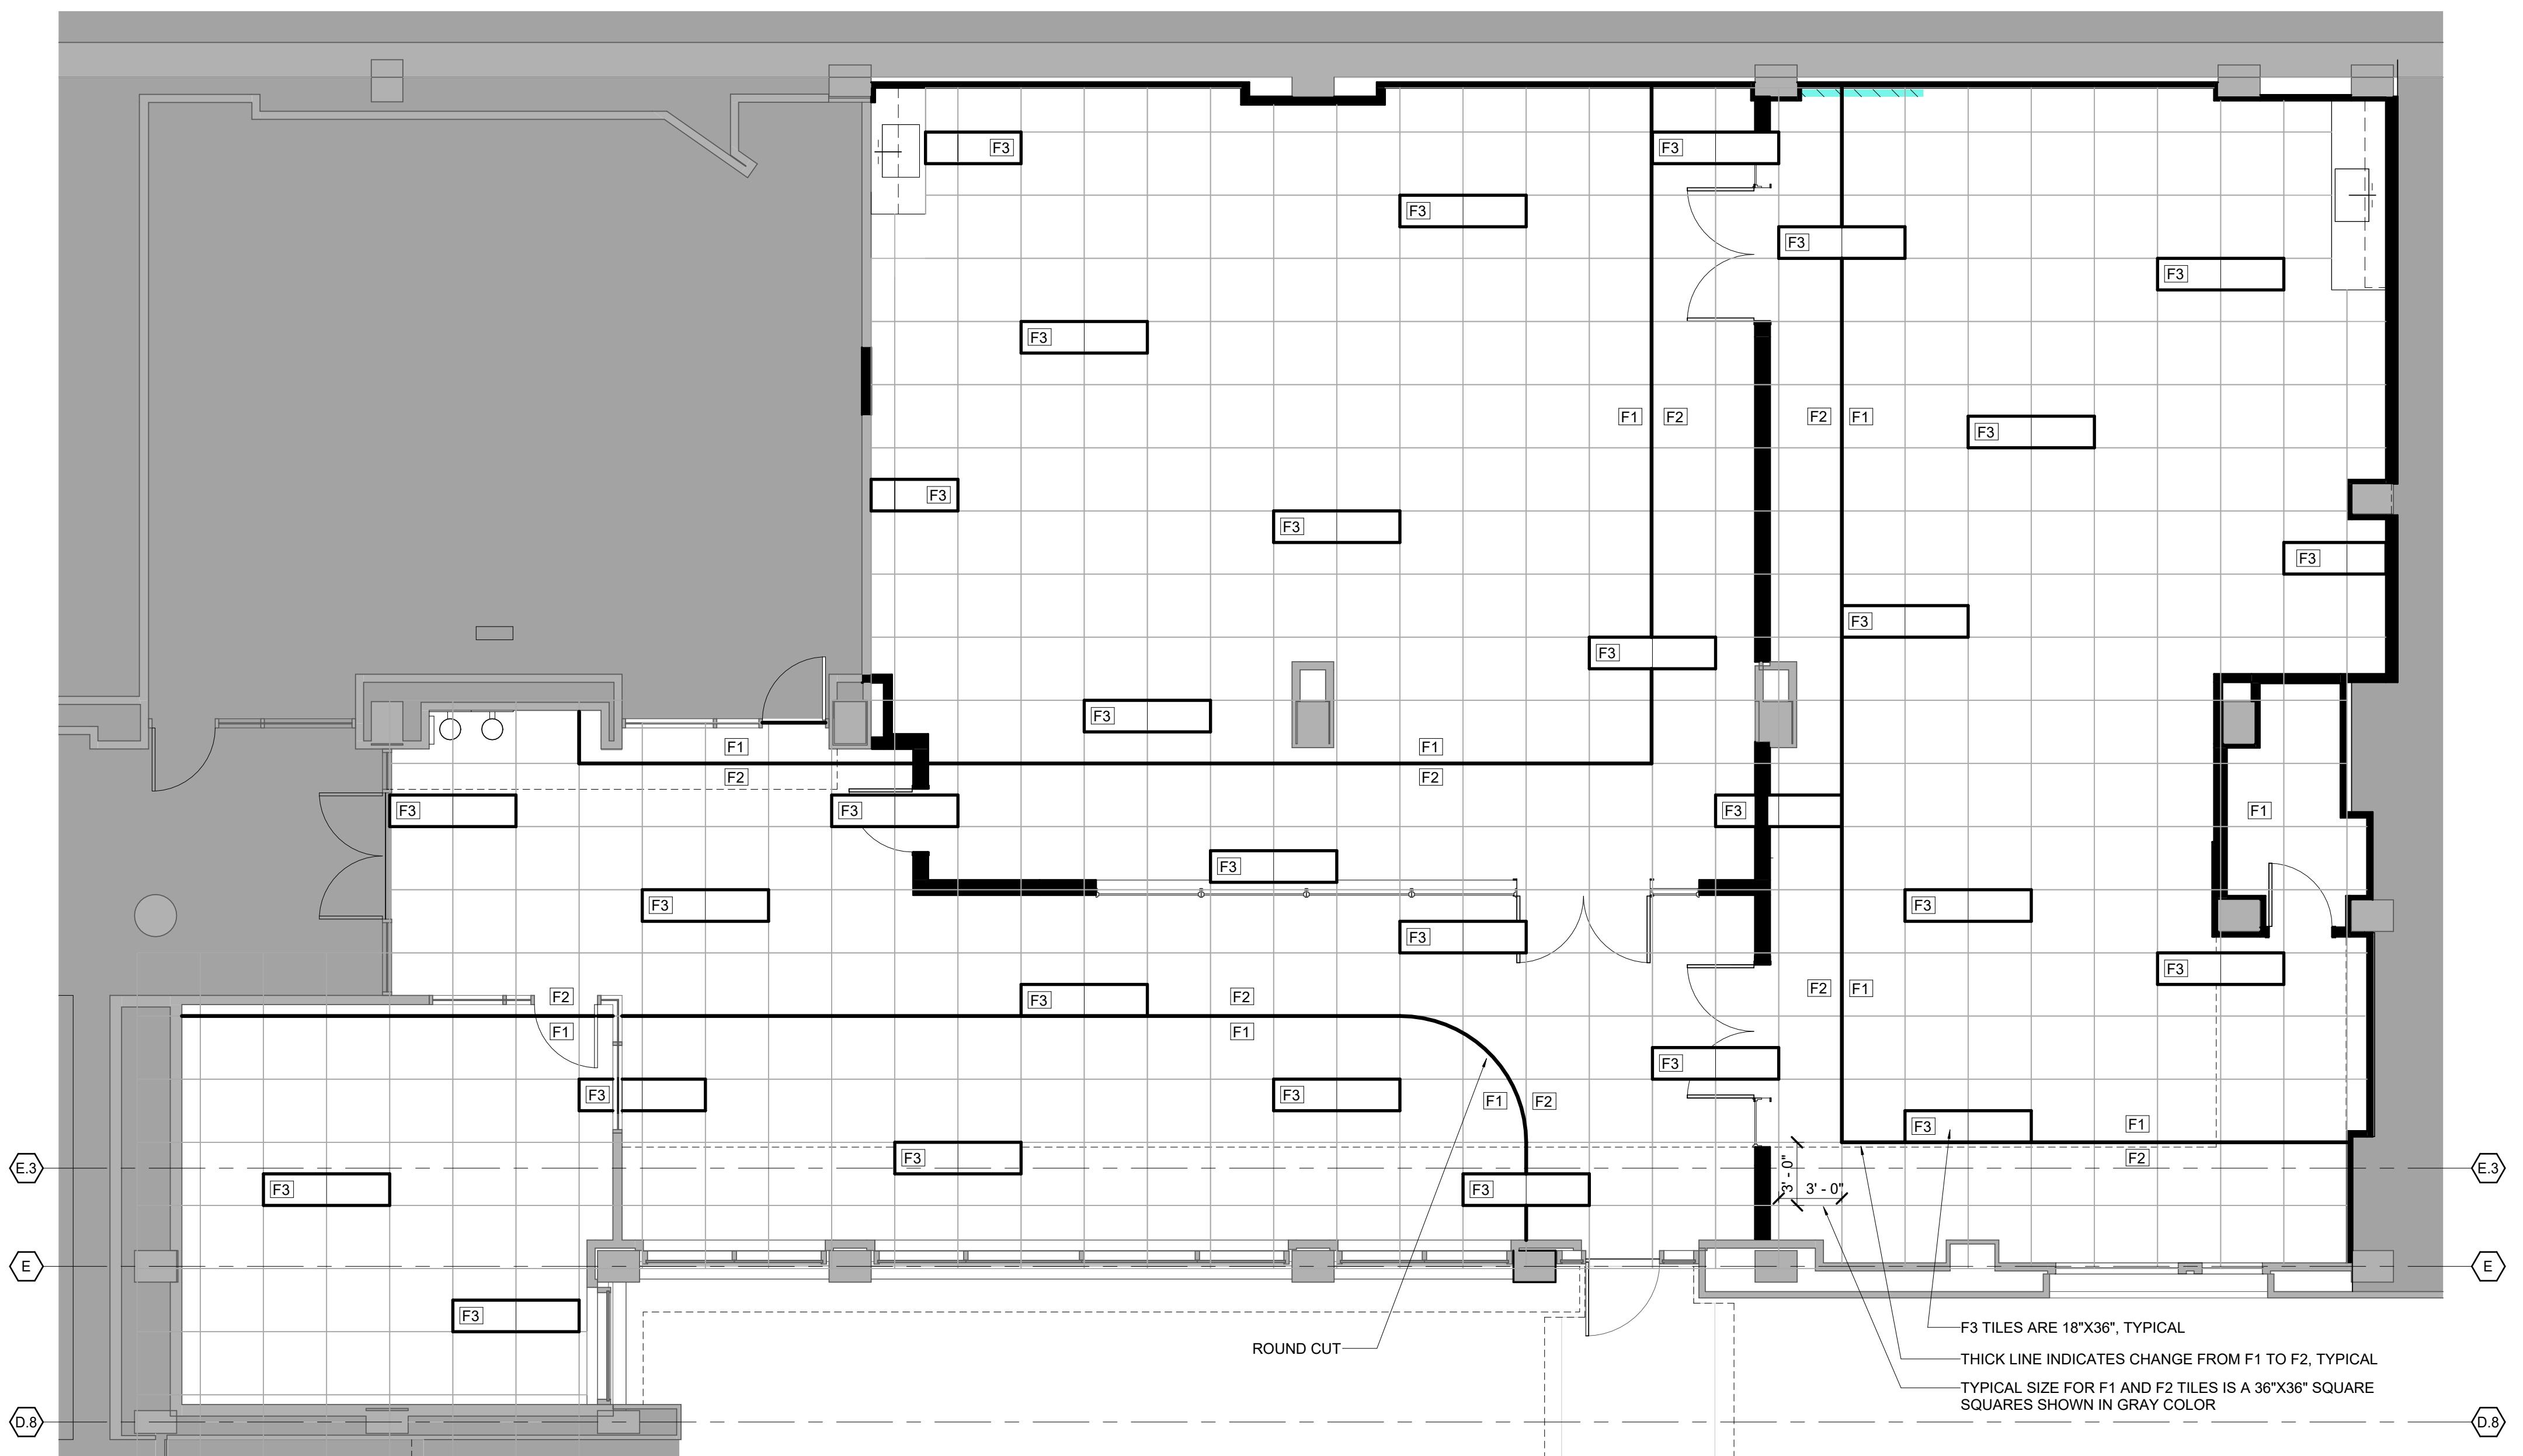

ALL JOINTS ARE WELDED AND SEAMLESS. SEE FLOORING SPECS

THIS FLOORING LAYOUT IS PRELIMINARY AND FOR BIDDING PURPOSES. MINOR ADJUSTMENTS TO THE FINAL PATTERN DESIGN MAY BE NEEDED BEFORE CONSTRUCTION. COORDINATE FINAL PATTERN WITH ARCHITECT

SEE A-601 AND A-102 3 FLOOR PATTERN  
3/16" = 1'-0"

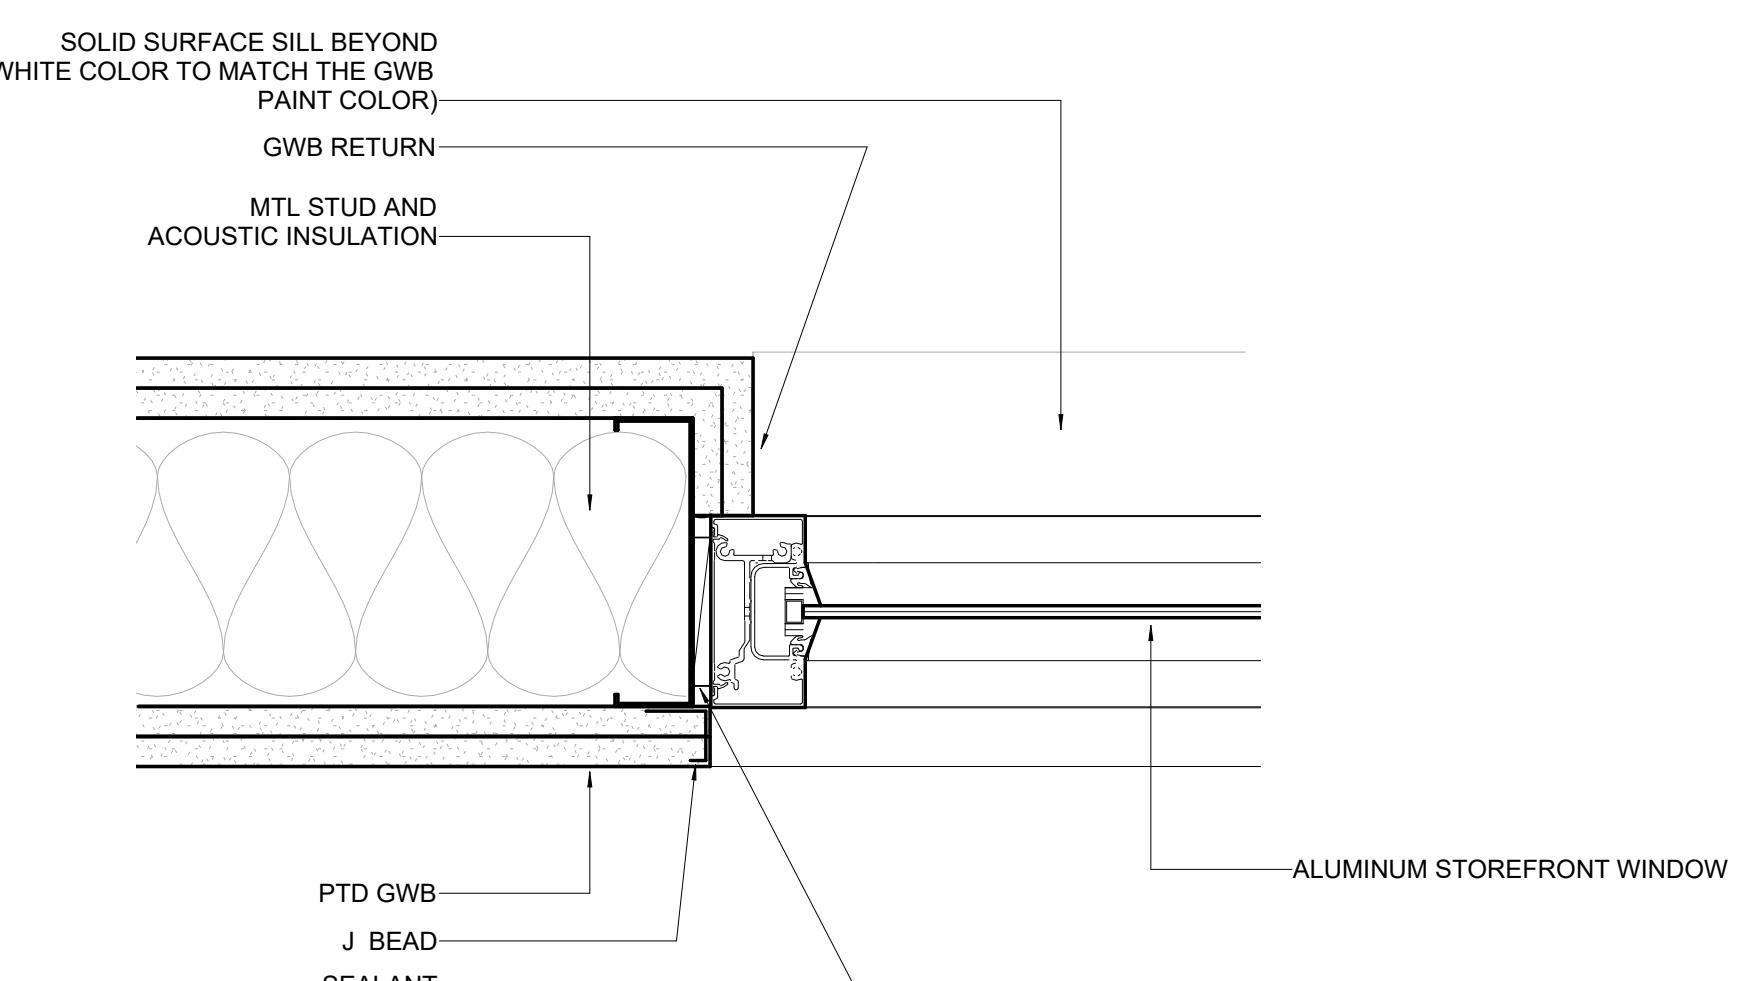

10 6 12 IN  
2 STOREFRONT PLAN DETAIL  
3" = 1'-0"

SEE A102 FOR TYPICAL NOTES AND LEGEND

1 ADD ALTERNATE 1-SECOND HOOD  
1/4" = 1'-0"

CLIENT NAME: THE UNIVERSITY OF NORTH CAROLINA AT CHAPEL HILL  
PROJ. NAME: UNC VENABLE HALL LOWER LEVEL UPLIFT  
LOCATION: 101 South Rd  
CARRBORO, NC 27514

ISSUE DATE: 5-21-25

JOB NO.: N092

SCO # 24-28389-01A

**A501**

PLAN DETAILS




NOTCH DESIGN, PLLC  
212 W MAIN ST, SUITE E,  
CARRBORO, NC

www.notchdesign.us  
info@notchdesign.us

REVISION:  
SCO Review 9/15/25  
2nd SCO Review 10/24/25  
Construction Set 11/17/25

## CONSTRUCTION SET

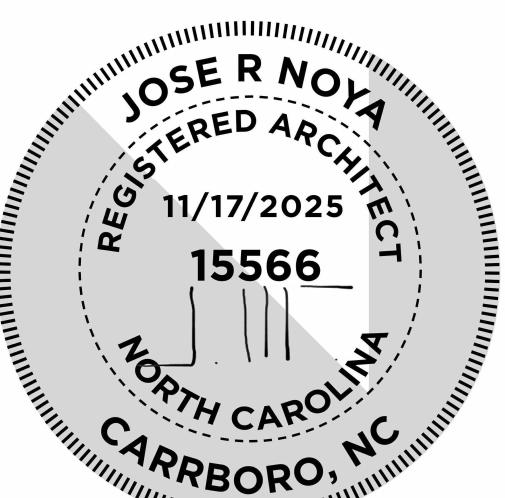


© 2025  
Notch Design

THE UNIVERSITY OF NORTH CAROLINA AT CHAPEL HILL  
JOB NAME: UNC VENABLE HALL LOWER LEVEL UPGRADE  
LOCATION: 101 South Rd  
CHASE HILL, NC 27514

CLIENT NAME: THE UNIVERSITY OF NORTH CAROLINA AT CHAPEL HILL  
ISSUE DATE: 5-21-25  
JOB NO.: N092  
SCO # 24-28389-01A

**A511**

SECTION DETAILS

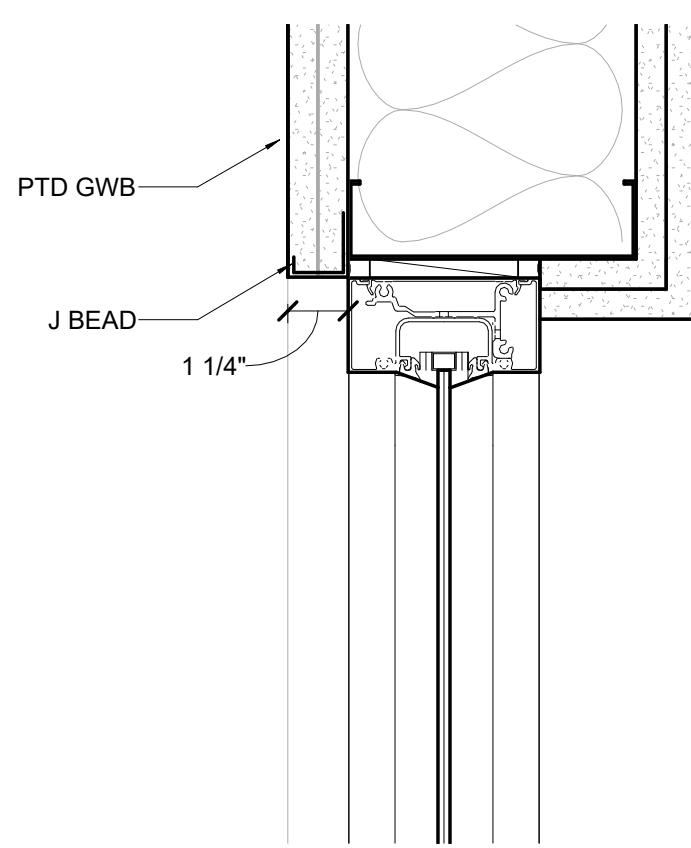


SEE 3/A-511 FOR GENERAL NOTES

4

STOREFRONT HEAD 2

3" = 1' - 0"

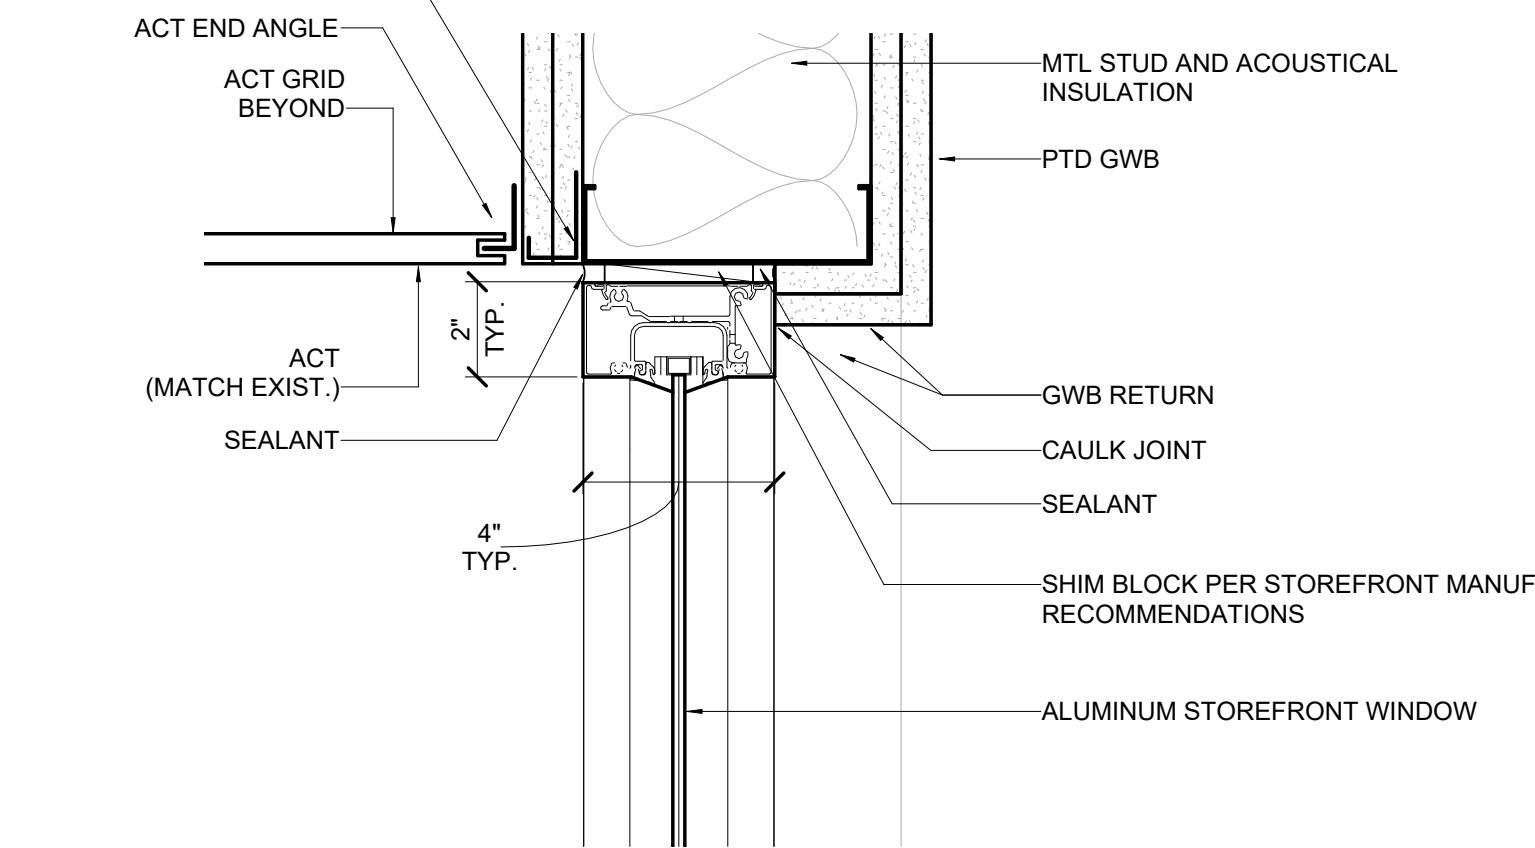


SEE 6/A-511 FOR ALTERNATIVE DETAIL WITH SHADES  
CONFIRM WITH OWNER NUMBER AND LOCATION OF SHADES

3

STOREFRONT HEAD DETAIL

3" = 1' - 0"

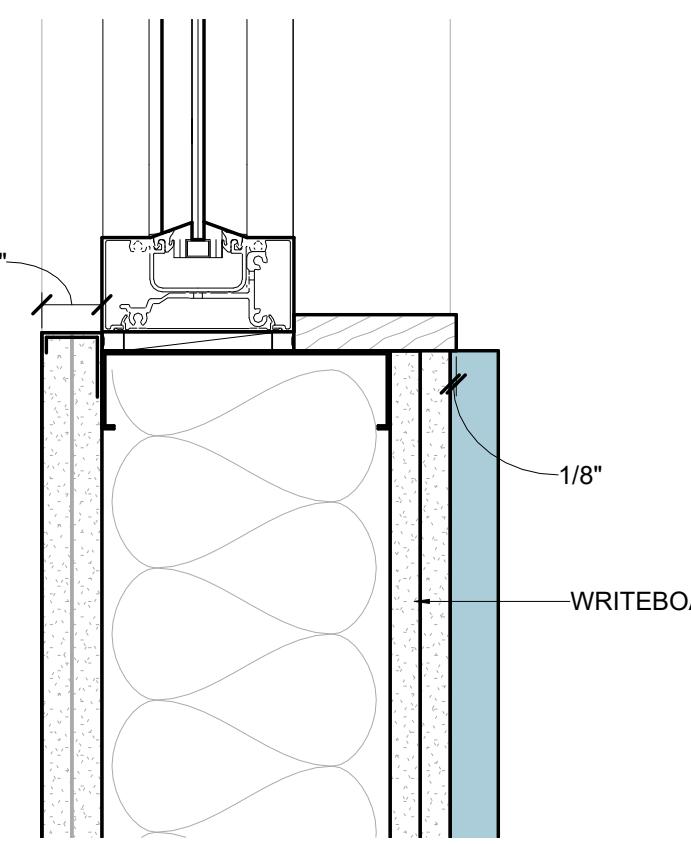


SEE 2/A-511 FOR GENERAL NOTES

5

STOREFRONT SILL 2

3" = 1' - 0"

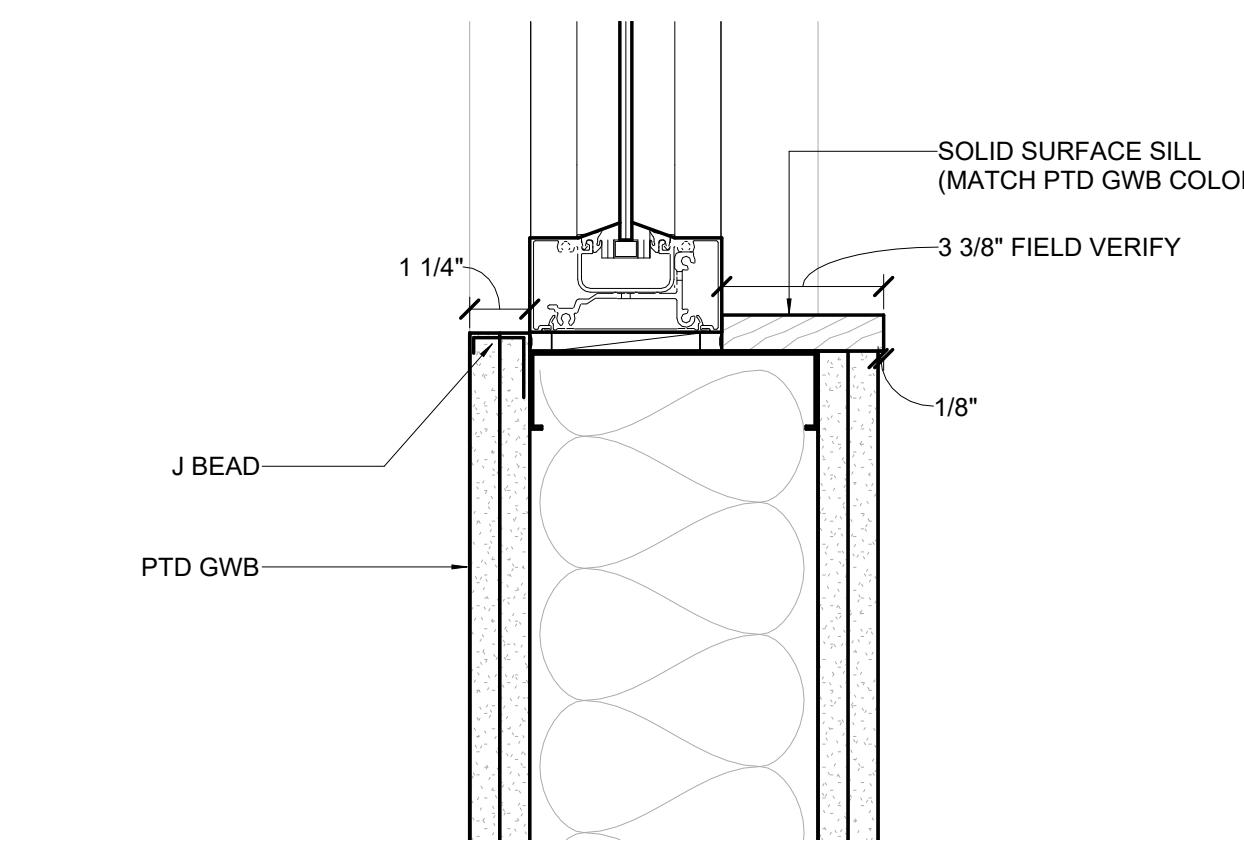


SEE 3/A-511 FOR GENERAL NOTES

2

STOREFRONT SILL DETAIL


3" = 1' - 0"

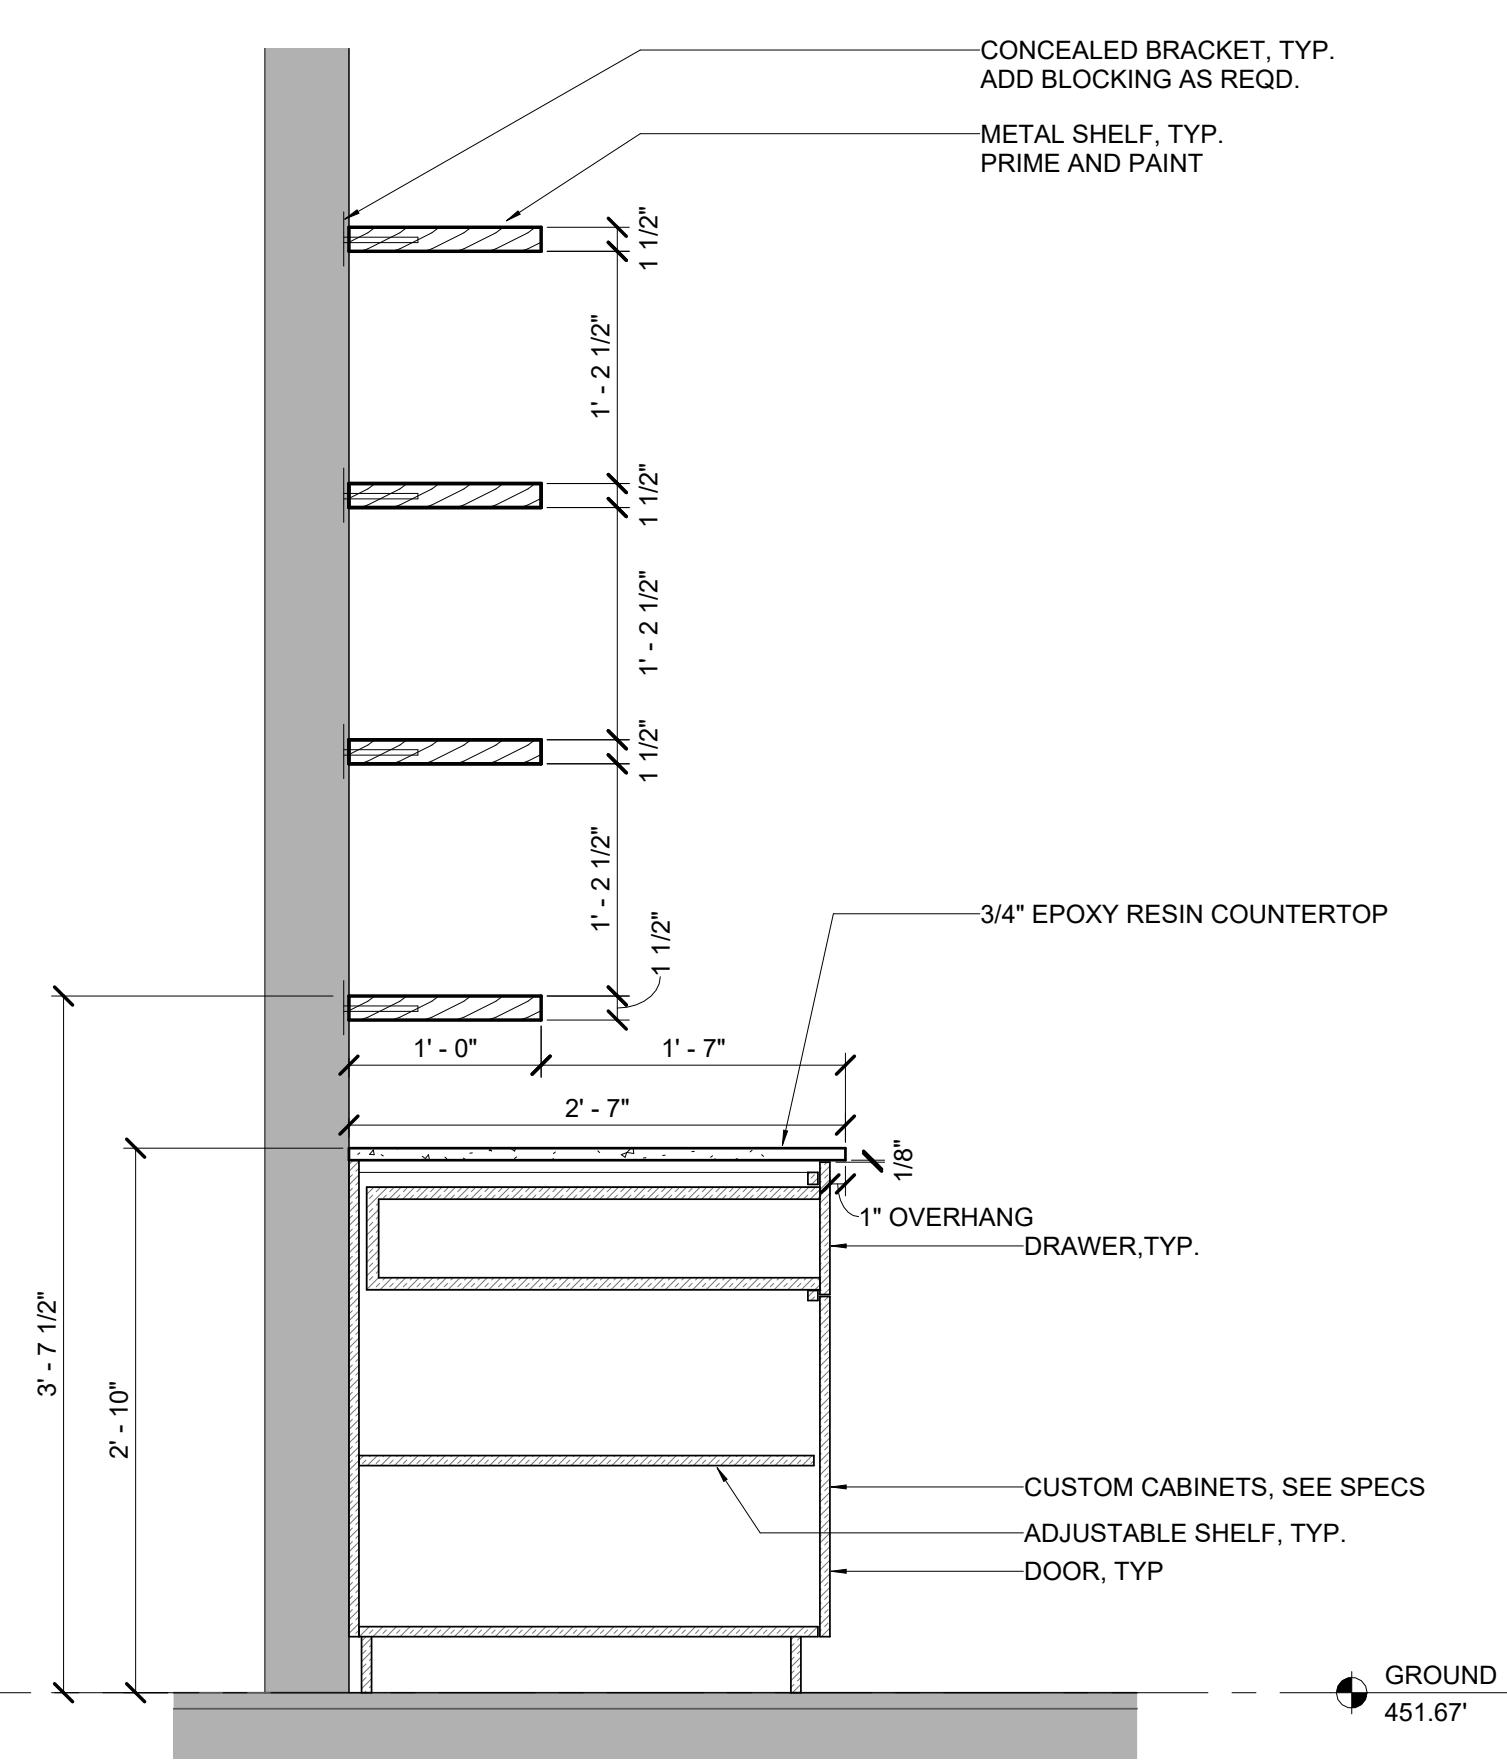

7

BUILT-IN CABINET SECTION 2

1" = 1' - 0"

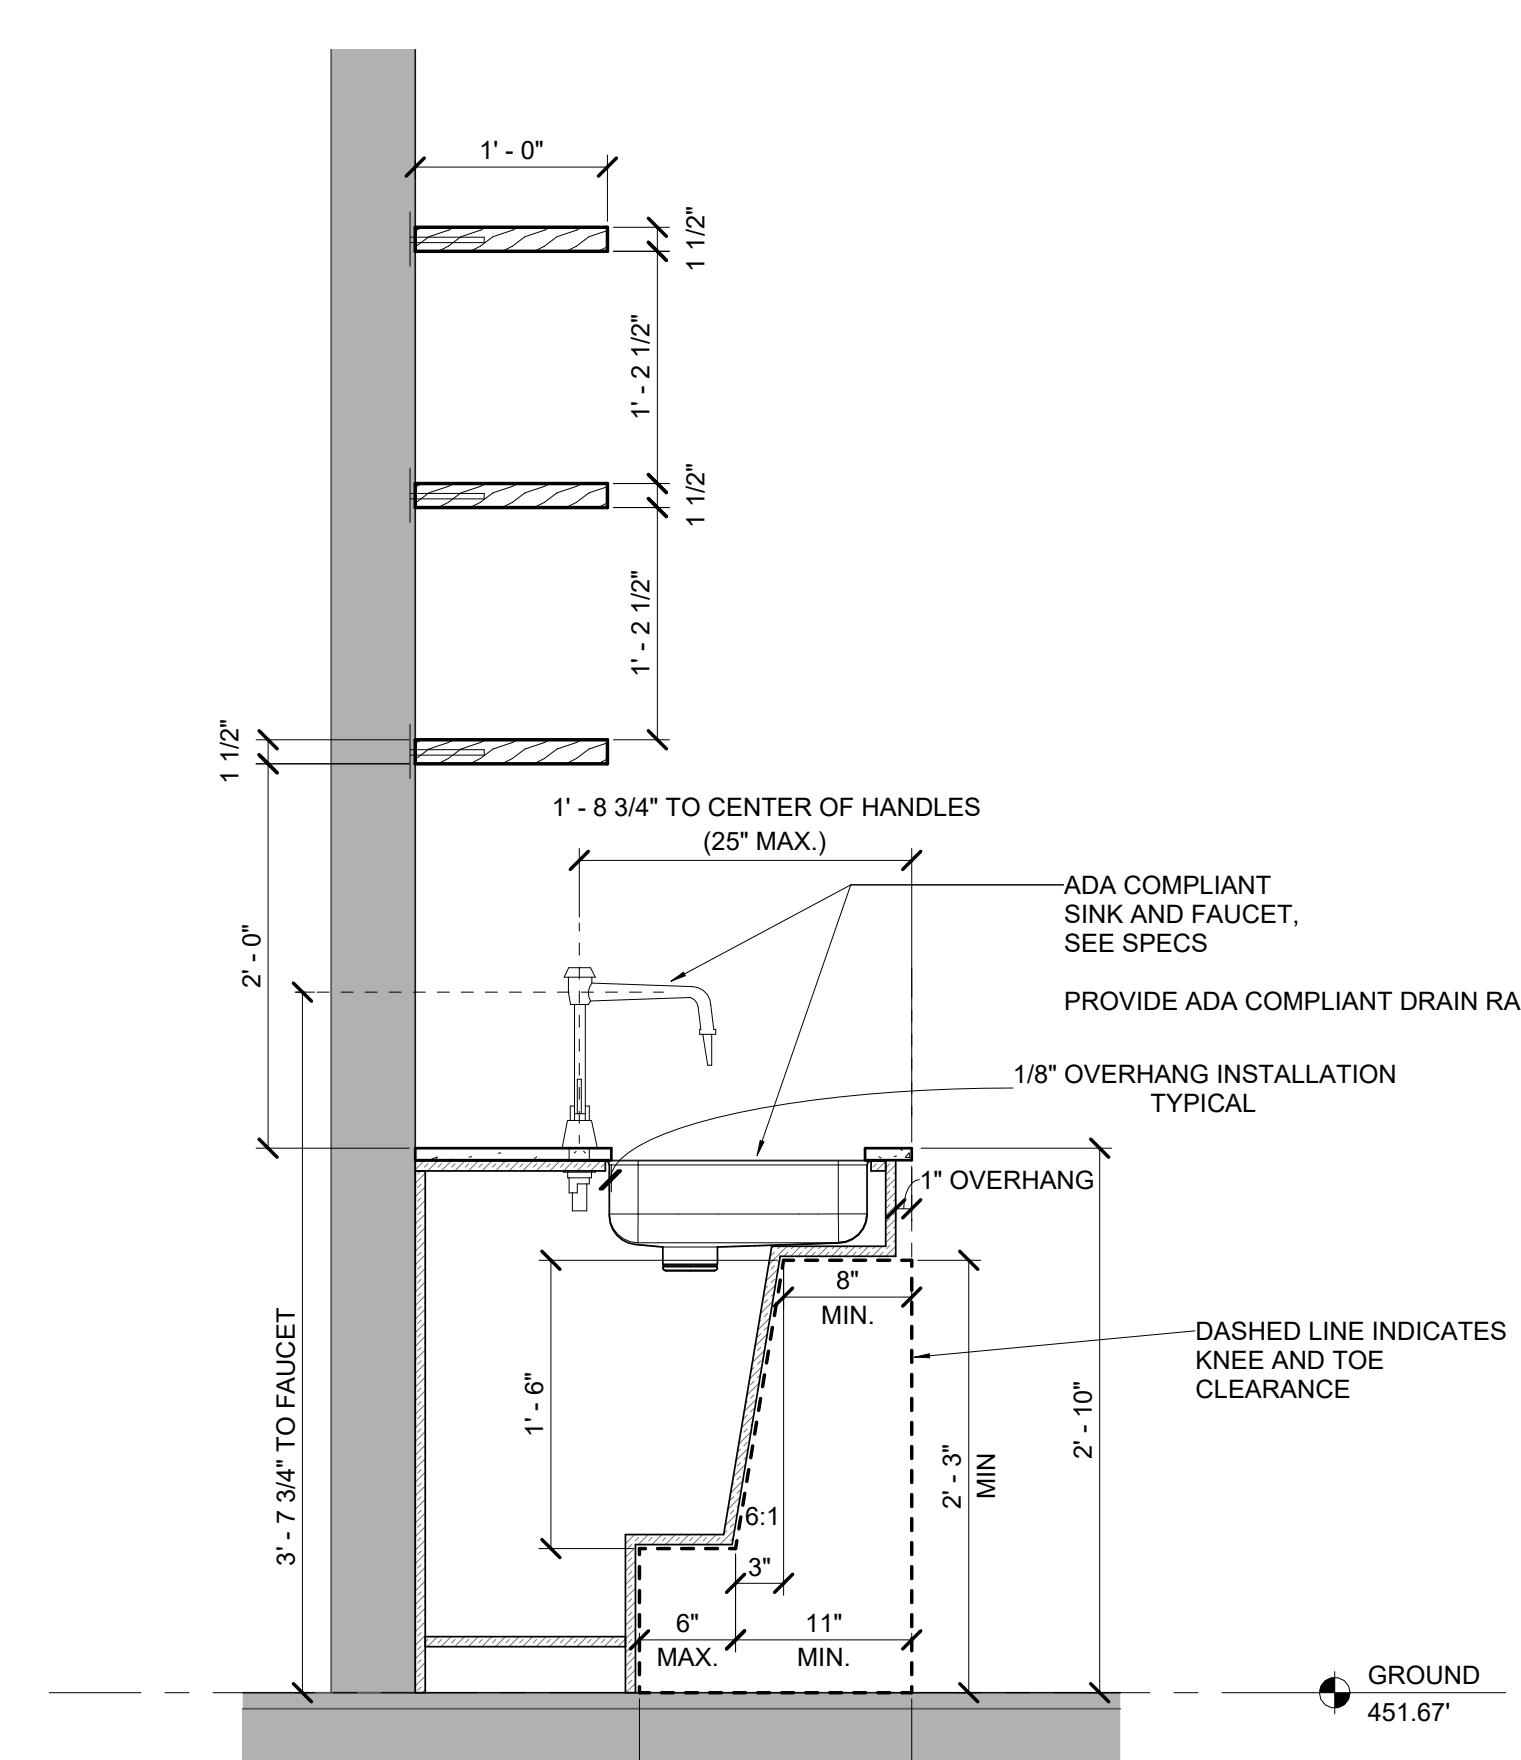

SEE 7/511 FOR TYPICAL NOTES

6

BUILT-IN CABINET SECTION 1

1" = 1' - 0"

1

NOT USED

## FINISH SCHEDULE

SPACE	FLOOR	BASE	WALLS	CEILING		REMARKS
				MATERIAL/COMPONENT	FINISH	
G301 SOCIAL	F1, F2, F3 SEE 1/A102 & 3/A501	EXISTING AND B1	GWB	PT01	ACT AREA (WHERE PATCHING IS REQD.)	MATCH EXISTING ACT AS REQD.
					GWB CEILING AREA	PT01
G301A OFFICE	F1, F3 SEE 1/A102 & 3/A501	EXISTING	GWB	PT01	ACT AREA (WHERE PATCHING IS REQD.)	MATCH EXISTING ACT AS REQD.
					GWB CEILING AREA	PT01
G301B TEACHING LAB	F1, F2, F3 SEE 1/A102 & 3/A501	B2	GWB	PT01	OPEN CEILING AND MEP/FP COMPONENTS	PT02 (WHERE VISIBLE)
					STRUCTURAL GRID	PT02
G301C TEACHING LAB	F1, F2, F3 SEE 1/A102 & 3/A501	B2	GWB	PT01	NEW ACT	REFER TO A-102.1 AND SPECS
					OPEN CEILING AND MEP/FP COMPONENTS	PT02 (WHERE VISIBLE)
G301D STORAGE	F1 SEE 1/A102 & 3/A501	B2	GWB	PT01	STRUCTURAL GRID	PT02
					NEW ACT	REFER TO A-102.1 AND SPECS
G301D STORAGE	F1 SEE 1/A102 & 3/A501	B2	GWB	PT01	GWB CEILING AREA	PT01

## REMARKS

1. WALL GRAPHICS TO BE INSTALLED BY OTHERS
2. IN OPEN-CEILING AREAS, WALLS AND WALL PAINT CONTINUE TO DECK ABOVE, USE PT02 FOR OTHER ELEMENTS TO BE PAINTED IN CEILING ZONE.

## MATERIAL AND COLOR SELECTIONS

## WOOD AND WOOD VENEER:

**WD01:**  
RIFT SAWN WHITE OAK, LINEAR GRAIN DIRECTION AS DESCRIBED IN THE DRAWINGS / MATCH EXISTING WOOD GRAIN  
FINAL APPROVAL OF ALL WOOD ELEMENTS TO BE MADE BY OWNER AND ARCHITECT FROM PHYSICAL SAMPLES SUBMITTED BY THE GENERAL CONTRACTOR

## PAINT COLORS:

**PT01** SHERWIN WILLIAMS PURE WHITE SW 7005  
**PT02** WHITE DRYFALL PAINT, COLOR SW 7005

## FLOORING:

**F1** 36"X36" HVT SHAW MONTAGE FUSE, 84518  
**F2** 36"X36" HVT SHAW MONTAGE ASSEMBLE 84761

**F3** 36"X36" HVT SHAW MONTAGE BLEND 84447. CUT IT HALF TO CREATE 18"X36" PIECES, AND WELD THEM TOGETHER TO CREATE 18"X72" RECTANGLES

## BASE:

**B1** 4" RESILIENT COVE BASE, DARK GRAY FINISH TO BE SELECTED BY THE ARCHITECT FROM THE MANUFACTURER'S FULL RANGE. SEE SPECS  
**B2** 4" RESILIENT COVE BASE, DARK GRAY FINISH TO BE SELECTED BY THE ARCHITECT FROM THE MANUFACTURER'S FULL RANGE. SEE SPECS

## PRODUCT MATERIAL/COLOR SELECTIONS:

**STOREFRONT WINDOW SYSTEM:** CLEAR ANODIZED

**GLASS WRITABLE SURFACE:** COLOR TO BE SELECTED BY OWNER AND ARCHITECT FROM MANUFACTURER'S FULL RANGE OF COLORS

**HVT FLOORING:** F1, F2, AND F3 COLORS AND PATTERNS TO BE APPROVED BY OWNER DURING INTERIOR DESIGN STAGE PRIOR TO CONSTRUCTION.

## DOOR SCHEDULE

DOOR NO.	W	H	RATING	MAT		FINISH		HEAD	JAMB	DESCRIPTION	REMARKS
				DOOR	FRM	DOOR	FRM				
D001	6'-4" (PR OF 3'-2")	7'-0"	N/A	AL	AL	ANODIZED	ANODIZED	1 / A221 SIM.	PER MANUF.	ALUMINUM STOREFRONT DOOR, FULL LITE, ADA COMPLIANT	1,2,3,4,9,11,12
D002	6'-4" (PR OF 3'-2")	7'-0"	N/A	AL	AL	ANODIZED	ANODIZED	1 / A221	PER MANUF.	ALUMINUM STOREFRONT DOOR, FULL LITE, ADA COMPLIANT	1,2,3,4,8,11,12
D003	6'-4" (PR OF 3'-2")	7'-0"	N/A	AL	AL	ANODIZED	ANODIZED	1 / A221 SIM.	PER MANUF.	ALUMINUM STOREFRONT DOOR, FULL LITE, ADA COMPLIANT	1,2,3,4,5,10,11,12
D004	3'-0"	7'-0"	N/A	AL	AL	ANODIZED	ANODIZED	PER MANUF.	PER MANUF.	ALUMINUM STOREFRONT DOOR, FULL LITE, ADA COMPLIANT	1,2,3,4,7,11,12
D005	3'-0"	7'-0"	N/A	SC	HM	WD	WD	5/A-602	SC WD DOOR, FLUSH SLAB, VERTICAL GRAIN, MATCH EXISTING DOORS		1,2,3,4,6

## DOOR REMARKS:


1. PROVIDE AUTOMATIC CLOSER
2. SIGNAGE SHOULD ADHERE TO UNC STANDARDS
3. COORDINATE CARD READER ACCESS WITH THE OWNER
4. SEE "DOOR HARDWARE" BELOW
5. THIS DOOR CANNOT BE LOCKED BECAUSE A PERCENTAGE OF THE OCCUPANTS IN ROOM G301C NEED TO BE ABLE TO EGREGG THROUGH ROOM G301B (SEE A002)
6. SEE 6/A-602 FOR DOOR FRAME PROFILE
7. DOOR AND FRAMES TO MATCH THE STOREFRONT SYSTEM'S DOORS AND FRAMES (W05-D002; W01-D001; W04-D003)
8. THIS DOOR IS ATTACHED TO STOREFRONT UNIT "W05"; SEE 1/A-602
9. THIS DOOR IS ATTACHED TO STOREFRONT UNIT "W01"; SEE 2/A-602
10. THIS DOOR IS ATTACHED TO STOREFRONT UNIT "W04"; SEE 2/A-602
11. EXIT DEVICE, PANIC HARDWARE / COORDINATE WITH ELECTRICAL-LOW VOLTAGE INSTALLATION AS REQUIRED. SEE RISER DIAGRAMS ATTACHED TO SPEC SECTION "DOOR HARDWARE" 087100
12. DOOR AND HARDWARE TO BE ADA COMPLIANT

## ABBREVIATIONS


PR: PAIR OF DOORS  
UPR: UNEVEN PAIR OF DOORS  
T: THICKNESS  
MAT: MATERIAL  
WD: WOOD  
AL: ALUMINUM  
GL: GLASS  
ST: STEEL  
FIN: FINISH  
PT: PAINTED  
STN: STAINED  
HW: HEAD WIDTH  
FRM: FRAME  
HM: HOLLOW METAL DOOR  
SC: SOLID CORE COMMERCIAL DOOR

NOTCH DESIGN, PLLC  
212 W MAIN ST, SUITE E,  
CARRBORO, NC  
www.notchdesign.us  
info@notchdesign.us

REVISION:  
SCO Review 9/15/25  
2nd SCO Review 10/24/25  
Construction Set 11/17/25

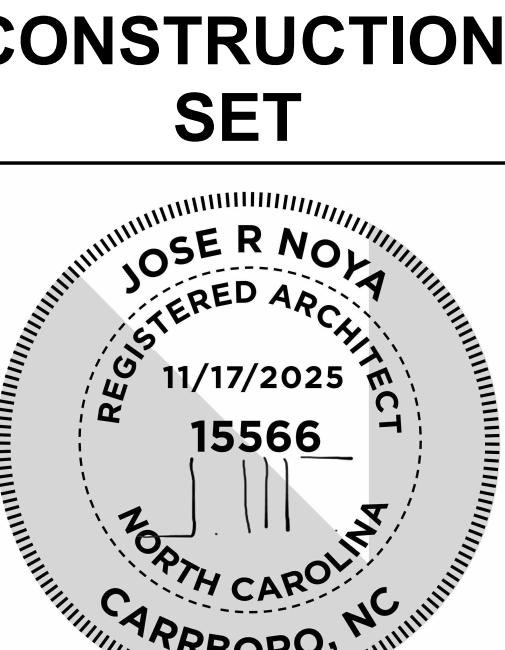

© 2025  
Notch Design  
PROJ. NAME: THE UNIVERSITY OF NORTH CAROLINA AT CHAPEL HILL  
LOCATION: VENABLE HALL LOWER LEVEL  
101 South Rd  
CHAPEL HILL, NC 27514  
ISSUE DATE: 5-21-25  
JOB NO.: N092  
SCO # 24-28389-01A

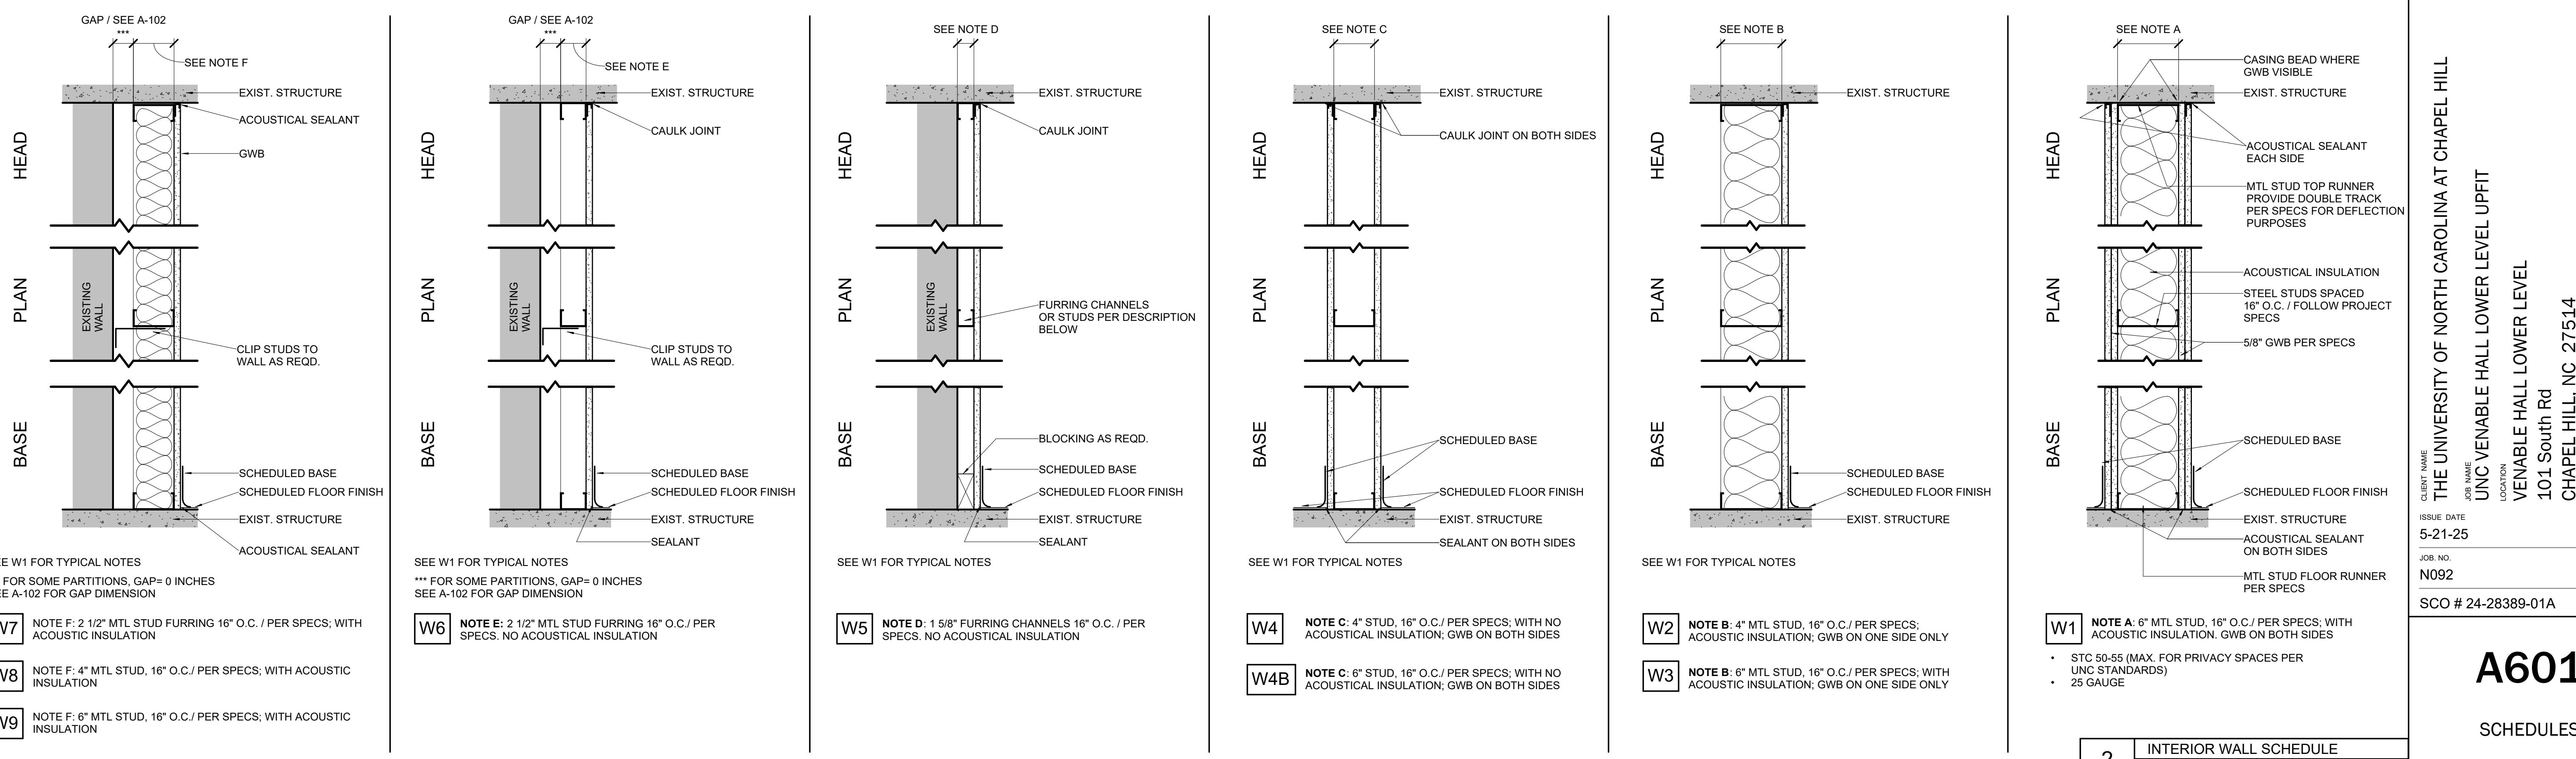



A601  
SCHEDULES

## ROLLER SHADES SCHEDULE

TAG	DRAWINGS	DESCRIPTION	FINISH	DRAPEY SELECTION	NOTES
M1.1	7/A-402 & 1/A-102.1	ROLLER SHADE, SINGLE ROLLER, ALUMINUM FASCIA AND END CAPS	WHITE	BLACKOUT FABRIC, FINAL SELECTION BY ARCHITECT	MANUAL CHAIN SIMILAR TO EXISTING SHADES
M1.2	7/A-402 & 1/A-102.1	ROLLER SHADE, SINGLE ROLLER, ALUMINUM FASCIA AND END CAPS	WHITE	BLACKOUT FABRIC, FINAL SELECTION BY ARCHITECT	MANUAL CHAIN SIMILAR TO EXISTING SHADES
M1.3	7/A-402 & 1/A-102.1	ROLLER SHADE, SINGLE ROLLER, ALUMINUM FASCIA AND END CAPS	WHITE	BLACKOUT FABRIC, FINAL SELECTION BY ARCHITECT	MANUAL CHAIN SIMILAR TO EXISTING SHADES
M1.4	7/A-402 & 1/A-102.1	ROLLER SHADE, SINGLE ROLLER, ALUMINUM FASCIA AND END CAPS	WHITE	BLACKOUT FABRIC, FINAL SELECTION BY ARCHITECT	MANUAL CHAIN SIMILAR TO EXISTING SHADES
M2	7/A-402 & 1/A-102.1	ROLLER SHADE, SINGLE ROLLER, ALUMINUM FASCIA AND END CAPS	WHITE	BLACKOUT FABRIC, FINAL SELECTION BY ARCHITECT	MANUAL CHAIN SIMILAR TO EXISTING SHADES
## GENERAL NOTES:


- SEE PROJECT MANUAL, COMPLY WITH UNC GUIDELINES
- ALL ROLLER SHADE CHAINS SHOULD BE WITHIN ADA OPERABLE REACH RANGES (15" AFF MINIMUM, 48" AFF MAXIMUM)

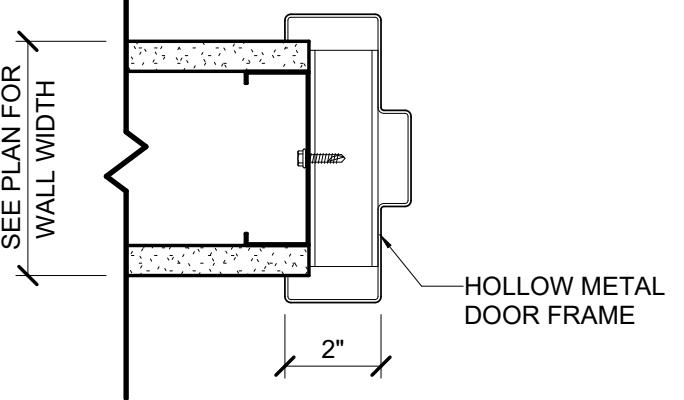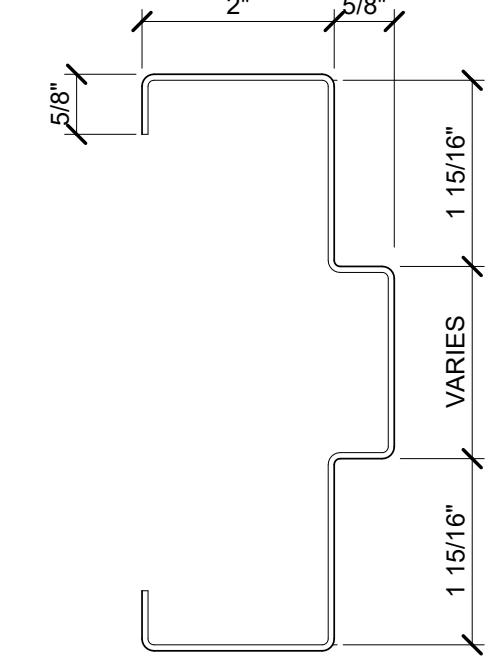


NOTCH DESIGN, PLLC  
212 W MAIN ST, SUITE E,  
CARRBORO, NC  
www.notchdesign.us  
info@notchdesign.us

REVISION:  
SCO Review 9/15/25  
2nd SCO Review 10/24/25  
Construction Set 11/17/25




## CONSTRUCTION SET

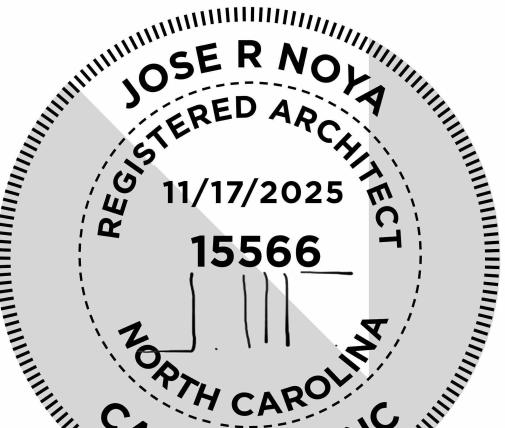

© 2025  
Notch Design

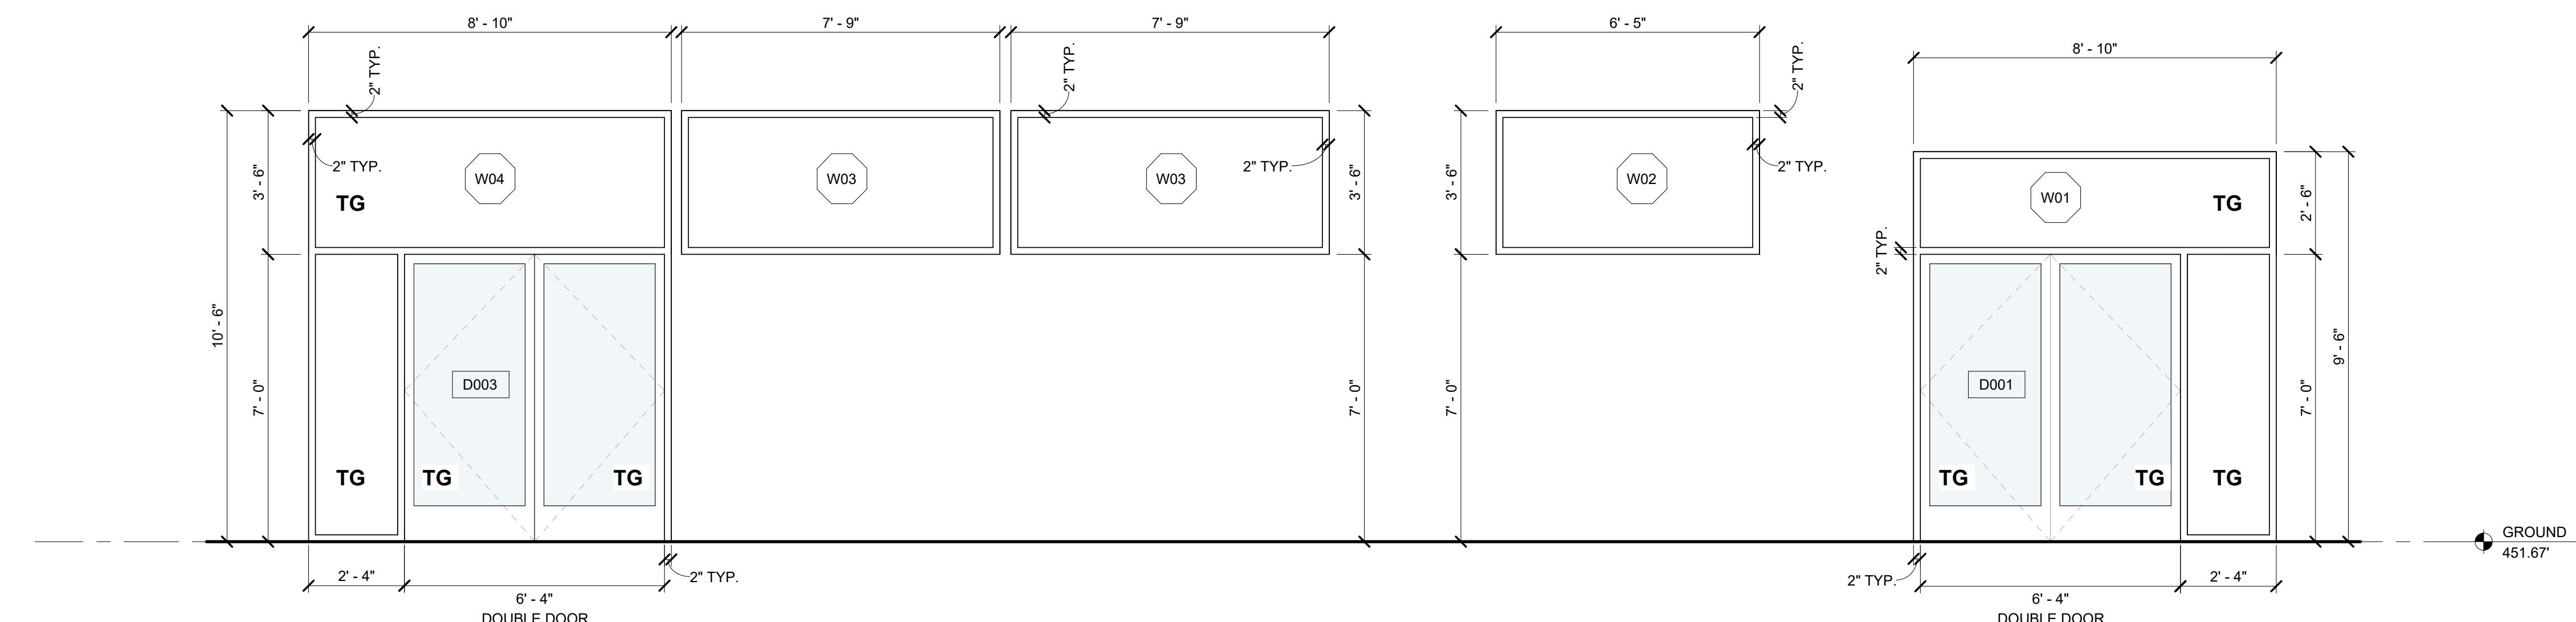

SEE 1/A-602 FOR TYPICAL NOTES 2 W01-W04, D001 & D003 ELEVATIONS  
3/8" = 1' - 0"

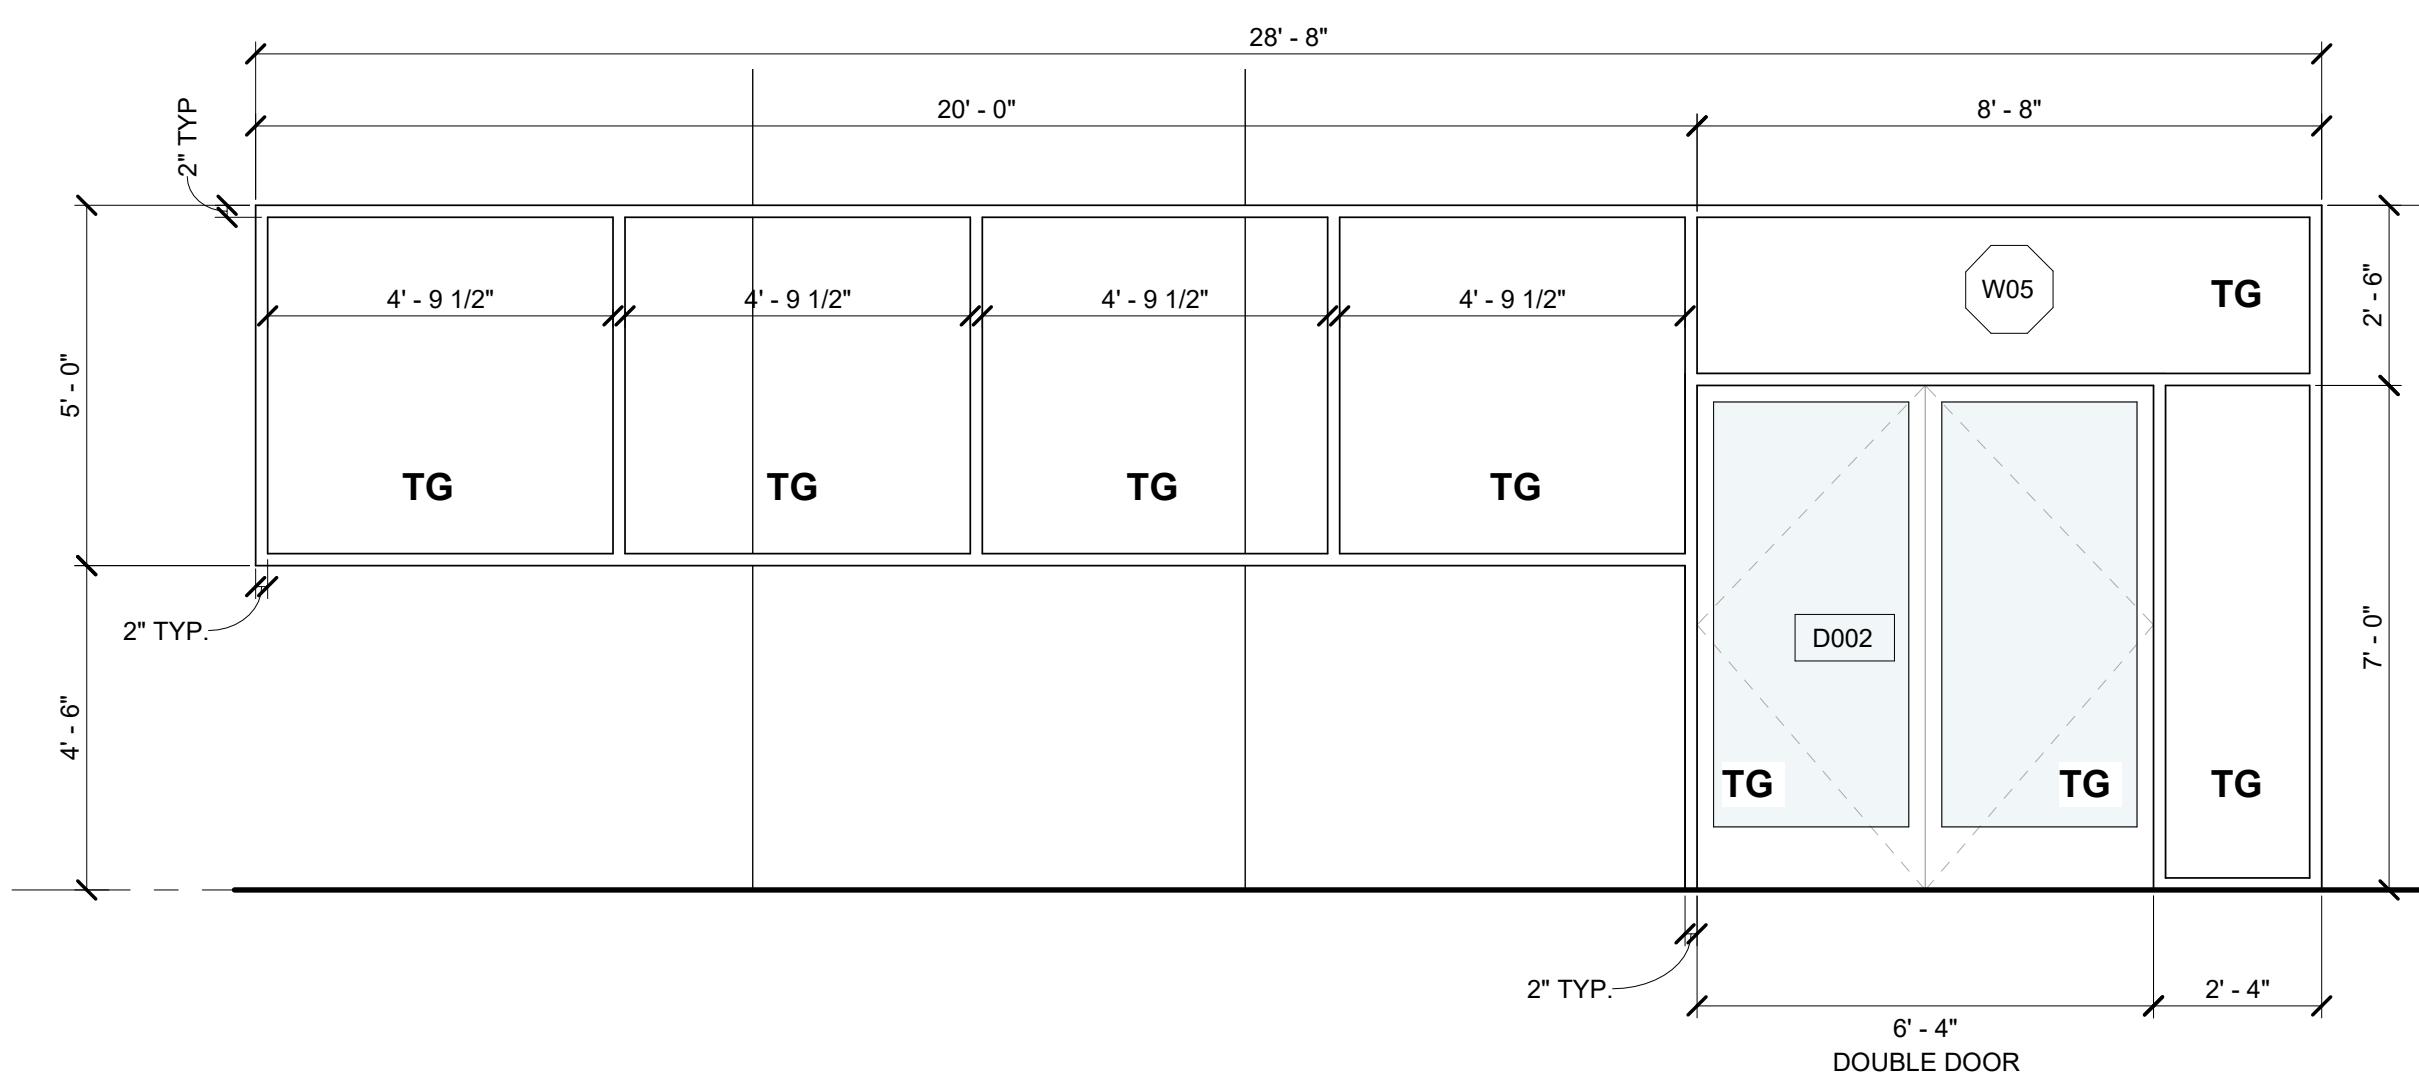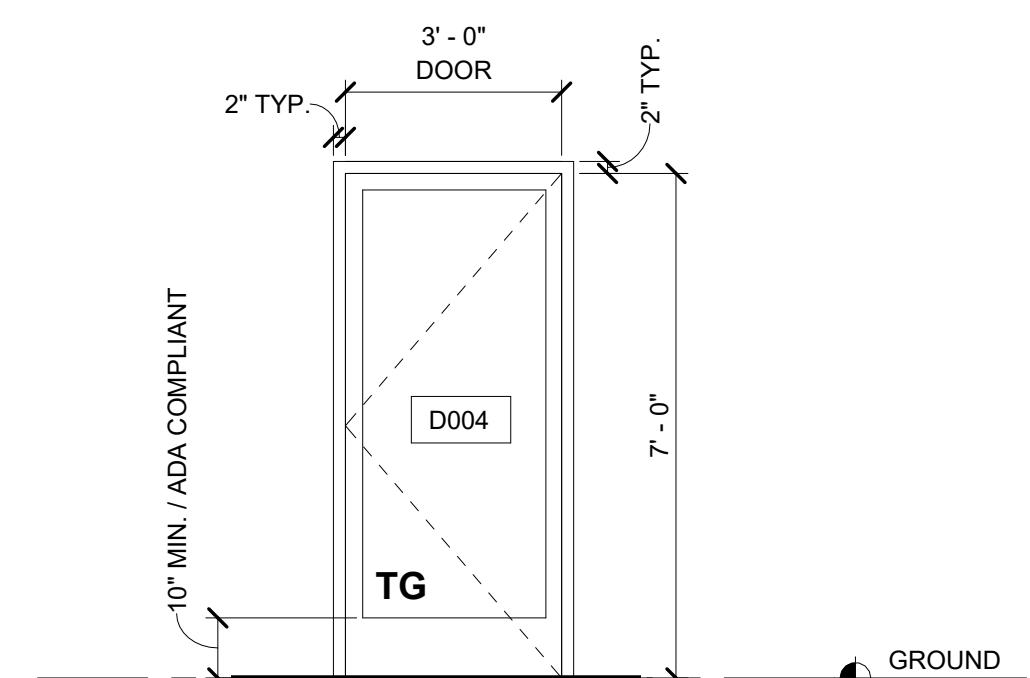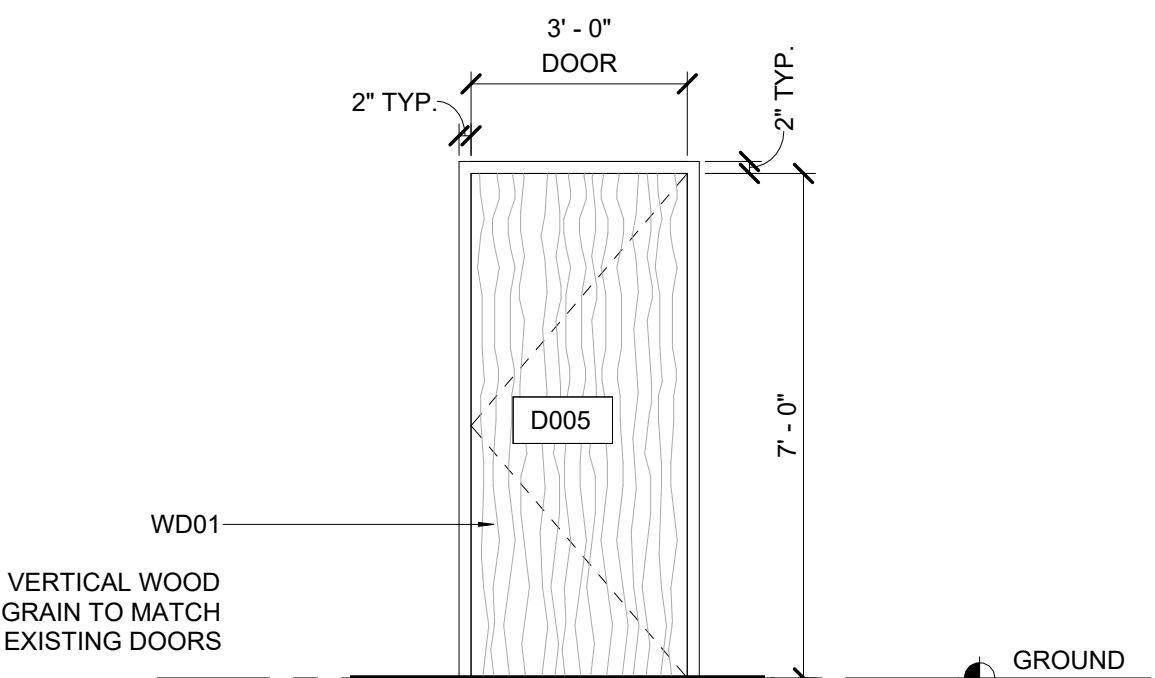

SEE A-601/ DOOR SCHEDULE AND DOOR HARDWARE

THE UNIVERSITY OF NORTH CAROLINA AT CHAPEL HILL  
PROJECT NAME: UNC VENABLE HALL LOWER LEVEL UPLIFT  
LOCATION: 101 South Rd  
CARRBORO, NC 27514  
CLIENT NAME: THE UNIVERSITY OF NORTH CAROLINA AT CHAPEL HILL  
ISSUE DATE: 5-21-25  
JOB NO.: N092  
SCO # 24-28389-01A


A602  
INTERIOR  
STOREFRONT AND  
DOOR ELEVATIONS

SEE 5 & 6/ A-602 FOR DOOR FRAME, JAMB AND HEAD DETAILS


SEE 1/A-602 FOR TYPICAL NOTES 4 D005 ELEVATION  
3/8" = 1' - 0"

SEE 1/A-602 FOR TYPICAL NOTES 3 D004 ELEVATION  
3/8" = 1' - 0"

1 W05 AND D002 ELEVATION  
3/8" = 1' - 0"

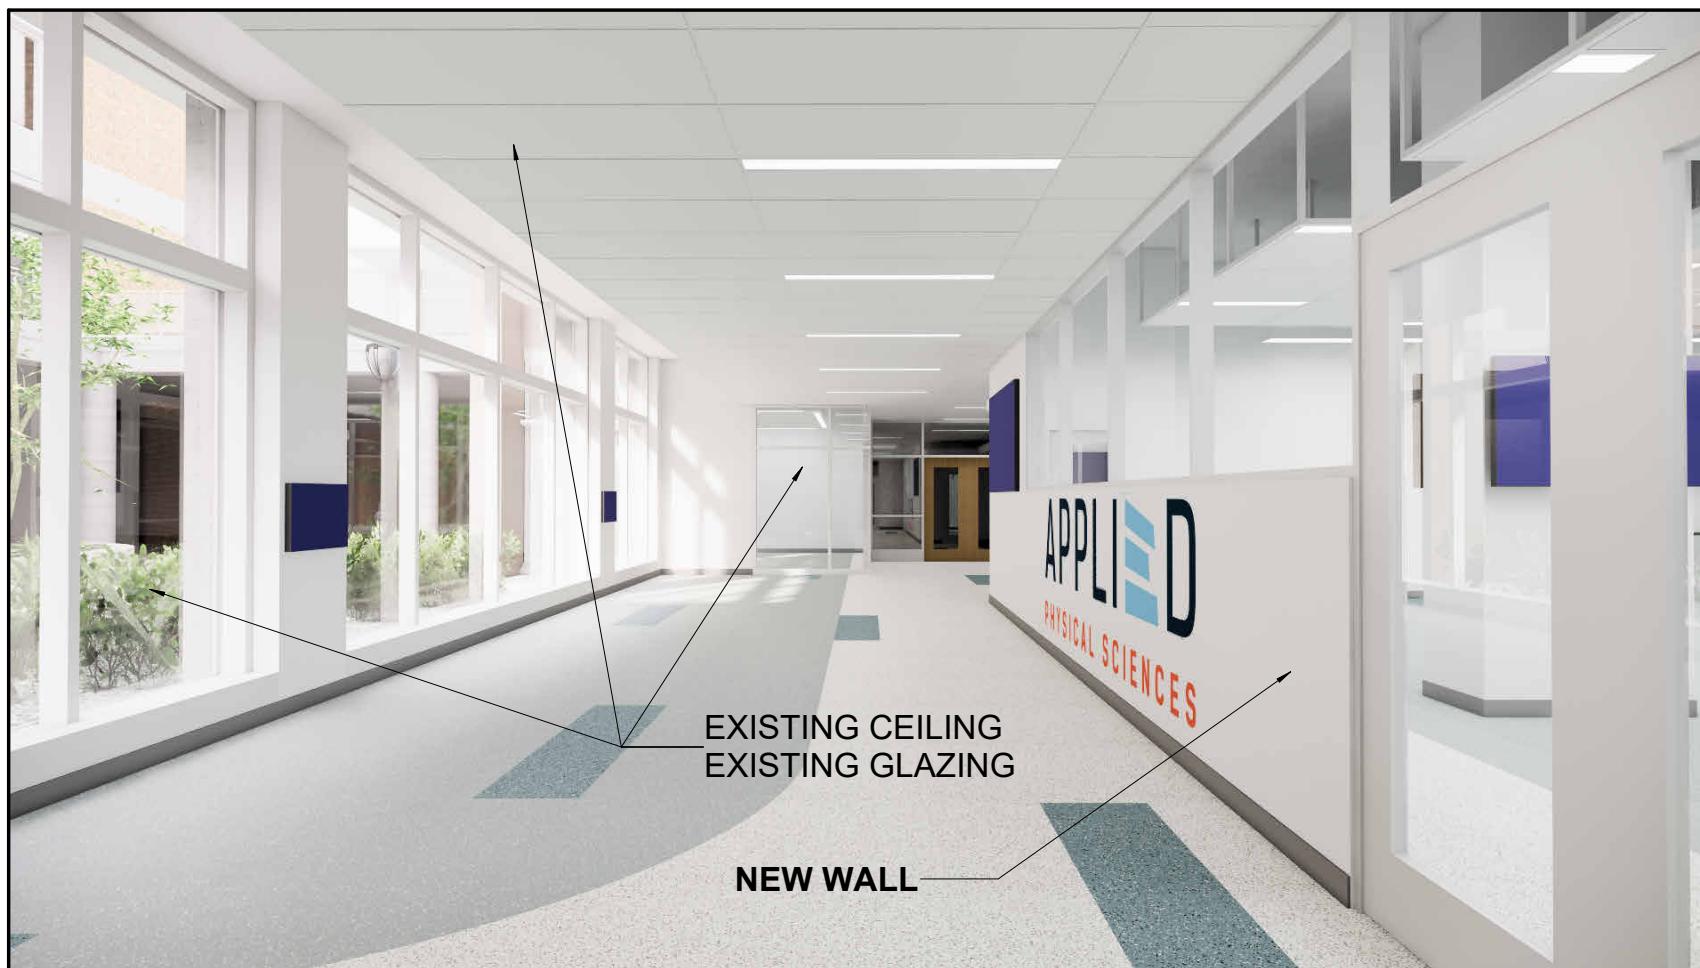

1. SOCIAL SPACE G301, LOOKING NORTH

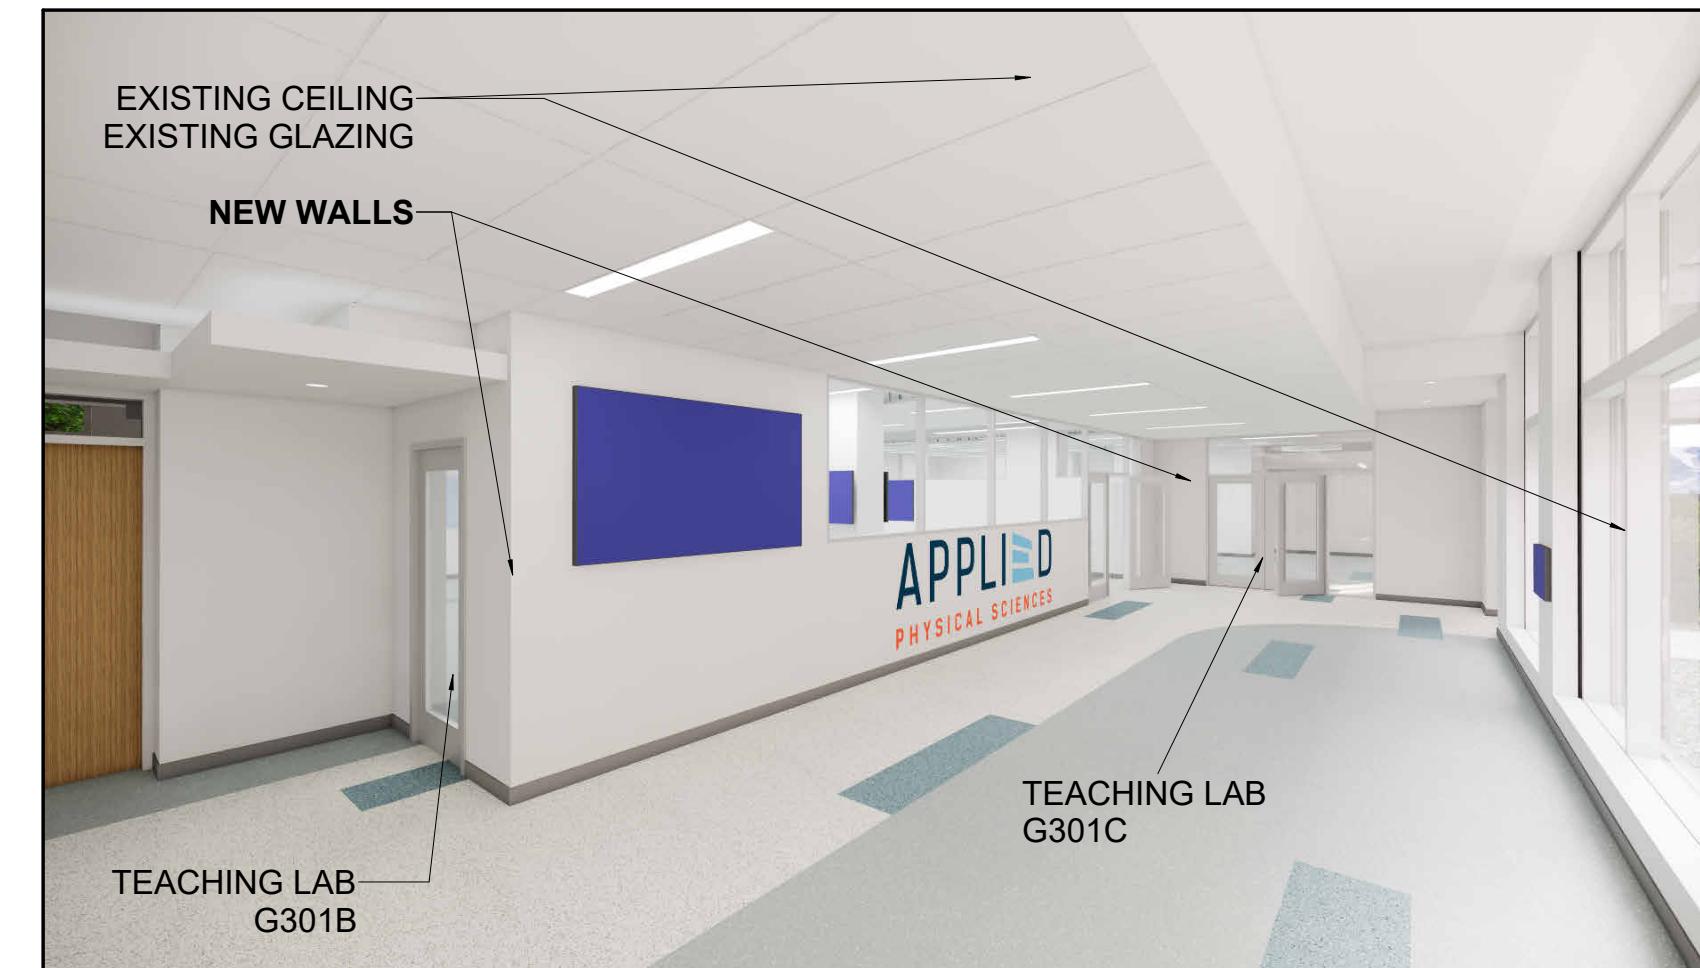

2. SOCIAL SPACE G301, LOOKING SOUTH



3. SOCIAL SPACE G301, LOOKING SOUTH AT TEACHING LAB ENTRIES



4. TEACHING LAB G301B LOOKING EAST/SOUTHEAST



5. TEACHING LAB G301B LOOKING SOUTH



6. TEACHING LAB G301B LOOKING NORTH



7. TEACHING LAB G301C, LOOKING NORTH/NORTHWEST




8. TEACHING LAB G301C LOOKING NORTHEAST




9. TEACHING LAB G301C LOOKING EAST



10. TEACHING LAB G301B, LOOKING EAST TOWARD TEACHING STATION

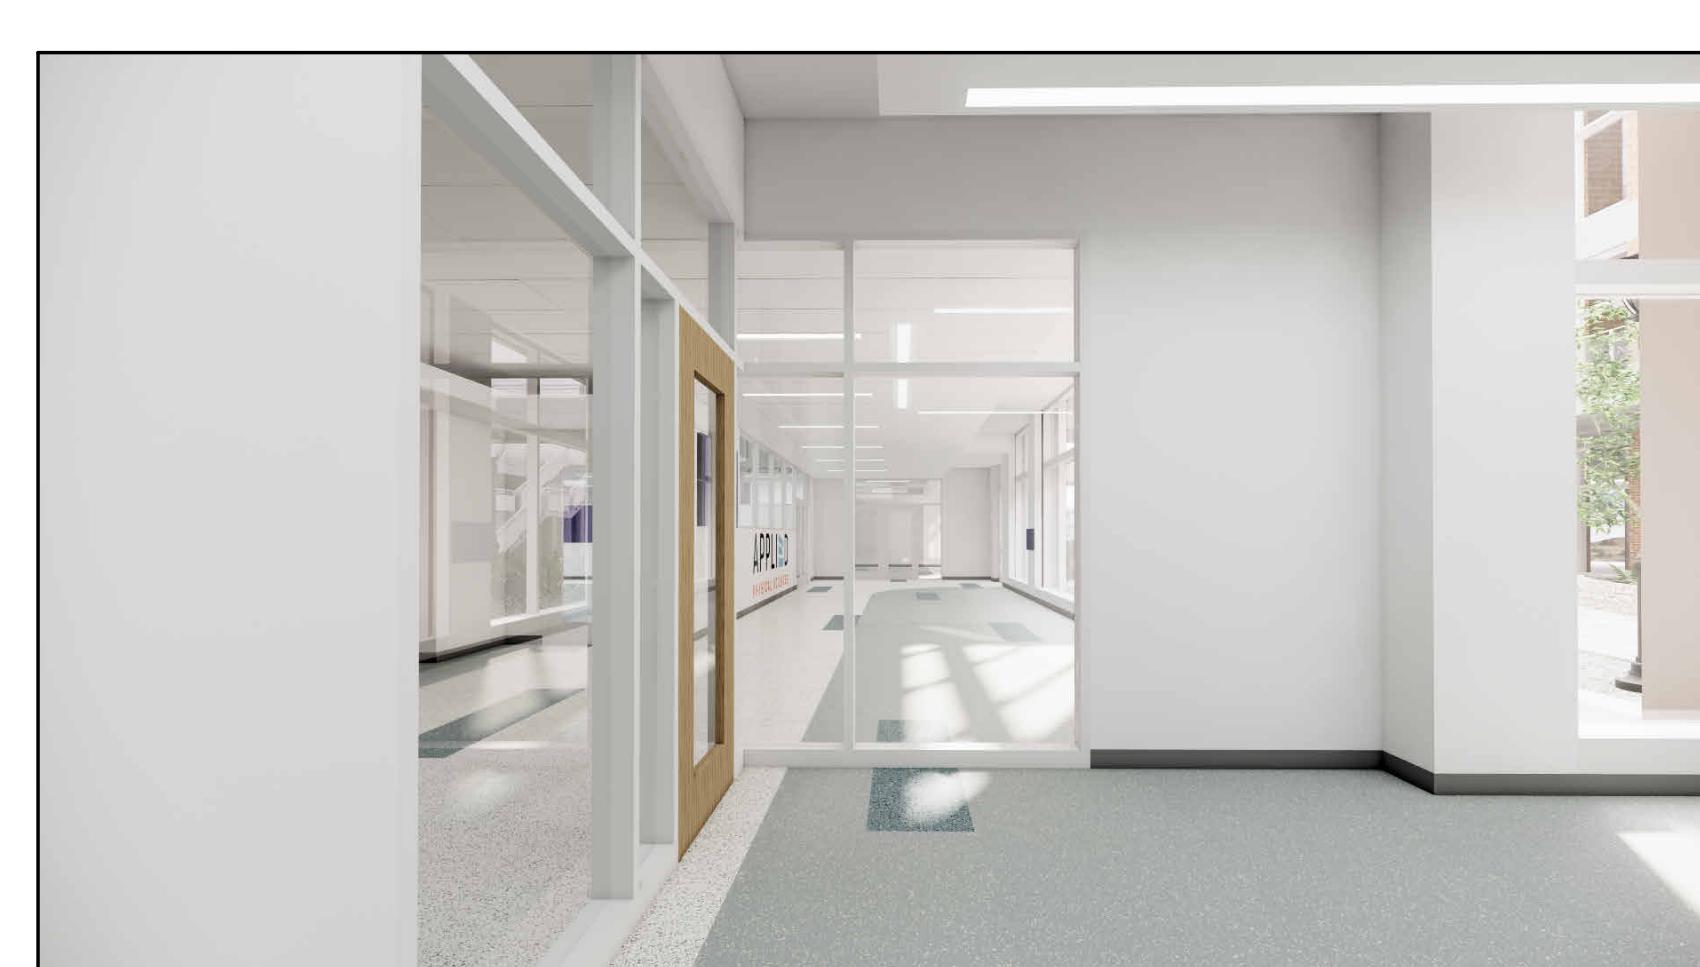

11. OFFICE G301A, LOOKING SOUTH

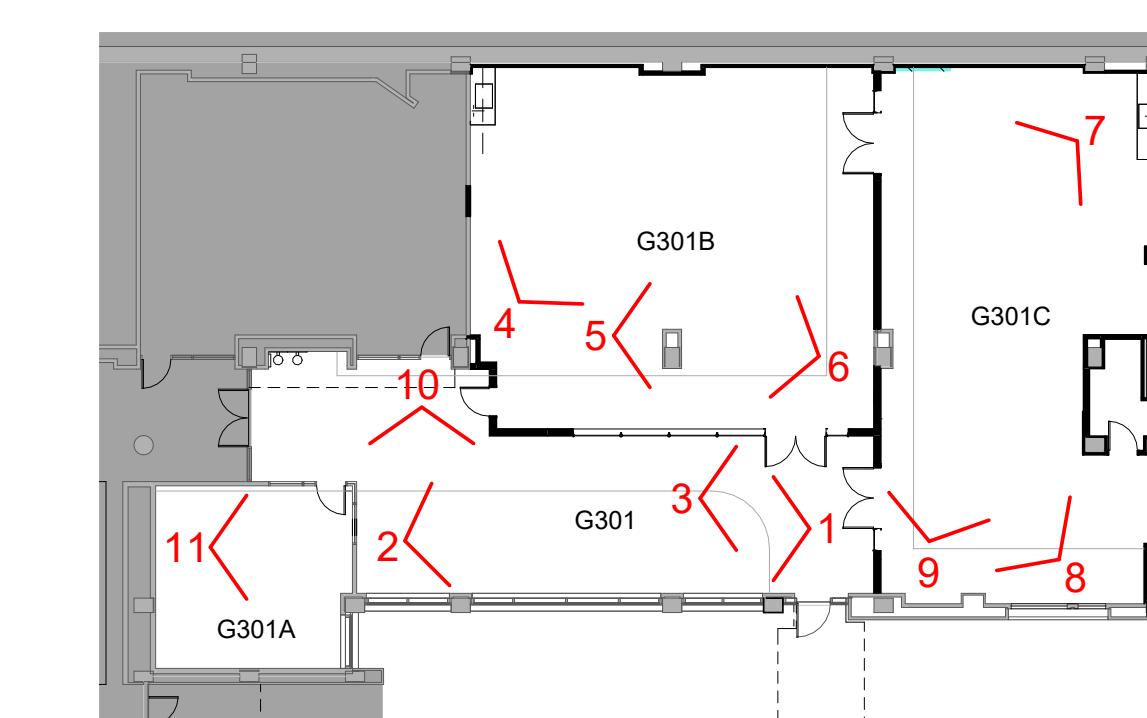

3D VIEWS  
KEY PLAN




NOTCH DESIGN, PLLC  
212 W MAIN ST, SUITE E,  
CARRBORO, NC

www.notchdesign.us  
info@notchdesign.us

REVISION:  
SCO Review 9/15/25  
2nd SCO Review 10/24/25  
Construction Set 11/17/25

## CONSTRUCTION SET

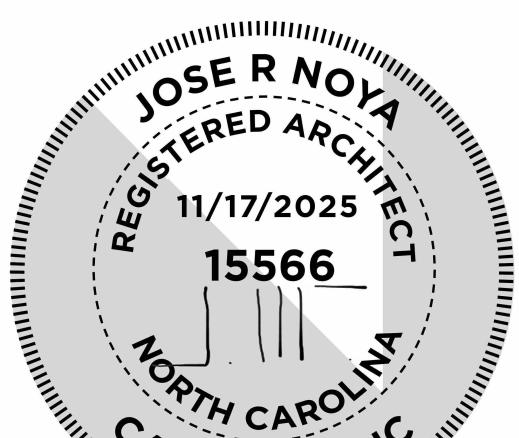

© 2025  
Notch Design

CLIENT NAME: THE UNIVERSITY OF NORTH CAROLINA AT CHAPEL HILL  
PRO. NAME: VENABLE HALL LOWER LEVEL UPGRADE  
LOCATION: 101 South Rd  
CARRBORO, NC 27514  
ISSUE DATE: 5-21-25  
JOB NO.: N092  
SCO # 24-28389-01A

A700

3D VIEWS

## CONSTRUCTION SET




2018 APPENDIX B	
NC MECHANICAL SUMMARY	
MECHANICAL SYSTEMS, SERVICE SYSTEMS AND EQUIPMENT	
4A	
CLIMATE ZONE	
WINTER DRY BULB	10 DEG F
SUMMER DRY BULB	92 DEG F
INTERIOR DESIGN CONDITIONS	
WINTER DRY BULB	70 DEG F
SUMMER DRY BULB	75 DEG F
RELATIVE HUMIDITY	50%
BUILDING HEATING LOAD	N/A
BUILDING COOLING LOAD	N/A
MECHANICAL SPACE CONDITIONING SYSTEM	
UNITARY	N/A
DESCRIPTION OF UNIT	N/A
HEATING EFFICIENCY	N/A
COOLING EFFICIENCY	N/A
HEAT OUTPUT OF UNIT	N/A
COOLING OUTPUT OF UNIT	N/A
BOILER	TOTAL BOILER OUTPUT, IF OVERSIZED, STATE REASON. N/A
CHILLER	TOTAL CHILLER OUTPUT, IF OVERSIZED, STATE REASON. N/A
LIST EQUIPMENT EFFICIENCIES	

CODES/STANDARDS	
2018 NORTH CAROLINA MECHANICAL CODE	<ul style="list-style-type: none"> <li>ASHRAE STANDARDS:</li> <li>15-2022, "SAFETY STANDARD FOR REFRIGERATION SYSTEMS"</li> <li>62-2022, "VENTILATION FOR ACCEPTABLE INDOOR AIR QUALITY"</li> <li>90.1-2021, "ENERGY STANDARD FOR BUILDINGS EXCEPT LOW-RISE"</li> <li>170-2021, "VENTILATION OF HEALTHCARE FACILITIES"</li> <li>2018, "ADVANCED ENERGY GUIDE FOR K-12 SCHOOL BUILDINGS, SMALL RETAIL BUILDINGS, SMALL OFFICE BUILDINGS"</li> <li>55-2023, "THERMAL ENVIRONMENTAL CONDITIONS FOR HUMAN OCCUPANCY"</li> </ul>
2018 ASHRAE STANDARDS	
15-2022, "SAFETY STANDARD FOR REFRIGERATION SYSTEMS"	
62-2022, "VENTILATION FOR ACCEPTABLE INDOOR AIR QUALITY"	
90.1-2021, "ENERGY STANDARD FOR BUILDINGS EXCEPT LOW-RISE"	
170-2021, "VENTILATION OF HEALTHCARE FACILITIES"	
2018, "ADVANCED ENERGY GUIDE FOR K-12 SCHOOL BUILDINGS, SMALL RETAIL BUILDINGS, SMALL OFFICE BUILDINGS"	
55-2023, "THERMAL ENVIRONMENTAL CONDITIONS FOR HUMAN OCCUPANCY"	

MECHANICAL ABBREVIATIONS	
AAV	AUTOMATIC AIR VENT
ADJ	ADJUSTABLE OR ADJUSTMENT
AI	ANALOG IN
AO	ANALOG OUT
AFF	ABOVE FINISHED FLOOR
AFG	ABOVE FINISHED GRADE
AHU	AIR HANDLING UNIT
APD	AIRSIDE PRESSURE DROP
BFF	BELOW FINISHED FLOOR
BLDG	BUILDING
BMP	BOILER MANAGEMENT PANEL
CFM	CUBIC FEET PER MINUTE
CMD	COMMAND
COND	CONDENSATE DRAINAGE
CV	CONSTANT VOLUME
CWMU	COLD WATER MAKEUP UNIT
CHWR	CHILLED WATER RETURN
CHWS	CHILLED WATER SUPPLY
CWS	CONDENSER WATER SUPPLY
CWR	CONDENSER WATER RETURN
DI	DIGITAL IN
DO	DIGITAL OUT
DN	DOWN
EA	EXHAUST AIR
EAG-X	EXHAUST AIR GRILLE - TYPE
EAT	ENTERING AIR TEMPERATURE
EC	ELECTRICAL CONTRACTOR
ESP	EXTERNAL STATIC PRESSURE
ETR	EXISTING TO REMAIN
EWT	ENTERING WATER TEMPERATURE
EX	EXISTING
FACP	FIRE ALARM CONTROL PANEL
FCU	FAN COIL UNIT
FPM	FEET PER MINUTE
GC	GENERAL CONTRACTOR
GPM	GALLONS PER MINUTE
HWS	HEATING HOT WATER SUPPLY
HWR	HEATING HOT WATER RETURN
HP	HORSEPOWER
HPC	HIGH PRESSURE CONDENSATE
HPS	HIGH PRESSURE STEAM
IND	INDUCTION UNIT
IWC	INCHES WATER COLUMN
JB	JUNCTION BOX
LAT	LEAVING AIR TEMPERATURE
LPC	LOW PRESSURE CONDENSATE
LPS	LOW PRESSURE STEAM
LWT	LEAVING WATER TEMPERATURE
MAV	MANUAL AIR VENT
MC	MECHANICAL CONTRACTOR
MPC	MEDIUM PRESSURE CONDENSATE
MPS	MEDIUM PRESSURE STEAM
MTD	MONTH TO DATE
N/A	NOT AVAILABLE / NOT APPLICABLE
NC	NORMALLY CLOSED
NIC	NOT IN CONTRACT
NO	NORMALLY OPEN
NTS	NOT TO SCALE
OCC	OCCUPANT OR OCCUPANCY
OA	OUTSIDE AIR
PC	PLUMBING CONTRACTOR
PSI	POUNDS PER SQUARE INCH
RA	RETURN AIR
RAG-X	RETURN AIR GRILLE - TYPE
RTU	ROOF TOP UNIT
SA	SUPPLY AIR
SAD-X	SUPPLY AIR DIFFUSER - TYPE
SC	SAFETY CIRCUIT
S/S	START/STOP
STM COND	STEAM CONDENSATE RETURN
TAB	TEST AND BALANCE
TEMP	TEMPERATURE
TSP	TOTAL STATIC PRESSURE
UH	UNIT HEATER
VEL	VELOCITY
VAV	VARIABLE AIR VOLUME
VP	VIRTUAL POINT
WPD	WATERSIDE PRESSURE DROP
XFMR	TRANSFORMER

HAZARDOUS MATERIALS WARNING	
HAZARDOUS MATERIALS, INCLUDING ASBESTOS CONTAINING MATERIALS, ARE EITHER NOT PRESENT OR WERE REMOVED PRIOR TO CONSTRUCTION. TO THE BEST OF THIS CONSULTANT'S KNOWLEDGE, THERE IS ALWAYS THE RISK OF REMAINING, UNDISCOVERED HAZARDOUS MATERIALS PRESENT IN THE CONSTRUCTION SITE; HOWEVER, DURING THE COURSE OF THE PROJECT, SHOULD SUSPECT REGULATED MATERIALS BE LOCATED AND/OR IDENTIFIED, THE CONTRACTOR SHALL CEASE ALL WORK AND NOTIFY THE OWNER/DESIGNER/ENVIRONMENTAL CONSULTANT FOR CONFIRMATION AND TESTING IF NECESSARY.	

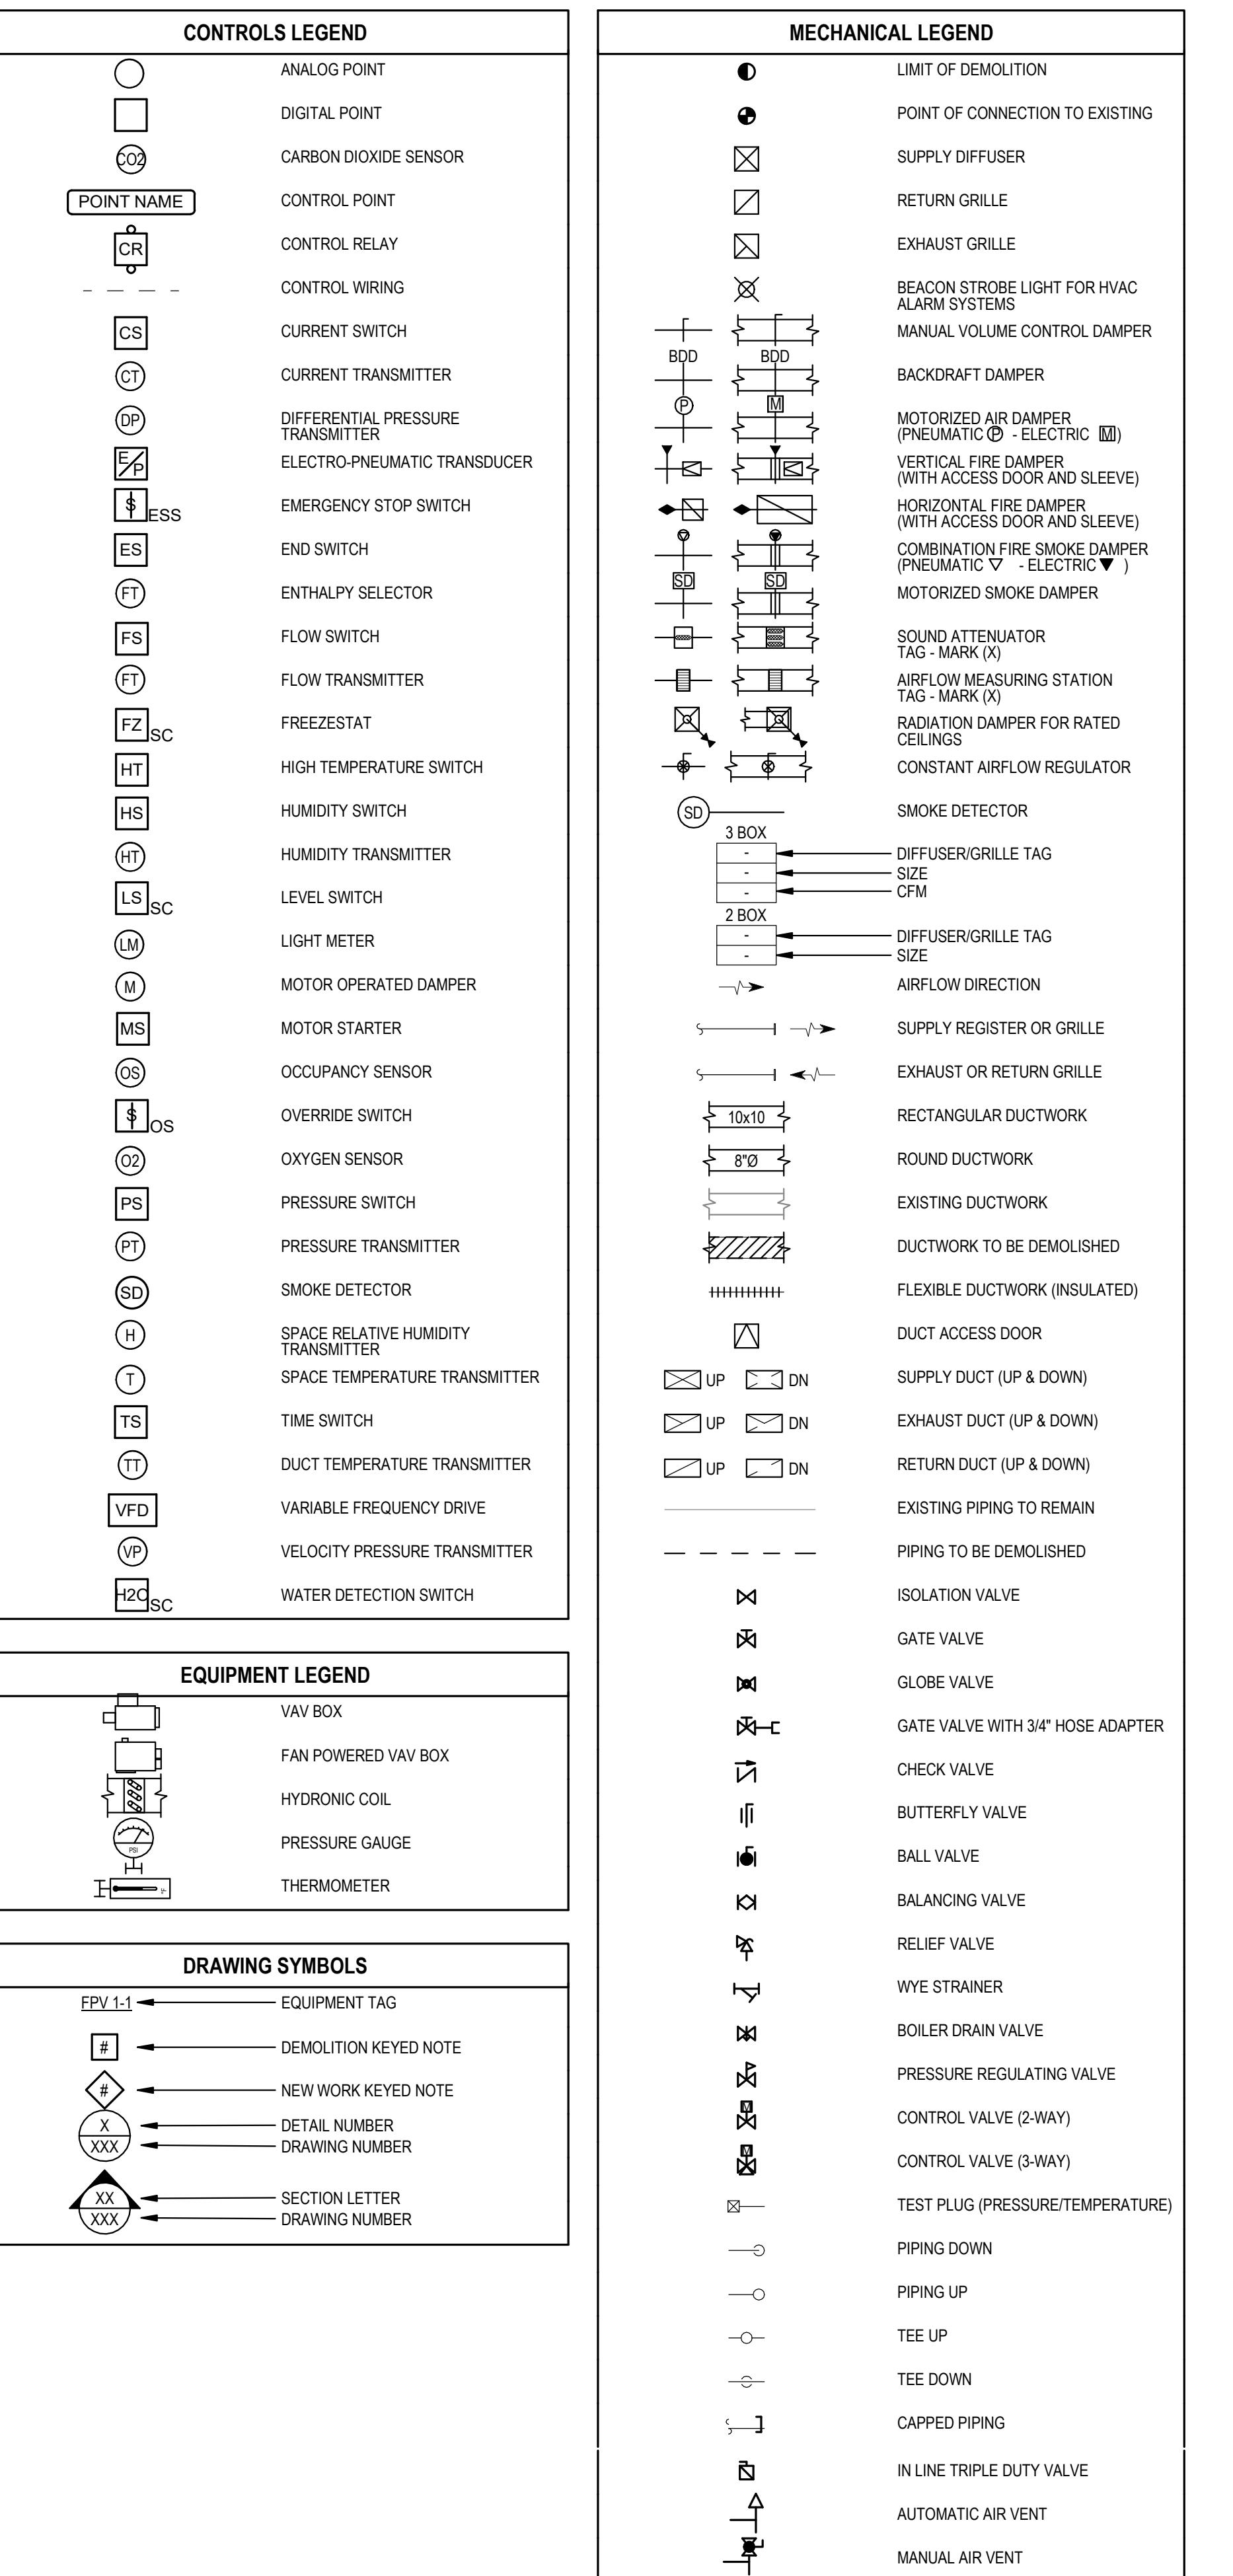

**GENERAL NOTES**

- THE DRAWINGS SHALL NOT BE SCALED FOR CONSTRUCTION PURPOSES. THE SCALE, WHEN INDICATED IS INTENDED FOR GENERAL REFERENCE ONLY.
- THE MECHANICAL CONTRACTOR SHALL MAKE A COMPLETE REVIEW OF THE PROJECT PLANS, SCHEDULES, AND DETAILS PRIOR TO INSTALLATION OF THE MECHANICAL SYSTEMS AND REVIEW ANY CONFLICTS WITH THE ENGINEER.
- ALL WORK SHALL CONFORM TO ALL LOCAL STATE AND NATIONAL CODES. EQUIPMENT SHALL BE INSTALLED IN ACCORDANCE WITH MANUFACTURER'S WRITTEN RECOMMENDATIONS. ANY EQUIPMENT OR MATERIAL DEVIATIONS FROM THAT SPECIFIED OR DETAILED ON THIS DRAWING SHALL BE SUBJECT TO THE APPROVAL OF THE ARCHITECT/ENGINEER. ALL PROPOSED EQUIPMENT DEVIATIONS SUBMITTED SHALL BE SIMILAR BOTH IN QUALITY AND CAPACITY TO THAT EQUIPMENT SPECIFIED.
- DESIGN IS BASED ON THE MANUFACTURER AND MODELS SCHEDULED OR THE FIRST MANUFACTURER LISTED IN THE DRAWINGS AND SPECIFICATIONS. CONTRACTOR SHALL BEAR ANY AND ALL COSTS FOR ALTERING ANY OTHER CONTRACT OR SUB-CONTRACT RESULTS FROM THE USE OF ANY MANUFACTURER OR MODEL OTHER THAN THE DESIGN BASIS, INCLUDING LISTED ALTERNATIVES.
- PRIOR TO CONSTRUCTION, FABRICATING DUCTWORK, ORDERING EQUIPMENT, ETC., THE CONTRACTOR SHALL FIELD VERIFY SPACE LIMITATIONS AT THE JOB SITE AND COORDINATE WITH OTHER TRADES.
- ALL MATERIALS, EQUIPMENT AND PRODUCTS INCORPORATED IN THE WORK UNDER THE CONTRACT SHALL BE NEW, OR A SUITABLE GRADE FOR THE PURPOSES INTENDED, AND TO THE EXTENT POSSIBLE, STANDARD PRODUCTS OF THE VARIOUS MANUFACTURES EXCEPT WHERE SPECIAL CONSTRUCTION OR PERFORMANCE FEATURES ARE CALLED FOR, THEY SHALL BE INSTALLED IN ACCORDANCE WITH THE MANUFACTURER'S REQUIREMENTS.
- ALL MATERIALS AND EQUIPMENT SHALL BE NEW UNLESS OTHERWISE NOTED AND SHALL BE FURNISHED AND INSTALLED IN ACCORDANCE WITH THE MANUFACTURER'S REQUIREMENTS.
- THE MECHANICAL CONTRACTOR IS RESPONSIBLE FOR ANY DAMAGE CAUSED BY THEIR ACTIONS, SUCH DAMAGE SHALL BE RETURNED TO ORIGINAL NORMAL WORKING CONDITIONS SUBJECT TO ACCEPTANCE OF THE OWNER AND ENGINEER, WITHOUT EXTRA COST TO THE OWNER.
- THE MECHANICAL CONTRACTOR SHALL KEEP THEIR WORK SITE AND ALL ACCESS POINTS OF THE BUILDING FREE OF RUBBISH AND WASTE MATERIAL. ALL ROOF OPENINGS IN THE BUILDING REQUIRED FOR THE MECHANICAL CONTRACT SHALL BE PROVIDED BY THE GENERAL CONTRACTOR. ALL FRAMING AROUND OPENINGS SHALL BE PROVIDED BY THE GENERAL CONTRACTOR. MECHANICAL CONTRACTOR SHALL COORDINATE SIZE OF OPENINGS AND LOCATION OF OPENINGS WITH THE GENERAL CONTRACTOR. ALL ROOF CURBS AND ROOF SUPPORT RAILS FOR MECHANICAL EQUIPMENT INSTALLED ON THE ROOF SHALL BE FURNISHED BY THE MECHANICAL CONTRACTOR AND INSTALLED BY THE GENERAL CONTRACTOR.
- ALL OPENINGS IN WALLS AS REQUIRED BY THE MECHANICAL SYSTEM IN THE BUILDING SHALL BE PROVIDED BY THE GENERAL CONTRACTOR. IT IS THE MECHANICAL CONTRACTOR'S RESPONSIBILITY TO COORDINATE THE SIZE AND LOCATION OF ALL OPENINGS IN THE WALLS AND PROVIDE THE CONTRACTOR WITH A JOBSITE TIMING PLAN.
- REFER TO ARCHITECTURAL DRAWINGS AS AVAILABLE FOR LOCATION OF ALL RATED WALL AND FLOOR ASSEMBLIES. PROVIDE FIRE DAMPERS AND/OR UL LISTED ASSEMBLIES AND/OR SEALANTS PER DRAWINGS, SPECIFICATIONS, AND APPLICABLE CODES AT ALL PENETRATIONS.
- THE MECHANICAL CONTRACTOR SHALL FURNISH ACCESS DOORS FOR ALL GYPSUM BOARD CEILINGS AT VOLUME DAMPERS, EQUIPMENT, MOTOR OPERATED DAMPERS, FIRE DAMPERS, BALANCING DEVICES OR OTHER ITEMS REQUIRING BALANCING OR SERVICE. ACCESS DOORS SHALL BE INSTALLED BY THE GENERAL CONTRACTOR. SEE PLANS AND GENERAL CONSTRUCTION SPECIFICATIONS FOR ACCESS DOOR REQUIREMENTS.
- MECHANICAL CONTRACTOR SHALL PROVIDE 6" HIGH HOUSEKEEPING PADS UNDER MAJOR MECHANICAL EQUIPMENT (I.E. CHILLERS) & 4" HIGH HOUSEKEEPING PADS UNDER ALL OTHER FLOOR MOUNTED EQUIPMENT UNLESS NOTED OTHERWISE. PADS SHALL EXTEND BEYOND EQUIPMENT BY THE SAME DIMENSION AS THE HEIGHT OF THE PAD AND NOT MORE THAN ONE INCH.
- ALL PIPING AND DUCTWORK EXCEPT IN MECHANICAL ROOMS, BOILER ROOM, ETC.) SHALL BE CONCEALED UNLESS OTHERWISE SHOWN OR NOTED.
- DO NOT INSTALL PIPING OR DUCTWORK OVER ANY ELECTRICAL SWITCHGEAR; SEE MECHANICAL DETAIL SHEET(S).
- MC SHALL BLANK OFF UNUSED PORTIONS OF LOUVERS WITH DOUBLE WALL INSULATED PANELS.
- REFER TO SPECIFICATIONS FOR EQUIPMENT STARTUP PROCEDURES AND REQUIREMENTS.
- DUCTWORK AND PIPING LAYOUTS AND LOCATIONS ARE SCHEMATIC. DO NOT SCALE THESE DRAWINGS. EXACT ROUTING OF DUCTWORK AND PIPING MUST BE DETERMINED IN THE FIELD. ALL DIMENSIONS SHALL BE FIELD VERIFIED BY THE CONTRACTOR BY ACTUAL MEASUREMENT AND OBSERVATION BEFORE ORDERING OR FABRICATING ANY DUCTWORK, PIPING OR EQUIPMENT. ANY DISCREPANCIES BETWEEN THE REQUIREMENTS OF THE CONTRACT DOCUMENTS AND THE EXISTING CONDITIONS OR DIMENSIONS SHALL BE REPORTED TO THE ENGINEER BEFORE THE PERFORMANCE OF ANY WORK. FAILURE TO VERIFY AND REPORT SHALL CONSTITUTE THE CONTRACTOR'S ACCEPTANCE OF THE EXISTING CONDITIONS AS FIT FOR THE PROPER EXECUTION OF THEIR WORK.
- DUCTWORK AND PIPING SHALL BE KEPT AS CLOSE AND HIGH AS POSSIBLE TO THE EXISTING CEILING AND FLOOR AND ROOF STRUCTURE IN ORDER THAT THE MAXIMUM AMOUNT OF SPACE IS AVAILABLE. ADDITIONAL OFFSETS, FITTINGS, ETC. NOT SHOWN BUT REQUIRED TO MAINTAIN MAXIMUM CLEARANCE SHALL BE PROVIDED AT NO ADDITIONAL COST.
- THE MECHANICAL CONTRACTOR SHALL COORDINATE RESPONSIBILITY FOR ALL PATCHING AND CLEANING ASSOCIATED WITH THIS PROJECT WITH THE GENERAL CONTRACTOR.
- EXISTING FLOOR DRAINS SHOULD BE COVERED DURING DEMOLITION AND NEW WORK CONSTRUCTION.

CLIENT NAME: THE UNIVERSITY OF NORTH CAROLINA AT CHAPEL HILL  
JOB NO.: 101 South RD  
LOCATION: CHAPEL HILL, NC 27514  
SCO ID: 24-28389-01A  
ISSUE DATE: 11-17-25  
JOB NO.: 10021-0001  
DWG. NO.:  
SCO NAME: UNC VENABLE HALL LOWER LEVEL

**M001**

MECHANICAL DATA SHEET



**NOTCH**  
NOTCH DESIGN, PLLC  
212 W MAIN ST, SUITE E,  
CARRBORO, NC  
www.notchdesign.us  
info@notchdesign.us



www.mckimcreed.com  
4300 Edwards Mill Rd Suite 200  
Raleigh, NC 27612  
(919) 223-8091  
(919) 233-8031 Fax

NC License# F-1222

REVISION:  
SCO REVIEW 9/19/25  
2nd SCO REVIEW 10/24/25  
Construction Set 11/17/25

## CONSTRUCTION SET




© 2024  
Notch Design

CLIENT NAME: THE UNIVERSITY OF NORTH CAROLINA AT CHAPEL HILL  
JOB NAME: UNC VENABLE HALL LOWER LEVEL UPLIFT  
LOCATION: VENABLE HALL LOWER LEVEL  
101 South RD  
CHAPEL HILL, NC 27514  
SCO ID: 24-28389-01A

ISSUE DATE: 11-17-25  
JOB NO.: 10021-0001  
DWG. NO.:  
11-17-25

**MD111**  
DEMO  
MECHANICAL -  
GROUND FLOOR  
PLAN

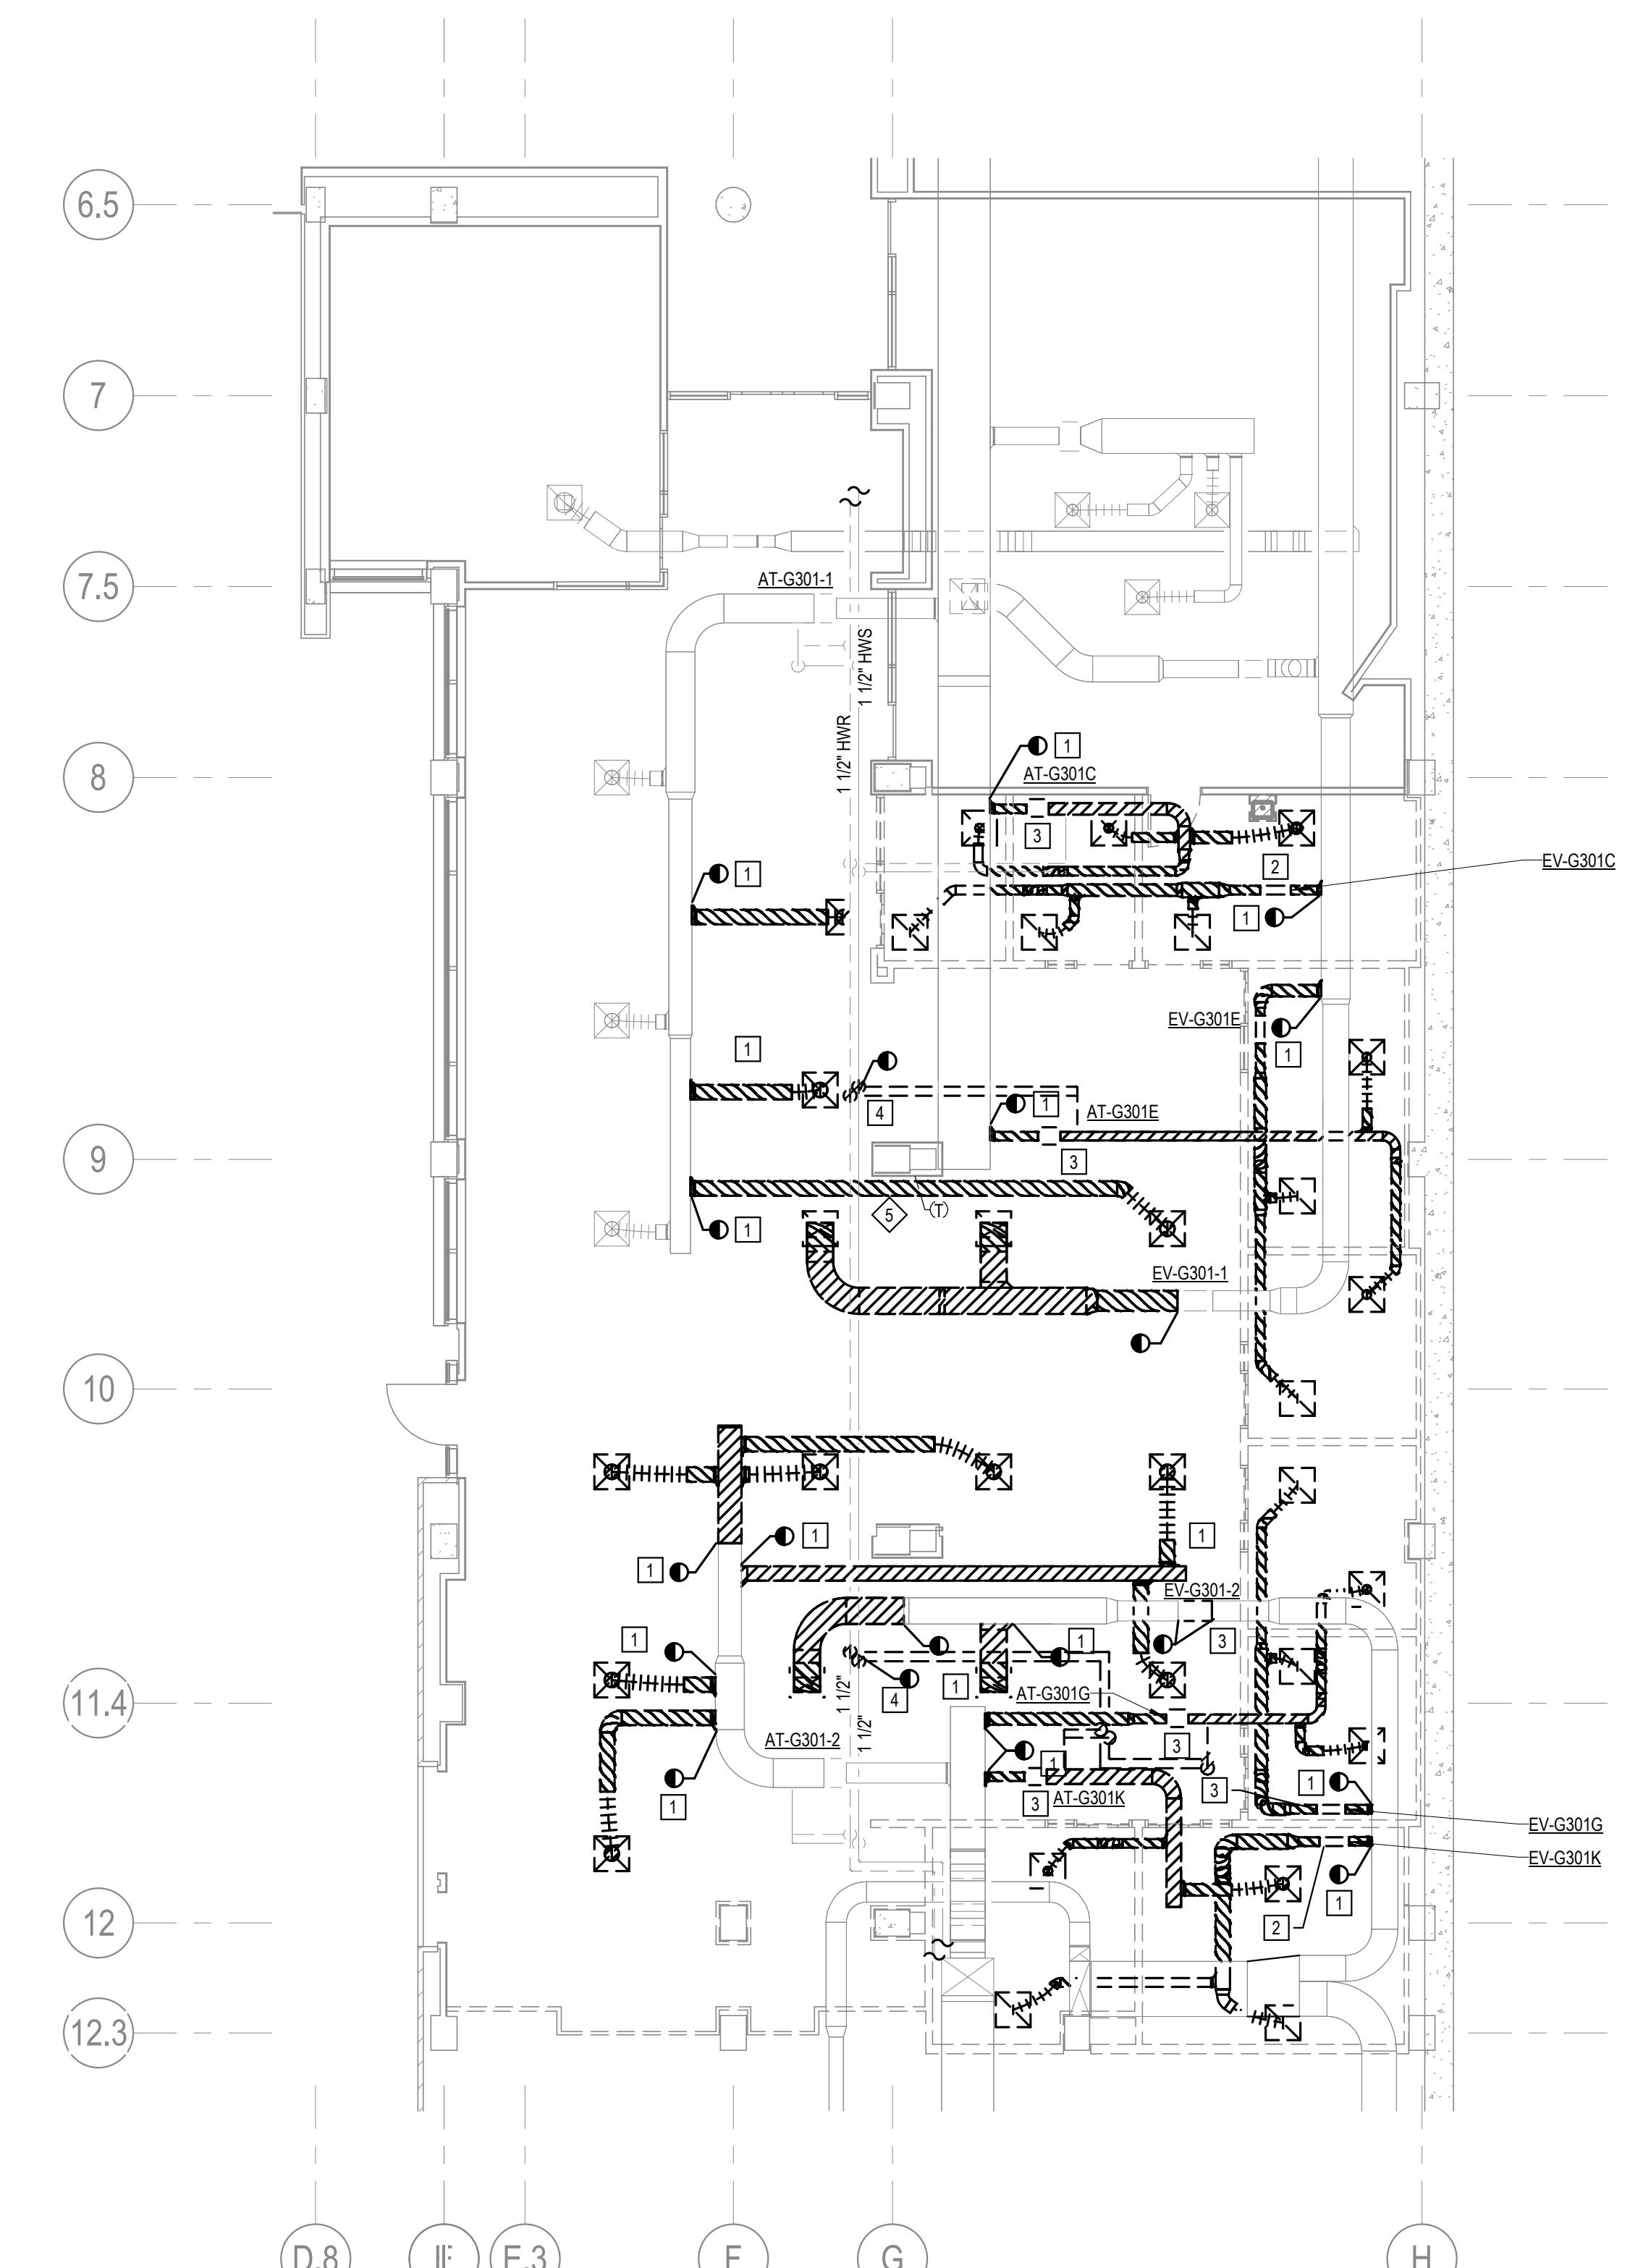

1 MECHANICAL GROUND DEMOLITION PLAN  
SCALE: 1/8" = 1'-0"

1/8" = 1'-0" 8' 4' 0 8' 16'



**NOTCH**  
NOTCH DESIGN, PLLC  
212 W MAIN ST, SUITE E,  
CARRBORO, NC  
www.notchdesign.us  
info@notchdesign.us



www.mckimcreed.com  
4300 Edwards Mill Rd Suite 200  
Raleigh, NC 27612  
(919) 223-8091  
(919) 233-8031 Fax

NC License# F-1222

REVISION  
SCO REVIEW 9/19/25  
2nd SCO REVIEW 10/24/25  
Construction Set 11/17/25

## CONSTRUCTION SET



© 2024  
Notch Design

CLIENT NAME: THE UNIVERSITY OF NORTH CAROLINA AT CHAPEL HILL  
JOB NAME: UNC VENABLE HALL LOWER LEVEL UPGRADE  
LOCATION: 101 South RD  
CHAPEL HILL, NC 27514

SCO ID: 24-28389-01A

**M111**


DUCTWORK -  
GROUND FLOOR  
PLAN

1/8" = 1'-0" 8' 4' 0' 8' 16'


## 1 MECHANICAL DUCTWORK GROUND PLAN

SCALE: 1/8" = 1'-0"

1

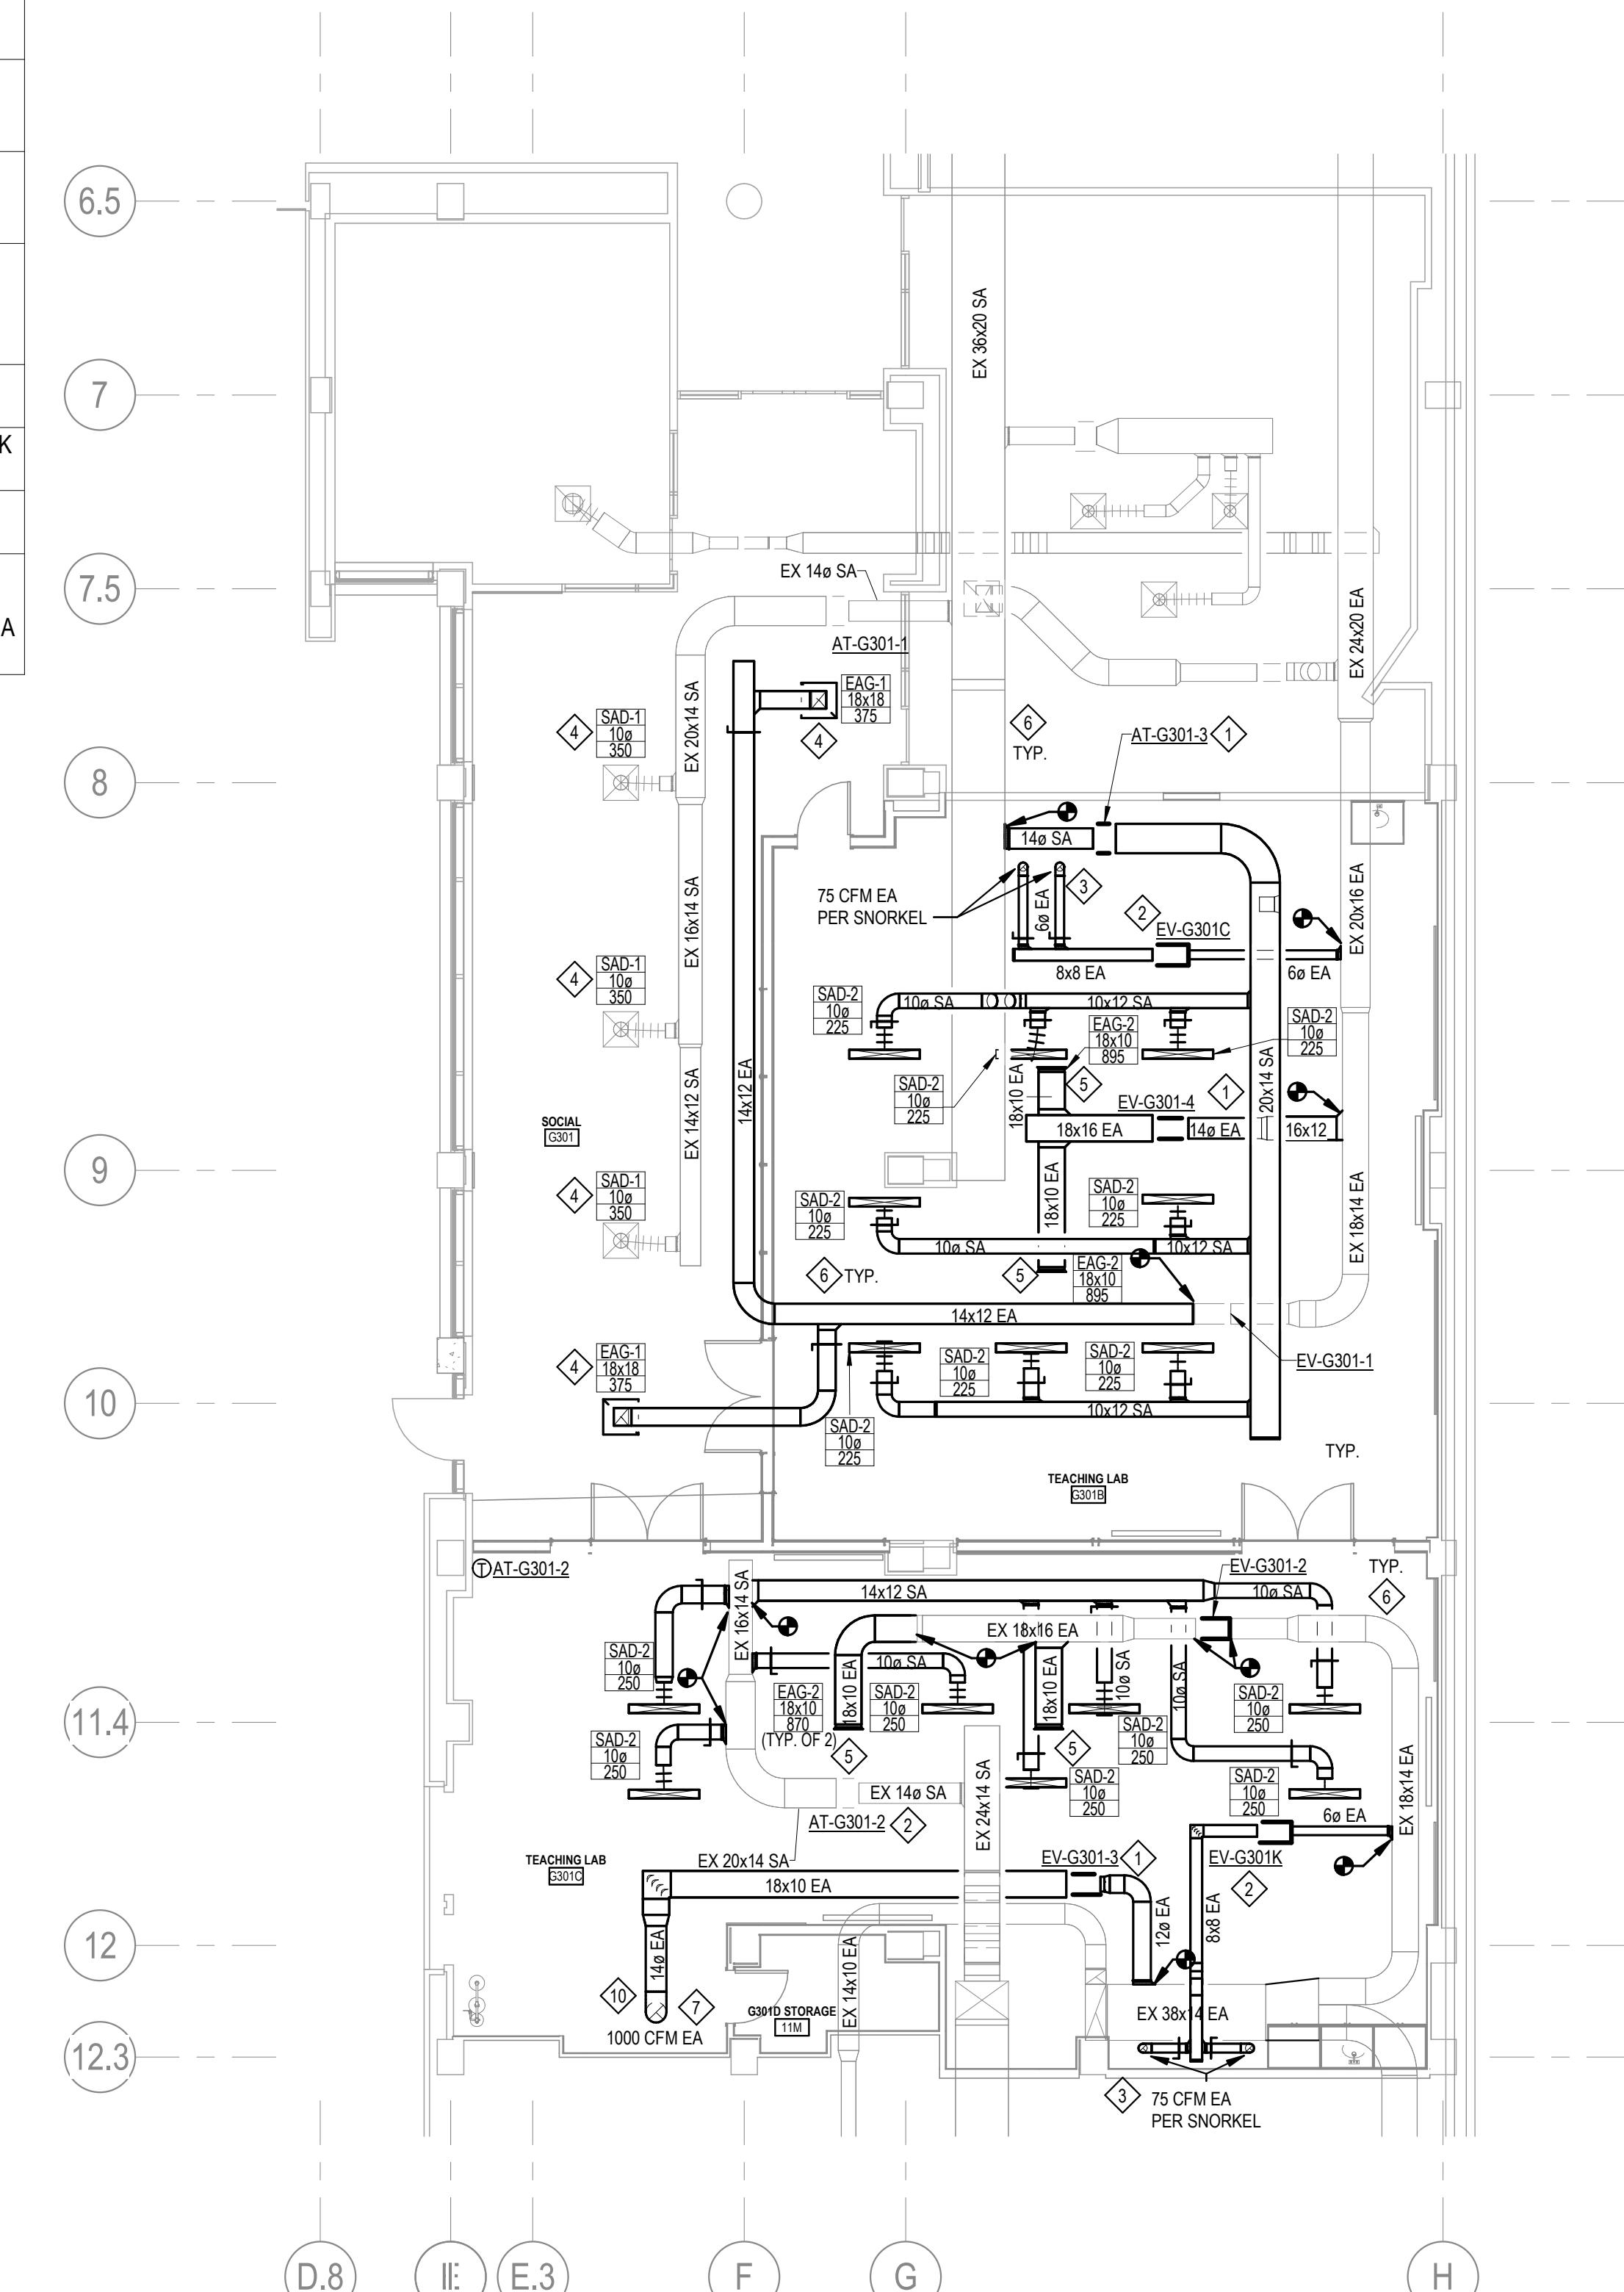

1 MECHANICAL DUCTWORK GROUND PLAN  
SCALE: 1/8" = 1'-0"

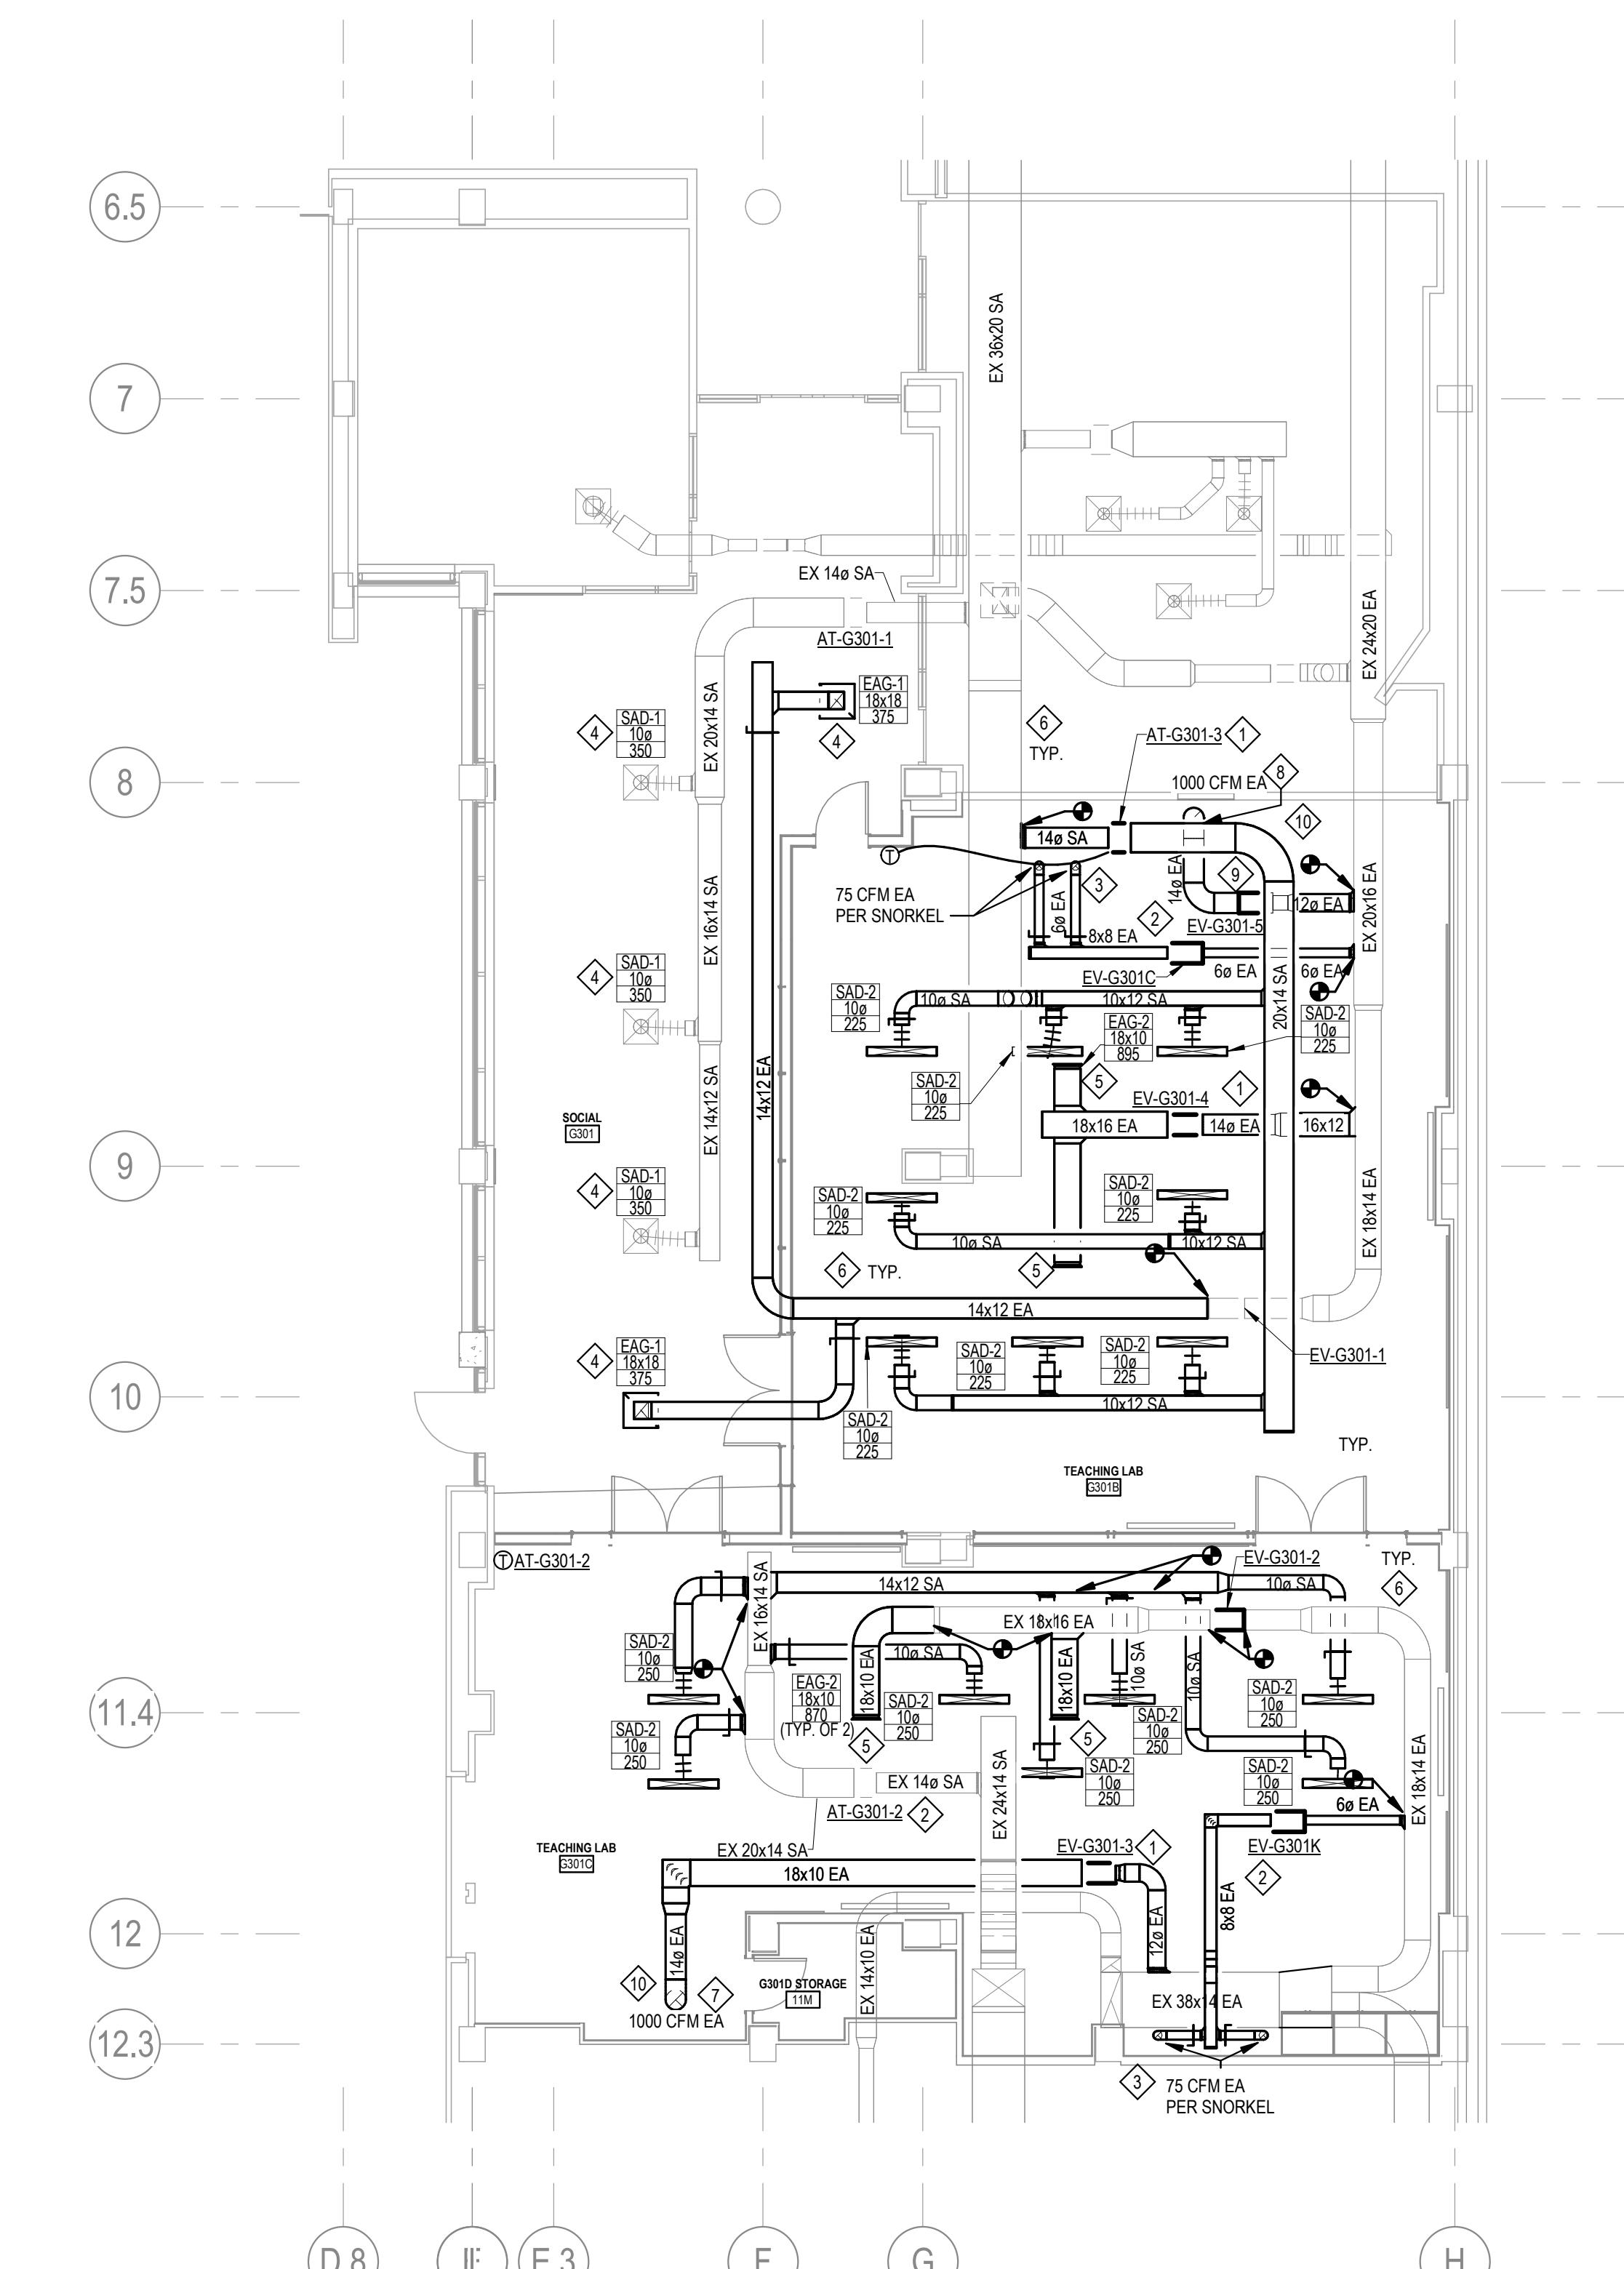

## 2 MECHANICAL DUCTWORK GROUND PLAN ALTERNATE 01

SCALE: 1/8" = 1'-0"



**NOTCH**  
NOTCH DESIGN, PLLC  
212 W MAIN ST, SUITE E,  
CARRBORO, NC  
www.notchdesign.us  
info@notchdesign.us



www.mckimcreed.com  
4300 Edwards Mill Rd Suite 200  
Raleigh, NC 27612  
(919) 233-8091  
(919) 233-8031 Fax

NC License# F-1222

REVISION  
SCO REVIEW 9/19/25  
2nd SCO REVIEW 10/24/25  
Construction Set 11/17/25

## CONSTRUCTION SET




© 2024  
Notch Design

CLIENT NAME: THE UNIVERSITY OF NORTH CAROLINA AT CHAPEL HILL  
JOB NAME: UNC VENABLE HALL LOWER LEVEL UPGRADE  
LOCATION: 101 South RD  
CHAPEL HILL, NC 27514  
SCO ID: 24-28389-01A

CLIENT NAME: THE UNIVERSITY OF NORTH CAROLINA AT CHAPEL HILL  
JOB NAME: UNC VENABLE HALL LOWER LEVEL UPGRADE  
LOCATION: 101 South RD  
CHAPEL HILL, NC 27514  
SCO ID: 24-28389-01A  
ISSUE DATE: 11-17-25  
JOB NO: 10021-0001  
DWG. NO: \_\_\_\_\_

**M211**

PIPING - GROUND  
FLOOR PLAN

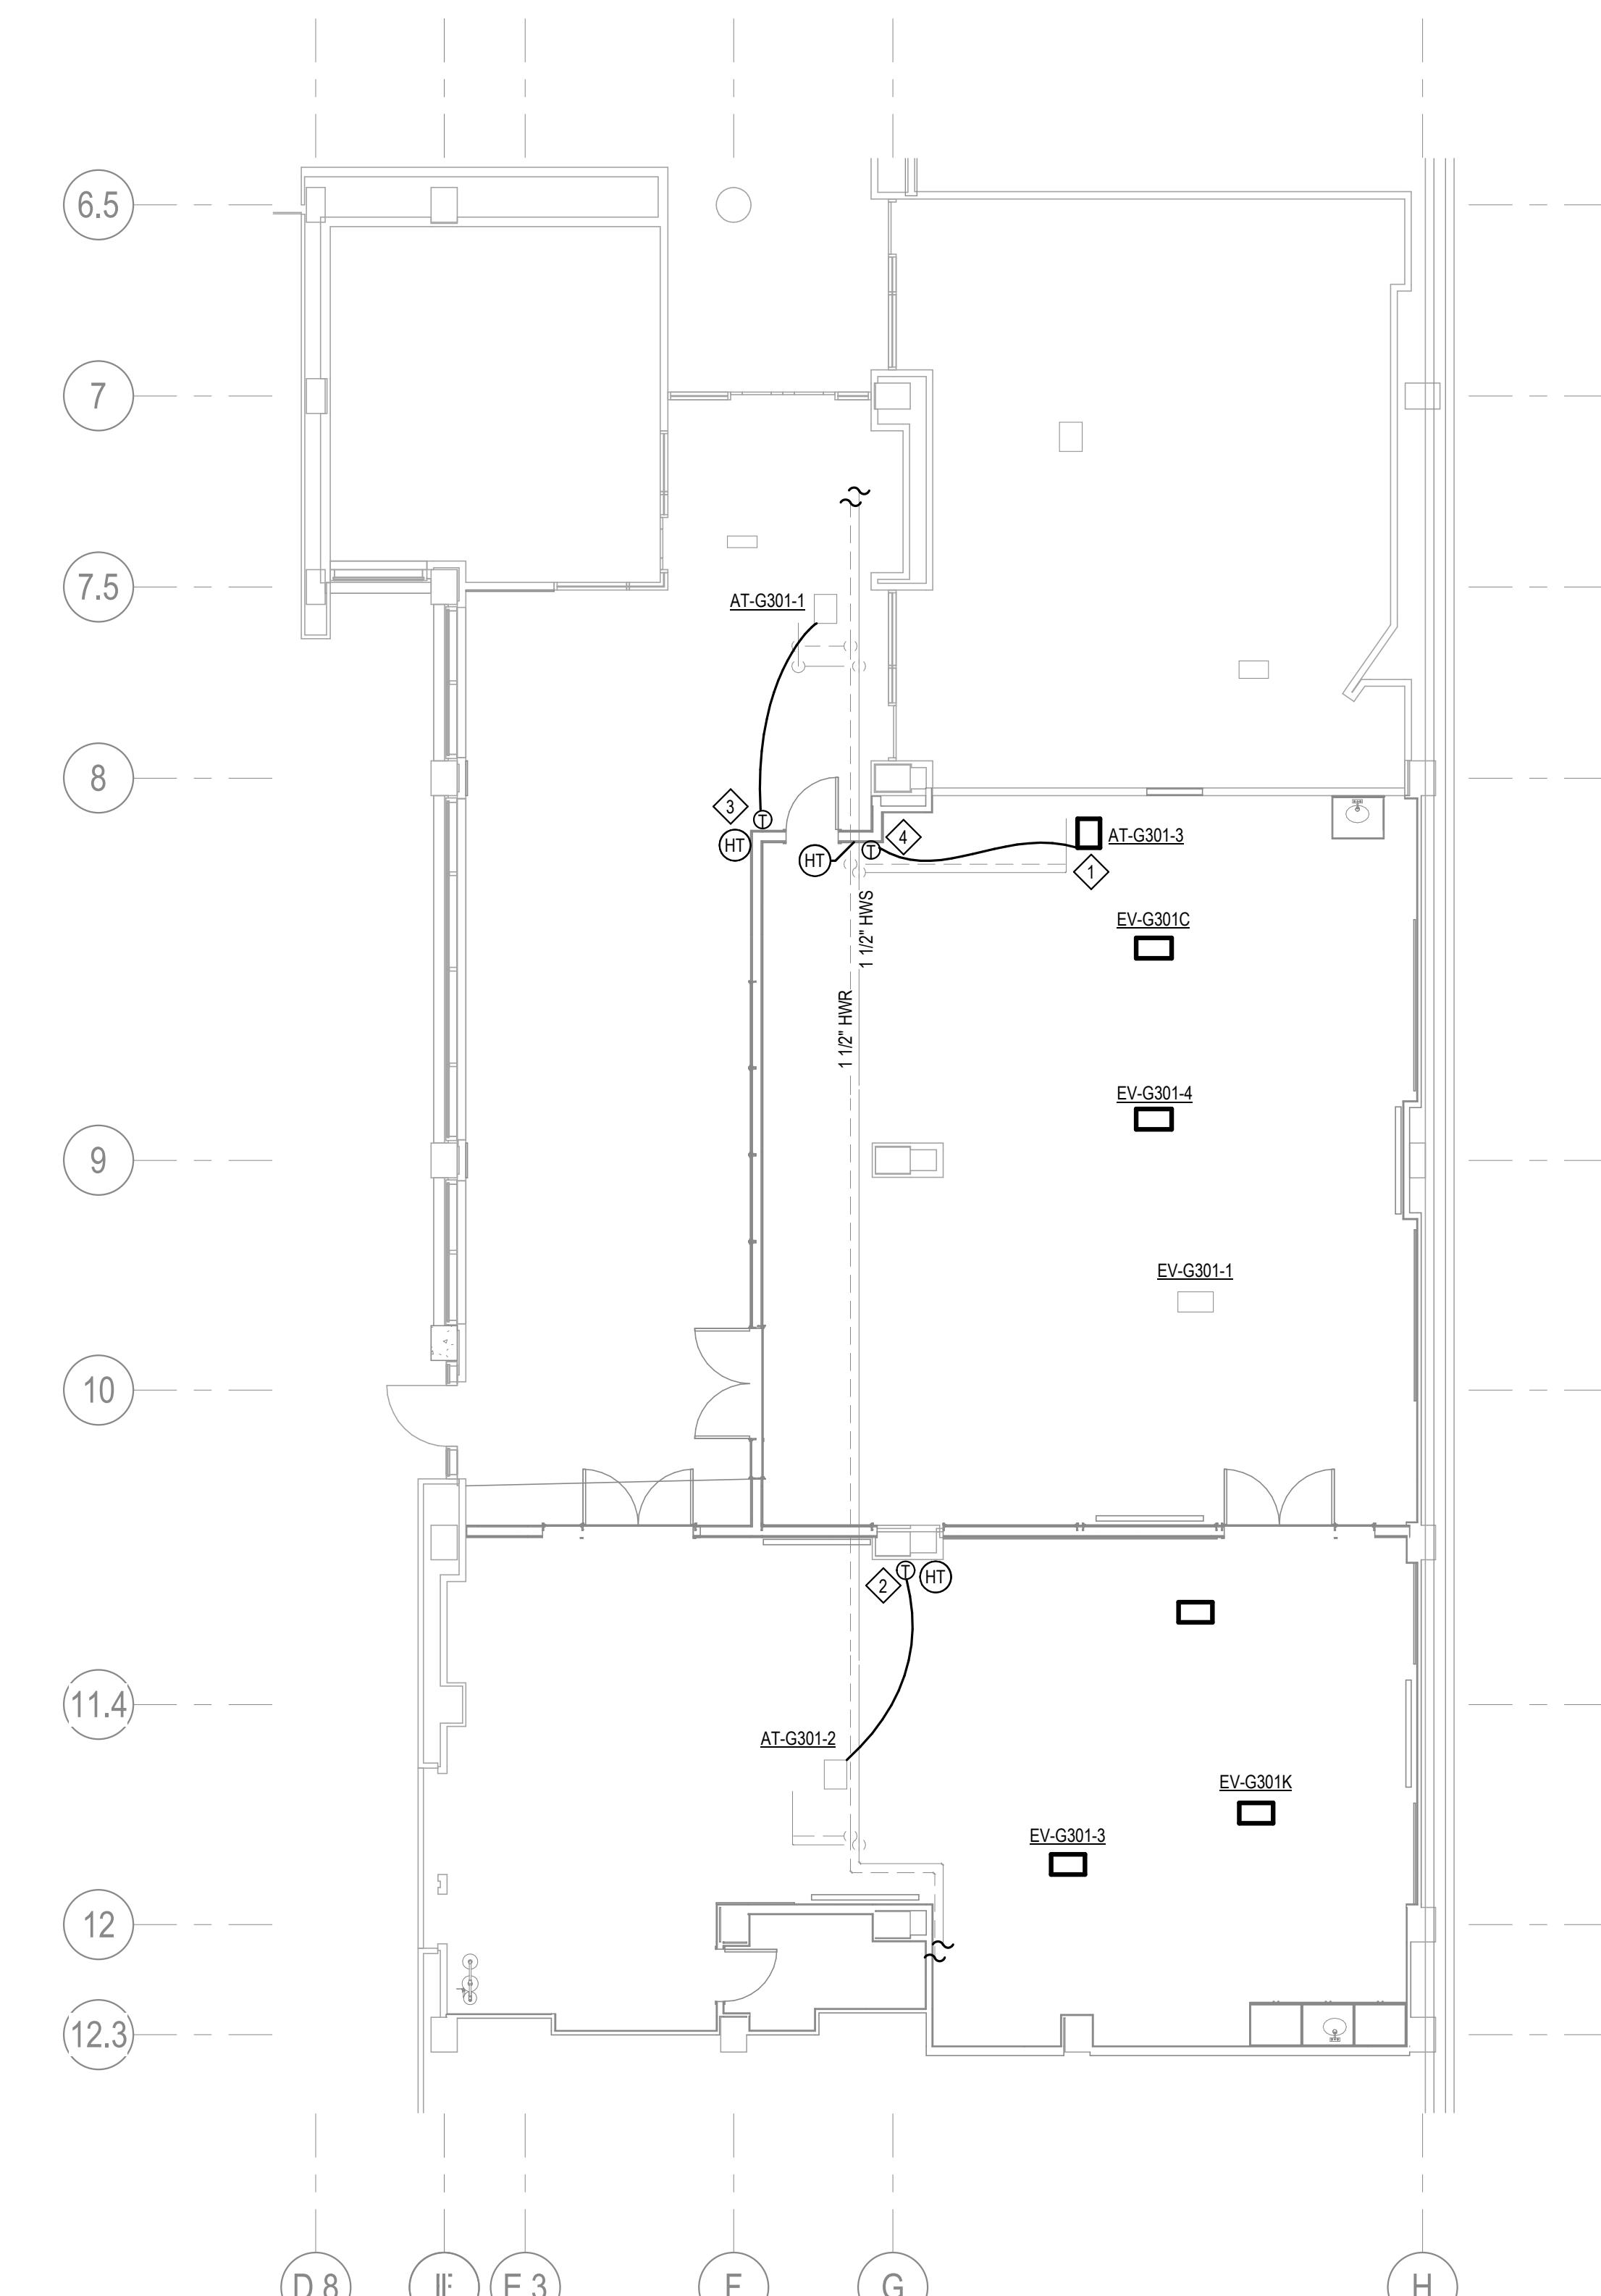

1 MECHANICAL PIPING BASEMENT PLAN

SCALE: 1/8" = 1'-0"

1/8" = 1'-0" 8' 4' 0 8' 16'



**NOTCH**  
NOTCH DESIGN, PLLC  
212 W MAIN ST, SUITE E,  
CARRBORO, NC  
www.notchdesign.us  
info@notchdesign.us



www.mckimcreed.com  
4300 Edwards Mill Rd Suite 200  
Raleigh, NC 27612  
(919) 223-8091  
(919) 233-8031 Fax

NC License# F-1222

REVISION:  
SCO REVIEW 9/19/25  
2nd SCO REVIEW 10/24/25  
Construction Set 11/17/25


## CONSTRUCTION SET



© 2024  
Notch Design


CLIENT NAME: THE UNIVERSITY OF NORTH CAROLINA AT CHAPEL HILL  
JOB NAME: UNC VENABLE HALL LOWER LEVEL UPLIFT  
LOCATION: 101 South RD  
CHAPEL HILL, NC 27514

SCO ID: 24-28389-01A

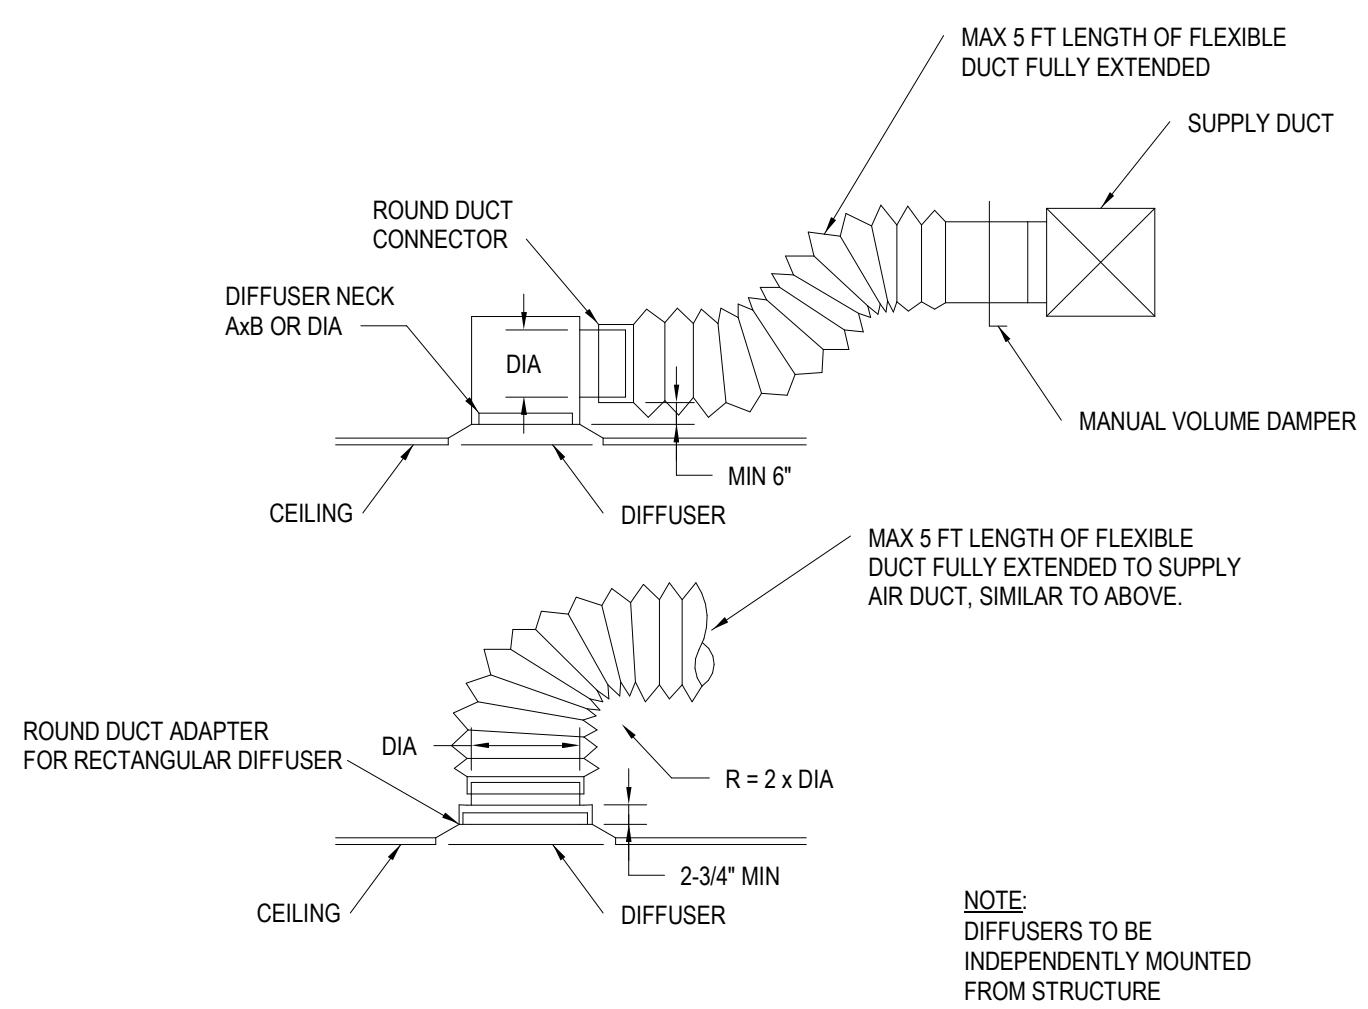


**1 DIFFUSER CONNECTION**

SCALE: 12" = 1'-0"

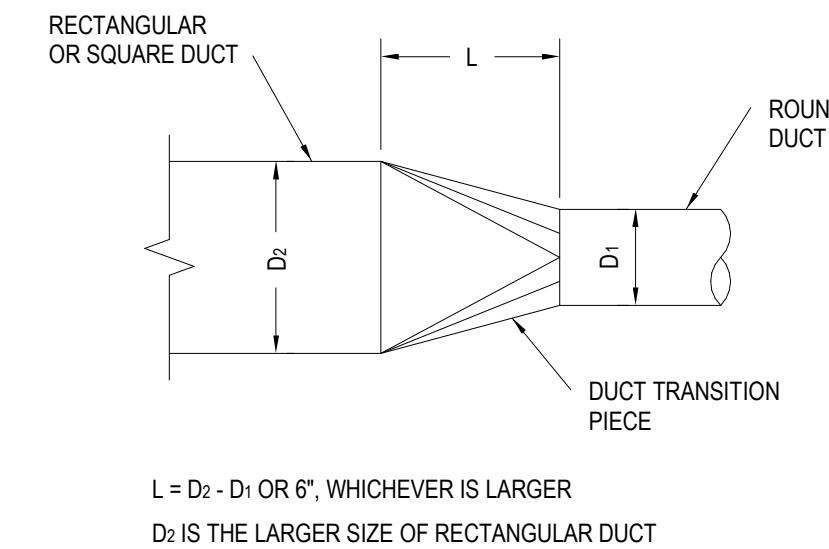


**2 3-210 DUCT TRANSITION**

SCALE: 12" = 1'-0"

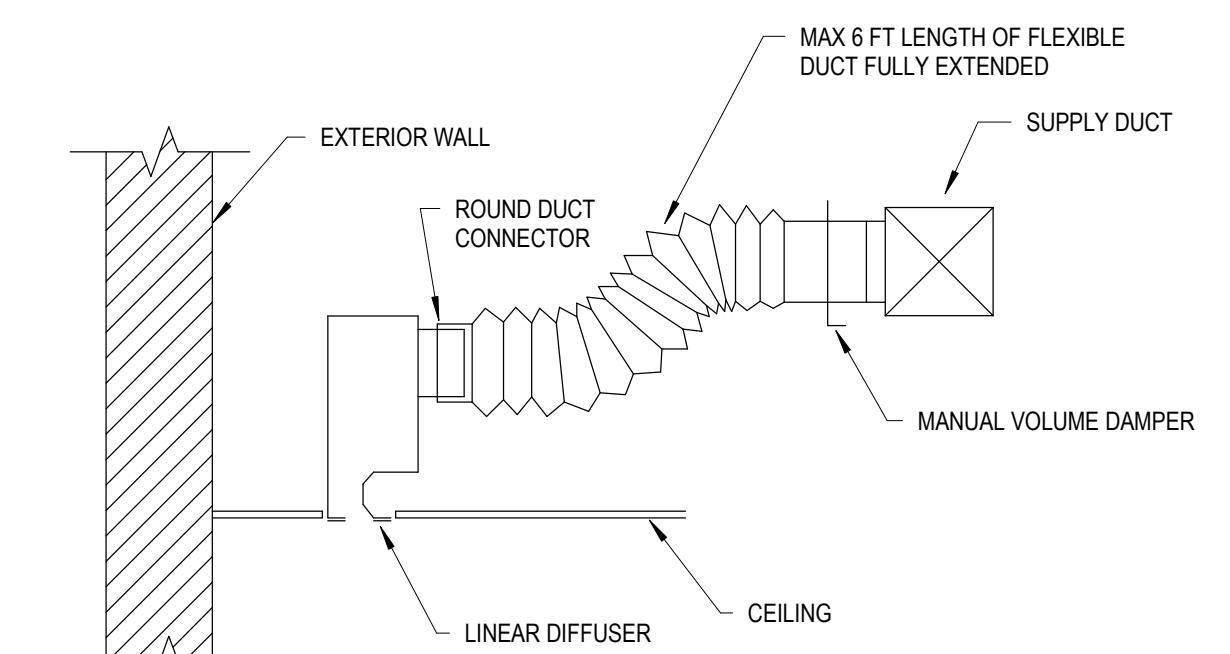


**3 LINEAR DIFFUSER CONNECTION**

SCALE: NTS

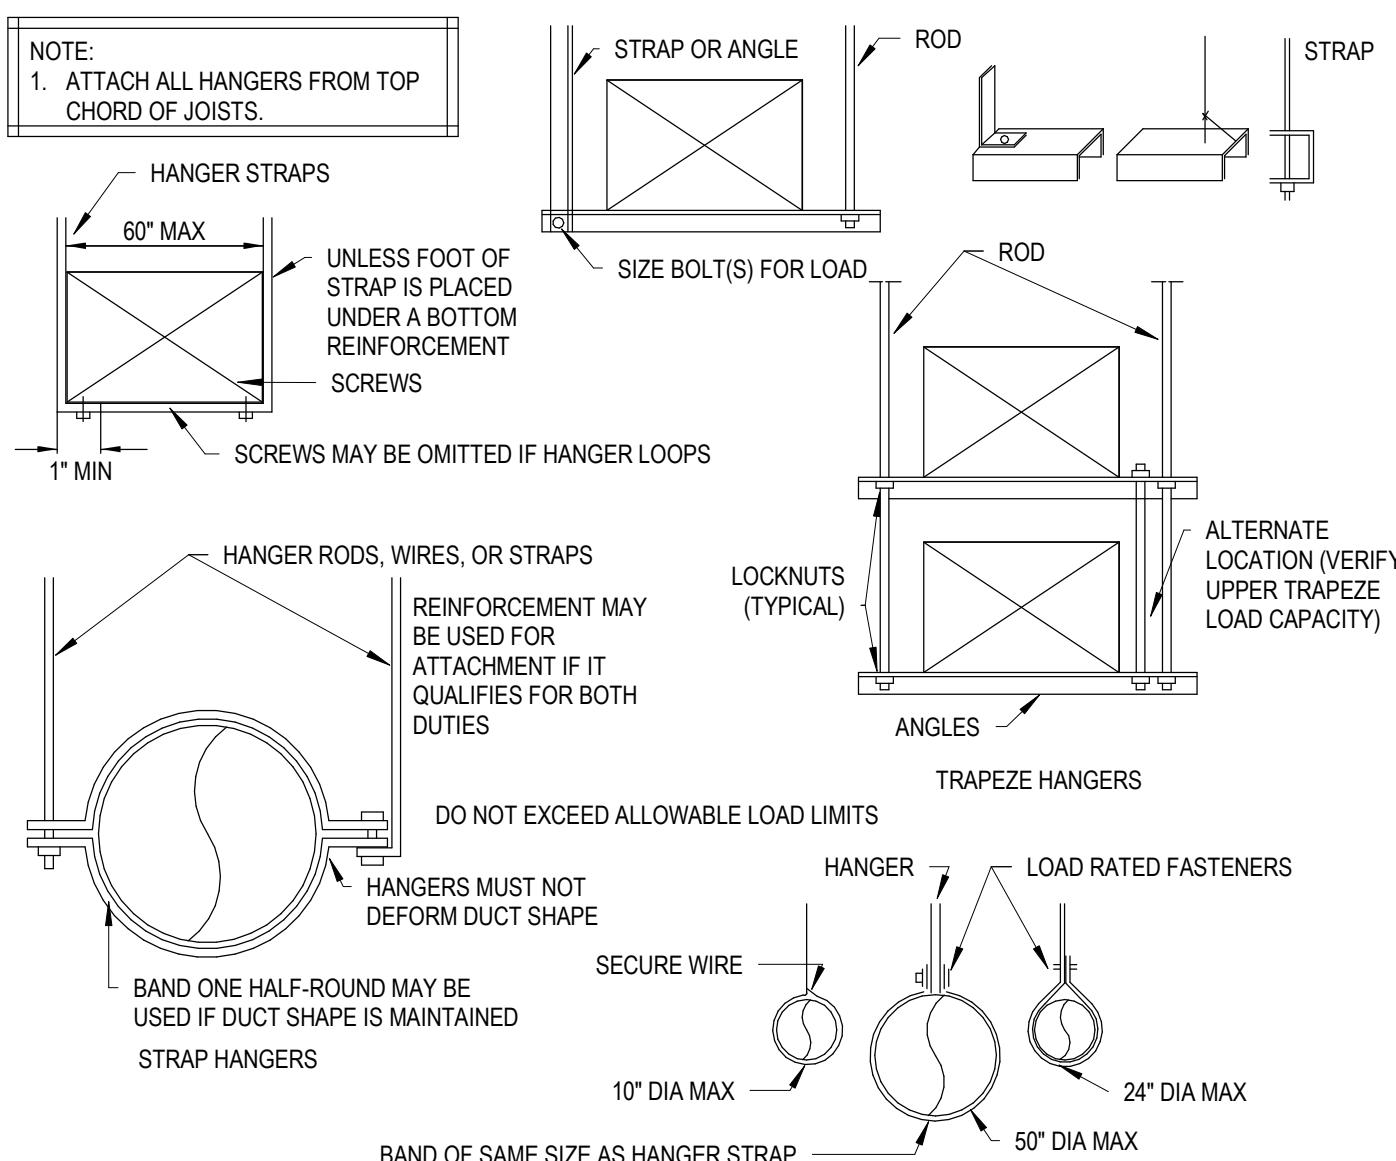

**4 DUCT HANGERS**

SCALE: NTS

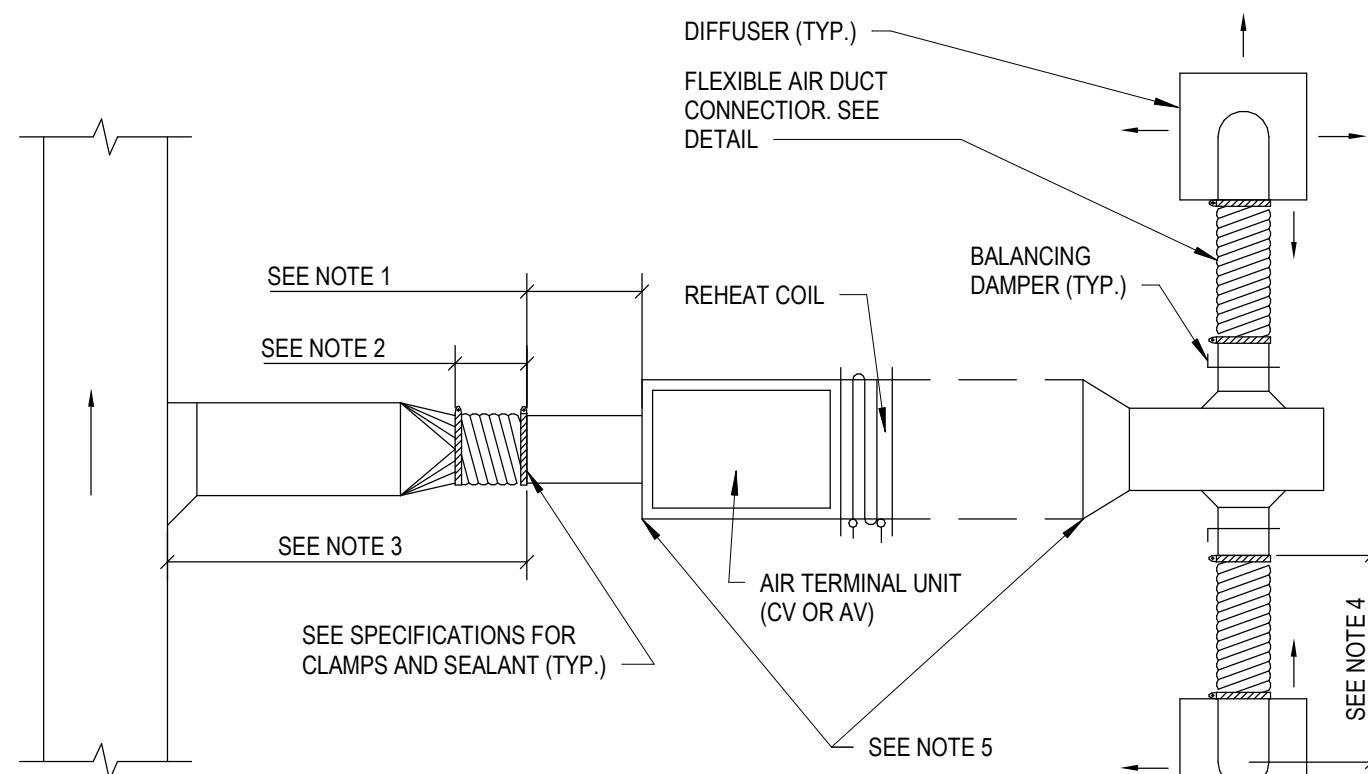

**5 AIR TERMINAL UNITS - DUCT CONNECTIONS**

SCALE: NTS

**M301**

MECHANICAL  
DETAILS

ISSUE DATE: 11-17-25  
JOB NO: 10021-0001  
DWG. NO: \_\_\_\_\_



**NOTCH**  
NOTCH DESIGN, PLLC  
212 W MAIN ST, SUITE E,  
CARRBORO, NC  
www.notchdesign.us  
info@notchdesign.us

 **McKIM & CREED**  
www.mckimcreed.com  
4300 Edwards Mill Rd Suite 200  
Raleigh, NC 27612  
(919) 233-8091  
(919) 233-8031 Fax  
NC License# F-1222

REVISION:  
SCO REVIEW 9/19/25  
2nd SCO REVIEW 10/24/25  
Construction Set 11/17/25

## CONSTRUCTION SET



© 2024  
Notch Design

CLIENT NAME: THE UNIVERSITY OF NORTH CAROLINA AT CHAPEL HILL  
JOB NAME: UNC VENABLE HALL LOWER LEVEL UPGRADE  
LOCATION: 101 South RD  
CHAPEL HILL, NC 27514  
SCO ID: 24-28389-01A  
ISSUE DATE: 11-17-25  
JOB NO.: 10021-0001  
DWG. NO. \_\_\_\_\_

**M401**

MECHANICAL  
SCHEDULES

### AIR TERMINAL DEVICES SCHEDULE

TAG	SYSTEM TYPE	STATUS	MAX AIRFLOW (CFM)	MIN AIRFLOW (CFM)	INLET SIZE (IN. Ø)	APD (IN WC)	REHEAT CFM	HEAT CAPACITY (MBH)	EAT (°F)	LAT (°F)	GPM	EWT (°F)	LWT (°F)	WPD (FT)	MANUF	MODEL	NOTES
EV-G301-1	EXHAUST	EXISTING	750	750	14	EX.	-	-	-	-	-	-	-	-	EXISTING	EXISTING	
EV-G301-2	EXHAUST	NEW	1740	700	14	0.17	-	-	-	-	-	-	-	-	ACCUTROL	AVT6414-03	2
EV-G301-3	EXHAUST	NEW	1000	120	10	0.27	-	-	-	-	-	-	-	-	ACCUTROL	AVC6210-03	2
EV-G301-4	EXHAUST	NEW	1790	750	14	0.18	-	-	-	-	-	-	-	-	ACCUTROL	AVT6414-03	2
EV-G301-5	EXHAUST	NEW	1000	120	10	0.27	-	-	-	-	-	-	-	-	ACCUTROL	AVC6210-03	1, 2
EV-G301C	EXHAUST	RELOCATED	150	0	6	EX.	-	-	-	-	-	-	-	-	EXISTING	EXISTING	
EV-G301K	EXHAUST	RELOCATED	150	0	6	EX.	-	-	-	-	-	-	-	-	EXISTING	EXISTING	
AT-G301-1	SUPPLY	EXISTING	1050	1050	14	EX.	1050	42	55	85	4.3	160	140	0.2	EXISTING	EXISTING	
AT-G301-2	SUPPLY	EXISTING	1750	1750	14	EX.	1750	64.7	55	85	6.6	160	140	0.2	EXISTING	EXISTING	
AT-G301-3	SUPPLY	NEW	1800	1800	14	0.38	1800	72.4	55	85	4.02	160	140	4.51	PRICE	SDV	3

NOTES:  
1. ADD ALTERNATE 01: PROVIDE NEW EXHAUST AIR VALVE FOR FUME HOOD.  
2. PROVIDE NEW VENTURI TYPE AIR TERMINAL UNIT.  
3. PROVIDE NEW BLADE TYPE AIR TERMINAL UNIT.

AIR DISTRIBUTION SCHEDULE						
TAG	SYSTEM	BASIS OF DESIGN		DESCRIPTION	MAX. N.C.	NOTES
		MANUF	MODEL			
EAG-1	EXHAUST	PRICE	PDDR	PERFORATED RETURN GRILLE, 24x24" FACE WITH SQUARE INLET PROFILE WITH SQUARE TO ROUND INLET CONNECTION WHERE REQUIRED. SEE PLANS FOR NECK SIZES/DIMENSIONS.	25	
EAG-2	EXHAUST	PRICE	80	EGG CRATE RETURN GRILLE, 0" CORE, 1/2 IN X 1/2 IN. DEPTH	25	
SAD-1	SUPPLY	EXISTING	EXISTING	EXISTING 24x24" DIFFUSER. SEE PLANS FOR AIRFLOW.	25	
SAD-2	SUPPLY	PRICE	SDS	PRICE SDS100 WITH SDS PLenum, 1 IN. SLOT WIDTH WITH 3 SLOTS.	25	

**M401**

## CONSTRUCTION SET



© 2024  
Notch Design





CLIENT NAME: THE UNIVERSITY OF NORTH CAROLINA AT CHAPEL HILL  
JOB NAME: UNC VENABLE HALL LOWER LEVEL UPTIT

LOCATION: 101 South RD  
CHAPEL HILL, NC 27514

ISSUE DATE: 11-17-25  
JOB NO.: 10021-0001  
DWG. NO.

**M501**

MECHANICAL  
CONTROL  
DIAGRAMS

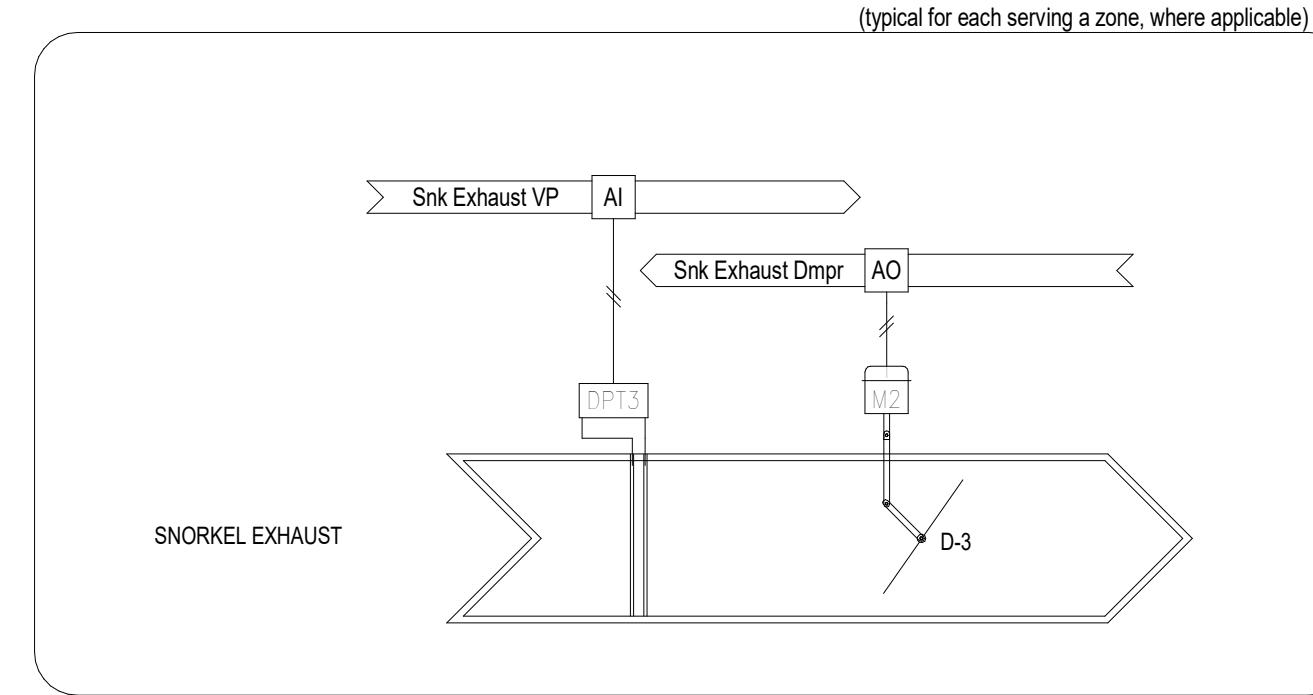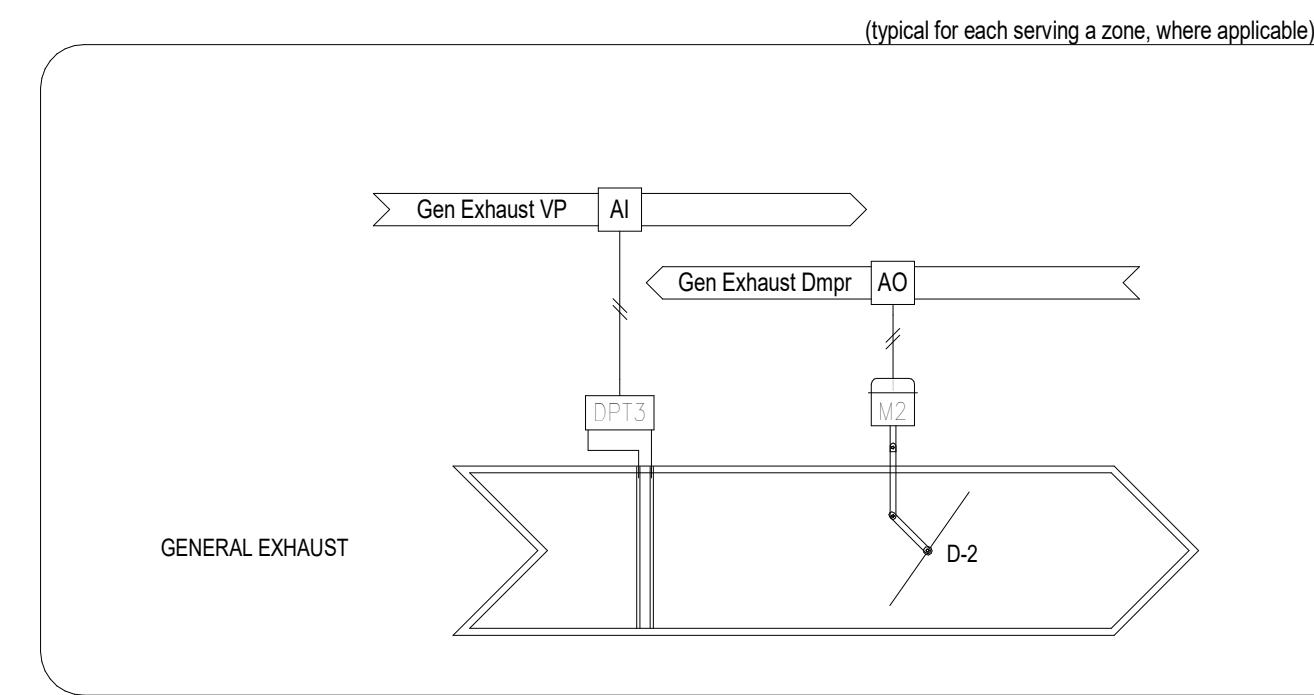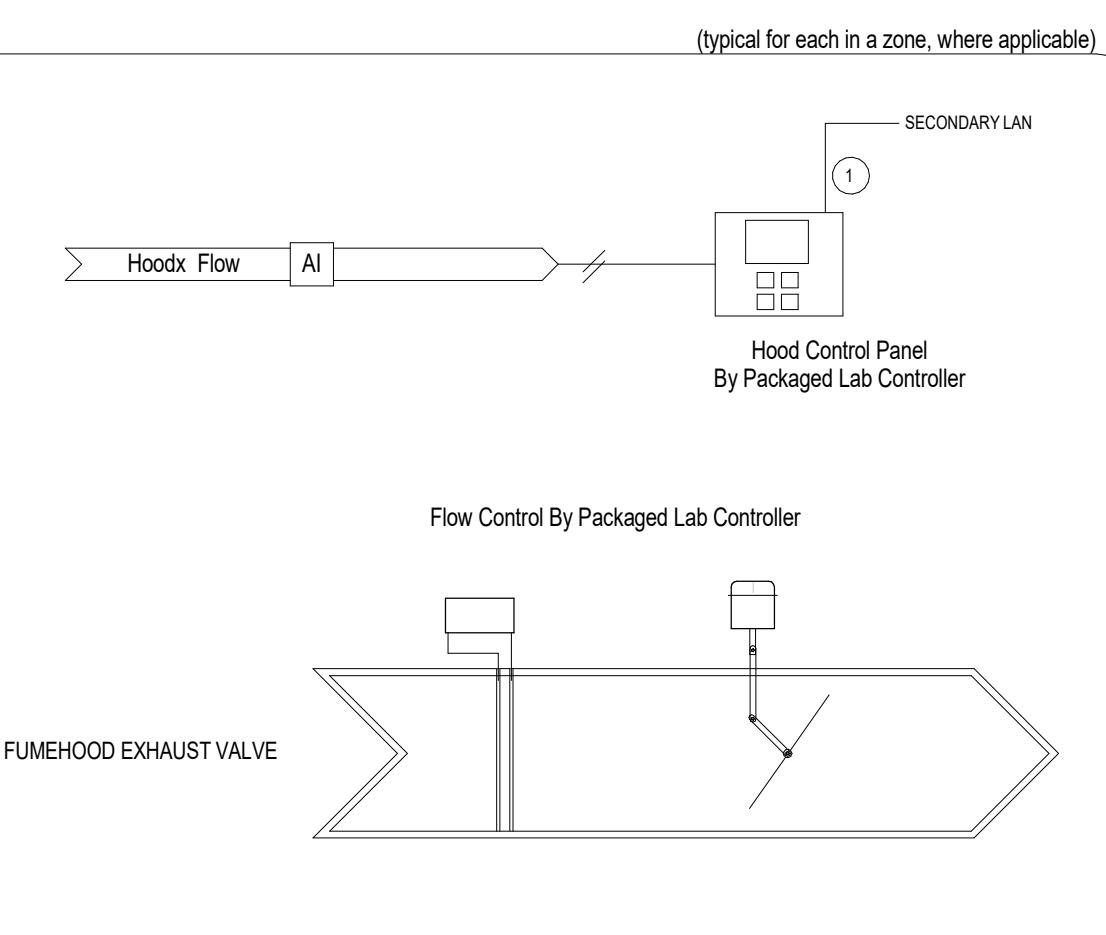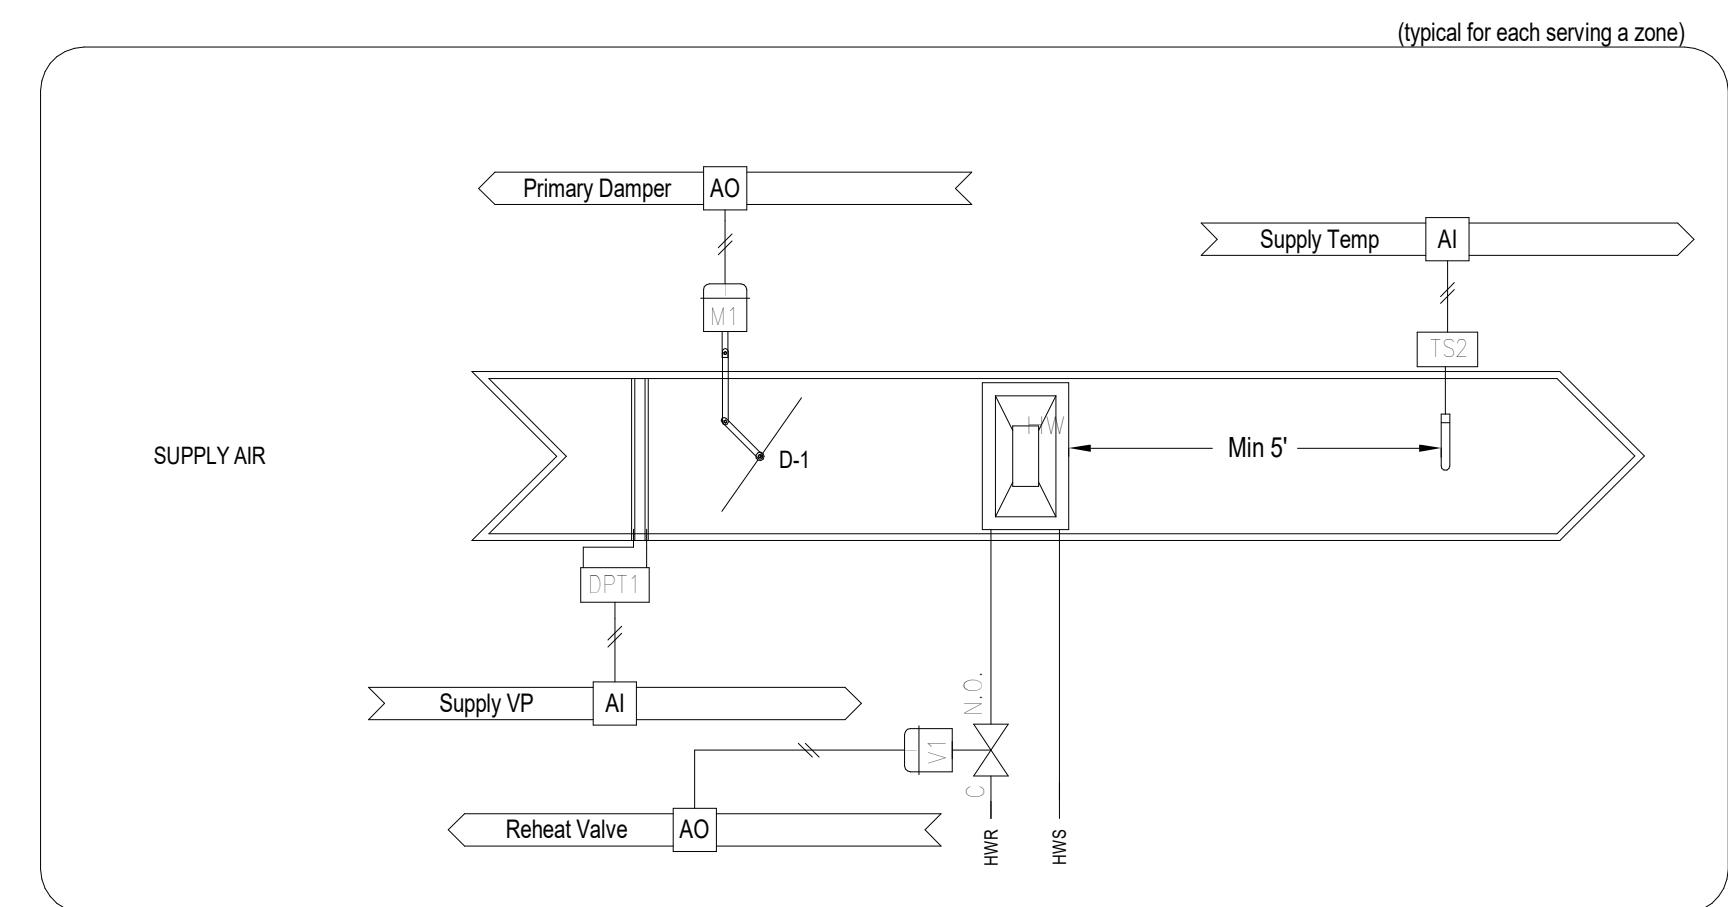


**NOTES**

- Provide digital interface to the control system for diagnostic point information. Required points to be mapped include: Hood cfm, Master Alarm, Volume/Velocity Reset & Sash Position. Hood Flow point to be hardwired to the BAS for flow calculation of General Exhaust and Supply Air Valves
- NOT USED
- Provide a single controller for each Flow Tracking Zone. Broadcasting flow setpoints between separate controllers at each Supply or Exhaust valve is not acceptable.
- Provide a single graphic for each flow tracking zone that depicts all equipment and devices in the zone. Show all values and setpoints as indicated in the logic diagram below. Provide links to the zone hood controllers from the tracking zone graphic, as applicable.
- Drawing applies to entire open lab. i.e. Each open lab is considered a zone.
- Average all zone sensors in a flow tracking zone. Use average zone temperature as controlling input for space temperature control. Provide software logic that will allow the system operator to exclude any individual zone temperature sensors from the averaging calculations through the head end. This should be accomplished without the need to modify or download a new program.
- Provide only 1 zone sensor in each open lab flow tracking zone with setpoint adjust and override. All other sensors shall have space temperature only. Locations of the zone sensors with setpoint adjust and override shall be labeled and shown on the floor plans.

ADDRESS	POINT DESCRIPTOR	POINTS LIST						
		POINT TYPE	DI	AI	DO	AO	VP	REMARKS
Override			•					
Space Temp				•				
Temp Adj				•				
Space Humidity				•				
Supply VP				•				
Primary Damper					•			
Supply Temp				•				
Reheat Valve						•		
Gen Exhaust VP						•		
Gen Exhaust Dmpr						•		
Snk Exhaust VP						•		
Snk Exhaust Dmpr						•		
Hood x Flow						•		

LOGIC VARIABLES		
BINARY	ANALOG	DESCRIPTION
<i>Occ</i>		ON WHEN OCCUPIED MODE IS ACTIVE
<i>STBK</i>		ON WHEN AHU IN SETBACK MODE
<i>Temp</i>		VARIABLE VALUE OF SPACE TEMPERATURE
<i>HTSP</i>		VARIABLE CALCULATED VALUE OF EFFECTIVE HEATING SETPOINT
<i>CLSP</i>		VARIABLE CALCULATED VALUE OF EFFECTIVE COOLING SETPOINT
<i>HdxFL</i>		VARIABLE CALCULATED VALUE OF HOOD EXHAUST FLOW (CFM) FOR HOOD x
<i>GxFL</i>		VARIABLE CALCULATED VALUE OF GENERAL EXHAUST FLOW (CFM) FOR VALVE x
<i>SPxFL</i>		VARIABLE CALCULATED VALUE OF SUPPLY FLOW (CFM) FOR SUPPLY VALVE x
<i>SPCT</i>		VARIABLE CALCULATED VALUE OF SUPPLY FLOW SETPOINT % FOR EACH VALVE
<i>ZSSP</i>		VARIABLE CALCULATED VALUE OF ZONE TOTAL SUPPLY FLOW SETPOINT
<i>ZSMN</i>		VARIABLE CALCULATED VALUE OF ZONE TOTAL SUPPLY SCHEDULED MIN SETPT
<i>ZSMX</i>		VARIABLE CALCULATED VALUE OF ZONE TOTAL SUPPLY SCHEDULED MAX SETPT
<i>EPCT</i>		VARIABLE CALCULATED VALUE OF EXHAUST FLOW SETPOINT % FOR EACH VALVE
<i>ESMN</i>		VARIABLE CALCULATED VALUE OF ZONE TOTAL EXHAUST MIN SETPOINT
<i>ESMX</i>		VARIABLE CALCULATED VALUE OF ZONE TOTAL EXHAUST MAX SETPOINT
<i>Run</i>		ON WHEN SUPPLY AIR SOURCE (AHU) IS PROVEN ON
<i>SNxFL</i>		VARIABLE CALCULATED VALUE OF SNORKEL EXHAUST FLOW (CFM) FOR SNK x

## LAB VAV FLOW TRACKING – MULTI ZONE with TERMINAL SUPPLY DAT RESET

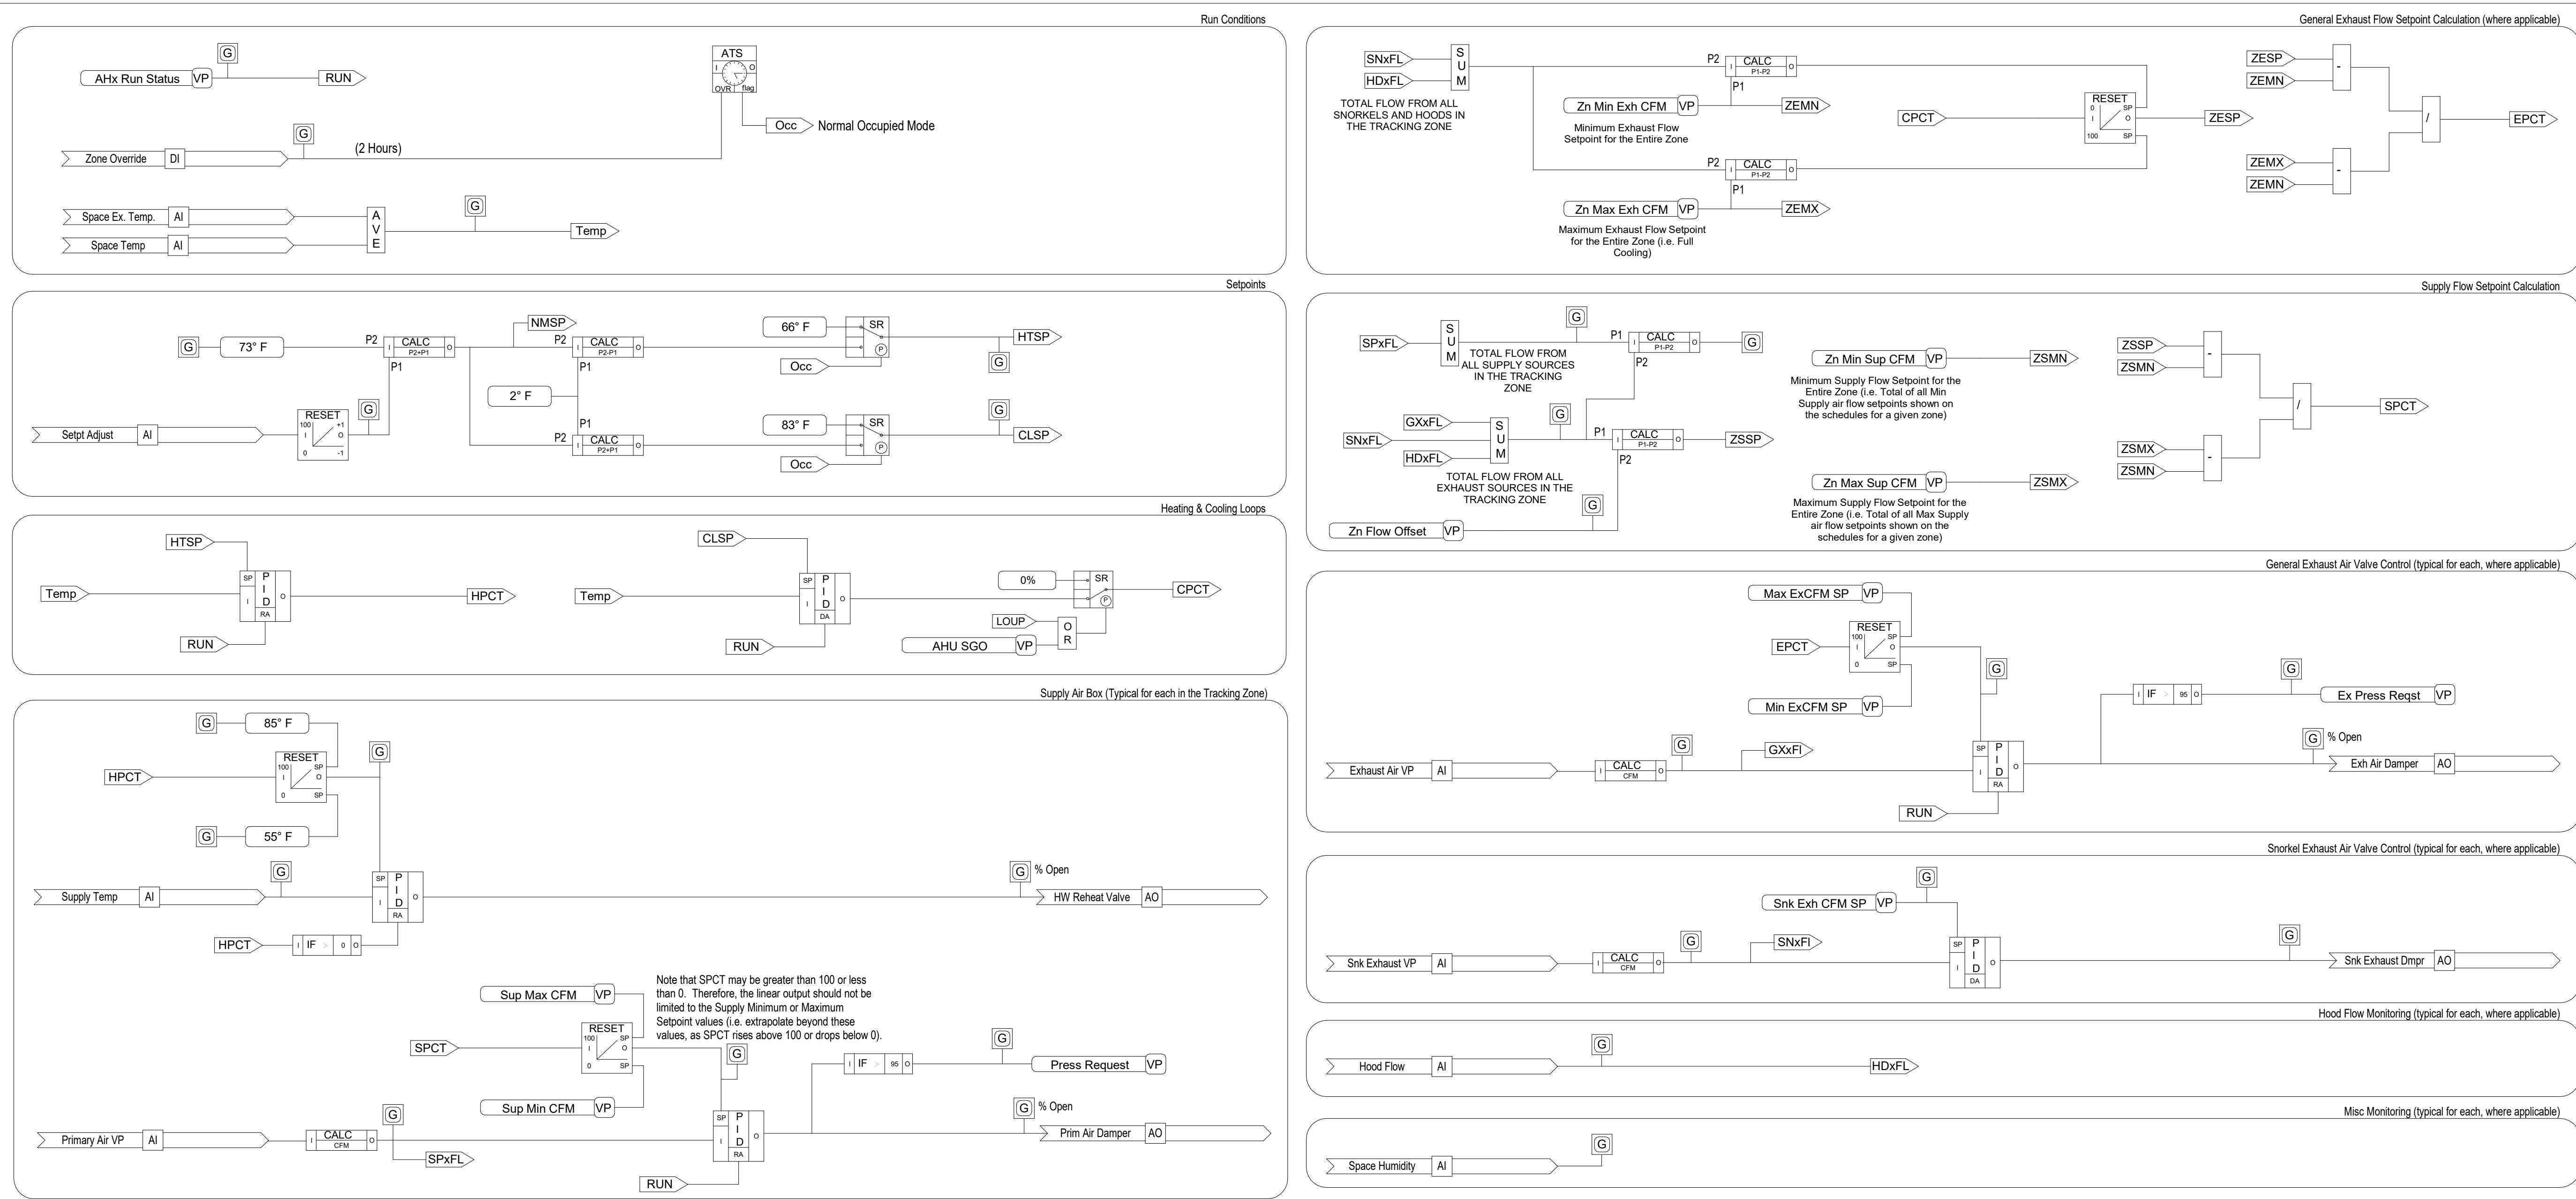



**NOTCH**  
NOTCH DESIGN, PLLC  
212 W MAIN ST, SUITE E,  
CARRBORO, NC  
www.notchdesign.com  
info@notchdesign.us



MCKIM&CREED  
www.mckimcreed.com  
4300 Edwards Mill Rd Suite 200  
Raleigh, NC 27612  
(919) 223-8091  
(919) 233-8031 Fax

NC License# F-1222

REVISION 1 ADDENDUM 1 1/7/26

## CONSTRUCTION SET



© 2024  
Notch Design

CLIENT NAME: THE UNIVERSITY OF NORTH CAROLINA AT CHAPEL HILL  
JOB NAME: UNC VENABLE HALL LOWER LEVEL UPTIT  
LOCATION: 101 South RD  
CHAPEL HILL, NC 27514

SCO ID: 24-28389-01A

**E001**

ELECTRICAL  
LEGEND SHEET

GENERAL	
#	DEMOLITION KEYED NOTE.
#	NEW WORK KEYED NOTE.
◆	REMOVE WIRING, CABLING, ETC. TO THIS POINT.
●	CONNECT WIRING, CABLING, ETC. TO THIS POINT.
X	FEEDER TAG - SEE FEEDER SCHEDULE
PR	PRESENT LIGHTING FIXTURE, SWITCH, DEVICE, ETC., TO REMAIN.
PRN	PRESENT LIGHTING FIXTURE, SWITCH, DEVICE, ETC., TO BE REMOVED AND REPLACED WITH NEW.
PRR	PRESENT LIGHTING FIXTURE, SWITCH, DEVICE, ETC., SHOWN AT NEW LOCATION
PRX	PRESENT LIGHTING FIXTURE, SWITCH, DEVICE, ETC., TO BE REMOVED AND OUTLET BOX EXTENSION INSTALLED FOR SURFACE CONDUIT OR SMR AND WIRE EXTENSION TO NEW OUTLET SHOWN. REINSTALL PRESENT LIGHTING FIXTURE, SWITCH, DEVICE, ETC.
RPC	REMOVE PRESENT FIXTURE, SWITCH, DEVICE, ETC., AND CAP OUTLET
RPP	REMOVE PRESENT FIXTURE, SWITCH, DEVICE, ETC., PATCH THE PLASTER IF IN PLASTER: CAP IF IN METAL OR WOOD.
RPR	REMOVE PRESENT FIXTURE, SWITCH, DEVICE, ETC., TO BE REMOVED AND RELOCATED.
RPX	REMOVE PRESENT FIXTURE, SWITCH, DEVICE, ETC., WIRE AND ALL RELATED EXPOSED RACEWAY INSOFAK AS IS POSSIBLE. ALL DAMAGED SURFACES TO BE REPAIRED.

LIGHTING FIXTURES	
	SURFACE, RECESSED, OR WALL MOUNTED LIGHTING FIXTURE. SEE LIGHTING FIXTURE KEY FOR TAG INFORMATION. SEE LIGHTING FIXTURE SCHEDULE FOR EXACT REQUIREMENTS.
	SURFACE, RECESSED, OR WALL MOUNTED LIGHTING FIXTURE CONNECTED TO EMERGENCY/LIFE SAFETY BRANCH CIRCUIT OR PROVIDE EMERGENCY DRIVER. SEE LIGHTING FIXTURE KEY FOR TAG INFORMATION. SEE LIGHTING FIXTURE SCHEDULE FOR EXACT REQUIREMENTS.
	SURFACE, RECESSED, OR WALL MOUNTED LIGHTING FIXTURE CONNECTED TO CRITICAL BRANCH CIRCUIT OR PROVIDE EMERGENCY DRIVER. SEE LIGHTING FIXTURE KEY FOR TAG INFORMATION. SEE LIGHTING FIXTURE SCHEDULE FOR EXACT REQUIREMENTS.
#	SURFACE MOUNTED TRACK LIGHTING SYSTEM. LETTER INDICATES TYPE. SEE LIGHTING FIXTURE KEY FOR TAG INFORMATION. SEE LIGHTING FIXTURE SCHEDULE FOR EXACT TRACK AND FIXTURE REQUIREMENTS.
#	MONO-POINT HEAD LIGHT FIXTURE. LETTER INDICATES TYPE. SEE LIGHTING FIXTURE KEY FOR TAG INFORMATION. SEE LIGHTING FIXTURE SCHEDULE FOR EXACT TRACK AND FIXTURE REQUIREMENTS.
	CEILING MOUNTED EXIT SIGN. SHADED AREA INDICATES FACE WITH DIRECTIONAL ARROWS AS SHOWN. SEE LIGHTING FIXTURE SCHEDULE FOR EXACT REQUIREMENTS. CONNECT UNSWITCHED TO INDICATED BRANCH CIRCUIT.
	WALL MOUNTED EXIT SIGN. SHADED AREA INDICATES FACE WITH DIRECTIONAL ARROWS AS SHOWN. SEE LIGHTING FIXTURE SCHEDULE FOR EXACT REQUIREMENTS. CONNECT UNSWITCHED TO INDICATED BRANCH CIRCUIT.
	POLE MOUNTED ROUND SITE LIGHTING FIXTURE. NUMBER OF HEADS AS SHOWN ON PLANS
	POLE MOUNTED SQUARE SITE LIGHTING FIXTURE. NUMBER OF HEADS AS SHOWN ON PLANS
	STRIP FIXTURE
	DOWNLIGHT FIXTURE
	WALL WASHER FIXTURE
	BOLLARD
	PENDANT LIGHT
	EMERGENCY BATTERY PACK UNIT WITH NUMBER OF LAMPS AS INDICATED WITH SELF DIAGNOSTICS. SEE LIGHTING FIXTURE SCHEDULE FOR EXACT REQUIREMENTS. CONNECT UNSWITCHED TO INDICATED BRANCH CIRCUIT.
	EMERGENCY REMOTE LIGHTING FIXTURE WITH SINGLE LAMP. LETTER (WHERE SHOWN) INDICATES TYPE. SEE LIGHTING FIXTURE SCHEDULE FOR EXACT REQUIREMENTS. CONNECT UNSWITCHED TO REMOTE BATTERY PACK. SEE PLANS.
	EMERGENCY REMOTE LIGHTING FIXTURE WITH DOUBLE LAMPS. LETTER (WHERE SHOWN) INDICATES TYPE. SEE LIGHTING FIXTURE SCHEDULE FOR EXACT REQUIREMENTS. CONNECT UNSWITCHED TO REMOTE BATTERY PACK. SEE PLANS.
<b>LIGHTING FIXTURE KEY</b> 	

LIGHTING CONTROLS		
WALL	CEILING	
		DUAL TECHNOLOGY OCCUPANCY SENSOR IN FLUSH (FINISHED SPACES) OR SURFACE (UNFINISHED SPACES) CEILING-MOUNTED OUTLET BOX. X- DENOTES CONTROL ZONE.
		DUAL TECHNOLOGY VACANCY SENSOR IN FLUSH (FINISHED SPACES) OR SURFACE (UNFINISHED SPACES) CEILING-MOUNTED OUTLET BOX. X- DENOTES CONTROL ZONE.
		DAYLIGHT SENSOR
		CLOSED LOOP LIGHTING PHOTOCELL. MOUNT PER MANUFACTURER'S REQUIREMENTS. X- DENOTES CONTROL ZONE.
		OPEN LOOP LIGHTING PHOTOCELL. MOUNT PER MANUFACTURER'S REQUIREMENTS. X- DENOTES CONTROL ZONE.
		SWITCH BYPASS DEVICE.
		LIGHTING CONTROL STATION - REFER TO KEY NOTES OR TYPE DETAIL FOR MORE INFORMATION # INDICATES TYPE NUMBER (1,2,3,...)
		LIGHTING OR SWITCHED RECEPTACLE ZONE MODULE.
		NORMAL POWER LIGHTING POWER PACK. SEE E200 FOR BASIS OF DESIGN.
		EMERGENCY POWER LIGHTING POWER PACK. SEE E200 FOR BASIS OF DESIGN
X		SINGLE-POLE SWITCH IN FLUSH (FINISHED SPACES) OR SURFACE (UNFINISHED SPACES) OUTLET BOX. X- DENOTES TYPE (MAY BE MULTIPLE):
a,b,c		SWITCH / CONTROL ZONE/GROUP
3		THREE WAY
4		FOUR WAY
D		DIMMER
OS		DUAL TECH OCCUPANCY SENSOR
OS2		DUAL TECH, DUAL CIRCUIT OCCUPANCY SENSOR
E		EMERGENCY (RED COLOR)
F		FAN
K		KEY OPERATED
LV		LOW VOLTAGE
LVD		LOW VOLTAGE DIMMER
MC		MOMENTARY CONTACT
M		MOTOR STARTER
P		PILOT LIGHT
T		TIMER SWITCH WITH VISUAL AND AUDIBLE OFF WARNING
VS		VACANCY SWITCH
VSD		VACANCY SWITCH DIMMER
W		WET LOCATION
WP		WEATHER PROOF COVER
X		EXPLOSION PROOF

DATA / COMMUNICATION - PATHWAYS & BOXES		
WALL	FLOOR	CEILING
		DATA OUTLET - 4" SQUARE BOX WITH SINGLE GANG DEVICE BRACKET FLUSH (FINISHED SPACES) OR SURFACE (UNFINISHED SPACES). MINIMUM 1" CONDUIT TO ABOVE ACCESSIBLE CEILING WITH PULL STRING. WIRING AND CABLING BY UNC-ITS.
		VOICE OUTLET - 4" SQUARE BOX WITH SINGLE GANG DEVICE BRACKET FLUSH (FINISHED SPACES) OR SURFACE (UNFINISHED SPACES). MINIMUM 1" CONDUIT TO ABOVE ACCESSIBLE CEILING WITH PULL STRING. WIRING AND CABLING BY UNC-ITS.
		VOICE/DATA OUTLET - 4" SQUARE BOX WITH SINGLE GANG DEVICE BRACKET FLUSH (FINISHED SPACES) OR SURFACE (UNFINISHED SPACES). MINIMUM 1" CONDUIT TO ABOVE ACCESSIBLE CEILING WITH PULL STRING. WIRING AND CABLING BY UNC-ITS.
		WIRELESS ACCESS POINT - SEE SHEET E502, OUTLET, CONDUITS AND SUPPORTS BY ELECTRICAL CONTRACTOR. WIRING AND CABLING BY UNC-ITS.
		TELEVISION CABLE OUTLET - 4" SQUARE BOX WITH SINGLE GANG DEVICE BRACKET FLUSH (FINISHED SPACES) OR SURFACE (UNFINISHED SPACES) OUTLET BOX. MINIMUM 1" CONDUIT TO ABOVE ACCESSIBLE CEILING WITH PULL STRING. WIRING AND CABLING BY UNC AV TEAM.
WALL	CEILING	
		COMMUNICATION SYSTEM SPEAKER. SUBSCRIPT, WHEN SHOWN, INDICATES ZONE.
AUDIO INPUT		
MICROPHONE		
		BASKET TRAY - (width) x (height) AS INDICATED. ELECTRICAL CONTRACTOR PROVIDES CONDUITS, JUNCTION BOXES, SUPPORTS AND BACK BOXES. WIRING AND CABLING FOR AV AND DATA IS BY UNC-ITS AND UNC AV.

ACCESS CONTROL - PATHWAY & BOXES		
ACB		FLUSH MOUNTED ACCESS CONTROL CARD READER MOUNTED 46-INCHES ABOVE FINISHED FLOOR UNLESS OTHERWISE INDICATED.
LCR		FLUSH MOUNTED ACCESS CONTROL CARD READER MOUNTED 46-INCHES ABOVE FINISHED FLOOR UNLESS OTHERWISE INDICATED.
KP		FLUSH MOUNTED ACCESS CONTROL KEY PAD MOUNTED 46-INCHES ABOVE FINISHED FLOOR UNLESS OTHERWISE INDICATED.
DR		DOOR RELEASE BUTTON. SUBSCRIPT, WHEN SHOWN, INDICATES ZONE.
HIS		INFRARED HAND SENSOR FOR HANDS FREE DOOR OPERATION. SUBSCRIPT, WHEN SHOWN, INDICATES ZONE.
		REQUEST TO EXIT
REX		ELECTRIC DOOR STRIKE
ES		MAG LOCK DEVICE - PROVIDE 120V TO THIS LOCATION.
ML		DOOR CONTACTS. SUBSCRIPT, WHEN SHOWN, INDICATES ZONE.
DC		PROVIDE POWER RACEWAYS. EMPTY 1" CONDUIT WITH PULL STRING AND BACK BOXES FOR TELECOM SECURITY AND AV DEVICES AND EQUIPMENT AS REQUIRED.

POWER EQUIPMENT		
		480/277 VOLT PANELBOARD, FLUSH AND SURFACE MOUNTED RESPECTIVELY. DESIGNATION AS INDICATED. REFER TO PANELBOARD SCHEDULES FOR EXACT REQUIREMENTS.
		208Y/120 OR 120/240 VOLT PANELBOARD, FLUSH AND SURFACE MOUNTED RESPECTIVELY. DESIGNATION AS INDICATED. REFER TO PANELBOARD SCHEDULES FOR EXACT REQUIREMENTS.
		EXISTING PANELBOARD, FLUSH AND SURFACE MOUNTED RESPECTIVELY. DESIGNATION AS INDICATED. REFER TO PANELBOARD SCHEDULES FOR EXACT REQUIREMENTS.
		ELECTRICAL POWER POLE, MOUNTING AND CONFIGURATION AS SPECIFIED.
		MOTOR CONNECTION. ELECTRICAL CONTRACTOR TO COORDINATE WITH MECHANICAL CONTRACTOR FOR FINAL CONNECTION.
		ENCLOSED CIRCUIT BREAKER. FRAME SIZE AND TRIP RATING AS INDICATED ON PLANS.
		MANUAL MOTOR STARTER. STARTER TYPE AND SIZE AS INDICATED ON PLANS.
		NON-FUSED DISCONNECT. FRAME SIZE AS INDICATED ON PLANS.
		FUSED DISCONNECT. FRAME SIZE AND TRIP RATING AS INDICATED ON PLANS. PROVIDE FUSES PER NAMEPLATE OF EQUIPMENT SERVED UNLESS OTHERWISE INDICATED.
		COMBINATION MOTOR STARTER & DISCONNECT. FRAME SIZE, TRIP RATING, AND STARTER SIZE AS INDICATED ON PLANS.
		SPECIAL EQUIPMENT CONNECTION. SEE KEYED NOTE OR EQUIPMENT CONNECTION SCHEDULE FOR EXACT REQUIREMENTS.

DISCONNECT SWITCH TAG KEY		
SIZE	NO. OF POLES	
	NEMA TYPE	
	FUSE SIZE OR NF	

VARIABLE FREQUENCY DRIVE - ELECTRICAL CONTRACTOR TO COORDINATE WITH MECHANICAL CONTRACTOR FOR FINAL CONNECTION.

AUTOMATIC TRANSFER SWITCH - SEE RISER DIAGRAM

TRANSFORMER - SEE RISER DIAGRAM

WIRING, RACEWAY, & GROUNDING		
		CONDUIT WITH BUSHING AND CAP
		CONDUIT TURNED UP
		CONDUIT TURNED DOWN
		CONDUIT CONTINUED
		SURFACE METAL RACEWAY, MOUNTING AND CONFIGURATION AS SPECIFIED.
		CONCEALED CONDUIT AND WIRING
		UNDER FLOOR OR UNDER GROUND CONDUIT AND WIRING
		GROUND CABLE
		GROUNDING TRIODE
		GROUNDING ROD
B1-3		WIRING HOMERUN - INDICATES CIRCUIT CONDUIT AND WIRE TO PANELBOARD SEE PANEL SCHEDULE

POWER DEVICE TAG KEY		

<tbl\_r cells="1" ix="1" maxcspan="3" maxrspan="1" used

## LUMINAIRE SCHEDULE

TYPE	MANUFACTURER	CATALOG NUMBER	LAMP DATA		DRIVER DATA		MOUNTING	INPUT WATTS	DESCRIPTION
			NO.	TYPE	NO.	TYPE			
A	LITHONIA EATON HUBBELL OR ENGINEER APPROVED EQUAL	LSIX-4FT-6000LM-80CRI-40K-BFR-SWL-MINI-ZT-MVOLT-MW	NA	LED 4000K	NA	DIMMING	RECESSED	51 WATTS	6"X4" LOW-PROFILE LINEAR RECESSED LED, MATTE WHITE FINISH, BEZEL FRAME, 80CRI+
AE	LITHONIA EATON HUBBELL OR ENGINEER APPROVED EQUAL	LSIX-4FT-6000LM-80CRI-40K-BFR-SWL-MINI-ZT-MVOLT-MW-E10WLCP	NA	LED 4000K	NA	DIMMING	RECESSED	51 WATTS	6"X4" LOW-PROFILE LINEAR RECESSED LED, MATTE WHITE FINISH, BEZEL FRAME, 80CRI+ EM SELF DIAGNOSTIC BATTERY PACK-10W
B	LITHONIA EATON HUBBELL OR ENGINEER APPROVED EQUAL	GRD-LSL-8FT-MSL4-80CRI-40K-ID1300LMF-20/80-MIN1-MVOLT-SCT-F1-24A-C110	NA	LED 4000K	NA	DIMMING	SUSPENDED	62 WATTS	4' DIRECT AND INDIRECT LINEAR PENDANT, PAINTED ALUMINUM (LOW GLOSS)
C	LITHONIA EATON HUBBELL OR ENGINEER APPROVED EQUAL	ZL1D-L48-3000LM-FST-MVOLT-40K-80CRI-HC36M12	NA	LED	NA		SUSPENDED	30 WATTS	4' INDUSTRIAL STRIP WITH CURVED REFLECTOR AND NARROW DISTRIBUTION, CONSTANT OUTPUT, PROVIDE WITH MOUNTING KIT AS NECESSARY
EX	LITHONIA EATON HUBBELL OR ENGINEER APPROVED EQUAL	LRP-1-RC-X-120/277	NA	LED	NA		SURFACE	2 WATTS	LED EDGE-LIT EXIT SIGN, BRUSHED ALUMINUM HOUSING, SINGLE FACE, RED ON CLEAR, NICKEL-CADMIUM BATTERY, SELF DIAGNOSTICS.

INTERIOR LIGHTING POWER (NEW)			
ROOM #	ROOM NAME	AVG. (FC)	IES RECOMMENDED AGV. (FC)
G301B	TEACHING LAB	71.6	50-75
G301C	TEACHING LAB	60.2	50-75
11M	STORAGE	10	10-20

INTERIOR LIGHTING POWER (NEW)			
LUMINAIRE TYPE	WATTS(W)	QTY	TOTAL WATTS(W)
A	51	31	1581
B1	31	1	31
B2	62	5	310
D	15	8	120
			2042 (TOTAL)

INTERIOR LIGHTING POWER ALLOWANCE PER NCECC 405.4.2			
SPACE NAME	AREA(SQFT)	WATTS/SQFT	TOTAL WATTS ALLOWED(W)
TEACHING LAB G301B	1554.72	1.43	2223.2
TEACHING LAB G301C	1556.9	1.43	2226.4
STORAGE 11M	63.02	0.63	39.7
	4489.3		x 0.9 4040.4 (W)
			(*) (ALLOWED)

Note (\*): 0.9 IS PER NCECC 406.3.2 REDUCE LIGHTING POWER DENSITY BASED ON AREA BEING REFLECTED

## 2018 APPENDIX B BUILDING CODE SUMMARY FOR ALL COMMERCIAL PROJECTS

ELECTRICAL DESIGN  
(PROVIDE ON THE ELECTRICAL SHEETS IF APPLICABLE)

### ELECTRICAL SUMMARY

#### ELECTRICAL SYSTEM AND EQUIPMENT

Method of Compliance: Energy Code:  Prescriptive  Performance  
ASHRAE 90.1:  Prescriptive  Performance

#### Lighting schedule (each fixture type)

lamp type required in fixture SEE LUMINAIRE SCHEDULE  
number of lamps in fixture SEE LUMINAIRE SCHEDULE  
ballast type used in the fixture SEE LUMINAIRE SCHEDULE  
number of ballasts in fixture SEE LUMINAIRE SCHEDULE  
total wattage per fixture SEE LUMINAIRE SCHEDULE  
total interior wattage specified vs. allowed (whole building or space by space) 2042W VS. 4040W  
total exterior wattage specified vs. allowed N/A

#### Additional Efficiency Package Options (When using the 2018 NCECC; not required for ASHRAE 90.1)

C406.2 More Efficient Mechanical Equipment  
 C406.3 Reduced Lighting Power Density  
 C406.4 Enhanced Digital Lighting Controls  
 C406.5 On-Site Renewable Energy  
 C406.6 Dedicated Outdoor Air System  
 C406.7 Reduced Energy Use in Service Water Heating

### GENERAL NOTES

- ALL ELECTRICAL WORK SHALL BE IN ACCORD WITH ALL APPLICABLE ORDINANCES, CODES AND REGULATIONS OF ALL AUTHORITIES HAVING JURISDICTION. ALL ELECTRICAL WORK SHALL BE INSPECTED AND APPROVED BY THE LOCAL ELECTRICAL INSPECTION AGENCY MONDAY THRU FRIDAY DURING NORMAL BUSINESS HOURS. THE ELECTRICAL CONTRACTOR SHALL PROVIDE ALL NECESSARY FEES AND PERMITS, INCLUDING THE CERTIFICATE OF ELECTRICAL INSPECTION.
- THE ELECTRICAL CONTRACTOR SHALL BE RESPONSIBLE FOR CONSTRUCTION SAFETY. ARCHITECT AND/OR ENGINEER SHALL ASSUME NO RESPONSIBILITY FOR WORKMANS, OR PEDESTRIAN'S SAFETY. NOTHING IN THE CONTRACT DOCUMENTS SHALL BE CONSTRUED TO INSTRUCT PROCEDURES OR COMPONENTS FOR PROJECT SAFETY.
- WHERE A CONFLICT ARISES BETWEEN PLANS, SPECIFICATIONS, DETAILS, SCHEDULES, APPLICABLE CODES OR REGULATIONS, THE MOST STRINGENT SHALL APPLY.
- NOTHING CONTAINED IN THE CONTRACT DOCUMENTS SHALL BE CONSTRUED TO CONFLICT WITH ANY NATIONAL, STATE, MUNICIPAL, OR LOCAL LAWS OR REGULATIONS GOVERNING THE WORK INDICATED OR SPECIFIED. THE ELECTRICAL CONTRACTOR AT NO ADDITIONAL EXPENSE TO THE OWNER SHALL SATISFY ALL SUCH REQUIREMENTS.
- THE CONTRACT DOCUMENTS ARE COMPRISED OF DRAWINGS AND SPECIFICATIONS. EACH ELECTRICAL BIDDER SHALL VISIT SITE TO DETERMINE EXISTING CONDITIONS PRIOR TO SUBMITTING BID. PROPOSAL BIDS SHALL BE BASED ON THE COMPLETE EXAMINATION OF THE DRAWINGS, SPECIFICATIONS AND EXISTING CONDITIONS. NO CONSIDERATION WILL BE GIVEN TO ANY CONTRACTOR WHO FAILS TO DO SO.
- THE WORK UNDER THIS CONTRACT SHALL INCLUDE THE FURNISHING OF ALL NECESSARY MATERIALS, TOOLS, LABOR FOR A COMPLETE AND WORKING INSTALLATION AS DEFINED BY THE PLANS AND SPECIFICATIONS. THE ELECTRICAL CONTRACTOR SHALL WARRANT THE WORK INDICATED AND SPECIFIED FOR A PERIOD OF ONE YEAR. THE WORK SHALL FUNCTION AS INTENDED, BE COMPLETE IN ALL DETAILS, AND SHALL INCLUDE ALL INDICATED, SPECIFIED, OR REQUIRED ACCESSORIES FOR A FUNCTIONING SYSTEM.
- THE ELECTRICAL CONTRACTOR SHALL PROVIDE TEMPORARY LIGHT AND POWER AS REQUIRED BY THE GENERAL CONDITIONS OF THE SPECIFICATION.
- THE ELECTRICAL CONTRACTOR SHALL COORDINATE HIS WORK WITH ALL OTHER TRADES. ALL DEVICES PROVIDED BY OTHERS THAT REQUIRE LINE VOLTAGE ELECTRICAL POWER SHALL BE CONNECTED BY THE ELECTRICAL CONTRACTOR. POWER, PHONE, DATA, TV, AND SIMILAR DEVICE OUTLET LOCATIONS SHALL BE COORDINATED WITH THE ARCHITECTURAL INTERIOR LAYOUTS, THE GENERAL CONTRACTOR, AND THE OWNER.
- THE ELECTRICAL CONTRACTOR SHALL COORDINATE WITH OWNERS PROJECT MANAGER PRIOR TO AND FOR SCHEDULING ANY INTERRUPTION OF ANY BUILDING UTILITY.
- THE ELECTRICAL CONTRACTOR SHALL COORDINATE WITH THE LOCAL UTILITIES AND ARRANGE FOR THE FOLLOWING SERVICES: ELECTRICAL, POWER, CABLE TV, AND TELEPHONE SERVICE. THE ELECTRICAL CONTRACTOR SHALL MEET WITH THE REPRESENTATIVES OF THE ELECTRICAL UTILITY & TELECOMM UTILITY TO CONFIRM DETAILS ON THE SERVICE AND METERING. THE ELECTRICAL CONTRACTOR SHALL PAY ALL NECESSARY COSTS, FEES, AND PERMITS INVOLVED IN BRINGING SERVICE TO THE BUILDING.
- ALL HOMERUNS WITH MORE THAN SIX (6) TOTAL CONDUCTORS SHALL BE A MINIMUM OF NO. 10 THHN WIRE UNLESS SPECIFICALLY SIZED OTHERWISE.
- ALL WORK SHOWN ON THE ELECTRICAL DRAWINGS SHALL BE BY THE ELECTRICAL CONTRACTOR UNLESS SPECIFICALLY NOTED OTHERWISE.
- CONTRACTOR SHALL REMOVE DEMOLITION DEBRIS COMPLETELY. CONTRACTOR SHALL SCHEDULE WITH THE OWNER THE TIME, LOCATION, ELEVATOR AND HAULING ROUTE.
- CONTRACTOR SHALL CLEAN UP ALL DEBRIS AT THE END OF EACH WORK DAY.
- THE ELECTRICAL CONTRACTOR SHALL FURNISH SUBMITTALS IN ACCORDANCE WITH THE SPECIFICATIONS. ALL SUBMITTALS SHALL BE REVIEWED AND STAMPED BY THE ENGINEER PRIOR TO INSTALLATION.
- THE ELECTRICAL CONTRACTOR SHALL PROVIDE AS-BUILT DRAWINGS FOR THE ENTIRE PROJECT AS DEFINED IN THE SPECIFICATIONS.
- THIS CONTRACTOR SHALL VISIT THE SITE AND FULLY INFORM HIMSELF OF ALL THE EXISTING CONDITIONS, WHICH IN ANY WAY WILL AFFECT THE EXECUTION OF HIS WORK AND THE REQUIREMENTS OF THIS CONTRACT AS SHOWN OR REASONABLY INFERRED ON THE DRAWINGS AND PRODUCT SPECIFICATIONS.

ELECTRICAL ABBREVIATIONS	
ABBREVIATION	DESCRIPTION
A/AMP	AMPERE
ACFI	ARC FAULT INTERRUPTER
AFF	ABOVE FINISHED FLOOR
AGF	ABOVE FINISHED GRADE
AHJ	AUTHORITY HAVING JURISDICTION
AL	ALUMINUM
ANSI	AMERICAN NATIONAL STANDARDS INSTITUTE
ASA	AMERICAN STANDARDS ASSOCIATION
ASTM	AMER. SOCIETY OF TESTING MATERIALS
AWG	AMERICAN WIRE GAUGE
AT	AMPERE TRIP
ATS	AUTOMATIC TRANSFER SWITCH
BL	BLANK
BKR	BREAKER
C	CONDUT
CB, C/B	CIRCUIT BREAKER
CKT	CIRCUIT
CCTV	CLOSED CIRCUIT TV
CLG	CEILING
CO	CONVENIENCE OUTLET
CONN	CONNECTION
CU	COPPER
DB	DIRECT BURIAL
DISC	DISCONNECT
DN	DOWN
DWG	DRAWING
EA	EACH
E.C.	ELECTRICAL CONTRACTOR
EF	EXHAUST FAN
EH	ELECTRIC HEAT
EIA	ELECTRONIC INDUSTRIES ASSOC.
EMT	ELECTRIC METALLIC TUBING
XP	EXPLOSION PROOF
E. EM	EMERGENCY
ELEC	ELECTRIC
EMT	ELECTRIC METALLIC TUBING
EQ/EQPM	EQUIPMENT
EUH	ELECTRIC UNIT HEATER
EWC	ELECTRIC WATER COOLER
EX	EXISTING
F	EXISTING
FA	FIRE ALARM
FAAP	FIRE ALARM ANNUNCIATOR PANEL
FACP	FIRE ALARM CONTROL PANEL
FCU	FAN COIL UNIT
FDR	FEEDER
FIXT	FIXTURE
FL	FLOOR
FLUOR	FLUORESCENT
FSS	FUSED SAFETY SWITCH
FT	FEET
G, GND, GRD	GROUND
GC	GENERAL CONTRACTOR
GEN	GENERATOR
GFI	GROUND FAULT INTERRUPTER
GTB	GROUND TERMINAL BOX
HID	HIGH INTENSITY DISCHARGE
HP	HORSE POWER
HPF	HIGH POWER FACTOR
HR	HOMERUN
HTR	HEATER
HVAC	HEATING, VENTILATION, AIR CONDITIONING CONTRACTOR
HV	HIGH VOLTAGE
Hz	HERTZ
ICEA	INTERNATIONAL CABLE ENGR. ASSOC.
IEEE	INSTITUTE OF ELECTRICAL AND ELECTRONIC ENGINEERS
IES	ILLUMINATING ENGINEERING SOCIETY
IN	INCH
IR	INFRARED
JBL/BOX	JUNCTION BOX
K	THOUSAND
KVA	KILOVOLT-AMPERE
KW	KILOWATT
KWH	KILOWATT HOUR
LA	LIGHTING ARRESTER
LCP	LIGHTING CONTROL PANEL
LED	LIGHT EMITTING DIODE
LTS	LIGHTS
LTG	LIGHTING
LV	LOW VOLTAGE
M.C.	Mechanical CONTRACTOR
MCB	MAIN CIRCUIT BREAKER
MCC	MOTOR CONTROL CENTER
MDP	MAIN DISTRIBUTION PANEL
MFR	MANUFACTURER
MH	MANHOLE
MLO	MAL LUGS ONLY
MISC	MISCELLANEOUS
MTD	MOUNDED
MTG HGT	MOUNTING HEIGHT
MTR	MOTOR
N/A	NOT APPLICABLE
NC	NORMALLY CLOSED
NF	ON-FUSED SAFETY SWITCH
NEC	NATIONAL ELECTRIC CODE
NEMA	NATIONAL ELECTRICAL MANUFACTURERS ASSOCIATION
P	POLE
PBOX	PULL BOX
PC	PHOTOCELL
P.C.	PLUMBING CONTRACTOR
PH / Ø	PHASE
PNL	PANEL
POS	POSITION
PRI	PRIMARY
PWR	POWER
REC / RECP	RECEPTACLE
RGS	RIGID GALVANIZED STEEL
RMC	RIGID GALVANIZED METAL CONDUIT
RT	RAIN TIGHT
SCHED	SCHEDULE
SEC	SECONDARY
SIG	SIGNAL
SM	SURFACE MOUNTED
SMR	SURFACE MOUNTED RACEWAY
SPARE	SPARE
SS	SAFETY SWITCH
SW	SWITCHBOARD
SWBD	TELEPHONE
TEL / TELE	TWIST LOCK
TP	TAMPER PROOF
TX / XFMR	TRANSFORMER
TTB	TELEPHONE TERMINAL BOARD
TV	TELEVISION
TYP	TYPICAL
UH	UNIT HEATER
UL	UNDERWRITERS' LABORATORIES, INC
UNO	UNLESS NOTED OTHERWISE



**NOTCH**  
NOTCH DESIGN, PLLC  
212 W MAIN ST, SUITE E,  
CARRBORO, NC  
www.notchdesign.com  
info@notchdesign.us

MCKIM & CREED  
www.mckimcreed.com  
4300 Edwards Mill Rd Suite 200  
Raleigh, NC 27612  
(919) 223-8091  
(919) 233-8031 Fax  
NC License# F-1222

REVISION 1 ADDENDUM 1 1/7/26

## CONSTRUCTION SET



© 2024  
Notch Design

CLIENT NAME: THE UNIVERSITY OF NORTH CAROLINA AT CHAPEL HILL  
JOB NAME: UNC VENABLE HALL LOWER LEVEL UPLIFT  
LOCATION: 101 South RD  
CHAPEL HILL, NC 27514

SCO ID: 24-28389-01A

### DEMOLITION GENERAL NOTES


- EXISTING CIRCUIT NUMBERING IN FIELD IS INCONSISTENT BETWEEN DEVICE LABELING, SCHEDULE IN PANEL DOOR, AND RECORD DRAWINGS THEREFORE THE LABELING ON THE FLOOR PLANS SHALL BE CONFIRMED BY EC. CONTRACTOR SHALL TRACE CIRCUITS UTILIZING CIRCUIT TRACERS FOR ALL CIRCUITS IN THE AREA OF WORK. CONTRACTOR SHALL DOCUMENT EXISTING CIRCUITING IN PREPARATION FOR DEMOLITION WORK AND TO FACILITATE NEW WORK INCLUDING UPDATED LABELING AS REQUIRED PER THE SPECIFICATIONS.
- ALL PENETRATIONS OF EXISTING FLOORS AND FIRE RATED WALL OR SMOKE PARTITIONS SHALL BE PATCHED & REPAIRED AS REQUIRED TO MAINTAIN THE EXISTING FIRE RATING OR SMOKE INFILTRATION INTEGRITY OF THE WALL. ALL SLEEVES, WIREWAYS, CABLE TRAYS, PIPES, DUCTWORK, ETC. SHALL BE FIRE SEALED TIGHT TO THE WALL OR FLOOR PENETRATIONS TO MAINTAIN THE REQUIRED CODE COMPLIANT FIRE RATING.
- ELECTRICAL CONTRACTOR SHALL FIELD VERIFY AND COORDINATE ALL EXISTING CONDITIONS, LOCATIONS, AND CIRCUITING OF ALL EXISTING ELECTRICAL EQUIPMENT LOCATED IN THE AREAS OF CONSTRUCTION INCLUDING EQUIPMENT LOCATED IN ADJACENT AREAS SERVED BY THE CIRCUITING LOCATED IN THESE SPACES.
- DEMOLITION WORK SHALL BE COMPLETED IN FULL. ALL CONDUIT AND WIRING SHALL BE DEMOLISHED BACK TO SOURCE UNLESS OTHERWISE NOTED. PANELS SCHEDULES SHALL BE UPDATED WHERE APPLICABLE. NO RACEWAY SHALL BE ABANDONED IN PLACE UNLESS SPECIFICALLY NOTED ON DRAWINGS.
- IN AREAS OF REMOVAL OF WALL AND CEILING MOUNTED DEVICES, CONTRACTOR SHALL REPAIR, PATCH AND CLEAN WALLS, WALL BASES, AND CEILING AS REQUIRED TO MATCH EXISTING FINISHES.
- CONTRACTOR SHALL MAINTAIN ALL CIRCUITS RUNNING THROUGH THE AREA OF DEMOLITION AND THE AREA OF NEW CONSTRUCTION.

### DEMOLITION KEY NOTES

- DEMOLISH EXISTING RECEPTACLES (HATCHED) AND ASSOCIATED HIRING, RACEWAY, BOXES, AND SUPPORTS COMPLETELY BACK TO SOURCE OR TO FIRST JUNCTION BOX SERVING EXISTING CIRCUITING TO REMAIN EXISTING CIRCUIT SOURCE AND NUMBER SHALL BE CONFIRMED AND NOTED ON AS-BUILT DRAWINGS PRIOR TO ANY DEMO WORK.
- DEMOLISH EXISTING DATA OUTLETS (HATCHED) AND ASSOCIATED CABLING, RACEWAY, BOXES, AND SUPPORTS COMPLETELY BACK TO SOURCE. COORDINATE WITH UNC-ITS PRIOR TO WORK.
- EXISTING CEILING MOUNTED WIRELESS ACCESS POINT SHALL BE DISCONNECTED AND SALVAGED TO BE INSTALLED IN NEW LOCATION. COORDINATE WITH UNC-ITS PRIOR TO WORK.
- DEMOLISH EXISTING CONNECTIONS TO MECHANICAL EQUIPMENT AND ASSOCIATED WIRING, RACEWAY, BOXES, AND SUPPORTS COMPLETELY BACK TO SOURCE.

1 GROUND FLOOR DEMO PLAN - POWER AND SPECIAL SYSTEMS

SCALE: 1/8" = 1'-0"

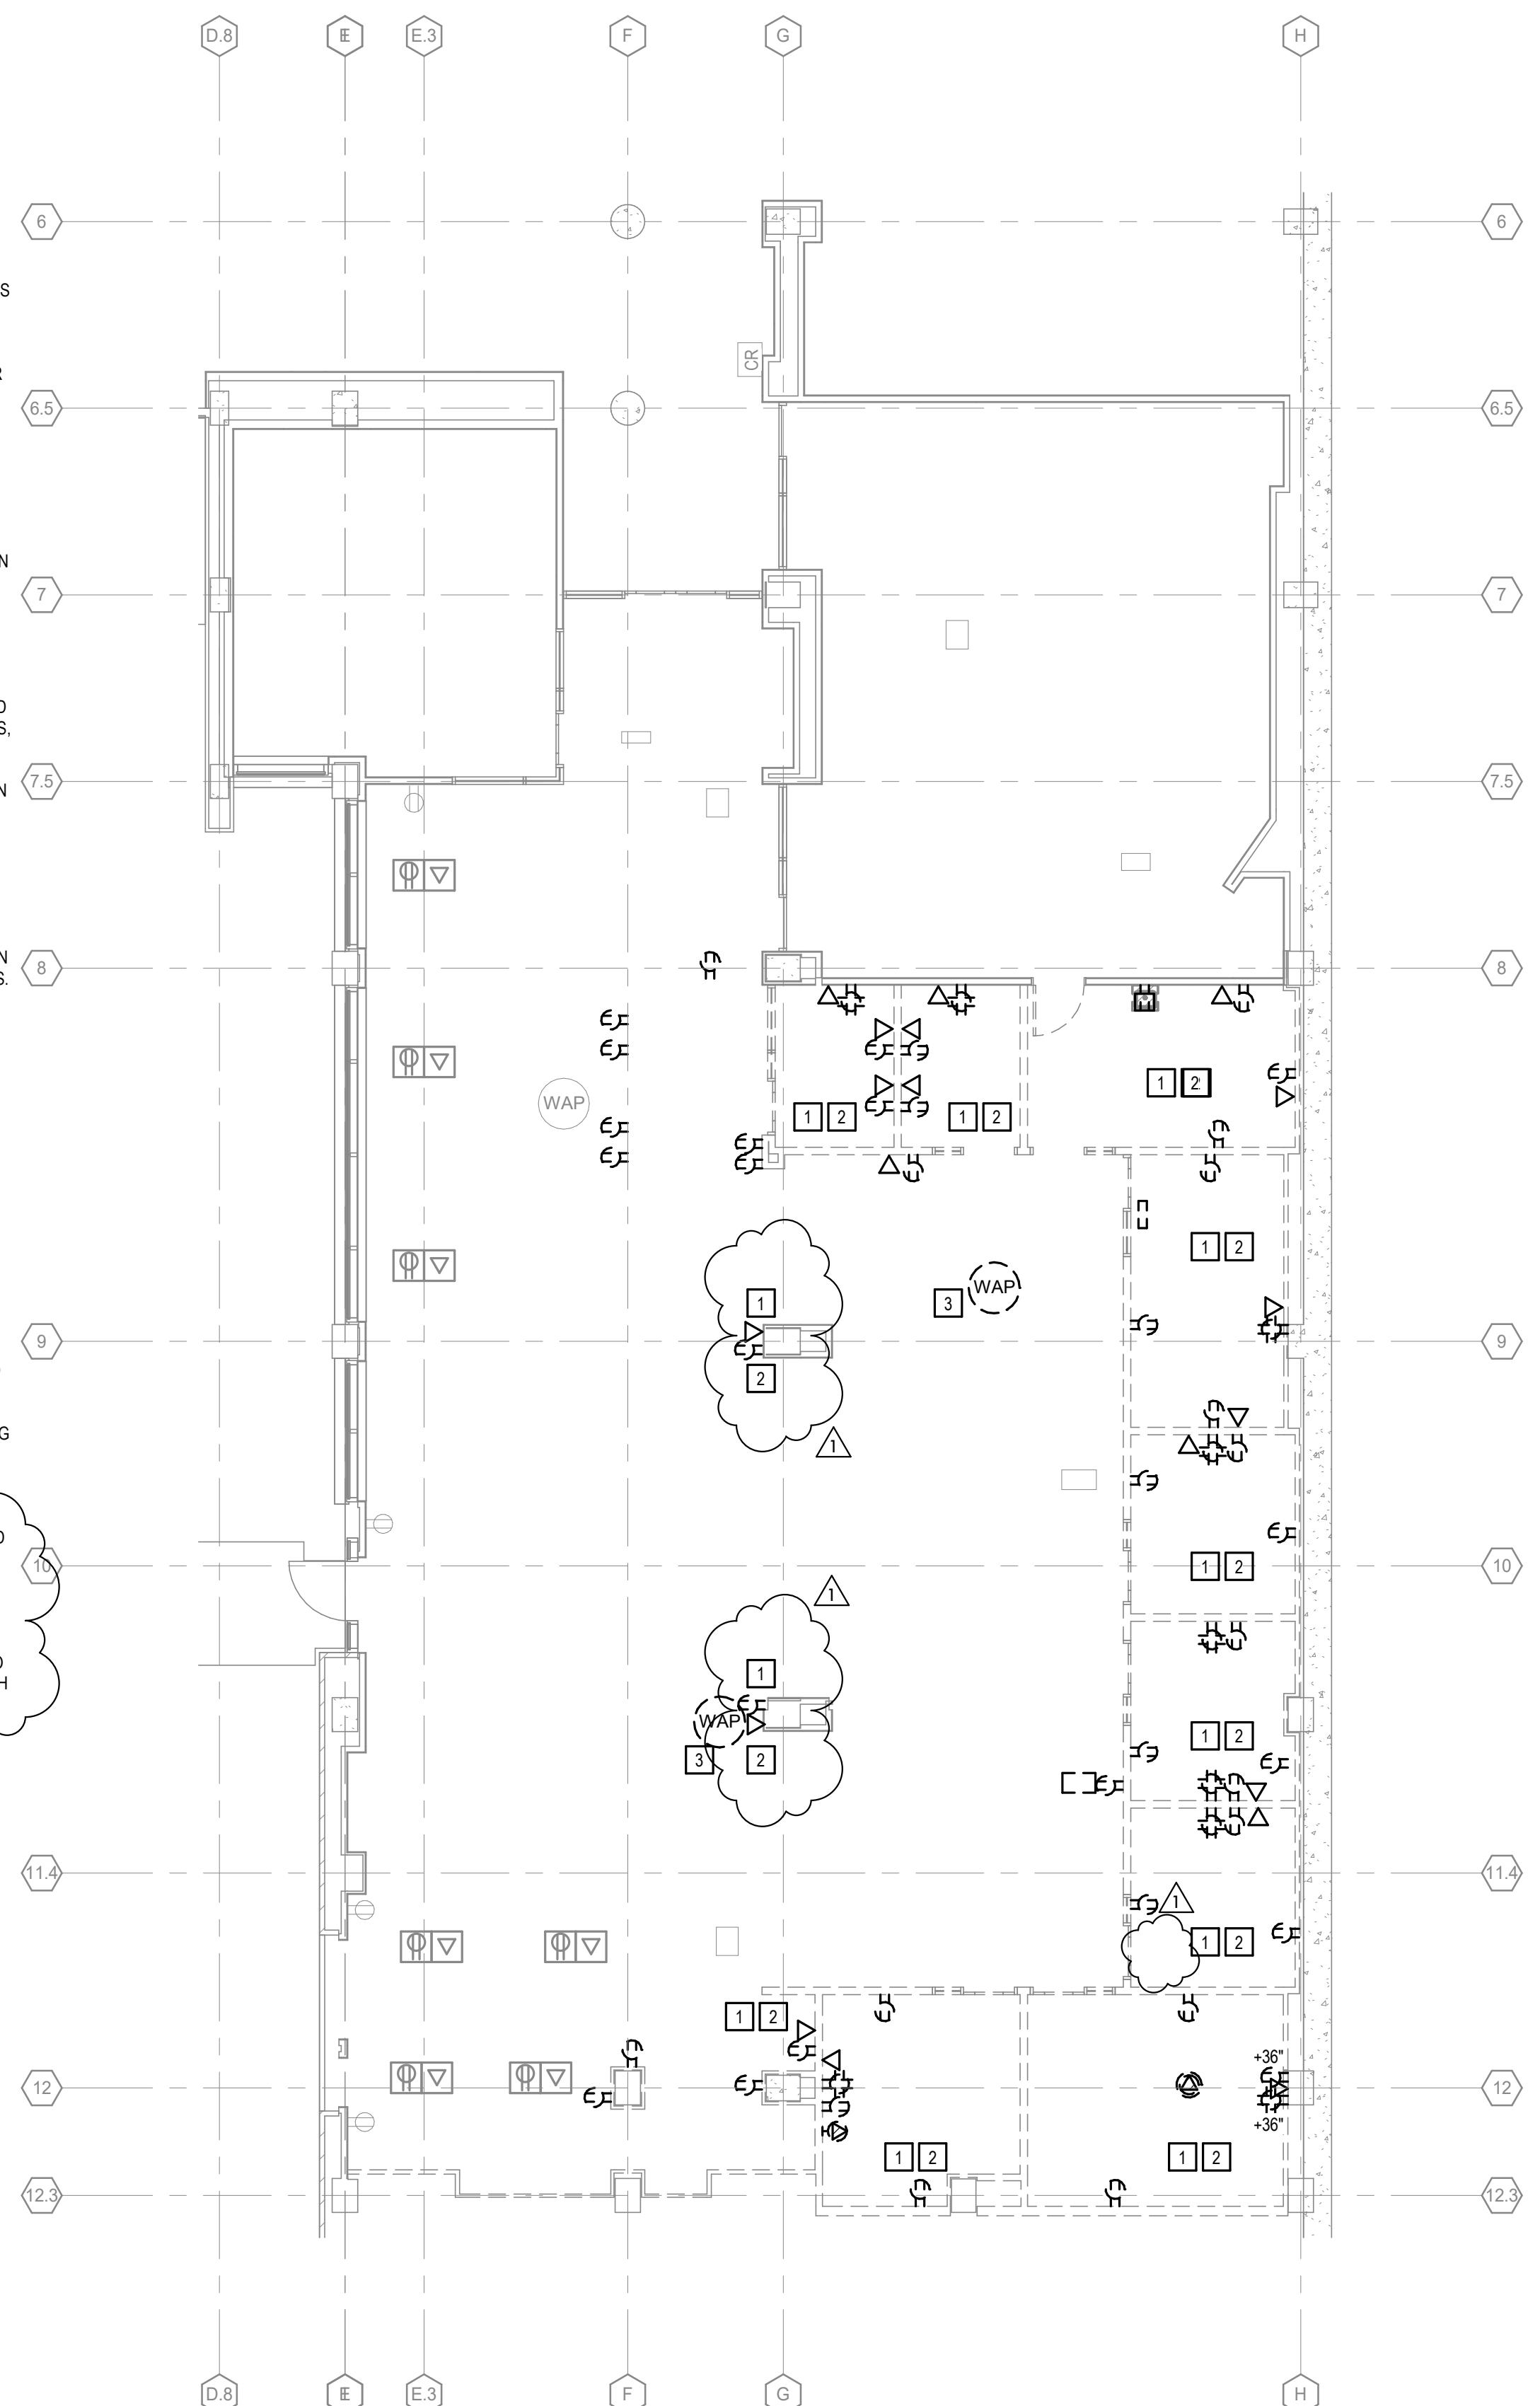

### DEMOLITION GENERAL NOTES


- EXISTING CIRCUIT NUMBERING IN FIELD IS INCONSISTENT BETWEEN DEVICE LABELING, SCHEDULE IN PANEL DOOR, AND RECORD DRAWINGS THEREFORE THE LABELING ON THE FLOOR PLANS SHALL BE CONFIRMED BY EC. CONTRACTOR SHALL TRACE CIRCUITS UTILIZING CIRCUIT TRACERS FOR ALL CIRCUITS IN THE AREA OF WORK. CONTRACTOR SHALL DOCUMENT EXISTING CIRCUITING IN PREPARATION FOR DEMOLITION WORK AND TO FACILITATE NEW WORK INCLUDING UPDATED LABELING AS REQUIRED PER THE SPECIFICATIONS.
- ALL PENETRATIONS OF EXISTING FLOORS AND FIRE RATED WALL OR SMOKE PARTITIONS SHALL BE PATCHED & REPAIRED AS REQUIRED TO MAINTAIN THE EXISTING FIRE RATING OR SMOKE INFILTRATION INTEGRITY OF THE WALL. ALL SLEEVES, WIREWAYS, CABLE TRAYS, PIPES, DUCTWORK, ETC. SHALL BE FIRE SEALED TIGHT TO THE WALL OR FLOOR PENETRATIONS TO MAINTAIN THE REQUIRED CODE COMPLIANT FIRE RATING.
- ELECTRICAL CONTRACTOR SHALL FIELD VERIFY AND COORDINATE ALL EXISTING CONDITIONS, LOCATIONS, AND CIRCUITING OF ALL EXISTING ELECTRICAL EQUIPMENT LOCATED IN THE AREAS OF CONSTRUCTION INCLUDING EQUIPMENT LOCATED IN ADJACENT AREAS SERVED BY THE CIRCUITING LOCATED IN THESE SPACES.
- DEMOLITION WORK SHALL BE COMPLETED IN FULL. ALL CONDUIT AND WIRING SHALL BE DEMOLISHED BACK TO SOURCE UNLESS OTHERWISE NOTED. PANELS SCHEDULES SHALL BE UPDATED WHERE APPLICABLE. NO RACEWAY SHALL BE ABANDONED IN PLACE UNLESS SPECIFICALLY NOTED ON DRAWINGS.
- IN AREAS OF REMOVAL OF WALL AND CEILING MOUNTED DEVICES, CONTRACTOR SHALL REPAIR, PATCH AND CLEAN WALLS, WALL BASES, AND CEILING AS REQUIRED TO MATCH EXISTING FINISHES.
- CONTRACTOR SHALL MAINTAIN ALL CIRCUITS RUNNING THROUGH THE AREA OF DEMOLITION AND THE AREA OF NEW CONSTRUCTION.

### DEMOLITION KEY NOTES

- DEMOLISH EXISTING LUMINARIES SHOWN (WITH SUPPORTS) AND ASSOCIATED CONTROLS IN HATCH. CONTRACTOR SHALL REMOVE CONDUIT AND WIRING BACK TO THE LAST JUNCTION BOX SERVING EXISTING LUMINARIES TO REMOVE LINESIDE CIRCUITING WHICH SHALL REMAIN AND BE MADE READY FOR RE-CONNECT. THE DISPOSAL OF FLUORESCENT LAMPS, BALLASTS, AND OTHER MERCURY CONTAINING DEVICES MUST COMPLY WITH NC GENERAL STATUTES G.S. 130A-310.60 WHICH APPLY TO ALL STATE AND LOCAL AGENCIES MANAGING DISCARDED MERCURY CONTAINING DEVICES, INCLUSIVE OF THOSE GENERATED THROUGH CONSTRUCTION/RENOVATION.

2 GROUND FLOOR DEMO PLAN - LIGHTING

SCALE: 1/8" = 1'-0"

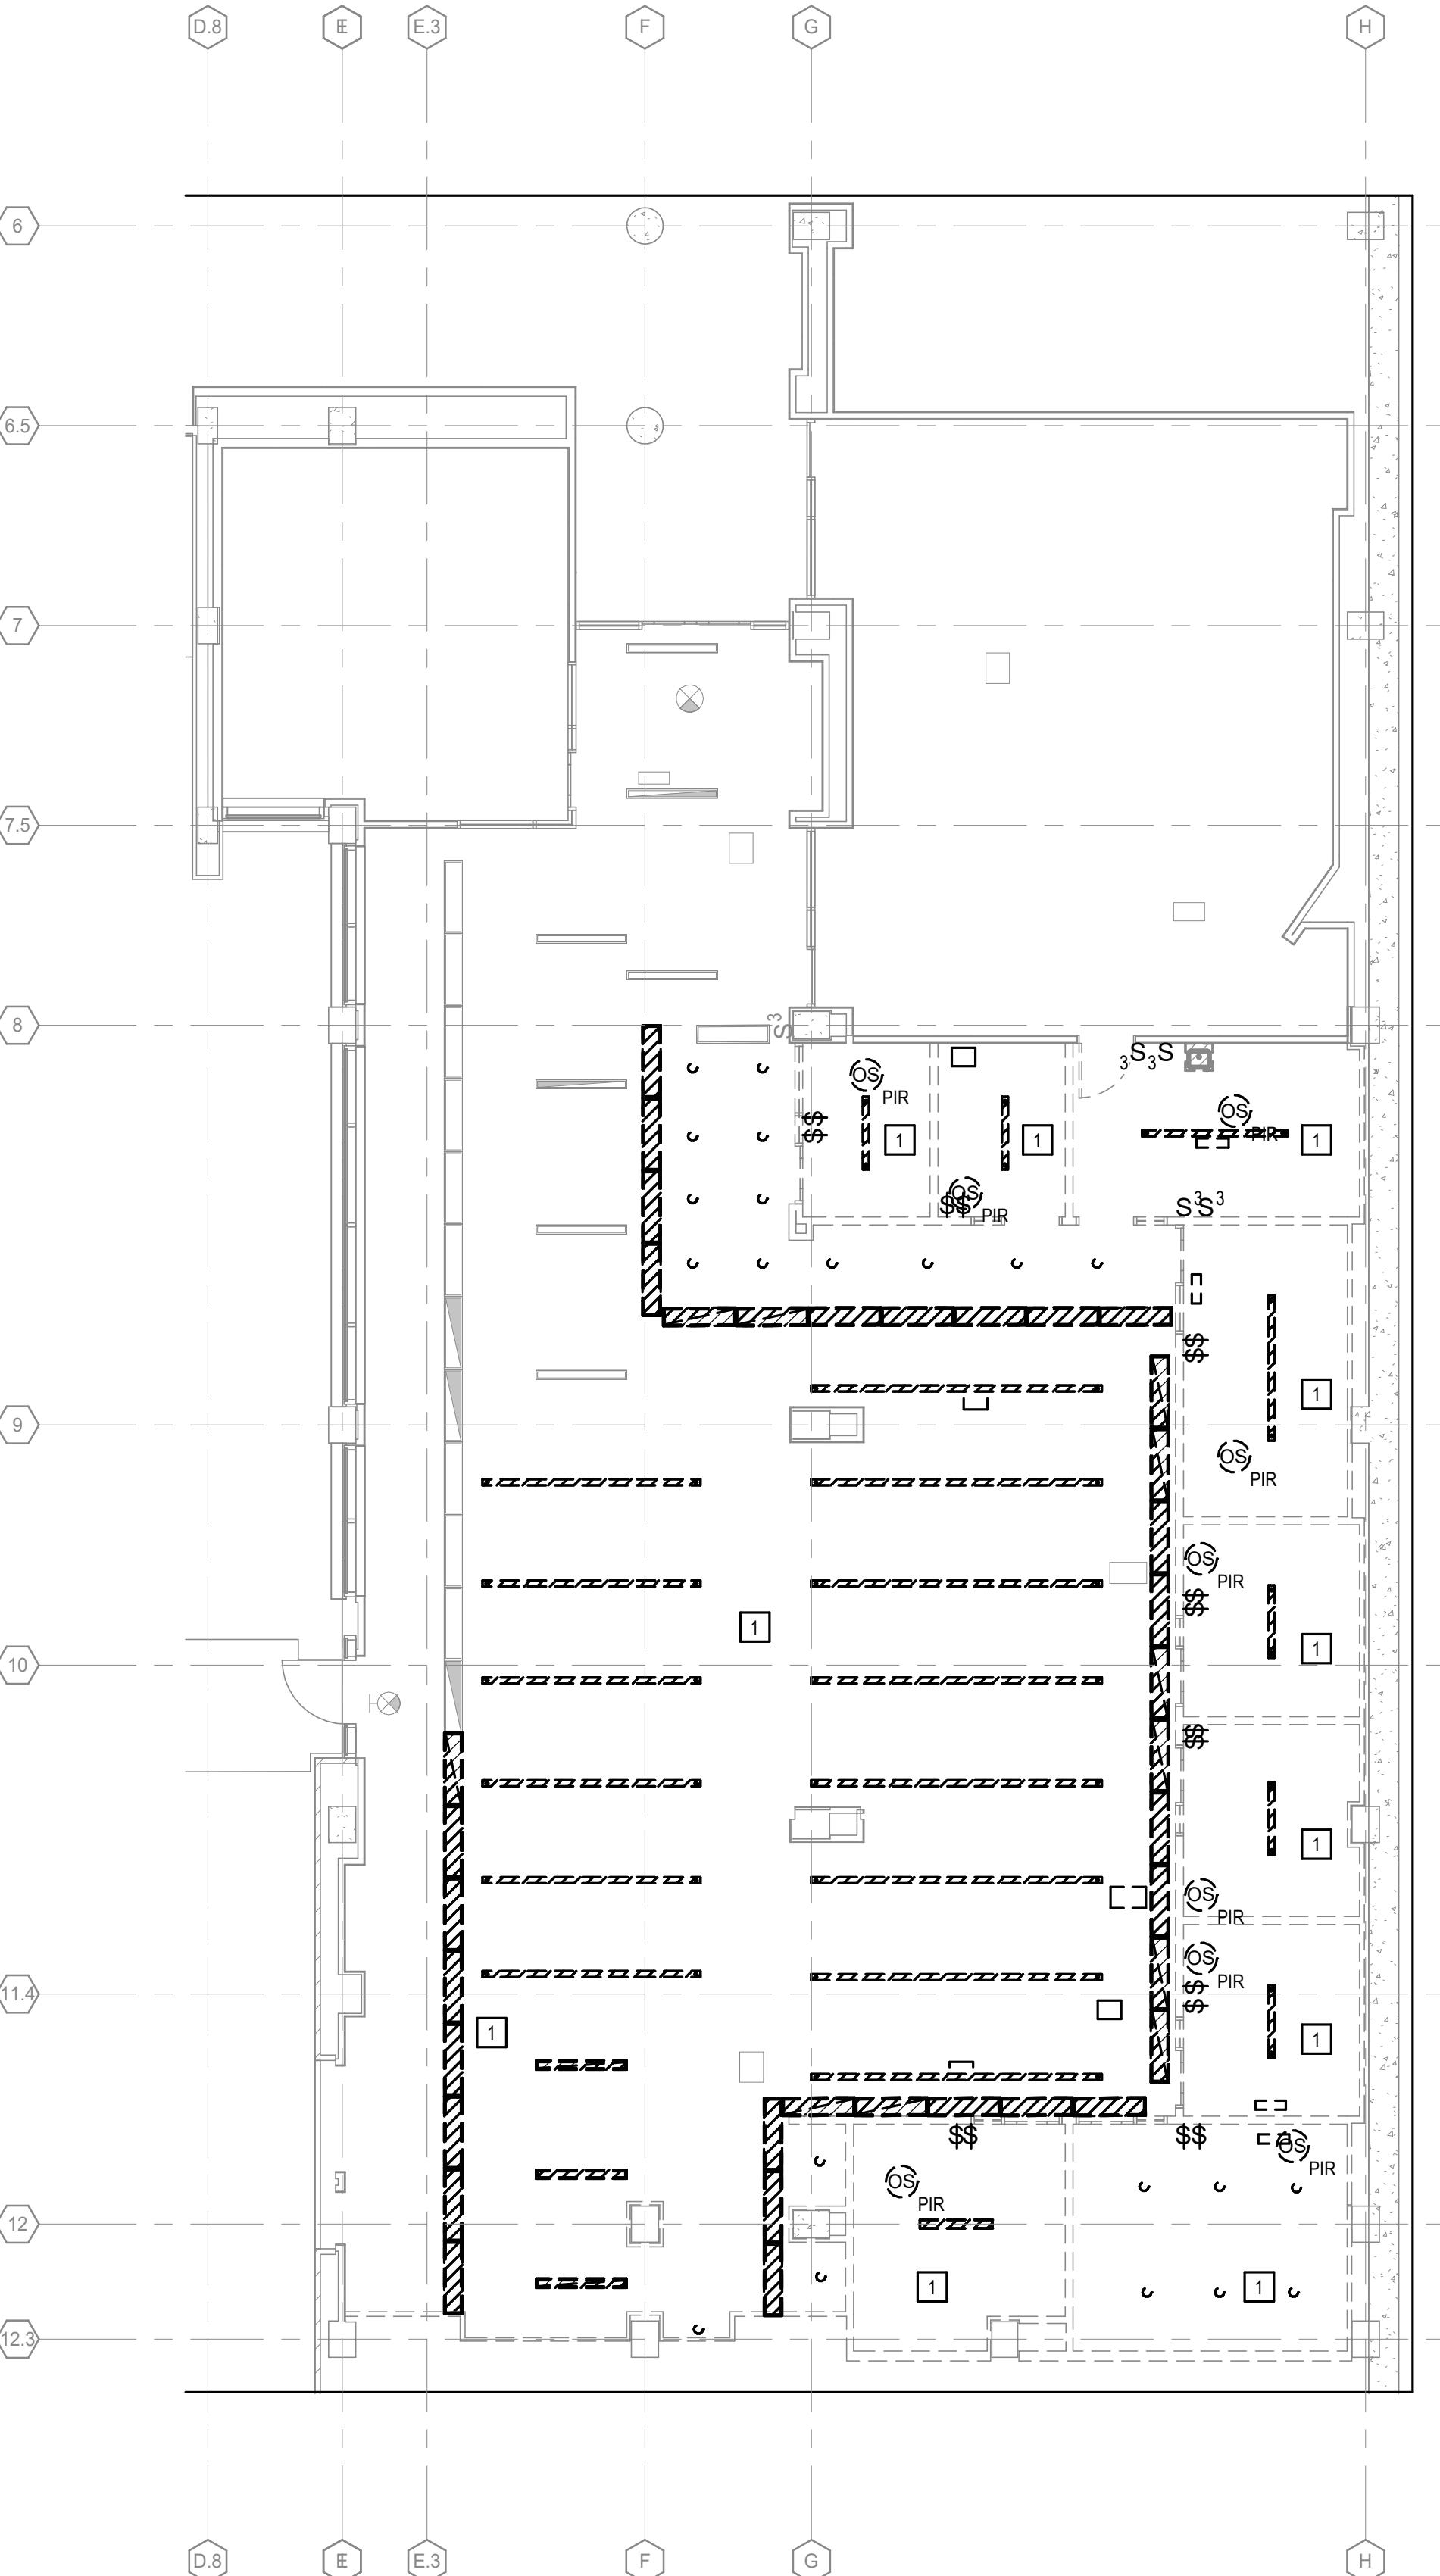

1/8" = 1'-0" 8' 4' 0' 8' 16'

**E100**

ELECTRICAL  
DEMOLITION  
PLANS

CLIENT NAME: THE UNIVERSITY OF NORTH CAROLINA AT CHAPEL HILL

JOB NAME: UNC VENABLE HALL LOWER LEVEL UPLIFT

LOCATION: 101 South RD

CHAPEL HILL, NC 27514

ISSUE DATE: 11-17-25

JOB NO: 10021-0001

DWG. NO:

SCO ID: 24-28389-01A

#### NEW WORK GENERAL NOTES

- EXISTING CIRCUIT NUMBERING IN FIELD SHALL BE CONFIRMED BY EC. CONTRACTOR SHALL TRACE CIRCUITS UTILIZING CIRCUIT TRACERS FOR ALL CIRCUITS IN THE AREA OF WORK. CONTRACTOR SHALL DOCUMENT EXISTING CIRCUITING IN PREPARATION FOR DEMOLITION WORK AND TO FACILITATE NEW WORK INCLUDING UPDATED LABELING AS REQUIRED PER THE SPECIFICATIONS.
- ELECTRICAL CONTRACTOR SHALL FIELD VERIFY AND COORDINATE ALL EXISTING CONDITIONS, LOCATIONS, AND CIRCUITING OF ALL EXISTING ELECTRICAL, POWER, LIGHTING, SPECIAL SYSTEMS, ETC. EQUIPMENT LOCATED IN AREAS OF DEMOLITION/CONSTRUCTION INCLUDING EQUIPMENT LOCATED IN ADJACENT AREAS SERVED BY CIRCUITING LOCATED IN THESE SPACES. THE CONTRACTOR SHALL VISIT THE JOB SITE AND BECOME FAMILIAR WITH ALL EXISTING CONDITIONS PRIOR TO BID AND ANY WORK.
- EXISTING ELECTRICAL PANELBOARDS SHALL REMAIN. PANELBOARDS AND ASSOCIATED CIRCUITS SHALL BE MODIFIED AS NOTED IN THE DRAWINGS.
- IN AREAS OF REMOVAL OF WALL AND CEILING MOUNTED DEVICES, CONTRACTOR SHALL REPAIR, PATCH AND CLEAN WALLS, WALL BASES, AND CEILING AS REQUIRED TO MATCH EXISTING FINISHES.
- REFER TO DRAWING E001 AND E002 FOR GENERAL PROJECT NOTES, SYMBOLS & ABBREVIATIONS.
- REFER TO DRAWING E500 FOR ELECTRICAL DETAILS.


#### # POWER AND SYSTEMS NEW WORK

##### KEYED NOTES:

- PROVIDE NEW POWER/DATA DEVICE (S) AS SHOWN. EXTEND 2 #12 GND IN 3/4" CONDUIT FROM EXISTING CIRCUIT MADE AVAILABLE FROM DEMO AND RECONNECT TO NEW WHERE APPLICABLE. OTHERWISE PROVIDE NEW CIRCUITING FROM CIRCUIT SHOWN TO NEW RECEPTACLE LOCATIONS FOR DATA OUTLETS. PROVIDE DOUBLE GANG BOX/AN FLUSH SINGLE GANG MUD RING. PROVIDE 1" EM CONDUIT FROM BOX TO ABOVE FINISHED CEILING AND PROVIDE 9" BEND WITH 1/2" RADIUS. 100' BUDGET AND 100 LBS. TIE WYLVON PULL STRINGS PROVIDED. DUAL CATEG 6A OUTLET FOR COMPLETE POWER INSTALLATION. WIRING AND CABLING BY UNC-ITS. COORDINATE PRIOR TO WORK.
- PROVIDE 10A-120V CORD REEL BY LEGRAND 0000 SERIES OR APPROVED EQUIVALENT) WITH 4 AC OUTLETS AND USB PORTS. CORD REEL SHALL BE TERMINATED WITH QUAD RECEPTACLE. PROVIDE MOUNTING HARDWARE TO MOUNT REEL BASE ALUMINUM FRAMING. PROVIDE FLUSH CEILING MOUNTED DUPLEX RECEPTACLE FOR SERVICE TO CORD REEL.
- REINSTALL CEILING WIRELESS ACCESS POINT(S). COORDINATE LOCATIONS WITH UNC-ITS. EXTEND CONDUIT AND SUPPORTS AS NEEDED. WIRING AND CABLING BY UNC-ITS.
- PROVIDE 120V POWER TO ELECTRIC DOOR HARDWARE. PROVIDE JUNCTION BOX AND ASSOCIATED RACEWAY FOR DOOR POWER SUPPLY. PROVIDE SINGLE GANG BOX AS REQUIRED FOR DOOR HARDWARE PROVIDED BY OTHERS. REFER TO DETAILS SHOWN ON E501. COORDINATE WITH ARCHITECT AS NECESSARY.
- PROVIDE NEW RECESSED ELECTRICAL PANEL 'RPGK', 100A MCB, 208Y/120V, 22KAIC IN NEW STORAGE ROOM 1101. PROVIDE FEEDER BREAKER IN EXISTING DISTRIBUTION PANEL 'DPGA' TO SERVER NEW BRANCH PANEL 'RPGK'.
- PROVIDE POWER CONNECTION FOR FUME HOOD AS SHOWN. PROVIDE JUNCTION BOX FOR POWER ACCESS ABOVE THE FUME HOOD. COORDINATE FUME HOOD CONNECTION REQUIREMENTS WITH MECHANICAL CONTRACTOR. EXHAUST FANS THAT SUPPLY FUME HOODS ARE ON EMERGENCY POWER.
- ADD ALTERNATE 01: PROVIDE POWER CONNECTION FOR FUME HOOD AS SHOWN. PROVIDE JUNCTION BOX FOR POWER ACCESS ABOVE THE FUME HOOD. COORDINATE FUME HOOD FINAL CONNECTION REQUIREMENTS WITH MECHANICAL CONTRACTOR. EXHAUST FANS THAT SUPPLY FUME HOODS ARE ON EMERGENCY POWER.
- PROVIDE 120V POWER TO DOOR POWER SUPPLY. COORDINATE EXACT LOCATION AND REQUIREMENTS WITH DOOR HARDWARE SUPPLIER AND ARCHITECT PRIOR TO INSTALLATION AND ROUGH-IN.
- NEW AV RACK BY UNC AV. PROVIDE NEW QUAD FOR AV RACK. COORDINATE EXACT LOCATION WITH UNC AV.
- PROVIDE FOUR (4) 2" CONDUITS TO 12"X12" AV PULL BOX. COORDINATE ROUTING WITH UNC AV PRIOR TO WORK. PAINT ANY EXPOSED CONDUITS TO MATCH CEILING.
- PROVIDE 12"X12" AV PULL BOX ABOVE CEILING IN THIS APPROXIMATE LOCATION. COORDINATE EXACT LOCATION AND REQUIREMENTS WITH UNC AV PRIOR TO WORK. PAINT ANY EXPOSED CONDUITS TO MATCH CEILING.
- PROVIDE TWO (2) 2" CONDUITS FROM AV PULL BOX TO G301B ROOM ABOVE DROP CEILING. COORDINATE LENGTH, AND END LOCATION OF CONDUITS WITH UNC AV PRIOR TO WORK. PAINT ANY EXPOSED CONDUITS TO MATCH CEILING.
- PROVIDE TWO (2) 2-GANG JUNCTION BOX WITH CONDUIT STUBBED ABOVE CEILING. COORDINATE MOUNTING HEIGHTS WITH UNC AV PRIOR TO ROUGH-IN. WIRING AND CABLING BY UNC AV.
- COORDINATE THE FINAL LOCATION OF ALL DEVICES RECESSED IN DROP CEILING PRIOR TO ANY WORK.

#### ELECTRICAL NEW WORK PLAN - POWER & SYSTEMS

SCALE: 1/8" = 1'-0"

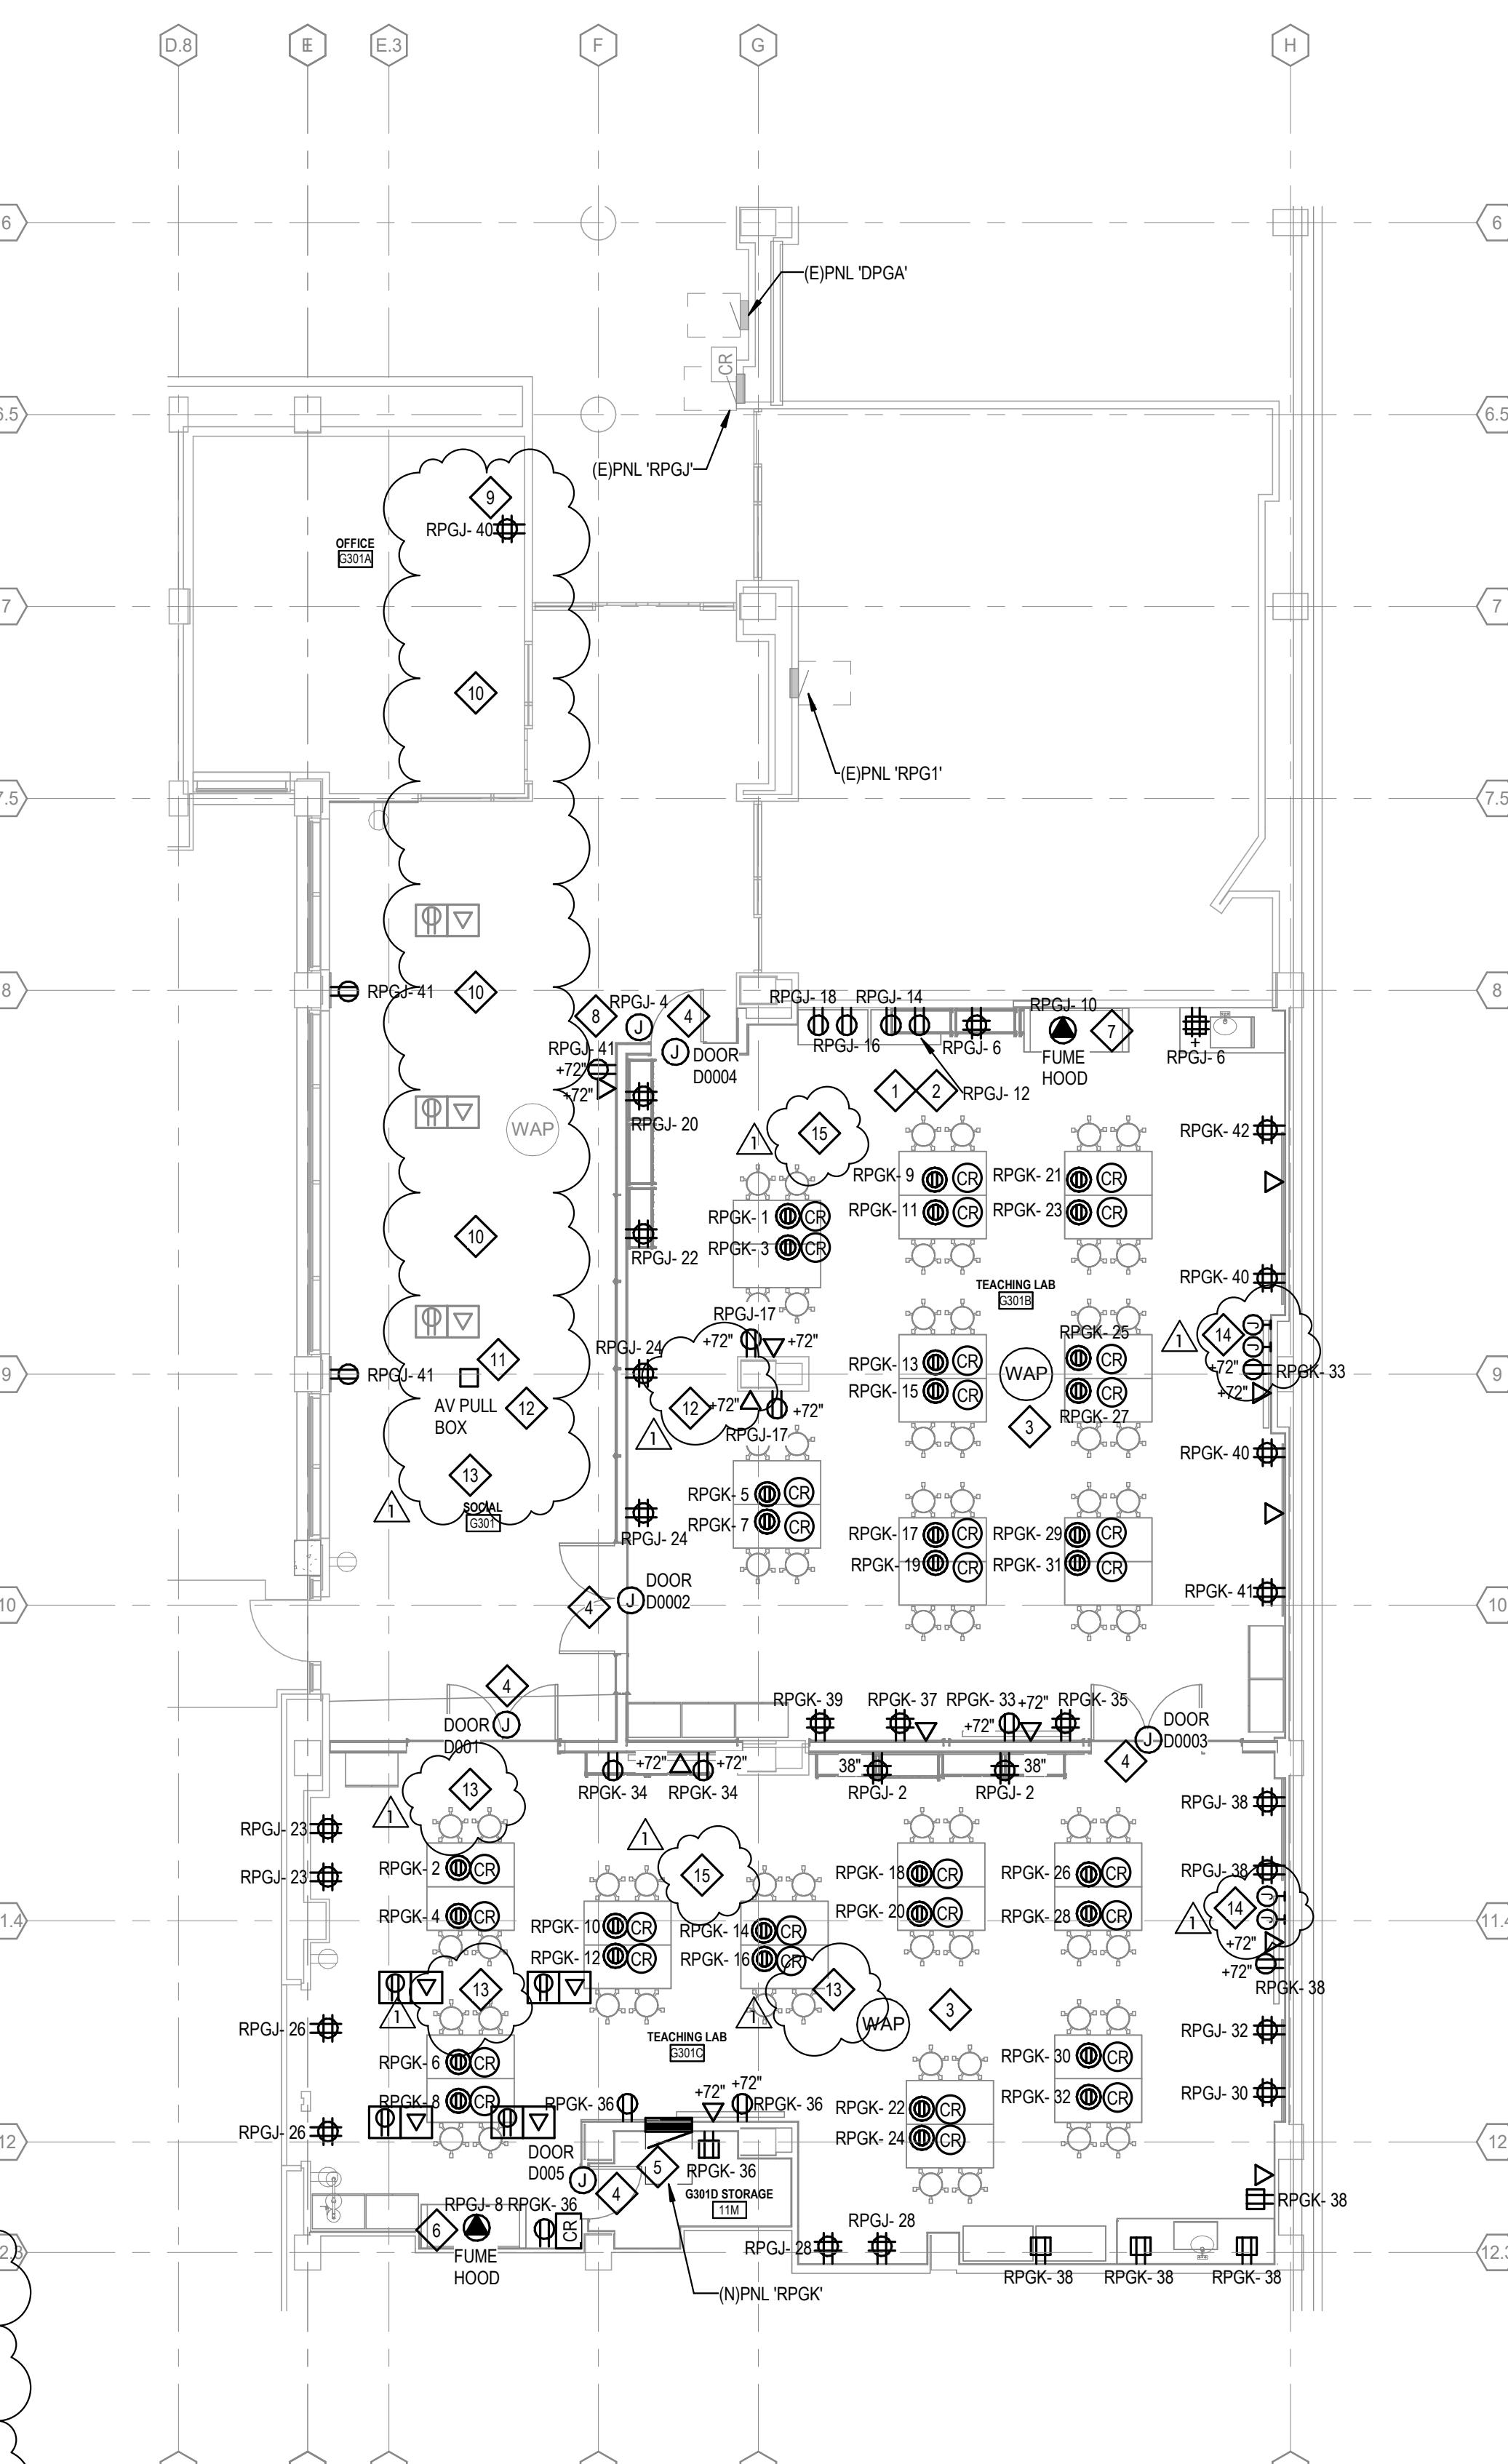

#### NEW WORK GENERAL NOTES


- EXISTING CIRCUIT NUMBERING IN FIELD SHALL BE CONFIRMED BY EC. CONTRACTOR SHALL TRACE CIRCUITS UTILIZING CIRCUIT TRACERS FOR ALL CIRCUITS IN THE AREA OF WORK. CONTRACTOR SHALL DOCUMENT EXISTING CIRCUITING IN PREPARATION FOR DEMOLITION WORK AND TO FACILITATE NEW WORK INCLUDING UPDATED LABELING AS REQUIRED PER THE SPECIFICATIONS.
- ELECTRICAL CONTRACTOR SHALL FIELD VERIFY AND COORDINATE ALL EXISTING CONDITIONS, LOCATIONS, AND CIRCUITING OF ALL EXISTING ELECTRICAL (POWER, LIGHTING, SPECIAL SYSTEMS, ETC.) EQUIPMENT LOCATED IN AREAS OF DEMOLITION/CONSTRUCTION INCLUDING EQUIPMENT LOCATED IN ADJACENT AREAS SERVED BY CIRCUITING LOCATED IN THESE SPACES. THE CONTRACTOR SHALL VISIT THE JOB SITE AND BECOME FAMILIAR WITH ALL EXISTING CONDITIONS PRIOR TO BID AND ANY WORK.
- EXISTING ELECTRICAL PANELBOARDS SHALL REMAIN. PANELBOARDS AND ASSOCIATED CIRCUITS SHALL BE MODIFIED AS NOTED IN THE DRAWINGS.
- IN AREAS OF REMOVAL OF WALL AND CEILING MOUNTED DEVICES, CONTRACTOR SHALL REPAIR, PATCH AND CLEAN WALLS, WALL BASES, AND CEILING AS REQUIRED TO MATCH EXISTING FINISHES.
- REFER TO DRAWING E001 AND E002 FOR GENERAL PROJECT NOTES, SYMBOLS & ABBREVIATIONS.
- REFER TO DRAWING E500 FOR ELECTRICAL DETAILS.

#### # LIGHTING NEW WORK KEYED NOTES:

- PROVIDE NEW LIGHT FIXTURE (S) AND ASSOCIATED CONTROLS AS SHOWN. EXTEND 2 #12 GND IN 3/4" CONDUIT FROM EXISTING CIRCUIT MADE AVAILABLE FROM DEMO AND RECONNECT TO NEW WHERE APPLICABLE. OTHERWISE PROVIDE NEW CIRCUITING FROM CIRCUIT SHOWN TO NEW LIGHT LOCATIONS. FOR CIRCUIT(S) EXCEEDING THE LENGTHS NOTED IN THE PLANS AND SPECS, UPSIZE ACCORDINGLY. TYPICAL OF ALL LIGHT FIXTURES, WIRE EMERGENCY LIGHTING FIXTURES AHEAD OF ANY SWITCHING. (TYPICAL)
- LIGHTING CONTROL INSTALLATION SHALL INCLUDE CONTROLS, DATA CABLING, AND 0-10V DIMMING WIRING, ETC. AS NECESSARY FOR COMPLETE AND FUNCTIONAL INSTALLATION. (TYPICAL FOR ALL SPACES). ALL LIGHTING SHALL BE CONTROLLED (NORMAL AND EMERGENCY).
- LIGHTING CONTROL BASIS OF DESIGN: POWER PACK FOR NORMAL POWER LUMINARIES SHALL BE ACUITY nLIGHT nPP160 EFP; POWER PACK FOR EMERGENCY POWER LUMINARIES SHALL BE ACUITY nLIGHT nPP160 ER EFP (PROVIDED WITH TEST SWITCH); OCCUPANCY SENSORS SHALL BE ACUITY nLIGHT nCM PDT 10 RJB SWITCHES SHALL BE ACUITY nLIGHT nPDMX DX W/ REVIEWED EQUIVALENT IS ACCEPTABLE. (TYPICAL FOR ALL SPACES)
- WALL SWITCH OCCUPANCY SENSOR: SENSOR SWITCH WSXn PDT COLOR TO BE CONFIRMED WITH OWNER AND ARCHITECT AT SUBMITTAL STAGE. REVIEWED EQUIVALENT IS ACCEPTABLE.
- REINSTALL EXISTING LUMINARIES WITH BATTERY PACKS SALVAGED FROM EXISTING CEILING TILES. EXTEND EXISTING WIRING AND CONDUIT AS NECESSARY FOR POWER AND CONTROLS. WIRE EMERGENCY LIGHTING FIXTURES AHEAD OF ANY SWITCHING.

#### ELECTRICAL NEW WORK PLAN - LIGHTING

SCALE: 1/8" = 1'-0"

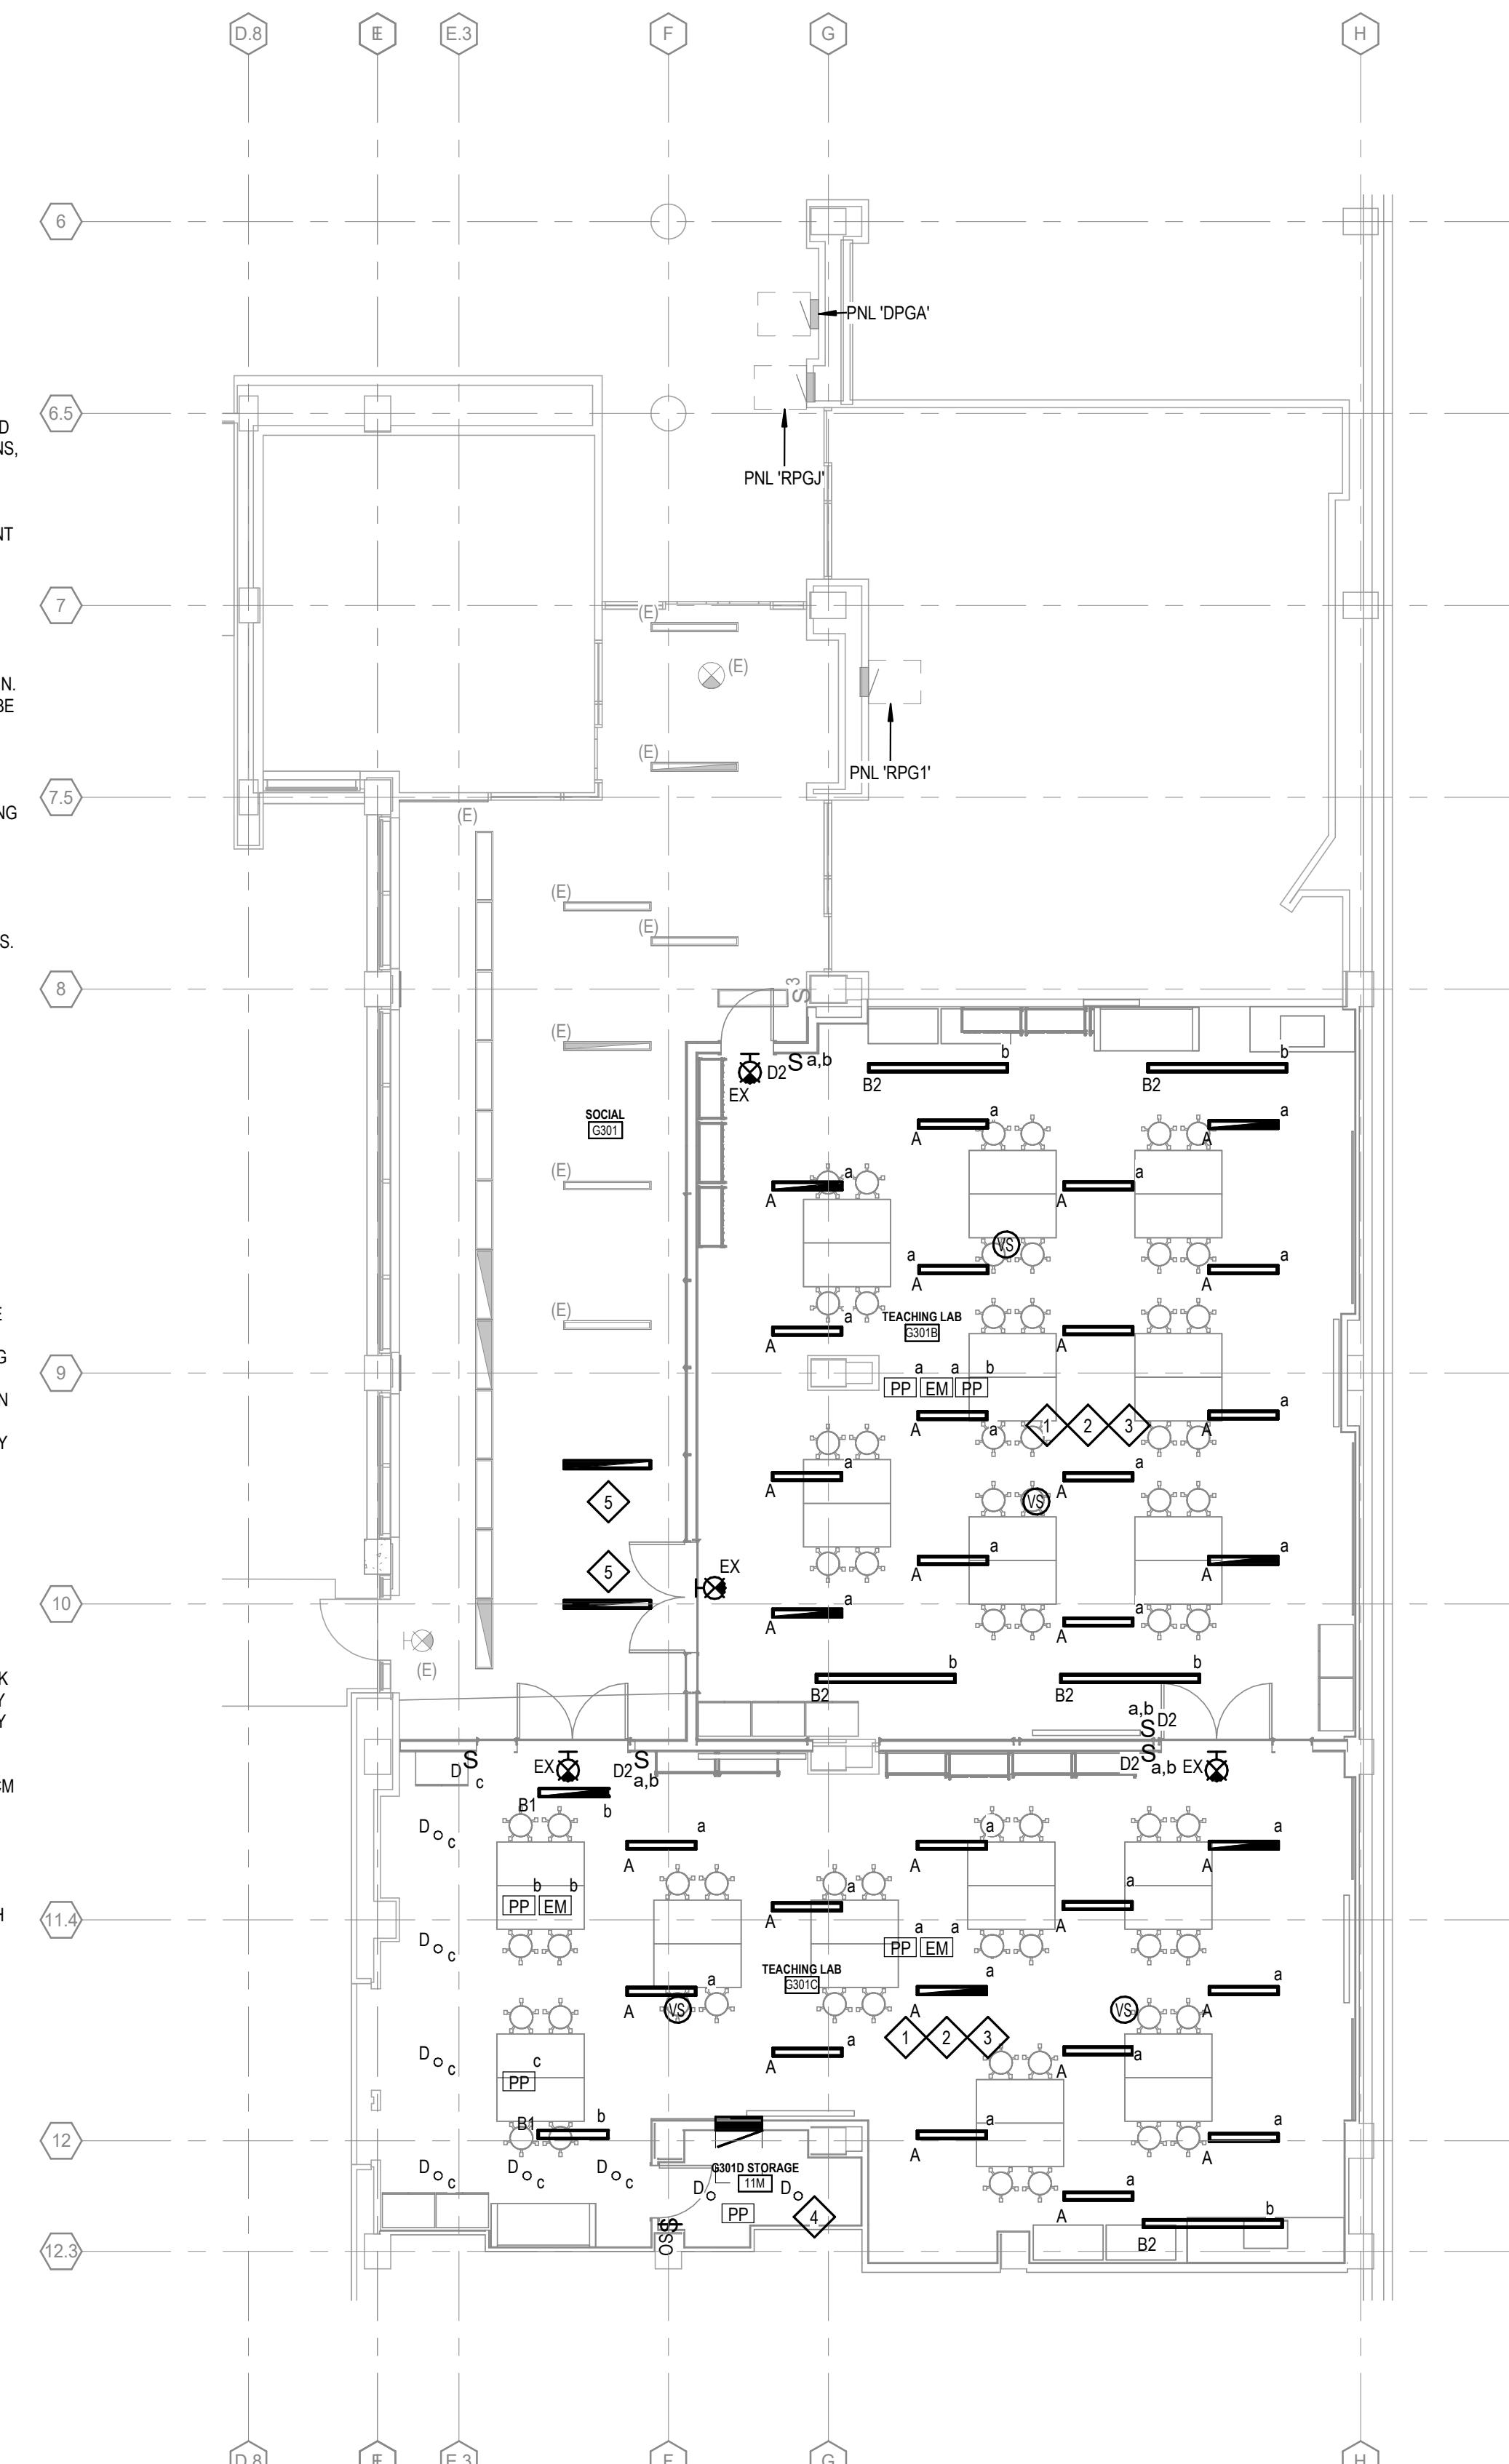

**NOTCH**  
NOTCH DESIGN, PLLC  
212 W MAIN ST, SUITE E,  
CARRBORO, NC  
www.notchdesign.us  
info@notchdesign.us

  
McKIM & CREED  
www.mckimcreed.com  
4300 Edwards Mill Rd Suite 200  
Raleigh, NC 27612  
(919) 223-8091  
(919) 233-8031 Fax  
NC Licens# F-1222

REVISION 1 ADDENDUM 1 1/7/26

#### CONSTRUCTION SET



© 2024  
Notch Design

CLIENT NAME: THE UNIVERSITY OF NORTH CAROLINA AT CHAPEL HILL  
JOB NAME: UNC VENABLE HALL LOWER LEVEL UPLIFT

LOCATION: 101 South RD  
CHAPEL HILL, NC 27514

SCO ID: 24-28389-01A

ISSUE DATE: 11-17-25

JOB NO.: 10021-0001


DWG. NO.

**E200**

ELECTRICAL NEW  
WORK PLANS

1/8" = 1'-0" 8' 4' 0' 8' 16'


## CONSTRUCTION SET

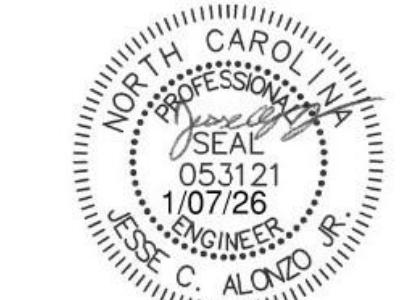

© 2024  
Notch Design

CLIENT NAME: THE UNIVERSITY OF NORTH CAROLINA AT CHAPEL HILL  
JOB NAME: UNC VENABLE HALL LOWER LEVEL UPLIFT  
LOCATION: 101 South RD  
CHAPEL HILL, NC 27514

SCO ID: 24-28389-01A

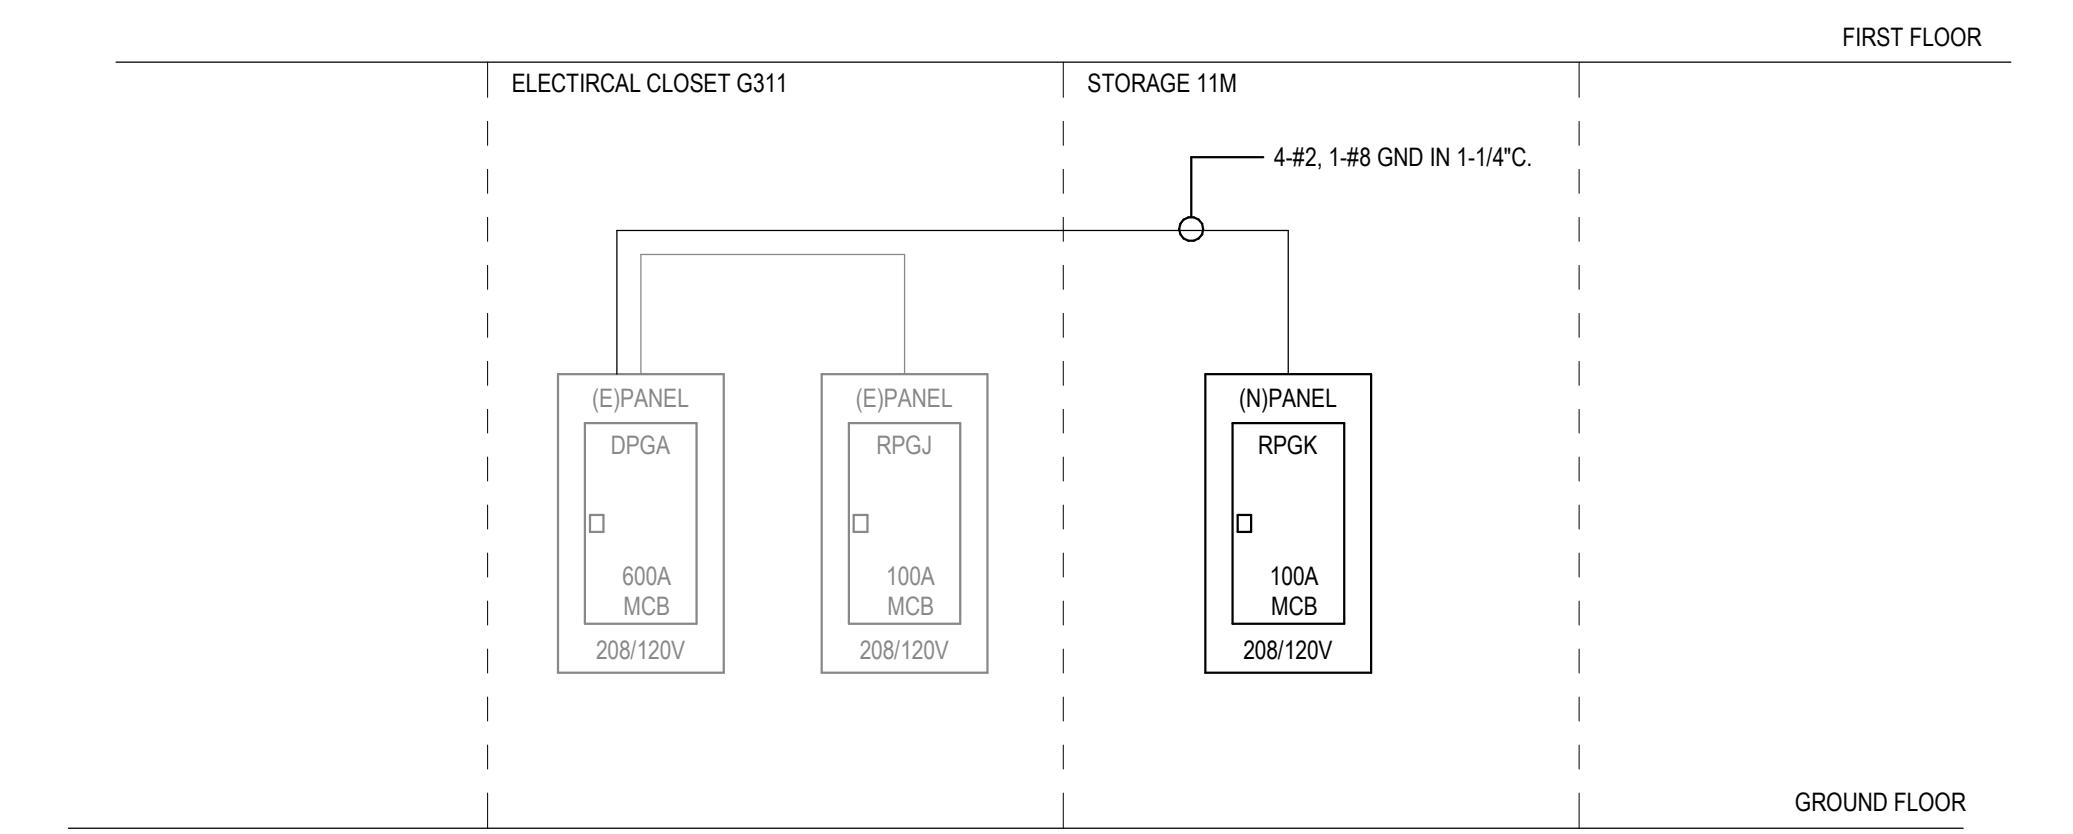

### 1 ELECTRICAL PARTIAL RISER DIAGRAM

SCALE: NTS

EXISTING PANELBOARD RPGJ											
SERVED FROM: DPGA			AMPERE RATING: 100 A			VOLTAGE (L-L): 208			PHASE: 3		
ENCLOSURE RATING: NEMA 1			MAIN BREAKER: 100 A			VOLTAGE (L-N): 120			WIRE: 4		
MOUNTING: RECESSED			LUG OPTIONS: MCB			LOCATION: ELEC CLOSET OUTSIDE CLASSROOM G311			ENCLOSURE NEMA RATING: Type 1		
CIR. NO.	LOAD DESCRIPTION	LTG	H/C	MOT	KIT	REC	MISC	PHASE	G	CND	BRKR
1	RPGH							A	0.90	100/3	
5								C	2.16		
7									3.60		
9	RPGI							A	3.78	100/3	
11								C	3.42		
13									5.76		
15	RPGJ							A	5.40	100/3	
17								C	5.38		
19									A		
21	SPARE								100/3	B 225/3	
23											
25											
27	SPARE									100/3	B 225/3
31											
33											
35											
37											
39											
41											
PANELBOARD NOTES:											
1. EXISTING PANELBOARD IS EATON PRL4.											
2. ITEMS IN BOLD DENOTE MODIFICATION.											
3. EXISTING LOAD ARE BASED ON AS-BUILTS.											
LOAD TOTALS (KVA):											
1. LIGHTING/CONTINUOUS											
2. HEATING/COOLING											
3. MOTORS											
4. KITCHEN											
5. RECEPTACLES											
6. MISCELLANEOUS											
7. TOTAL DEMAND AMPS x											
8. LARGEST UNBALANCE PHASE %:											
9. LARGEST MOTOR (KVA):											
10. LARGEST UNBALANCE PHASE AMPS:											
11. TOTAL:											
12. LARGEST UNBALANCE PHASE %:											
13. LARGEST UNBALANCE PHASE AMPS:											

### MODIFIED Panelboard: RPGJ

VOLTAGE: 208/120 Wye			MAINS TYPE: MCB			SERVED FROM: DPGA			22 :KAIC RATING			
PHASE: 3			MAINS RATING: 100 A			ENCLOSURE NEMA RATING: Type 1			LOCATION: ELEC CLOSET OUTSIDE CLASSROOM G311...			
WIRE: 4			MCB RATING: 100 A			MOUNTING: Recessed						
LOAD CLASS	WIRE SIZE PH / N / GND	COND IN	LOAD DESCRIPTION	BRKR RTG	CIR NO	A	B	C	BRKR RTG	CIR NO	LOAD DESCRIPTION	
REC	EXISTING	EX	EWC R. G301	20	1	0.36	2		2	20	QUADS N WALL G301C	
REC	EXISTING	EX	REC. RM G301	20	3		0.18	0.25	4	20	POWER SUPPLY FOR DOORS	
REC	EXISTING	EX	REC. RM G301	20	5				3/4"	1#12, 1#12, 1#12, 1#12	REC	
REC	EXISTING	EX	FLOOR BOX RM. G301	20	7	0.18	1		10	20	FUME HOOD G301C (ALT. #)	
REC	EXISTING	EX	FLOOR BOX RM. G301	20	11			0.36	0.18	12	20	INSTRON G301
REC	EXISTING	EX	FLOOR BOX RM. G301	20	13	0.36	0.18		14	20	INSTRON G301B	
REC	EXISTING	EX	REC. RM G301	20	15		0.18	0.18	16	20	INSTRON G301B	
REC 1#12, 1#12, 1#12, 1#12	3/4"	TV RECS LAB G301B	20	17			1	0.18	18	20	INSTRON G301B	
REC	EXISTING	EX	FLOOR BOX RM. G301	20	19	0.36	0.36		20	20	QUADS W WALL G301B	
REC	EXISTING	EX	REC. RM G301	20	21		0.36	0.36	22	20	QUADS W WALL G301B	
REC 1#10, 1#10, 1#10	3/4"	QUADS W WALL G301C	20	23			2	0.72	24	20	QUADS W WALL G301B	
REC	EXISTING	EX	SMR W WALL RM. G301A	20	25	0.36	2		26	20	QUADS W WALL G301C	
REC	EXISTING	EX	SMR W WALL RM. G301A	20	27		0.36	2	28	20	QUADS S WALL G301C	
REC	EXISTING	EX	SMR E WALL RM. G301A	20	29			0.36	30	20	QUADS E WALL 301B	
REC	EXISTING	EX	SMR E WALL RM. G301A	20	31	0.36	0.36		32	20	QUADS E WALL 30	



**NOTCH**  
NOTCH DESIGN, PLLC  
212 W MAIN ST, SUITE E,  
CARRBORO, NC  
www.notchdesign.us  
info@notchdesign.us



www.mckimcreed.com  
4300 Edwards Mill Rd Suite 200  
Raleigh, NC 27612  
(919) 223-8091  
(919) 233-8031 Fax

NC License# F-1222

REVISION  
SCO REVIEW 9/15/25  
2nd SCO REVIEW 10/24/25  
Construction Set 11/17/25

## CONSTRUCTION SET



© 2024  
Notch Design

CLIENT NAME: THE UNIVERSITY OF NORTH CAROLINA AT CHAPEL HILL  
JOB NAME: UNC VENABLE HALL LOWER LEVEL UPLIFT  
LOCATION: 101 South RD  
CHAPEL HILL, NC 27514

SCO ID: 24-28389-01A

**E500**

ELECTRICAL  
DETAILS


**ELECTRICAL NOTES:**

- EQUIPMENT OF TRADES OTHER THAN ELECTRICAL.
- CONDUIT & WIRING BY HVAC, PLUMBING CONTRACTOR OR OTHER TRADES.
- IF AN ADDITIONAL DISCONNECT IS REQUIRED BY NEC, IT SHALL BE PROVIDED AND INSTALLED BY THE EQUIPMENT CONTRACTOR.
- A COMBINATION STARTER OR VFD MAY BE USED IN LIEU OF A SEPARATE DISCONNECT SWITCH AND STARTER LOCATE ADJACENT TO EQUIPMENT.
- FEEDER CIRCUIT WIRING AND CONDUIT IN ELECTRICAL WORK. SEE PANELBOARD SCHEDULES FOR WIRE AND BREAKER SIZES.
- JUNCTION BOX MAY BE SHOWN ON ELECTRICAL PLANS FOR SOME EQUIPMENT IF NO STARTER OR DISCONNECT IS SUPPLIED, A JUNCTION BOX SHALL BE INSTALLED ADJACENT TO EQUIPMENT. THE ELECTRICAL CONTRACTOR SHALL PROVIDE LINE SIDE WIRING TO THE JUNCTION BOX, LOAD SIDE WIRING SHALL BE PROVIDED BY MECHANICAL CONTRACTOR OR OTHER TRADES.
- PROJECTS UTILIZING AN MCC, THE STARTER, CB OR VFD IN THE MCC ARE PROVIDED BY THE ELECTRICAL CONTRACTOR.
- IN ALL CASES, THE EQUIPMENT CONTRACTOR SHALL MAKE FINAL CONNECTIONS, START UP AND TEST EQUIPMENT.
- IF THE ROOF TOP EQUIPMENT IS NOT PROVIDED WITH BUILT IN SWITCH, THE ELECTRICAL CONTRACTOR SHALL PROVIDE A DISCONNECT SWITCH.

## NC SCO ELECTRICAL CONNECTION COORDINATION DIAGRAM

5

SCALE: NTS

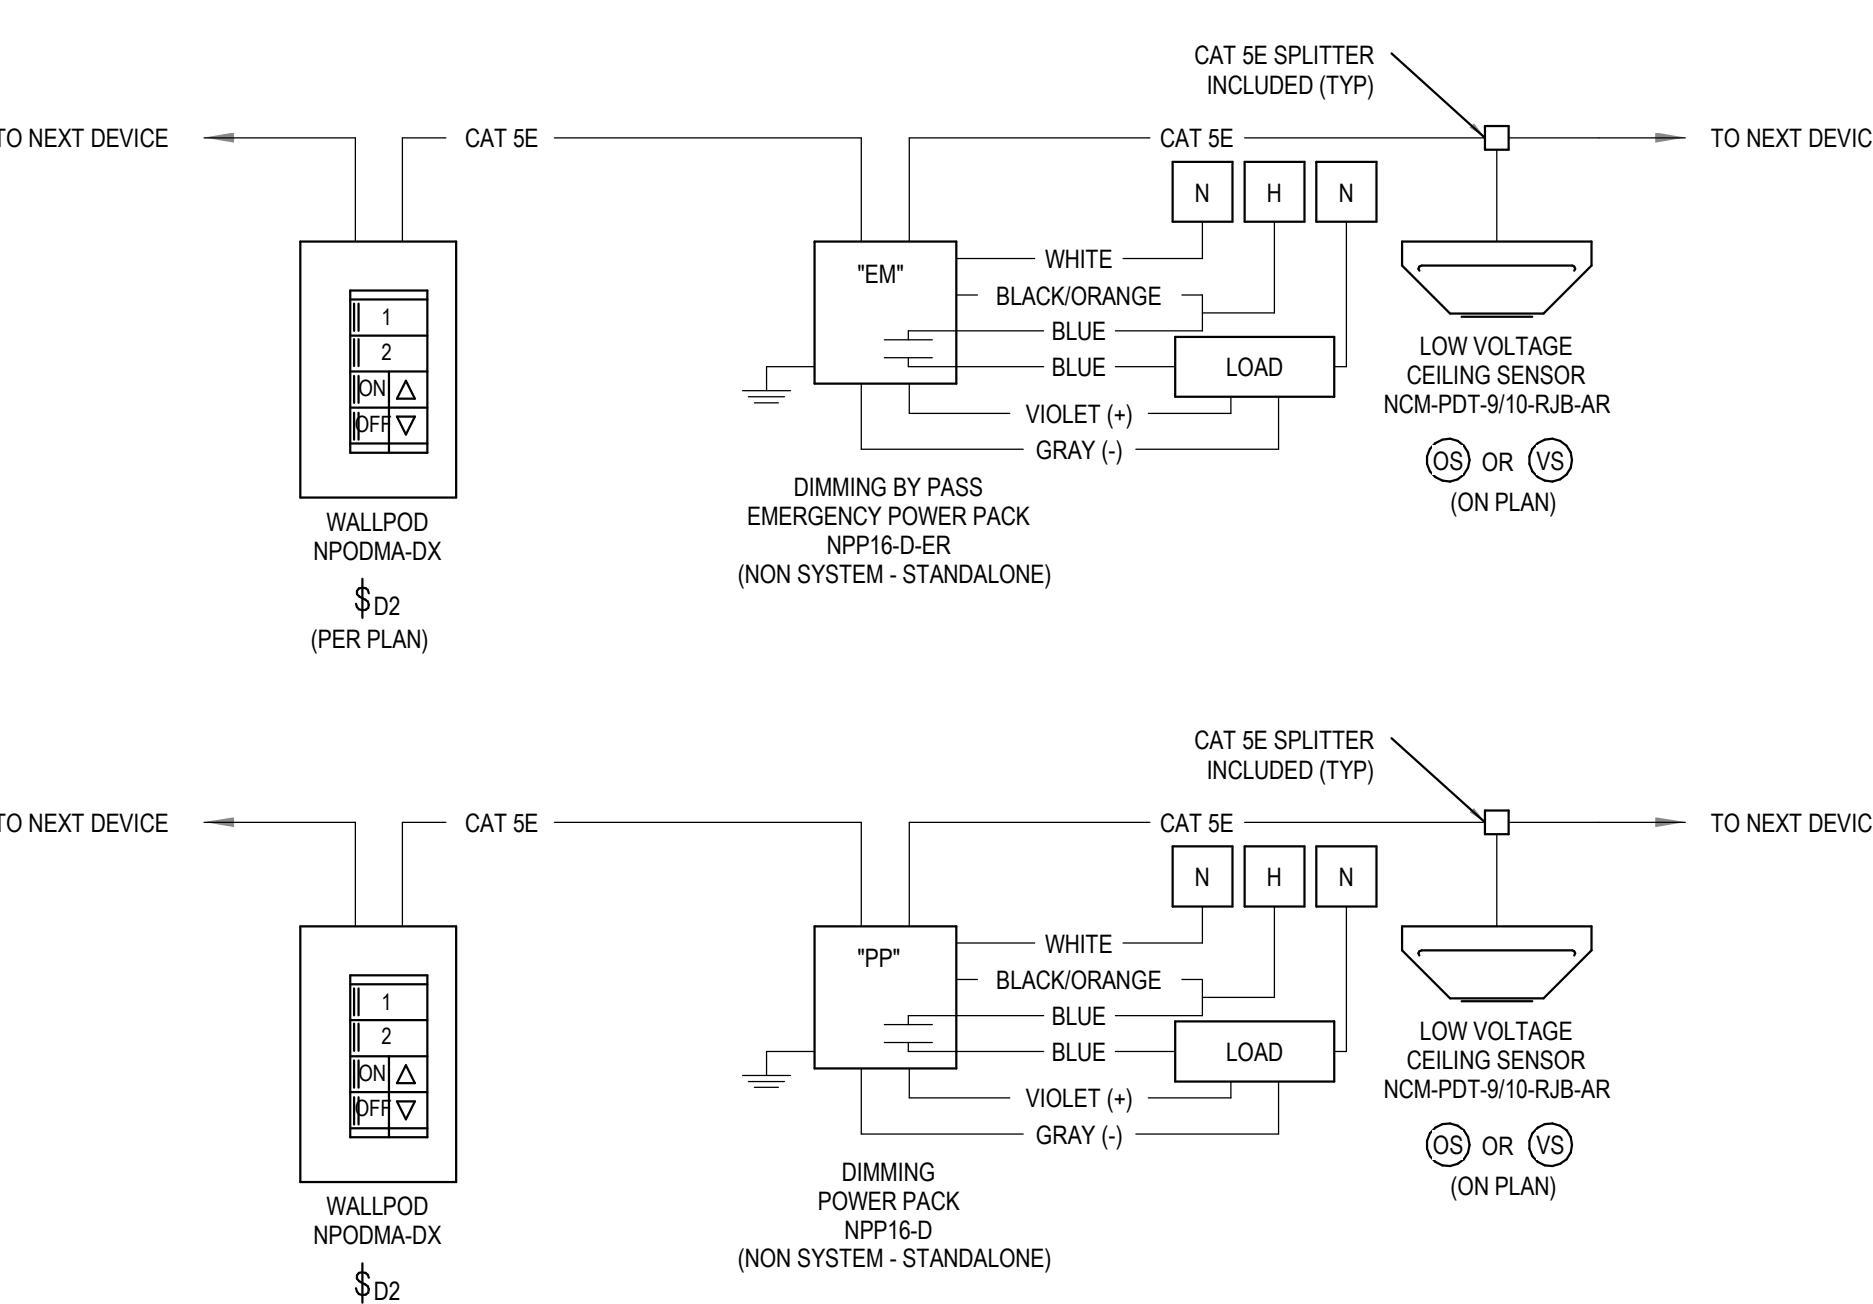


NOTES:

- ALL SWITCH DESIGNATION LABELS MUST BE CLEARLY ENGRAVED ON EACH BUTTON.
- FINAL SCENE PRESET TO BE DESIGNATED BY OWNER.
- QUANTITY OF DEVICES AS INDICATED ON DRAWINGS.
- BASIS OF DESIGN IS ACUTY NIGHT (OR APPROVED EQUIVALENT BY LUTRON OR WATTSTOPPER).

## TYPICAL STANDALONE ZONED DIMMING LIGHTING CONTROL WIRING DIAGRAM - NORMAL AND EMERGENCY WIRING

6

SCALE: NTS

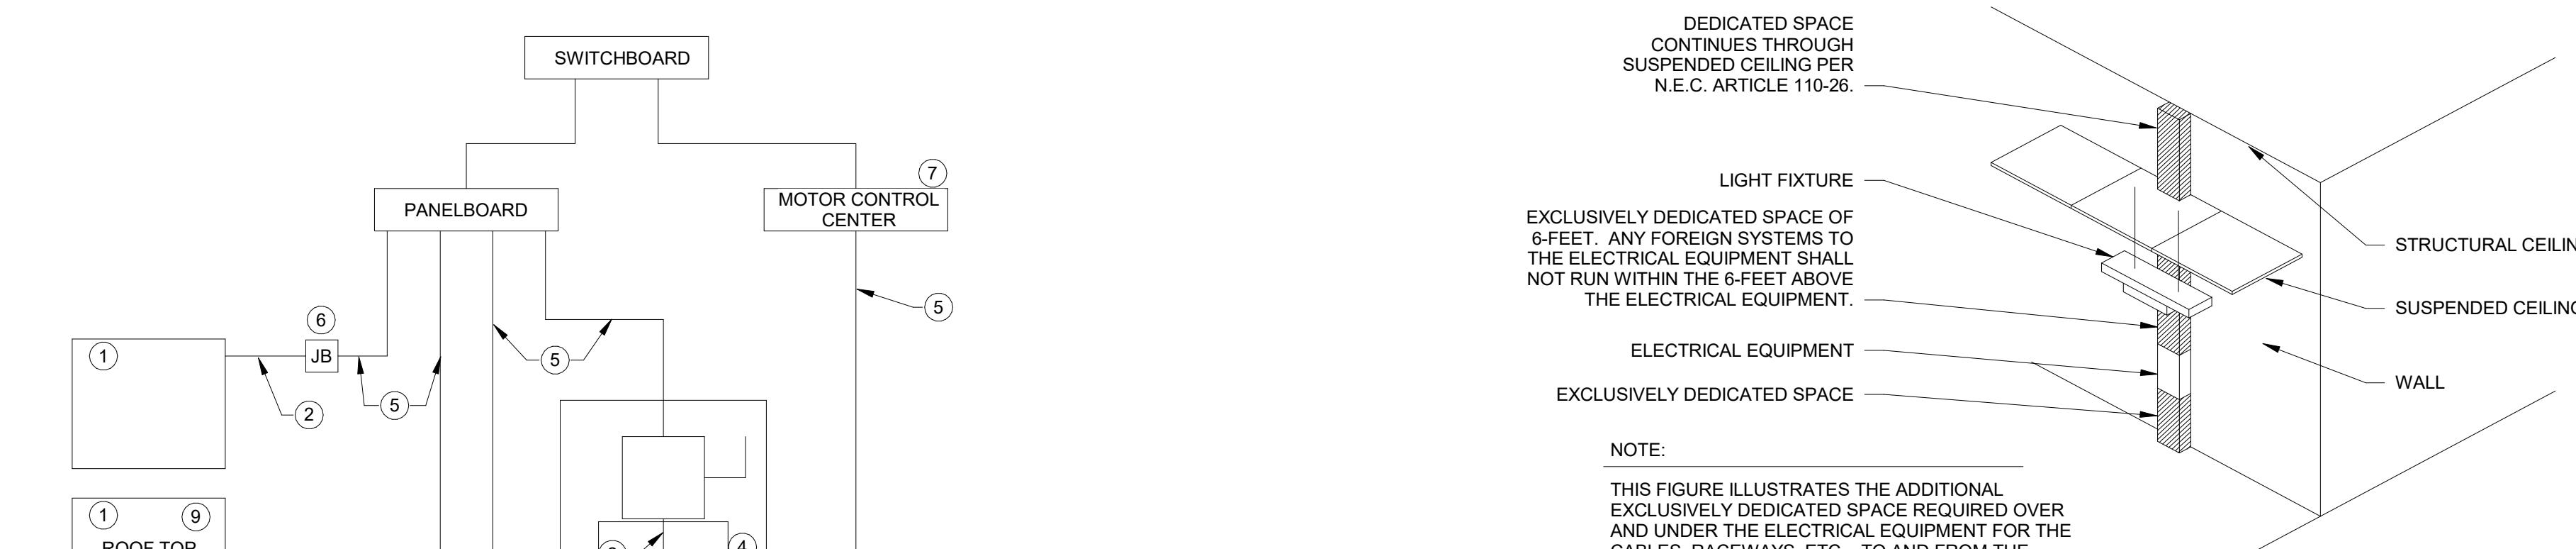

## 2 ELECTRICAL EQUIPMENT DEDICATED SPACE

SCALE: NTS

TABLE A - WORKING CLEARANCES			
VOLTAGE TO GROUND NOMINAL	MINIMUM CLEAR DISTANCE (INCHES)		
CONDITION:	1	2	3
0 - 150	36	36	36
151 - 600	36	42	48


WHERE THE "CONDITIONS" ARE AS FOLLOWS:

1. EXPOSED LIVE PARTS ON ONE SIDE AND NO LIVE OR GROUNDED PARTS ON THE OTHER SIDE OF THE EQUIPMENT. SPACE IS PROVIDED FOR PARTS ON BOTH SIDES EFFECTIVELY GUARDED BY SUITABLE WOOD OR OTHER INSULATING MATERIALS. INSULATED WIRE OR INSULATED BUSBARS OPERATING AT NOT OVER 300V SHALL NOT BE CONSIDERED LIVE PARTS.
2. EXPOSED LIVE PARTS ON ONE SIDE AND GROUNDED PARTS ON THE OTHER SIDE.
3. EXPOSED LIVE PARTS ON BOTH SIDES OF THE WORK SPACE (NOT GUARDED AS PROVIDED IN CONDITION 1) WITH THE OPERATOR BETWEEN.

NOTE:  
THIS FIGURE ILLUSTRATES THE WORKING  
SPACE IN FRONT OF THE ELECTRICAL  
EQUIPMENT REQUIRED BY SECTION  
110-26 OF THE NATIONAL ELECTRICAL  
CODE.


## 3 ELECTRICAL EQUIPMENT WORKING CLEARANCE

SCALE: NTS




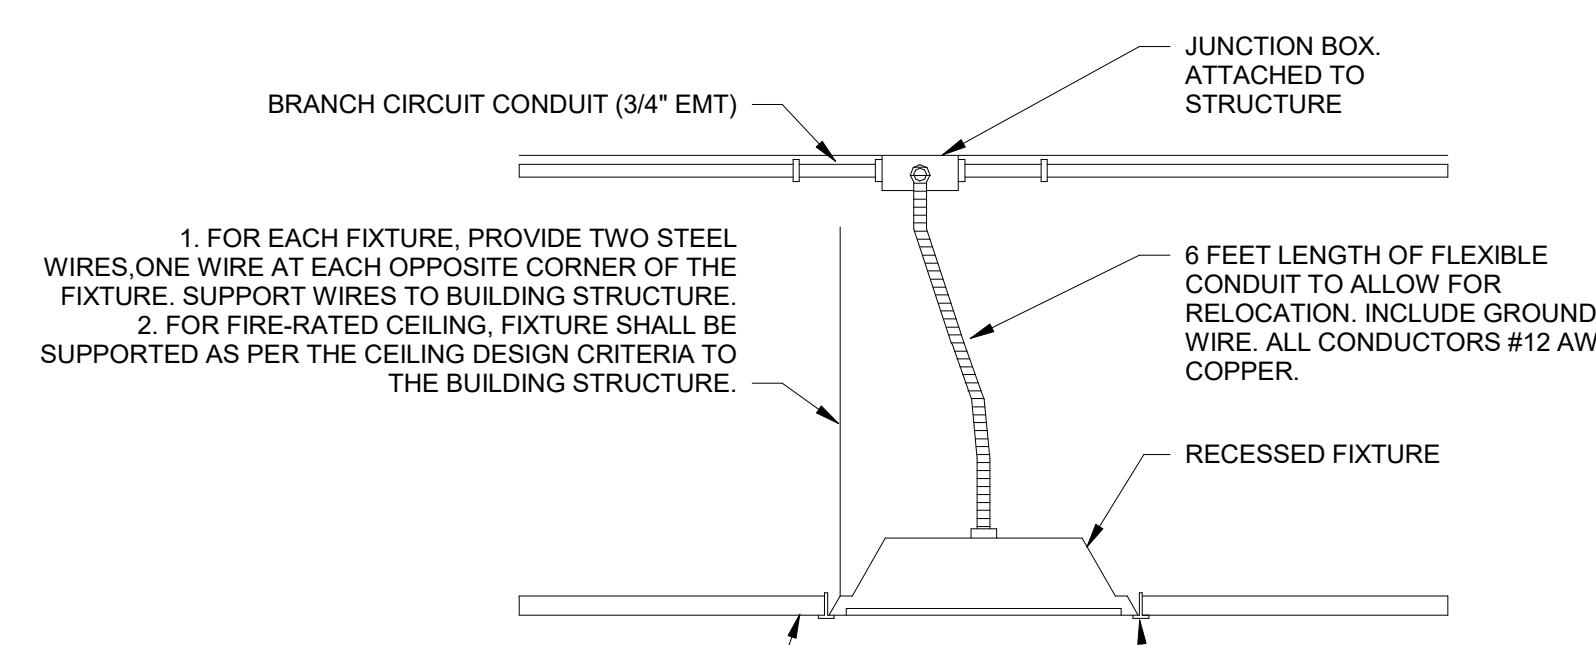


## 4 LIGHT FIXTURE CEILING MOUNTING DETAIL

SCALE: NTS

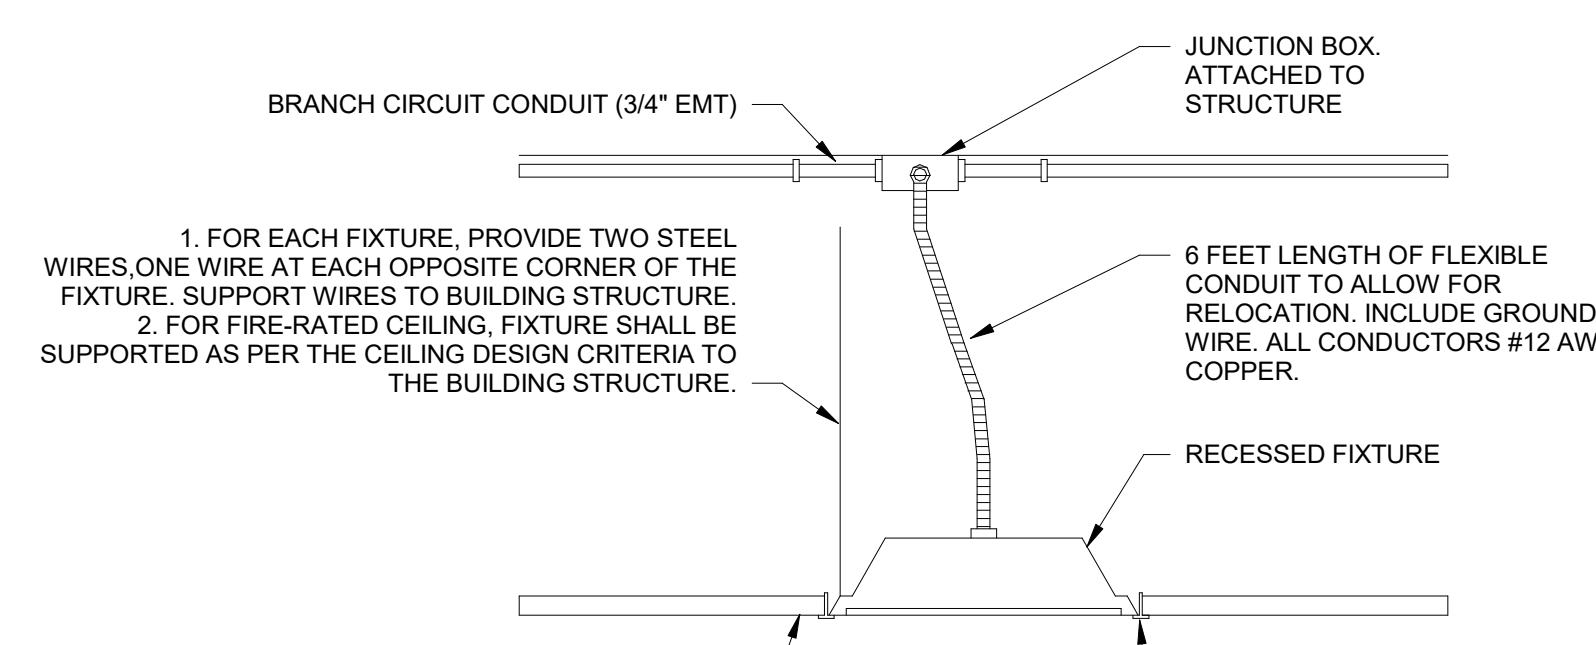

1. FOR EACH FIXTURE, PROVIDE TWO STEEL WIRES, ONE WIRE TO EACH OPPOSITE CORNER OF THE FIXTURE.  
2. FOR FIRE-RATED CEILING, FIXTURE SHALL BE SUPPORTED AS PER THE CEILING DESIGN CRITERIA TO THE BUILDING STRUCTURE.

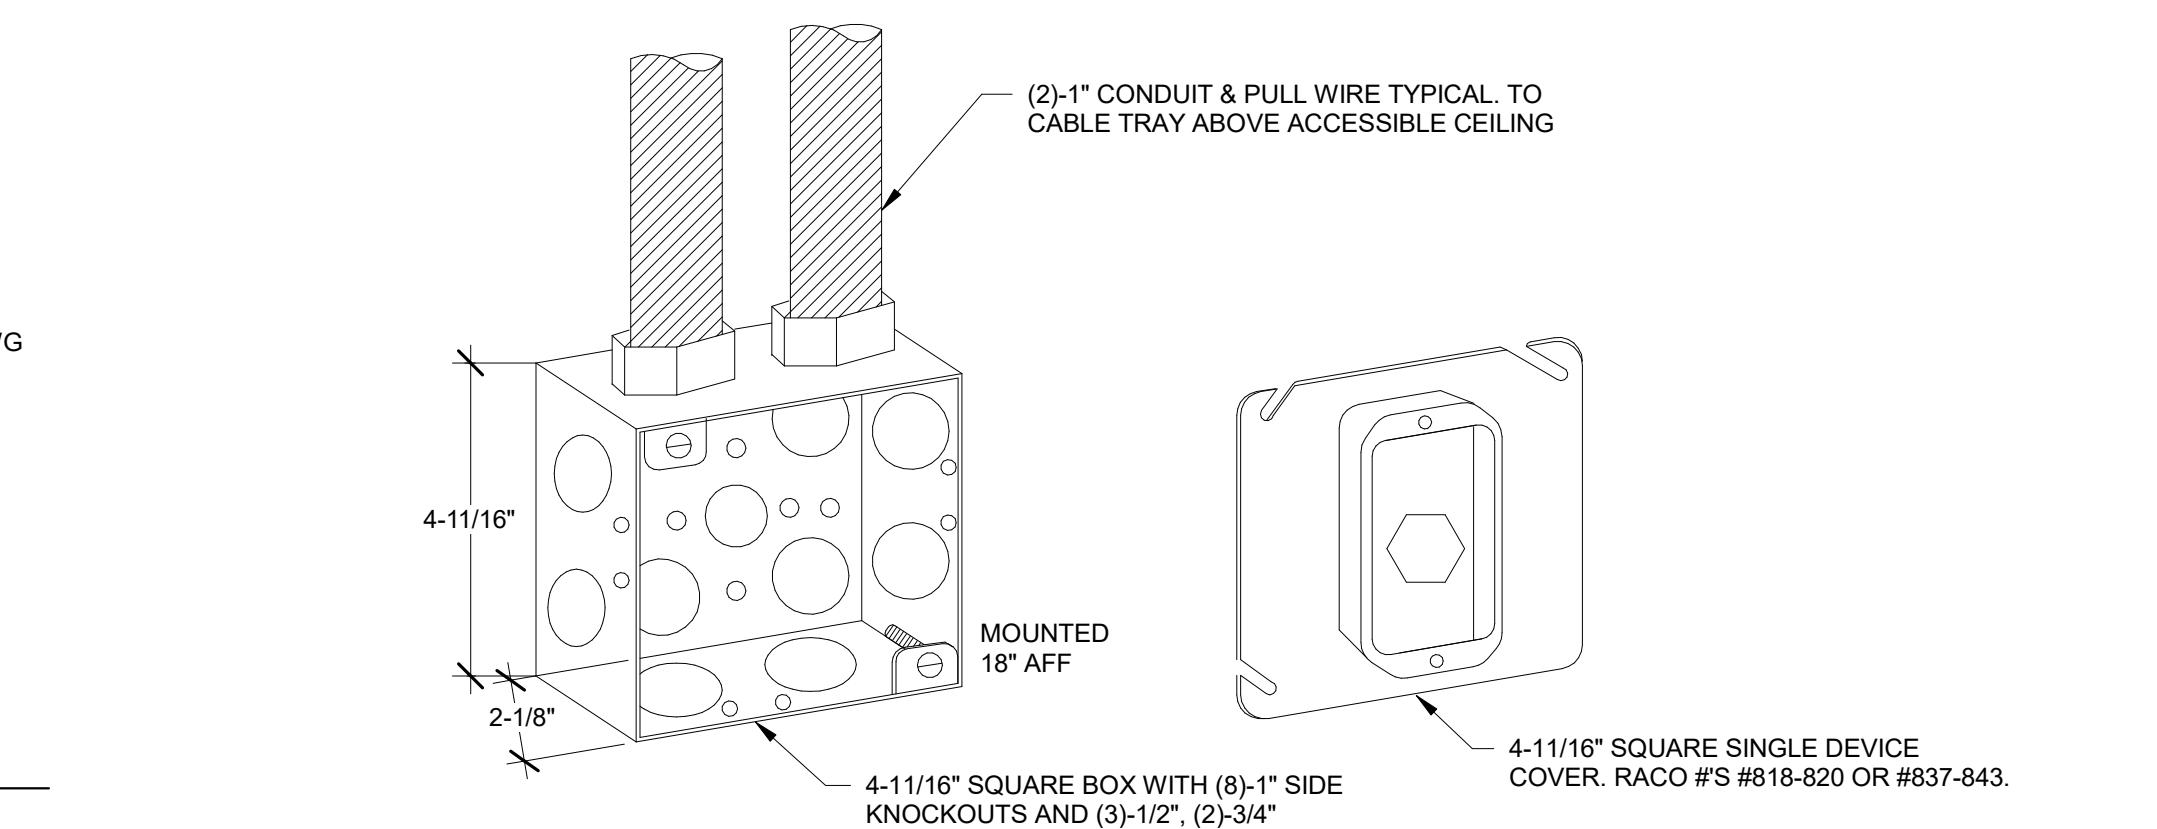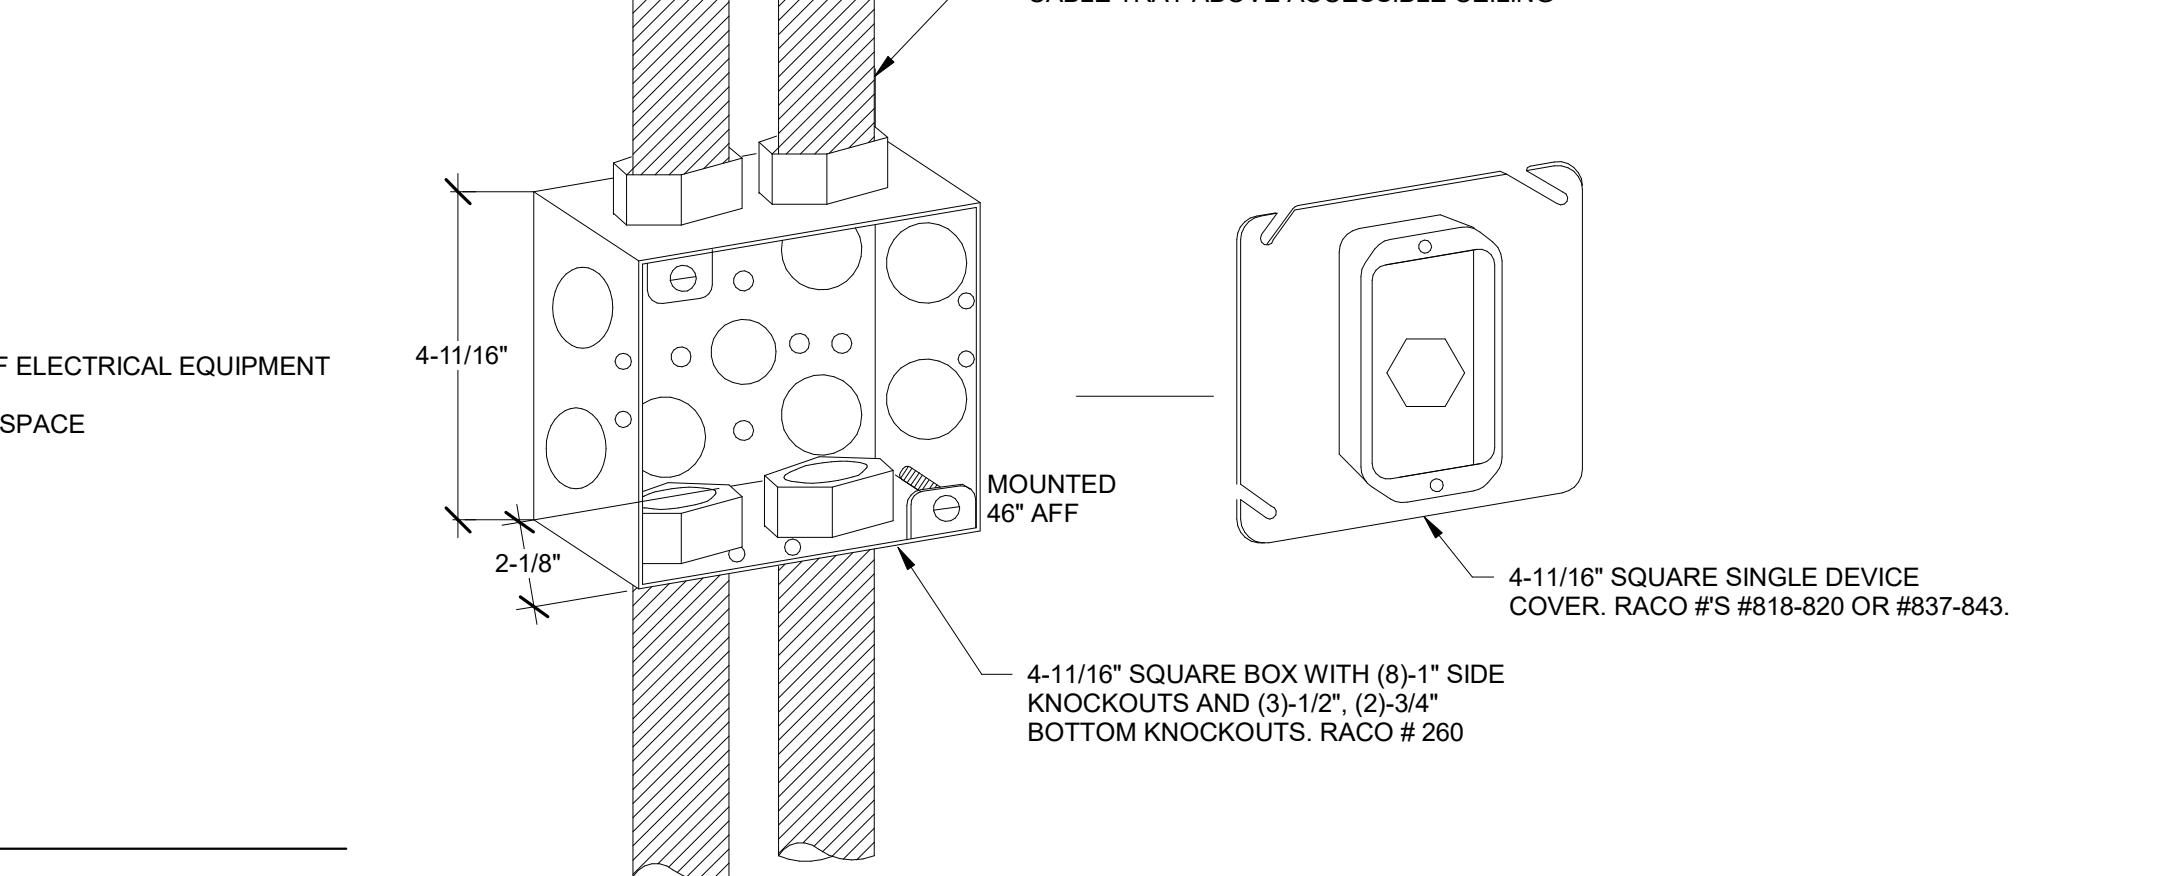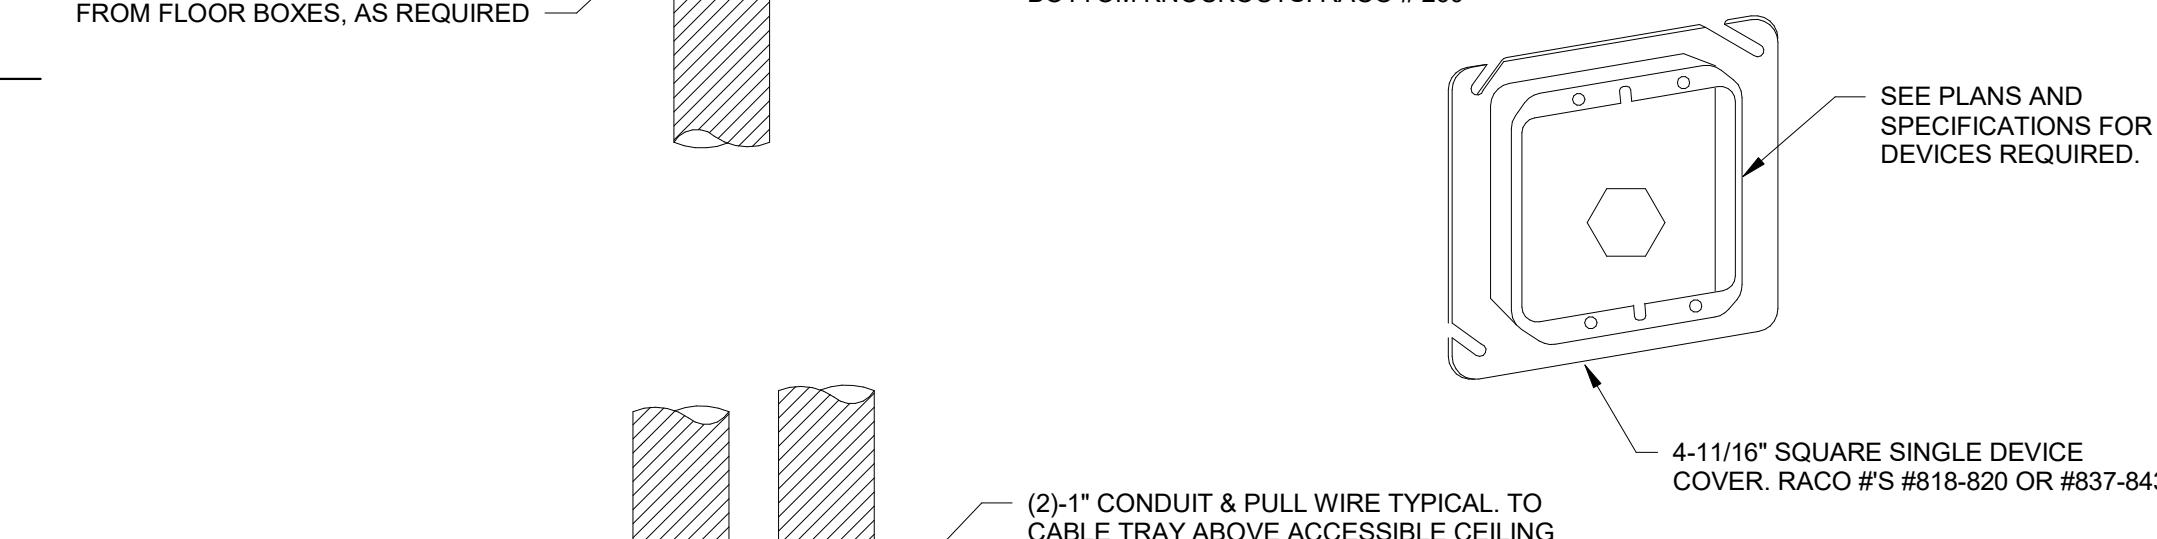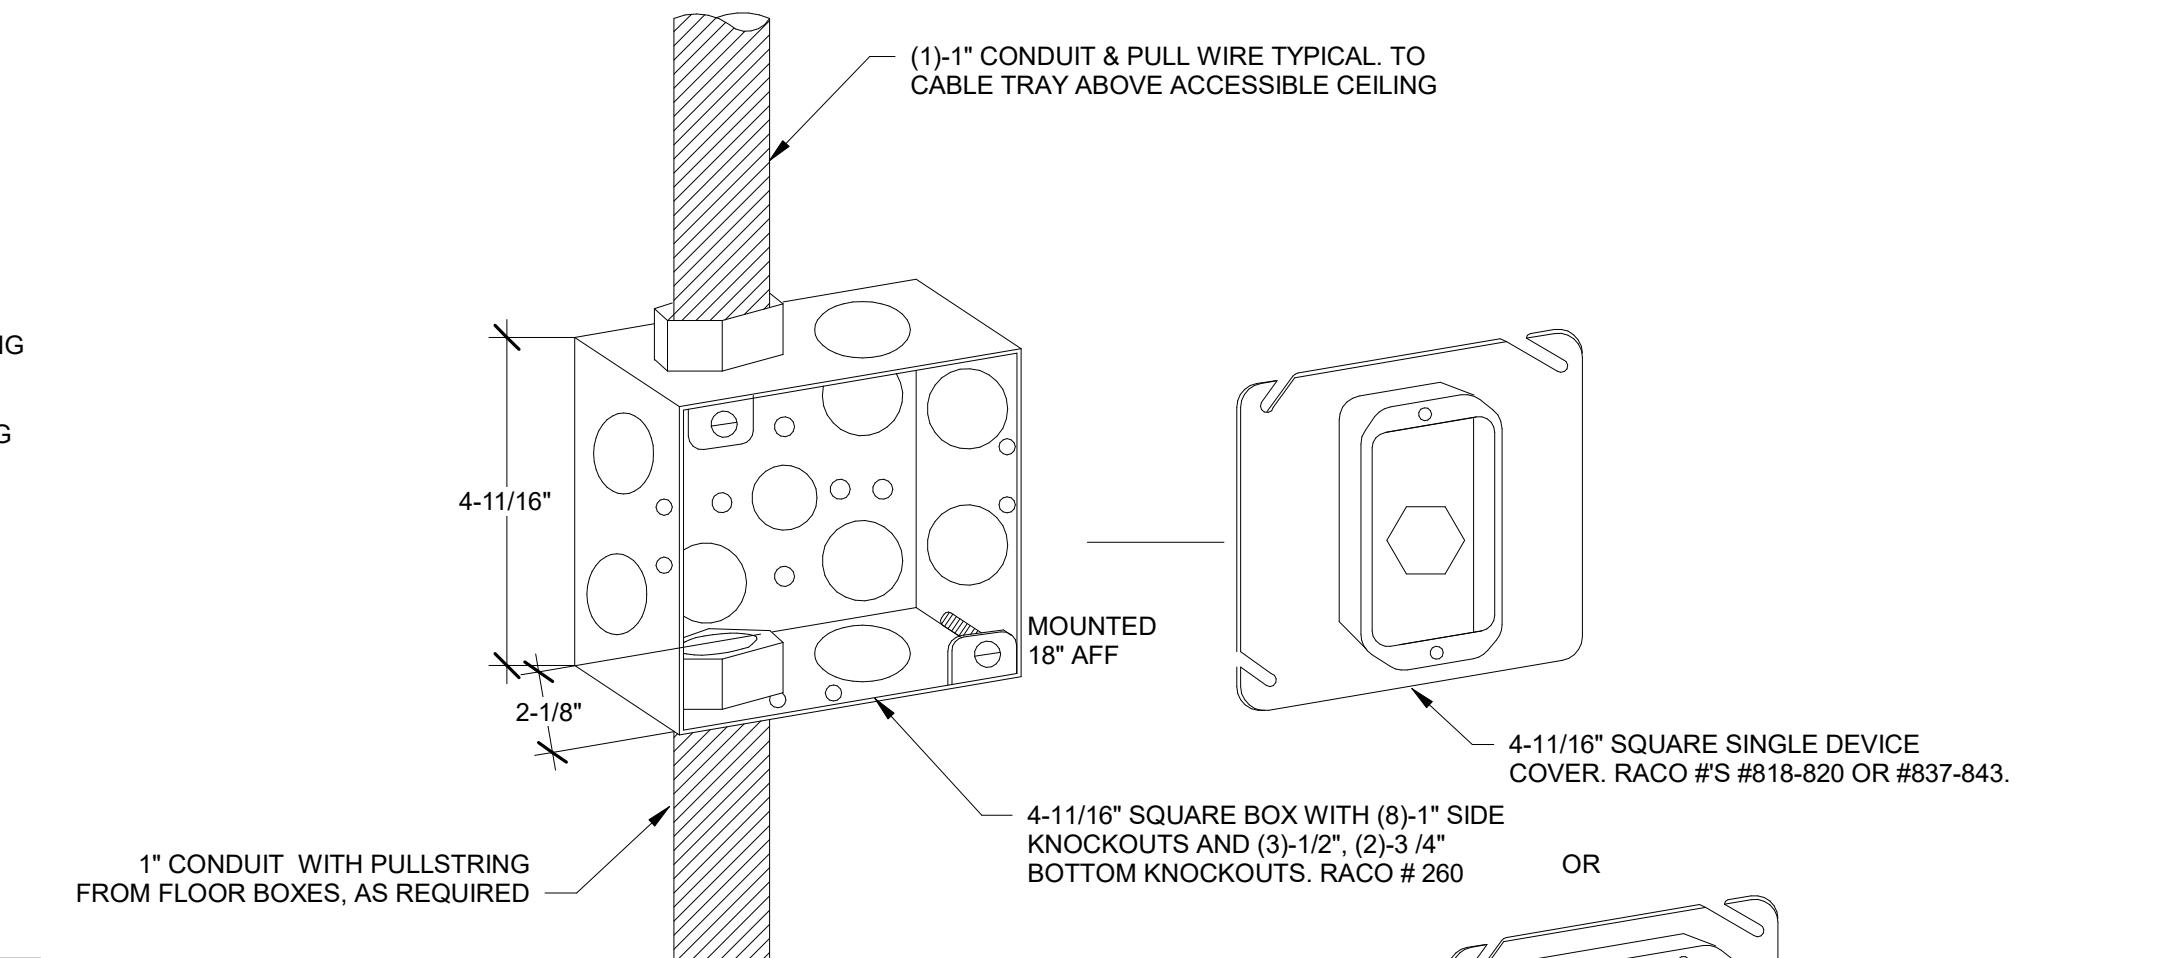

OTHER ACCEPTABLE MANUFACTURERS ARE APPLETON, T&B, AND MIDLAND ROSS/STEEL CITY

NOTES:

1. CONTRACTOR PROVIDE WALL BOXES AND CONDUIT ONLY. CONDUIT TO EXTEND AND TURN OUT ABOVE CEILING OR AN ACCESSIBLE SPACE ABOVE ADJACENT CEILING. 1C. MIN. PHONE/DATA CABLING BY TELECOMMUNICATIONS CONTRACTOR.
2. BOX AND RING NUMBERS SHOWN FOR STUD WALL CONSTRUCTION.
3. SUBSTITUTE MASONRY BOX EQUIVALENT WHERE LOCATED IN CMU OR CONCRETE WALLS.

## 1 TELE/DATA OUTLET BOX DETAIL

SCALE: NTS



## CONSTRUCTION SET



© 2024


Notch Design

CLIENT NAME: THE UNIVERSITY OF NORTH CAROLINA AT CHAPEL HILL  
JOB NAME: UNC VENABLE HALL LOWER LEVEL UPLIFT  
LOCATION: 101 South RD  
CHAPEL HILL, NC 27514

SCO ID: 24-28389-01A

**E501**

**ELECTRICAL DETAILS**

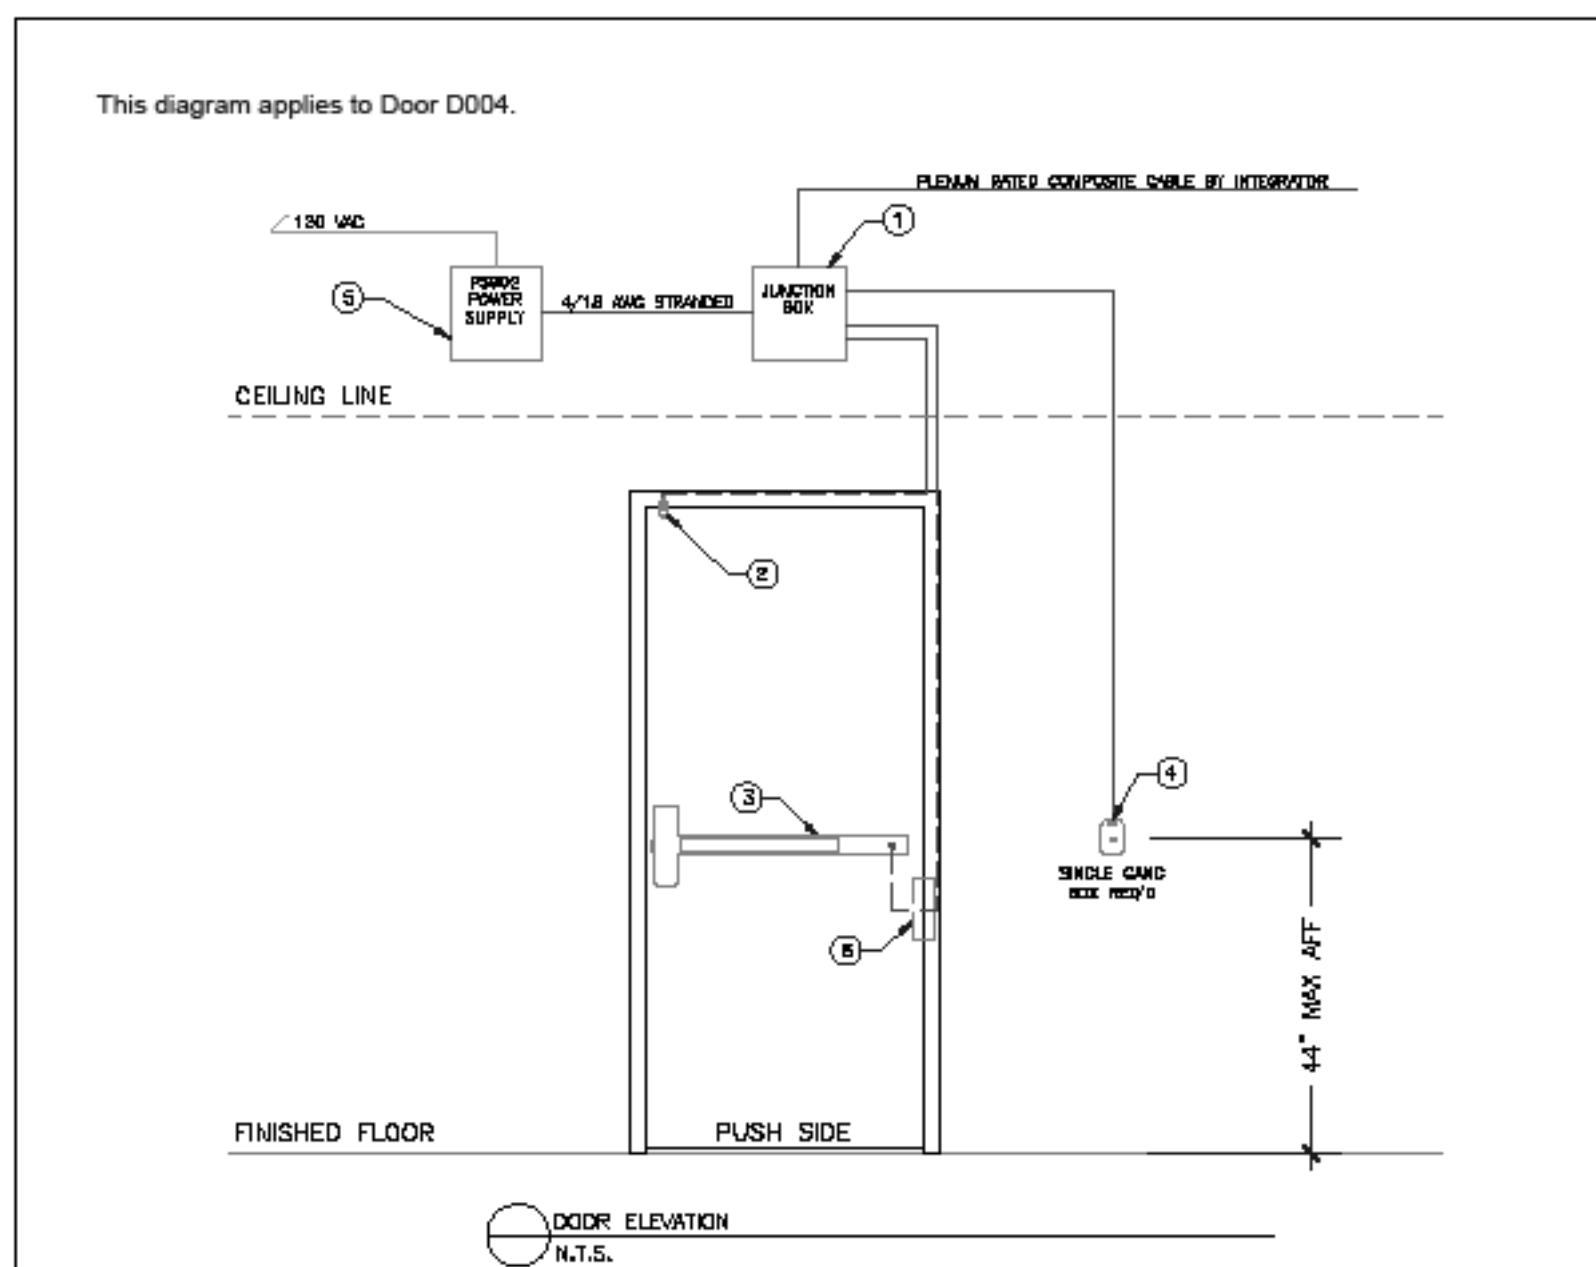


**DOOR HARDWARE**

- ① JUNCTION BOX BY OTHERS
- ② SQUARE STB-05 DOOR POSITION SWITCH
- ③ VON DUFEN RX-401 / FALCON RX-ML EXIT DEVICE (34 VDC)
- ④ SQUARE NT11 OR NT13
- ⑤ VON DUFEN PR02 X 400-285 POWER SUPPLY
- ⑥ VON DUFEN ELECTRIC POWER TRANSFER

**GENERAL NOTES:**  
ALL LOW VOLTAGE WIRE TO BE RUN IN MINIMUM 3/4" CONDUIT OR INSIDE DRYWALL UNLESS NOTED OTHERWISE  
ALL LOW VOLTAGE WIRE TO BE STRANDED WIRE  
ALL LOW VOLTAGE WIRING TO BE LABELED CLEARLY AT BOTH END  
ALL INDIVIDUAL HEIGHTS TO BE SHOWN  
COMPARISON OF HEIGHTS WITH ELECTRICAL/ARCHITECTURAL PLANS  
ANY DEVIATION FROM HARDWARE SPECIFIED IN SECTION 0610 WILL REQUIRE ALL REQUIREMENTS SHOWN  
HEREIN TO REQUIRE NEW DRAWINGS BY OTHERS TO MATCH SUBSTITUTED HARDWARE

**OPERATIONAL DESCRIPTION:**  
DOOR NORMALLY CLOSED AND LOCKED.  
DOOR WILL OPEN AND CLOSE FOR KEY AT LOCK.  
REQUEST TO EXIT SWITCH / SQUARE SHUTTER DOOR FORCED OPEN IN ACCESS CONTROL SYSTEM.  
KEY OVER-RIDE WILL RELEASE DOOR FORCED OPEN IN ACCESS CONTROL SYSTEM.  
DOOR CLOSURE FOR ALL TIMES DOOR FORCED OPEN IN ACCESS CONTROL SYSTEM.

Copyright 2021 Schlage Lock Company LLC.

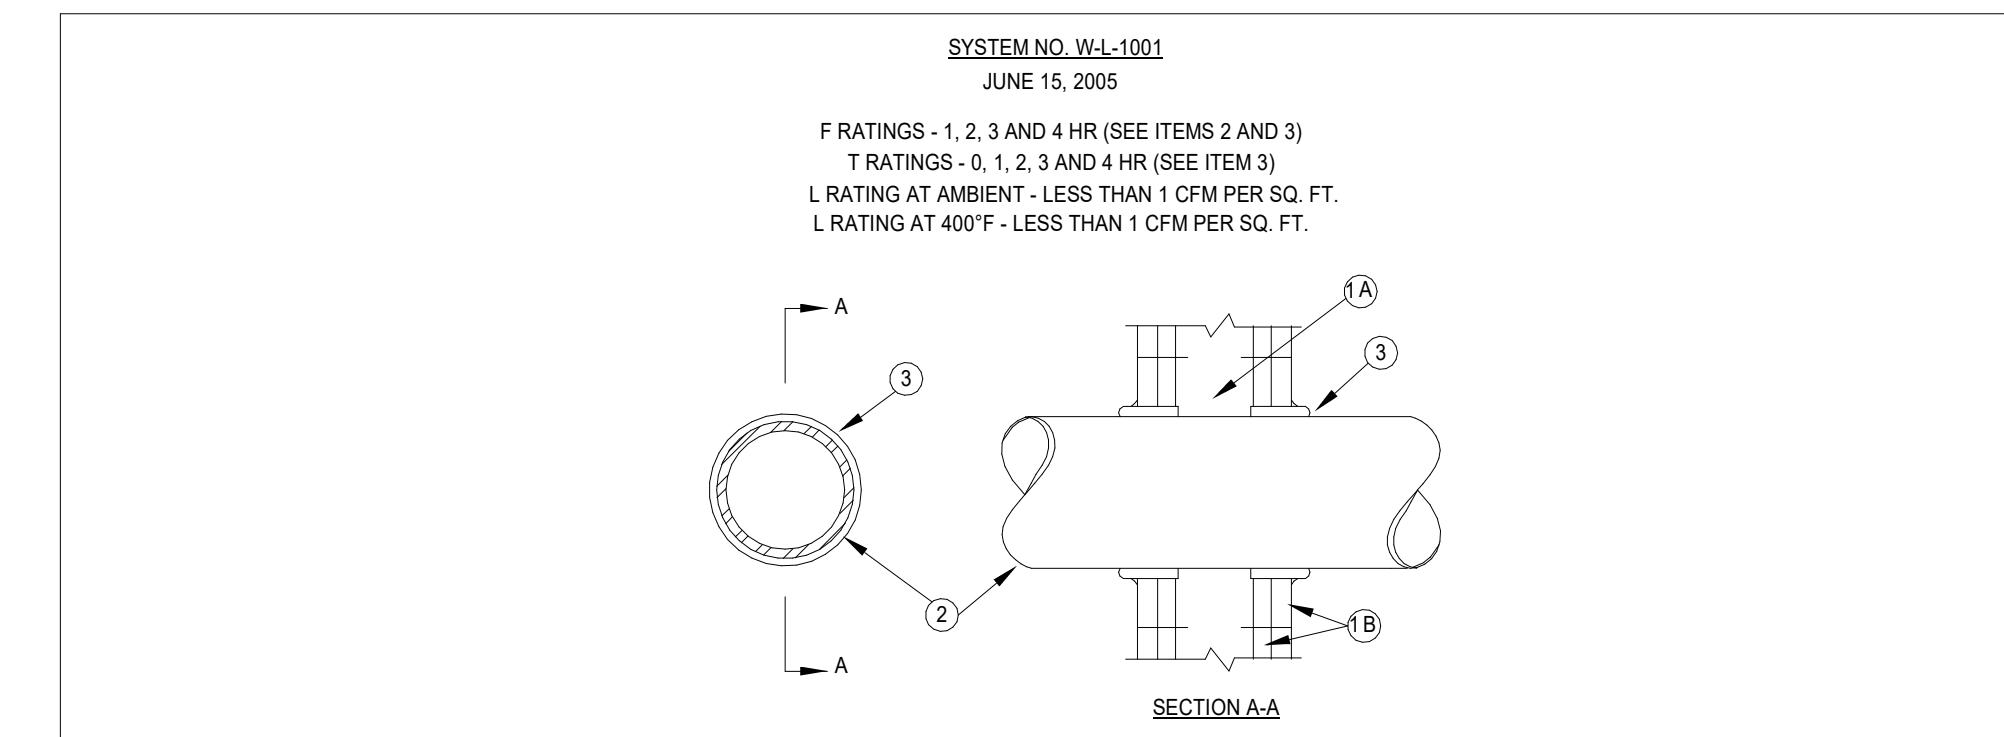

1. WALL ASSEMBLY - THE 1, 2, 3 OR 4 HR FIRE-RATED GYPSUM WALLBOARD/STUD WALL ASSEMBLY SHALL BE CONSTRUCTED OF THE MATERIALS AND IN THE MANNER DESCRIBED IN THE INDIVIDUAL U300 OR U400 SERIES WALL OR PARTITION DESIGNS IN THE UL FIRE RESISTANCE DIRECTORY AND SHALL INCLUDE THE FOLLOWING CONSTRUCTION FEATURES:

A. STUDS - WALL FRAMING MAY CONSIST OF EITHER WOOD STUDS (MAX 2 H FIRE RATED ASSEMBLIES) OR STEEL CHANNEL STUDS. WOOD STUDS TO CONSIST OF NOM 2 BY 4 IN. (51 BY 102 MM) LUMBER SPACED 16 IN. (406 MM) OC WITH NOM 2 BY 4 IN. (51 BY 102 MM) LUMBER END PLATES AND CLEAT SPACES. STEEL STUDS TO BE MIN 3-1/8 IN. (92 MM) WIDE BY 1-3/8 IN. (35 MM) DEEP CHANNELS SPACED MAX 24 IN. (610 MM) OC.

B. GYPSUM BOARD\* - NOM 1/2 OR 5/8 IN. (13 OR 16 MM) THICK, 4 FT. (122 CM) WIDE WITH SQUARE OR TAPERED EDGES. THE GYPSUM WALLBOARD TYPE, THICKNESS NUMBER OF LAYERS, FASTENER TYPE AND SHEET ORIENTATION SHALL BE AS SPECIFIED IN THE INDIVIDUAL U300 OR U400 SERIES DESIGN IN THE UL FIRE RESISTANCE DIRECTORY. MAX DIAM OF OPENING IS 26 IN. (660 MM).

2. THROUGH-PENETRANT - ONE METALLIC PIPE, CONDUIT OR TUBING INSTALLED EITHER CONCENTRICALLY OR ECCENTRICALLY WITHIN THE FIRESTOP SYSTEM. THE ANNUAL SPACE BETWEEN PIPE, CONDUIT OR TUBING AND PERIPHERY OF OPENING SHALL BE 0 IN. (0 MM) (POINT CONTACT) TO MAX 2 IN. (51 MM) PIPE. CONDUIT OR TUBING TO BE RIGIDLY SUPPORTED ON BOTH SIDES OF WALL ASSEMBLY. THE FOLLOWING TYPES AND SIZES OF METALLIC PIPES, CONDUITS OR TUBING MAY BE USED:

A. STEEL PIPE - NOM 24 IN. (610 MM) DIAM (OR SMALLER) SCHEDULE 10 (OR HEAVIER) STEEL PIPE.

B. IRON PIPE - NOM 24 IN. (610 MM) DIAM (OR SMALLER) SERVICE WEIGHT (OR HEAVIER) CAST IRON SOIL PIPE, NOM 12 IN. (305 MM) DIAM (OR SMALLER) OR CLASS 50 (OR HEAVIER) DUCTILE IRON PRESSURE PIPE.

C. CONDUIT - NOM 6 IN. (152 MM) DIAM (OR SMALLER) STEEL CONDUIT OR NOM 4 IN. (102 MM) DIAM (OR SMALLER) STEEL ELECTRICAL METALLIC TUBING.

D. COPPER TUBING - NOM 6 IN. (152 MM) DIAM (OR SMALLER) TYPE L (OR HEAVIER) COPPER TUBING.

E. COPPER PIPE - NOM 6 IN. (152 MM) DIAM (OR SMALLER) REGULAR (OR HEAVIER) COPPER PIPE.

F. THROUGH-PENETRATING PRODUCT\* - FLEXIBLE METAL PIPING THE FOLLOWING TYPES OF STEEL FLEXIBLE METAL GAS PIPING MAY BE USED:

1. NOM 3 IN. (85 MM) DIAM (OR SMALLER) STEEL FLEXIBLE METAL GAS PIPING. PLASTIC COVERING ON PIPING MAY OR MAY NOT BE REMOVED ON BOTH SIDES OF FLOR OR WALL ASSEMBLY.

OMEGA FLEX INC

2. NOM 1 IN. (25 MM) DIAM (OR SMALLER) STEEL FLEXIBLE METAL GAS PIPING. PLASTIC COVERING ON PIPING MAY OR MAY NOT BE REMOVED ON BOTH SIDES OF FLOR OR WALL ASSEMBLY.

TITEFLEX COP A BUNDY CO

3. NOM 1 IN. (25 MM) DIAM (OR SMALLER) STEEL FLEXIBLE METAL GAS PIPING. PLASTIC COVERING ON PIPING MAY OR MAY NOT BE REMOVED ON BOTH SIDES OF FLOR OR WALL ASSEMBLY.

WARD MFG INC

3. FILL, VOID OR CAVITY MATERIAL\* - CAULK OR SEALANT- MIN 5/8, 1-1/4, 1-7/8 AND 2-1/2 IN. (16, 32, 48 AND 64 MM) THICKNESS OF CAULK FOR 1, 2, 3 AND 4 HR RATED ASSEMBLIES.

RESPECTIVELY, APPLIED WITHIN ANNULUS, FLUSH WITH BOTH SURFACES OF WALL. MIN 1/4 IN. (6 MM) DIAM BEAD OF CAULK APPLIED TO GYPSUM BOARD/PENETRANT INTERFACE AT POINT OF PENETRATION. LENGTH OF CAULK APPLIED TO GYPSUM BOARD/PENETRANT INTERFACE OF THE FIRESTOP SYSTEM IS DEPENDENT UPON THE HOURLY FIRE RATING OF THE WALL ASSEMBLY IN WHICH IT IS INSTALLED, AS SHOWN IN THE FOLLOWING TABLE. THE HOURLY T RATING OF THE FIRESTOP SYSTEM IS DEPENDENT UPON THE TYPE OR SIZE OF THE PIPE OR CONDUIT AND THE HOURLY FIRE RATING OF THE WALL ASSEMBLY IN WHICH IT IS INSTALLED, AS TABULATED BELOW.

4. FIRESTOP SYSTEM - THE DETAILS OF THE FIRESTOP SYSTEM SHALL BE AS FOLLOWS:

A. PACKING MATERIAL - MIN 1 IN. (25 MM) THICKNESS OF FIRMLY PACKED MINERAL WOOL BATT INSULATION USED AS A PERMANENT FORM. PACKING MATERIAL TO BE RECESSED FROM TOP SURFACE OF FLOR OR SLEEVE OR FROM BOTH SURFACES OF WALL AS REQUIRED TO ACCOMMODATE THE REQUIRED THICKNESS OF CAULK FILL MATERIAL (ITEM B).

B. FILL, VOID OR CAVITY MATERIAL\* - CAULK OR SEALANT - APPLIED TO FILL THE ANNULAR SPACE FLUSH WITH THE TOP SURFACE OF THE FLOR OR SLEEVE OR FLUSH WITH BOTH SURFACES OF WALL. WHEN NOM PIPE COVERING THICKNESS IS 2 IN. (51 MM), MIN THICKNESS OF CAULK FILL MATERIAL IS 2 IN. (51 MM). WHEN NOM PIPE COVERING THICKNESS IS 1-1/2 IN. (38 MM) OR LESS, MIN THICKNESS OF CAULK FILL MATERIAL IS 1 IN. (25 MM). THE HOURLY F AND T RATINGS OF THE FIRESTOP SYSTEM ARE DEPENDENT UPON THE THICKNESS OF THE FLOR OR WALL, THE SIZE OF PIPE, THE THICKNESS OF PIPE COVERING MATERIAL AND THE SIZE OF THE ANNULAR SPACE (BETWEEN THE PIPE COVERING MATERIAL AND THE EDGE OF THE CIRCULAR THROUGH OPENING) AS SHOWN IN THE FOLLOWING TABLE:

3. PIPE COVERING\* - NOM 2 TO 2 IN. (13 TO 51 MM) THICK HOLLOW CYLINDRICAL HEAVY DENSITY (MIN 3.5 PCF OR 56 KG/M3) GLASS FIBER UNITS JACKETED ON THE OUTSIDE WITH AN ALL SERVICE JACKET. LONGITUDINAL JOINTS SEALED WITH METAL FASTENERS OR FACTORY-APPLIED SELF-SEALING LAP TAPE. TRANSVERSE JOINTS SECURED WITH METAL FASTENERS OR WITH BUTT STRIP TAPE SUPPLIED WITH THE PRODUCT.


MIN FLOOR OR WALL THKNS. IN. (MM)	MAX PIPE DIAM. IN. (MM)	NOM PIPE COVERING THKNS. IN. (MM)	ANNULAR SPACE IN. (MM)	F RATING HR.	T RATING HR.
2-1/2 (64)	4 (102)	1 or 1-1/2 (25 or 38)	1/2 to 2-1/2 (13 to 60)	2	1
4-1/2 (114)	4 (102)	2 (51)	1/4 to 5/8 (6 to 92)	2	1-1/2
2-1/2 (64)	12 (305)	1 (25)	1/2 to 1-1/2 (13 to 38)	2	1/2
4-1/2 (114)	12 (305)	1 (25)	1/2 to 2-3/8 (13 to 60)	3	1
2-1/2 (64)	12 (305)	1/2 (13)	1/2 to 2-3/8 (13 to 60)	2	0

+ WHEN COPPER PIPE IS USED, T RATING IS 0 H.

3M COMPANY - CP 25WB+ OR FB-3000 WT.

\* BEARING THE UL CLASSIFICATION MARK.

REPRINTED FROM THE UL ONLINE CERTIFICATIONS DIRECTORY WITH PERMISSION FROM UNDERWRITERS LABORATORIES INC.  
FILENAME = XHEZ-C-AJ-5001  
http://database.ul.com/cgi-bin/XV/template/LISEXT/1FRAME/gfilenbr.html  
TYPE WL-1001 IN UL FILE NUMBER BOX. CLICK ON SEARCH  
COPYRIGHT ©2016 BY UNDERWRITERS LABORATORIES INC. ©

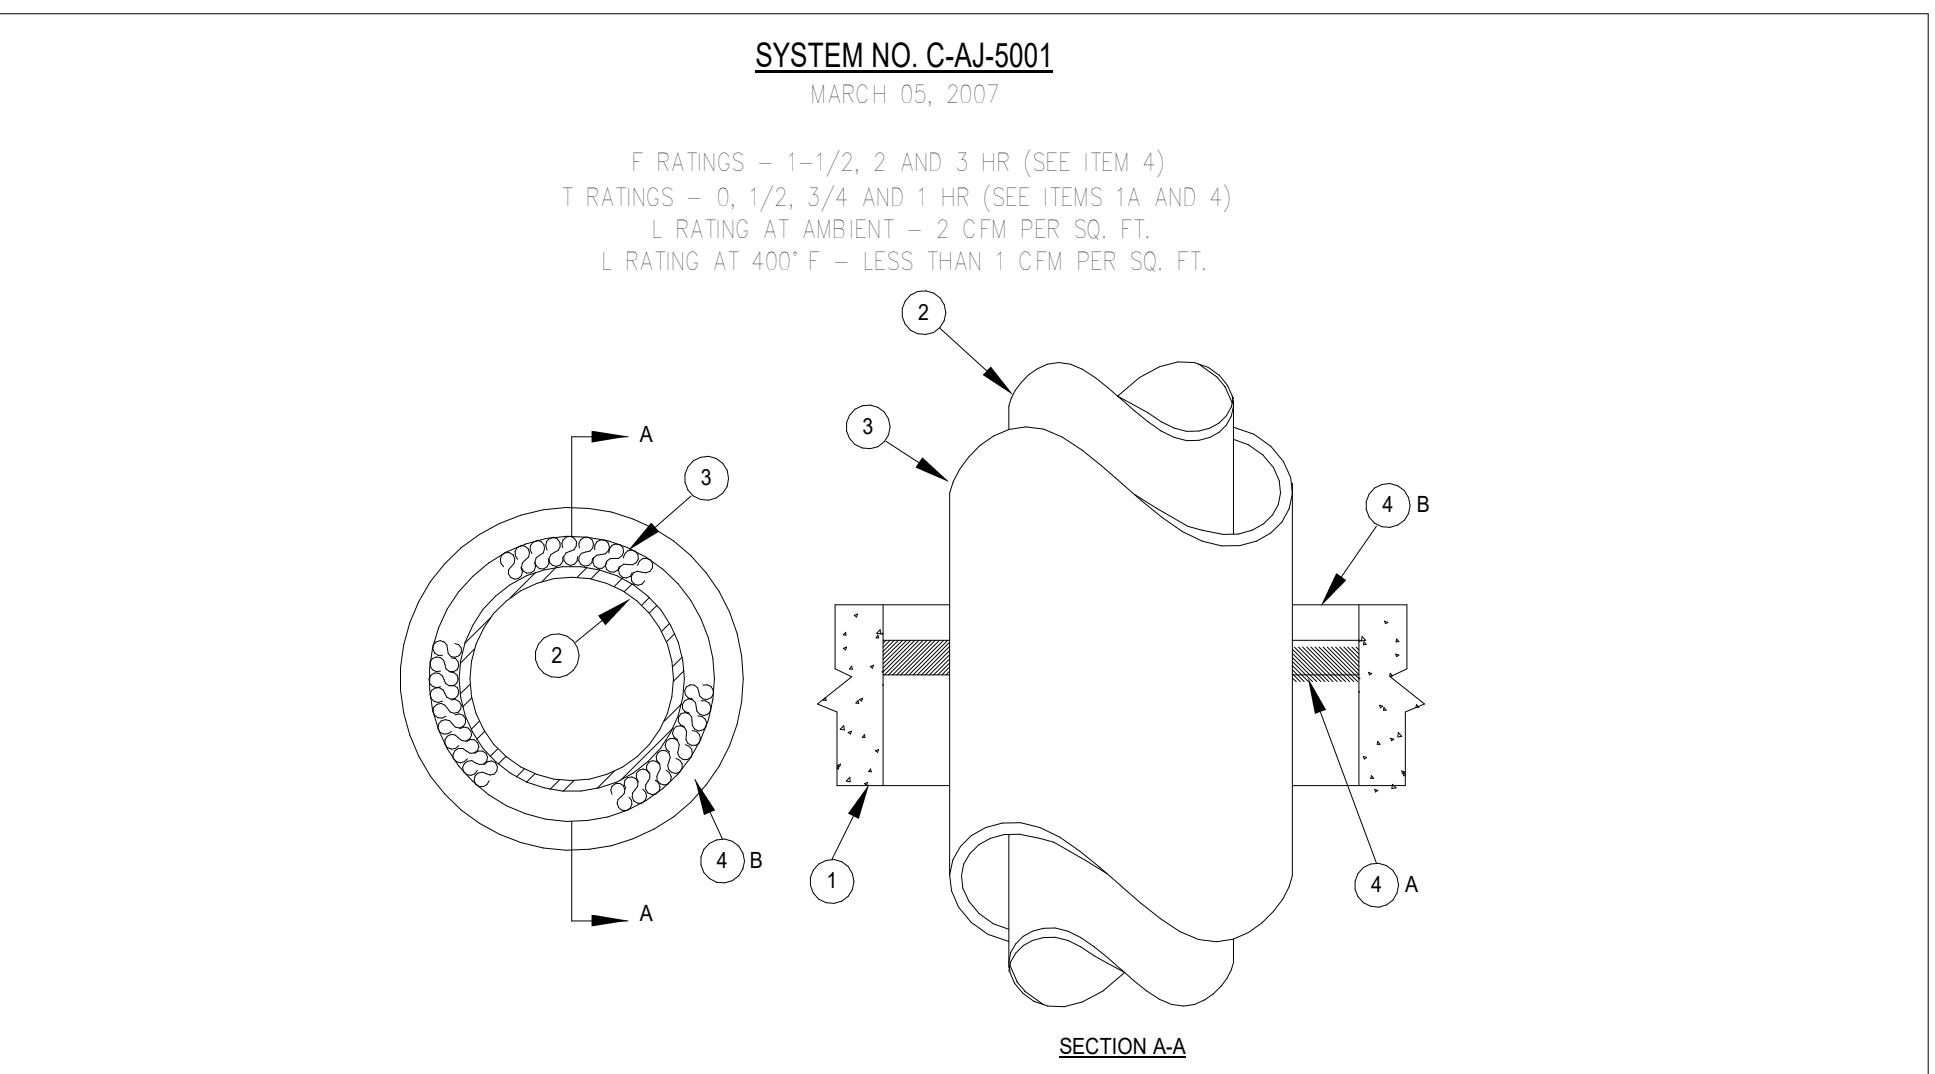

1. FLOOR OR WALL ASSEMBLY - MIN 2-1/2 IN. (64 MM) THICK REINFORCED LIGHTWEIGHT OR NORMAL WEIGHT (100-150 PCF OR 1600-2400 KG/M3) CONCRETE. WALL MAY ALSO BE CONSTRUCTED OF ANY UL CLASSIFIED CONCRETE BLOCKS\*. MAX DIAM OF OPENING IS 18 IN. (457 MM).

SEE PIPE AND EQUIPMENT COVERING - MATERIALS\* (BRGU) CATEGORY IN BUILDING MATERIALS DIRECTORY FOR NAMES OF MANUFACTURERS. ANY PIPE COVERING MATERIAL MEETING THE ABOVE SPECIFICATIONS AND BEARING THE UL CLASSIFICATION MARKING WITH A FLAME SPREAD INDEX OF 25 OR LESS AND A SMOKE DEVELOPED INDEX OF 50 OR LESS MAY BE USED.

2. FIRESTOP SYSTEM - THE DETAILS OF THE FIRESTOP SYSTEM SHALL BE AS FOLLOWS:

A. STEEL SLEEVE - (OPTIONAL, NOT SHOWN) - NOM 10 IN. (254 MM) (OR SMALLER) SCHEDULE 10 (OR HEAVIER) STEEL SLEEVE CAST OR GROUTED INTO FLOOR OR WALL ASSEMBLY. SLEEVE MAY EXTEND A MAX OF 2 IN. (51 MM) ABOVE TOP OF FLOOR OR BEYOND EITHER SURFACE OF WALL. AS AN ALTERNATE, NOM 10 IN. (254 MM) DIAM (OR SMALLER) SLEEVE FABRICATED FROM NOM 0.019 IN. (0.48 MM) THICK GALV STEEL CAST OR GROUTED INTO FLOOR OR WALL ASSEMBLY FLUSH WITH FLOOR OR WALL SURFACES. T RATING IS 0 WHEN SLEEVE IS USED.

B. FILL, VOID OR CAVITY MATERIAL\* - CAULK OR SEALANT - APPLIED TO FILL THE ANNULAR SPACE FLUSH WITH THE TOP SURFACE OF THE FLOOR OR SLEEVE OR FLUSH WITH BOTH SURFACES OF WALL. WHEN NOM PIPE COVERING THICKNESS IS 2 IN. (51 MM), MIN THICKNESS OF CAULK FILL MATERIAL IS 2 IN. (51 MM). WHEN NOM PIPE COVERING THICKNESS IS 1-1/2 IN. (38 MM) OR LESS, MIN THICKNESS OF CAULK FILL MATERIAL IS 1 IN. (25 MM). THE HOURLY F AND T RATINGS OF THE FIRESTOP SYSTEM ARE DEPENDENT UPON THE THICKNESS OF THE FLOOR OR WALL, THE SIZE OF PIPE, THE THICKNESS OF PIPE COVERING MATERIAL AND THE SIZE OF THE ANNULAR SPACE (BETWEEN THE PIPE COVERING MATERIAL AND THE EDGE OF THE CIRCULAR THROUGH OPENING) AS SHOWN IN THE FOLLOWING TABLE:


3. PIPE COVERING\* - NOM 2 TO 2 IN. (13 TO 51 MM) THICK HOLLOW CYLINDRICAL HEAVY DENSITY (MIN 3.5 PCF OR 56 KG/M3) GLASS FIBER UNITS JACKETED ON THE OUTSIDE WITH AN ALL SERVICE JACKET. LONGITUDINAL JOINTS SEALED WITH METAL FASTENERS OR FACTORY-APPLIED SELF-SEALING LAP TAPE. TRANSVERSE JOINTS SECURED WITH METAL FASTENERS OR WITH BUTT STRIP TAPE SUPPLIED WITH THE PRODUCT.

MIN FLOOR OR WALL THKNS. IN. (MM)	MAX PIPE DIAM. IN. (MM)	NOM PIPE COVERING THKNS. IN. (MM)	ANNULAR SPACE IN. (MM)	F RATING HR.	T RATING HR.
2-1/2 (64)	4 (102)	1 or 1-1/2 (25 or 38)	1/2 to 2-1/2 (13 to 60)	2	1
4-1/2 (114)	4 (102)	2 (51)	1/4 to 5/8 (6 to 92)	2	1-1/2
2-1/2 (64)	12 (305)	1 (25)	1/2 to 1-1/2 (13 to 38)	2	1/2
4-1/2 (114)	12 (305)	1 (25)	1/2 to 2-3/8 (13 to 60)	3	1
2-1/2 (64)	12 (305)	1/2 (13)	1/2 to 2-3/8 (13 to 60)	2	0

3M COMPANY - CP 25WB+ OR FB-3000 WT.

\* BEARING THE UL CLASSIFICATION MARK.

REPRINTED FROM THE UL ONLINE CERTIFICATIONS DIRECTORY  
FILENAME = XHEZ-C-AJ-5001  
http://database.ul.com/cgi-bin/XV/template/LISEXT/1FRAME/gfilenbr.html  
TYPE C-AJ-5001 IN UL FILE NUMBER BOX. CLICK ON SEARCH  
COPYRIGHT ©2016 BY UNDERWRITERS LABORATORIES INC. ©

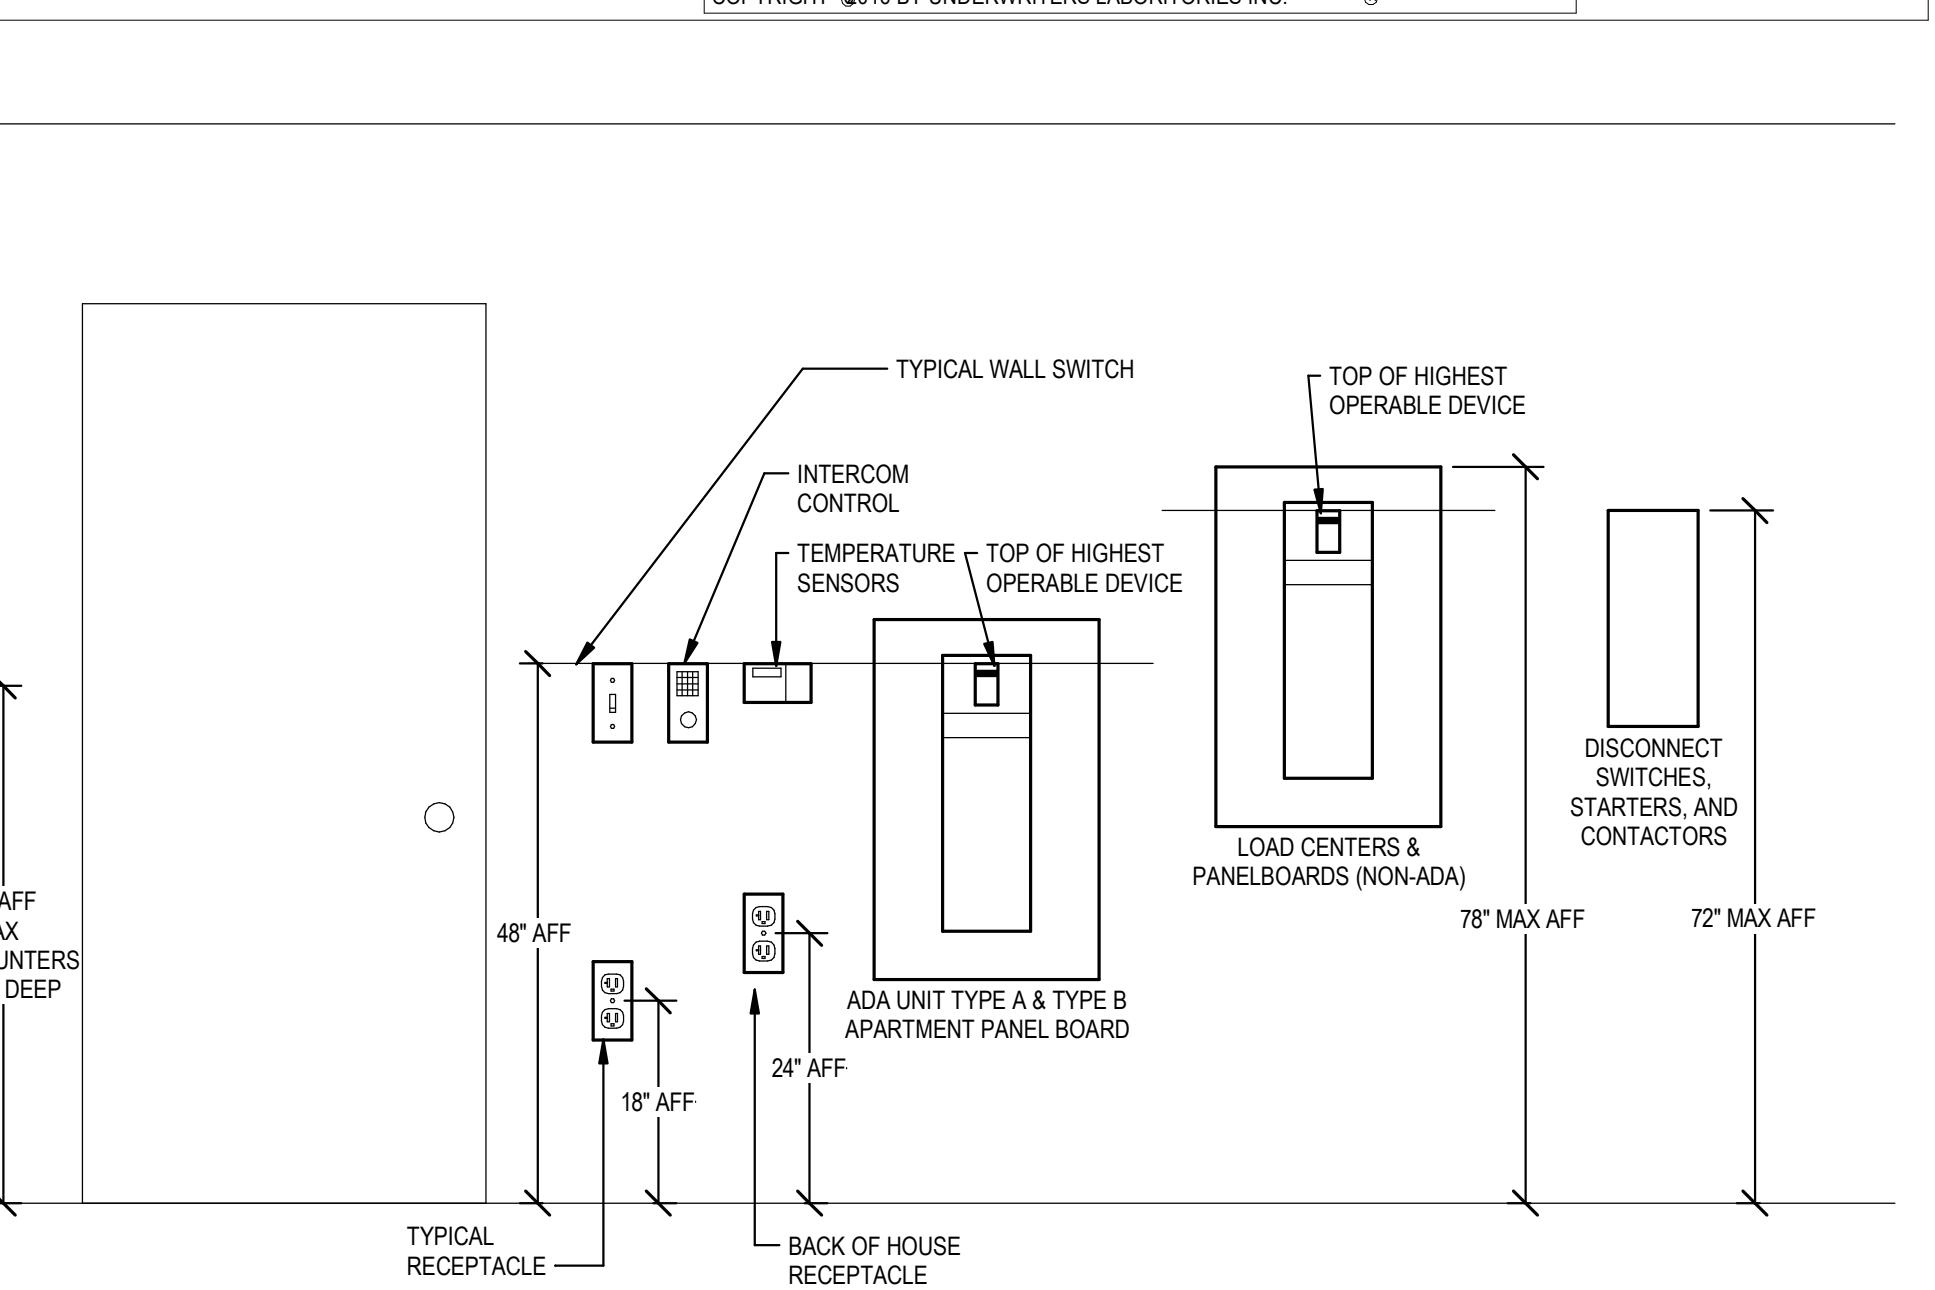

Door normally closed and locked.  
Door will open and close for key at lock.  
Request to exit switch / sensor shuts door forced open in access control system.  
key over-ride will cause door forced open in access control system.  
key over-ride will cause door forced open in access control system.

Copyright 2021 Schlage Lock Company LLC.

GENERAL NOTES:  
ALL LOW VOLTAGE WIRE TO BE RUN IN MINIMUM 3/4" CONDUIT OR INSIDE DRYWALL UNLESS NOTED OTHERWISE  
ALL LOW VOLTAGE WIRE TO BE STRANDED WIRE  
ALL LOW VOLTAGE WIRING TO BE LABELED CLEARLY AT BOTH END  
ALL INDIVIDUAL HEIGHTS TO BE SHOWN  
COMPARISON OF HEIGHTS WITH ELECTRICAL/ARCHITECTURAL PLANS  
ANY DEVIATION FROM HARDWARE SPECIFIED IN SECTION 0610 WILL REQUIRE ALL REQUIREMENTS SHOWN  
HEREIN TO REQUIRE NEW DRAWINGS BY OTHERS TO MATCH SUBSTITUTED HARDWARE

OPERATIONAL DESCRIPTION:



**NOTCH**  
NOTCH DESIGN, PLLC  
212 W MAIN ST, SUITE E,  
CARRBORO, NC  
www.notchdesign.us  
info@notchdesign.us


 **McKIM & CREED**  
www.mckimcreed.com  
4300 Edwards Mill Rd Suite 200  
Raleigh, NC 27612  
(919) 233-8091  
(919) 233-8031 Fax  
NC License# F-1222

REVISION 1 ADDENDUM 1 1/7/26

## CONSTRUCTION SET


© 2024  
Notch Design

CLIENT NAME: THE UNIVERSITY OF NORTH CAROLINA AT CHAPEL HILL  
JOB NAME: UNC VENABLE HALL LOWER LEVEL UPLIFT  
LOCATION: VENABLE HALL LOWER LEVEL  
101 South RD  
CHAPEL HILL, NC 27514  
SCO ID: 24-28389-01A

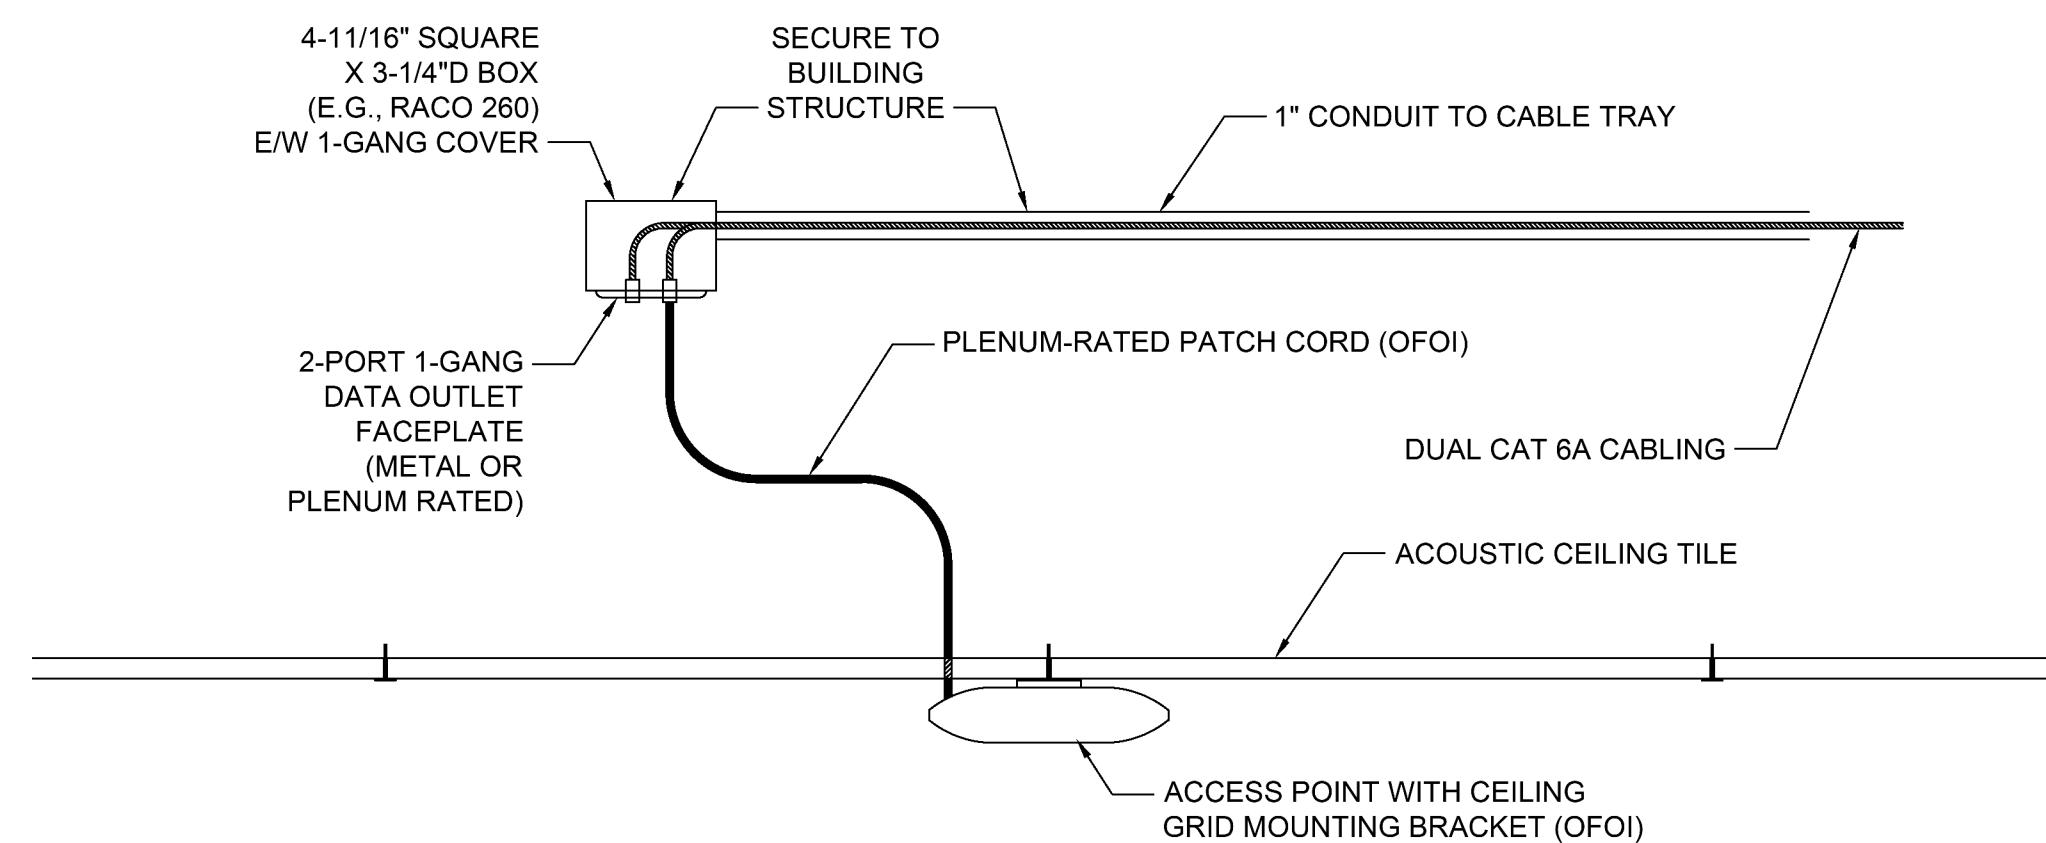

WIRELESS ACCESS POINT INSTALLATION IN ACT ENVIRONMENT

(NOTE: ALL COMPONENTS CFCI UON)

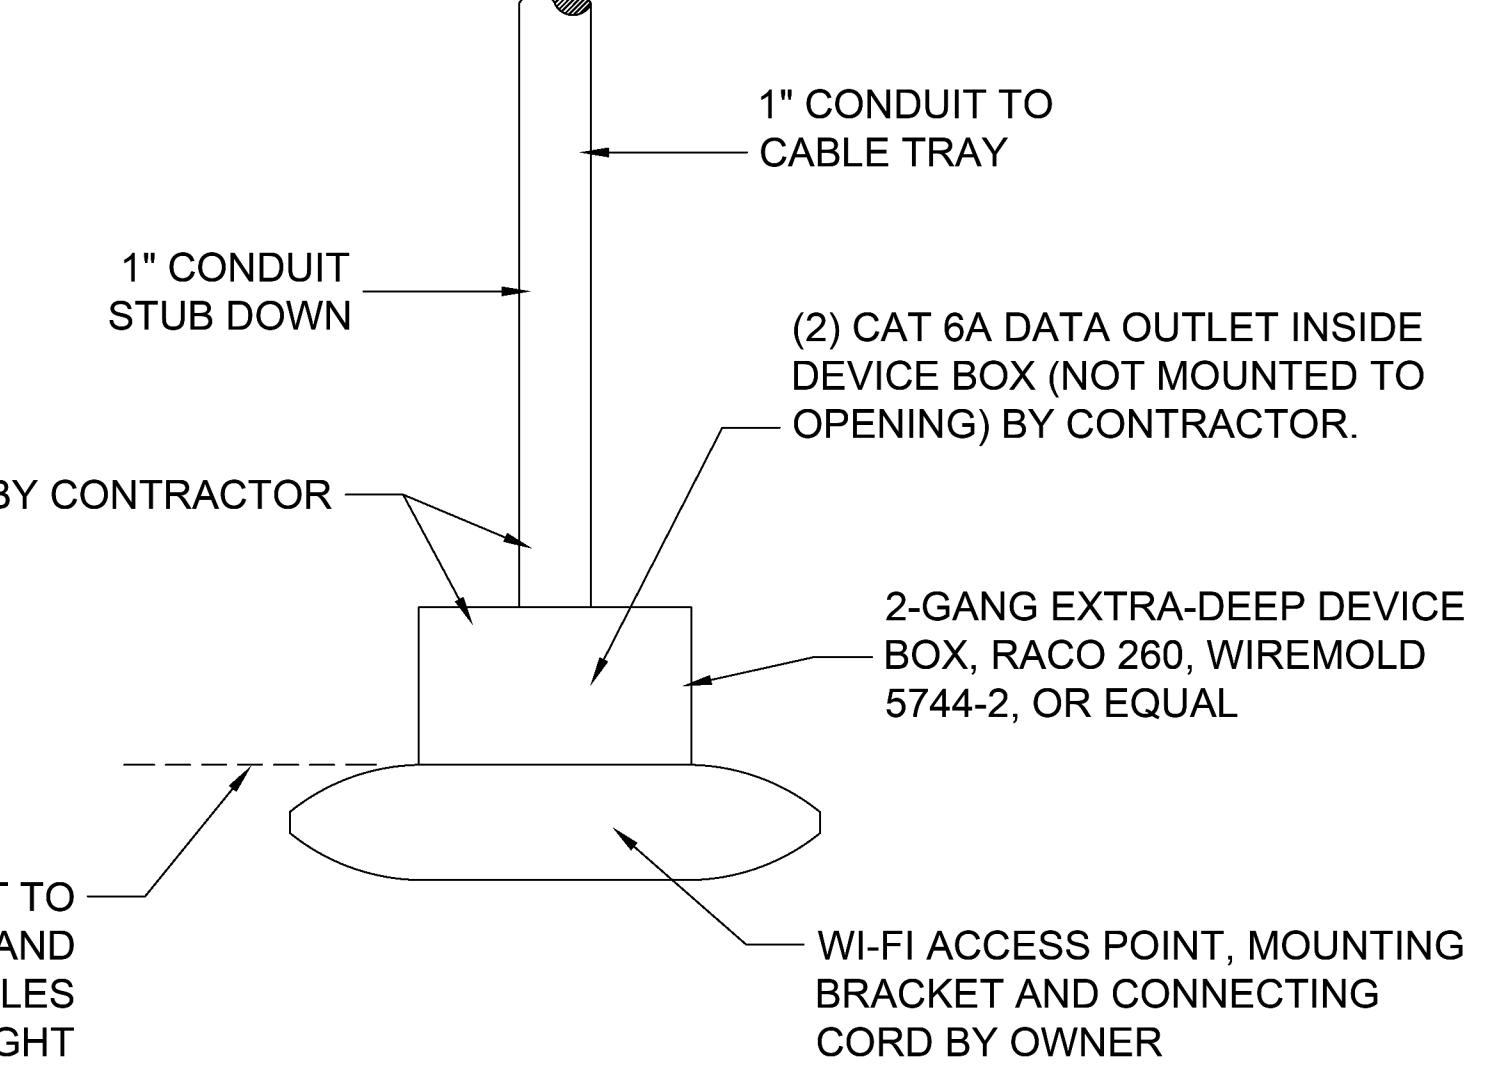

PENDANT MOUNT DETAIL FOR WI-FI ACCESS POINT

11-17-25

10021-0001

DWG. NO.

**E502**  
ELECTRICAL DETAILS



NOTCH DESIGN, PLLC  
212 W MAIN ST, SUITE E,  
CARRBORO, NC  
www.notchdesign.us  
info@notchdesign.us



www.mckimcreed.com  
4300 Edwards Mill Rd Suite 200  
Raleigh, NC 27612  
(919) 223-8091  
(919) 233-8031 Fax

NC License# F-1222

FIRE ALARM	
WALL	CEILING
	HORN AND STROBE FIRE ALARM SYSTEM. X = cd
	SPEAKER AND STROBE FIRE ALARM SYSTEM. X = cd
	HORN ONLY, FIRE ALARM SYSTEM.
	SPEAKER FIRE ALARM SYSTEM
	FIRE ALARM STROBE ONLY DEVICE. X=cd
	MANUAL FIRE ALARM PULL STATION
	DUCT DETECTOR, FURNISHED BY E.C. INSTALLED BY M.C. REQUIRED FOR ALL HVAC SYSTEM OVER 2000 CFM, COORDINATE FINAL COUNTS AND LOCATIONS WITH M.C.
	FLUSH MOUNTED CEILING FIRE ALARM SYSTEM DUCT DETECTOR REMOTE TEST STATION AND ALARM INDICATING LAMP.
	FIRE ALARM SYSTEM RELAY. SUBSCRIPT, WHEN SHOWN, INDICATES ZONE.
	LOCAL 120v SMOKE DETECTOR.
	SYSTEM SMOKE DETECTOR.
	SMOKE DETECTOR NOMENCLATURE
	P PHOTOELECTRIC
I IONIZATION	
	R RELAY BASE
	SYSTEM SMOKE DETECTOR WITH SOUNDER BASE
	SYSTEM SMOKE DETECTOR WITH STROBE BASE
	SYSTEM SMOKE DETECTOR FOR ELEVATOR RECALL.
	LOCAL 120v HEAT DETECTOR.
	SYSTEM HEAT DETECTOR.
	SYSTEM HEAT DETECTOR, RATE OF RISE
	SYSTEM HEAT DETECTOR, FIXED TEMP, # = ACTIVATING TEMP
	CARBON MONOXIDE DETECTOR
	CARBON DIOXIDE DETECTOR
	SYSTEM FIRE WATER FLOW MONITORING SWITCH.
	SYSTEM FIRE WATER TAMPER MONITORING SWITCH.
	MAGNETIC DOOR HOLD OPEN. PROVIDE 120v AND FIRE ALARM INTERFACE. HOLD OPEN WILL DE-ENERGIZE ALLOWING DOOR TO CLOSE WHEN FIRE ALARM IS ACTIVATED
	FIRE ALARM CONTROL PANEL
	FIRE ALARM ANNUNCIATOR PANEL
	FIRE ALARM POWER SUPPLY
	FIRE ALARM TERMINAL CABINET
	FIRE ALARM ADDRESSABLE CONTROL MODULE
	FIRE ALARM ZONE INTERFACE MODULE WITH RELAY
	PRESSURE SWITCH FOR DRY TYPE SPRINKLER SYSTEM. FURNISHED AND INSTALLED BY THE PLUMBING CONTRACTOR AND WIRED BY THE ELECTRICAL CONTRACTOR.
	GAS DETECTION SYSTEM
	FIRE SMOKE DAMPER (BY M.C.). PROVIDE DUCT DETECTOR, 120V POWER, CONTROL MODULE, & INTERFACE MODULE TO FIRE ALARM SYSTEM. COORDINATE FINAL COUNTS AND LOCATIONS WITH M.C.
	WALL MOUNTED HEAT OR SMOKE DETECTORS

CONSTRUCTION SET	
REVISION:	
SCO REVIEW	9/15/25
2nd SCO REVIEW	10/24/25
Construction Set	11/17/25
	© 2024 Notch Design

CLIENT NAME THE UNIVERSITY OF NORTH CAROLINA AT CHAPEL HILL	JOB NAME UNC VENABLE HALL LOWER LEVEL
LOCATION 101 South RD	LOCATION CHAPEL HILL, NC 27514
ISSUE DATE 11-17-25	SCO ID: 24-28389-01A
JOB NO. 10021-0001	DWG. NO.
FA001	ELECTRICAL FIRE ALARM LEGEND SHEET

#### FIRE ALARM GENERAL NOTES


1. THE WIRING REQUIREMENTS CHANGE FROM MANUFACTURER TO MANUFACTURER. VERIFY WIRING WITH THE FIRE ALARM MANUFACTURER AND INSTALL AS DIRECTED AND APPROVED.
2. THE FIRE ALARM SYSTEM PRODUCT DATA INFORMATION, BATTERY CALCULATIONS, VOLTAGE DROP CALCULATIONS, INSTALLATION DRAWINGS AND DETAILS WILL BE PROVIDED AS A DEFERRED SUBMISSION TO THE FIRE ALARM PERMIT REVIEWER FROM THE CONTRACTOR AFTER THE FIRE ALARM SYSTEM VENDOR HAS SUBMITTED THE INFORMATION TO BE REVIEWED AND APPROVED BY THE ENGINEER.
3. SOUND PRESSURE COVERAGE THROUGHOUT THE BUILDING WILL BE DETERMINED AFTER THE FIRE ALARM SYSTEM HAS BEEN INSTALLED. ADDITIONAL DEVICES WILL BE ADDED IF THE COVERAGE IS DEEMED TO BE INADEQUATE BY THE INSPECTOR DURING THE FIRE ALARM SYSTEM TEST.
4. 25 PERCENT SPARE CAPACITY SHALL BE PROVIDED ON ALL NOTIFICATION APPLIANCE CIRCUITS FOR ANY ADDITIONAL DEVICES THAT MAY BE ADDED IN THE FUTURE. ALL EMPLOYEE WORK AREAS SHALL HAVE AUDIBLE AND VISUAL ALARMES.
5. ALL AUDIBLE DEVICES SHALL PROVIDE A SOUND PRESSURE LEVEL OF 15 DECIBELS ABOVE THE AVERAGE AMBIENT SOUND LEVEL OR 5 DECIBELS ABOVE THE MAXIMUM SOUND LEVEL FOR A DURATION OF NOT LESS THAN 60 SECONDS, WHICHEVER IS GREATER. PER 907.5.2.1.

System Outputs	
System Inputs	
Manual Pull Station Ground Floor	X
Manual Pull Station First Floor	X
Manual Pull Station Second Floor	X
Manual Pull Station Third Floor	X
Manual Pull Station Fourth Floor	X
Manual Pull Station Penthouse	X
Smoke Detector Ground Floor	X
Smoke Detector First Floor	X
Smoke Detector Second Floor	X
Smoke Detector Third Floor	X
Smoke Detector Fourth Floor	X
Smoke Detector Penthouse	X
Smoke Detector Bldg. Lobby G	
Smoke Detector Bldg. Lobby 1	
Smoke Detector Bldg. Lobby 2	
Smoke Detector Bldg. Lobby 3	
Smoke Detector Bldg. Lobby 4	
Smoke Detector Bldg. Lobby P	
Heat Detector Ground Floor	X
Heat Detector First Floor	X
Heat Detector Second Floor	X
Heat Detector Third Floor	X
Heat Detector Fourth Floor	X
Heat Detector Penthouse	X
Duct Mounted Smoke Detectors At Fire/Smoke Dampers	X
AHU-1 Duct Mounted Smoke Detector	X
AHU-2 Duct Mounted Smoke Detector	X
AHU-3A Duct Mounted Smoke Detector	X
AHU-3B Duct Mounted Smoke Detector	X
AHU-4 Duct Mounted Smoke Detector	X
Sprinkler Main Waterflow	X
Sprinkler Ground Floor Zone Waterflow	X
Sprinkler First Floor Zone Waterflow	X
Sprinkler Second Floor Zone Waterflow	X
Sprinkler Third Floor Zone Waterflow	X
Sprinkler Fourth Floor Zone Waterflow	X
Sprinkler Penthouse Zone Waterflow	X
Sprinkler Tamper Switch	
Fire Alarm AC Power Failure	
Fire Alarm Low Battery	
Open Circuit	
Ground Fault	
Notification Appliance Circuit Short	
General Alarm (Keman)	

#### FIRE ALARM MATRIX

3

SCALE: NTS

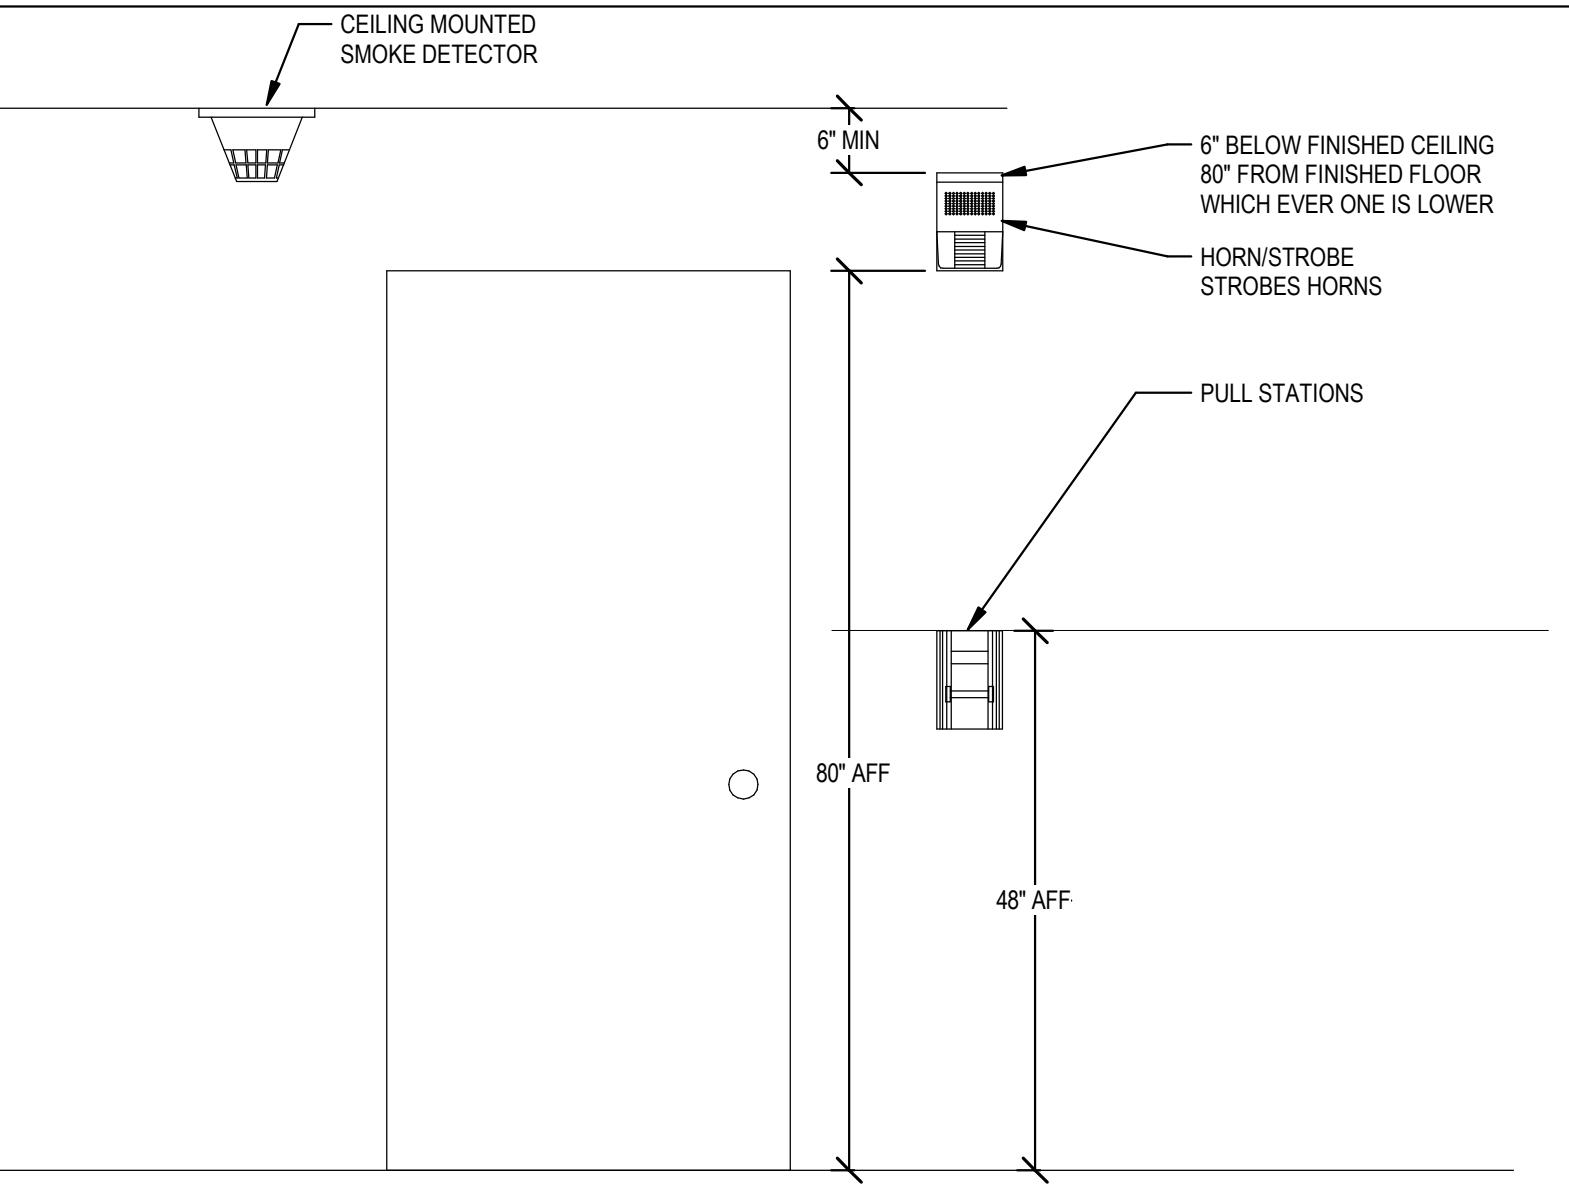

1

DEVICE MOUNTING HEIGHT DETAIL

SCALE: NTS

MOUNTING HEIGHT SCHEDULE	
4-INCHES BELOW THE FINISHED CEILING TO TOP OF DEVICE AND NOT MORE THAN 12-INCHES TO BOTTOM OF DEVICE.	TOP OF WALL MOUNTED HEAT OR SMOKE DETECTORS
6'-8" AFF OR 6' BELOW FINISHED CEILING, WHICHEVER IS LOWER (BOTTOM OF LENS, MIN.) 96-INCHES AFF MAXIMUM.	TOP OF FIRE ALARM HORNS/STROBES
6'-0"	TOP OF FIRE ALARM CONTROL PANEL
4'-0" MAX	TOP OF PULL HANDLE ON FIRE ALARM PULL STATIONS
0'-0"	FINISHED FLOOR

CLIENT NAME THE UNIVERSITY OF NORTH CAROLINA AT CHAPEL HILL	JOB NAME UNC VENABLE HALL LOWER LEVEL
LOCATION 101 South RD	LOCATION CHAPEL HILL, NC 27514
ISSUE DATE 11-17-25	SCO ID: 24-28389-01A
JOB NO. 10021-0001	DWG. NO.
FA001	ELECTRICAL FIRE ALARM LEGEND SHEET



**NOTCH**  
NOTCH DESIGN, PLLC  
212 W MAIN ST, SUITE E,  
CARRBORO, NC  
www.notchdesign.us  
info@notchdesign.us



www.mckimcreed.com  
4300 Edwards Mill Rd Suite 200  
Raleigh, NC 27612  
(919) 223-8091  
(919) 233-8031 Fax

NC License# F-1222

REVISION  
SCO REVIEW 9/15/25  
2nd SCO REVIEW 10/24/25  
Construction Set 11/17/25

## CONSTRUCTION SET



© 2024  
Notch Design

CLIENT NAME: THE UNIVERSITY OF NORTH CAROLINA AT CHAPEL HILL  
JOB NAME: UNC VENABLE HALL LOWER LEVEL UPLIFT

LOCATION: 101 South RD  
CHAPEL HILL, NC 27514


SCO ID: 24-28389-01A

### DEMOLITION GENERAL NOTES

- ALL PENETRATIONS OF EXISTING FLOORS AND FIRE RATED WALL OR SMOKE PARTITIONS SHALL BE PATCHED & REPAIRED AS REQUIRED TO MAINTAIN THE EXISTING FIRE RATING OR SMOKE INfiltration INTEGRITY OF THE WALL, ALL SLEEVES, WIREWAYS, CABLE TRAYS, PIPES, DUCTWORK, ETC. SHALL BE FIRE SEALED TIGHT TO THE WALL OR FLOOR PENETRATIONS TO MAINTAIN THE REQUIRED CODE COMPLIANT FIRE RATING.
- ELECTRICAL CONTRACTOR SHALL FIELD VERIFY AND COORDINATE ALL EXISTING CONDITIONS, LOCATIONS, AND CIRCUITING OF ALL EXISTING ELECTRICAL EQUIPMENT LOCATED IN THE AREA OF CONSTRUCTION INCLUDING EQUIPMENT LOCATED IN ADJACENT AREAS SERVED BY THE CIRCUITING LOCATED IN THESE SPACES.
- DEMOLITION WORK SHALL BE COMPLETED IN FULL. ALL CONDUIT AND WIRING SHALL BE DEMOLISHED BACK TO SOURCE UNLESS OTHERWISE NOTED. PANELS SCHEDULES SHALL BE UPDATED WHERE APPLICABLE. NO RACEWAY SHALL BE ABANDONED IN PLACE UNLESS SPECIFICALLY NOTED ON DRAWINGS.
- IN AREAS OF REMOVAL OF WALL AND CEILING MOUNTED DEVICES, CONTRACTOR SHALL REPAIR, PATCH AND CLEAN WALLS, WALL BASES, AND CEILING AS REQUIRED TO MATCH EXISTING FINISHES.
- CONTRACTOR SHALL MAINTAIN ALL CIRCUITS RUNNING THROUGH THE AREA OF DEMOLITION AND THE AREA OF NEW CONSTRUCTION.

### DEMOLITION KEY NOTES

- EXISTING HORN STROBE/STROBE, SMOKE DETECTOR SHOWN IN HATCH SHALL BE REMOVED. EXISTING CONDUIT(S) AND CABLEING SHALL BE DEMOLISHED AS REQUIRED.
- EXISTING CEILING MOUNTED SPEAKER STROBE SHALL BE DISCONNECTED AND SALVAGED TO BE INSTALLED IN NEW LOCATION OR RETURNED TO OWNER. COORDINATE WITH OWNER.
- EXISTING DUCT DETECTOR TO REMAIN, ASSOCIATED RAIL DEVICES SHALL BE TEMPORARILY DISCONNECTED AND MADE READY TO BE RELOCATED TO NEW LOCATION. COORDINATE WITH MECHANICAL CONTRACTOR AND OWNER.

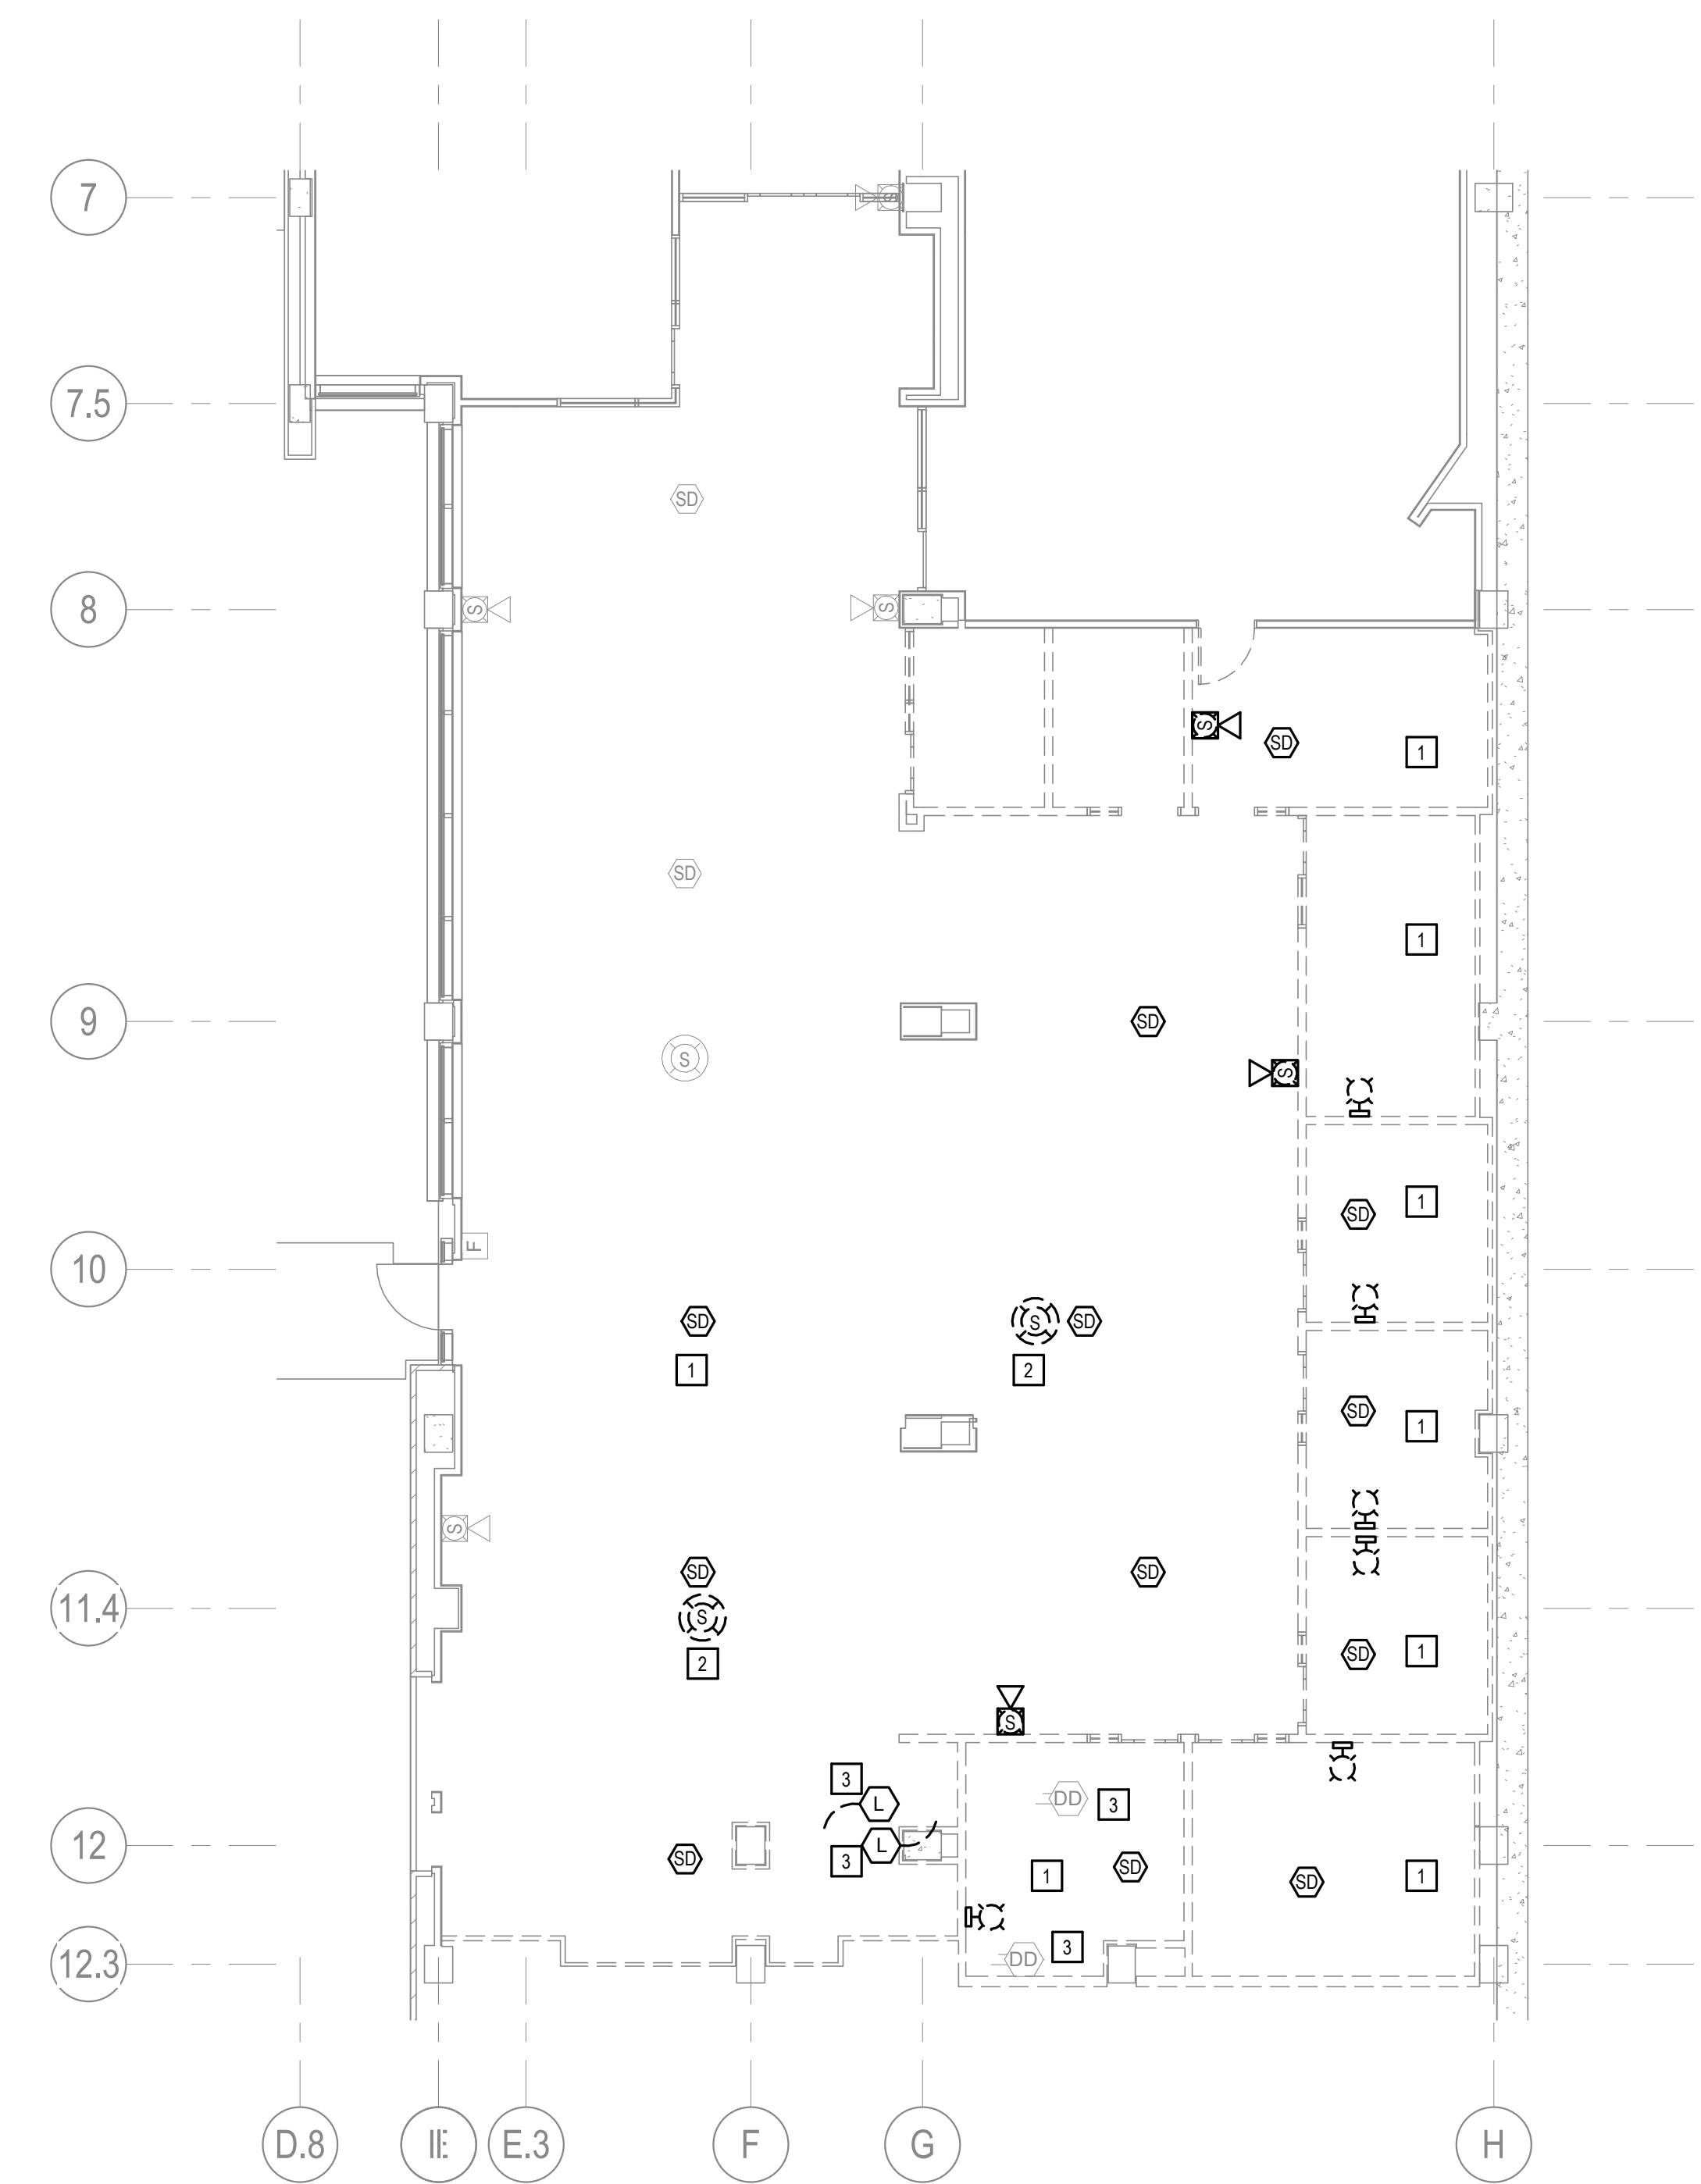

1 GROUND FLOOR DEMO PLAN - FIRE ALARM


SCALE: 1/8" = 1'-0"

### NEW WORK GENERAL NOTES

- ELECTRICAL CONTRACTOR SHALL FIELD VERIFY AND COORDINATE ALL EXISTING CONDITIONS, LOCATIONS, AND CIRCUITING OF ALL EXISTING ELECTRICAL (POWER, LIGHTING, SPECIAL SYSTEMS, ETC.) EQUIPMENT LOCATED IN AREAS OF DEMOLITION/CONSTRUCTION INCLUDING EQUIPMENT LOCATED IN ADJACENT AREAS SERVED BY CIRCUITING LOCATED IN THESE SPACES. THE CONTRACTOR SHALL VISIT THE JOB SITE AND BECOME FAMILIAR WITH ALL EXISTING CONDITIONS PRIOR TO BID AND ANY WORK.
- IN AREAS OF REMOVAL OF WALL AND CEILING MOUNTED DEVICES, CONTRACTOR SHALL REPAIR, PATCH AND CLEAN WALLS, WALL BASES, AND CEILING AS REQUIRED TO MATCH EXISTING FINISHES.
- REFER TO DRAWING FA001 FOR FIRE ALARM GENERAL PROJECT NOTES, SYMBOLS & ABBREVIATIONS.

### NEW WORK KEYED NOTES:

- PROVIDE NEW FIRE ALARM NOTIFICATION DEVICE, SMOKE DETECTOR(S), CABLEING, RACEWAY, ETC. AS REQUIRED FOR COMPLETE INSTALLATION. DEVICE AND WIRING SHALL MATCH EXISTING AND BE UL LISTED FOR USE WITH EXISTING SYSTEM. CONTRACTOR SHALL PROVIDE CALCULATIONS TO CONFIRM POWER SUPPLY/CIRCUIT WILL ACCOMMODATE MODIFICATIONS AS REQUIRED.
- FIRE ALARM SYSTEM OPERATING MATRIX SHALL MATCH EXISTING. COORDINATE WITH OWNER. TYPICAL FOR ALL SPACES. FIRE ALARM SYSTEM SHALL BE TESTED PER NFPA 72 2013 SECTION 14.4.2 - REACCEPTANCE TESTING UPON COMPLETION OF THE INSTALLATION. NEW VISUAL NOTIFICATION DEVICES SHALL SYNC WITH ANY VISUAL NOTIFICATION DEVICES OUTSIDE PROJECT PARAMETERS IF TWO (2) OR MORE CAN BE SEEN. COORDINATE PRE-TEST OF FIRE ALARM SYSTEM WITH OWNER.
- UPON COMPLETION OF THE INSTALLATION, PROVIDE TESTING OF THE FIRE ALARM SYSTEM PER NFPA 72 REQUIREMENTS AS WELL AS PROVIDING AN UPDATED NFPA 72 2013 RECORD OF COMPLETION FOR THE CURRENT VERSION OF THE CODE BEING UTILIZED BY SCO. THIS TESTING SHALL INCLUDE 100% TESTING OF ALL NEW DEVICES AS WELL AS 10% OF THE EXISTING DEVICES, ETC. TYPICAL OR ALL AREAS OF FIRE ALARM WORK. COORDINATE ALL TESTING AND SCHEDULING WITH OWNER.
- NEW LOCATION OF EXISTING RAIL LIGHTS. EXTEND CONDUIT AND CONDUCTOR AS NECESSARY.
- NEW SMOKE DETECTOR SHALL BE MOUNTED TO DECK.

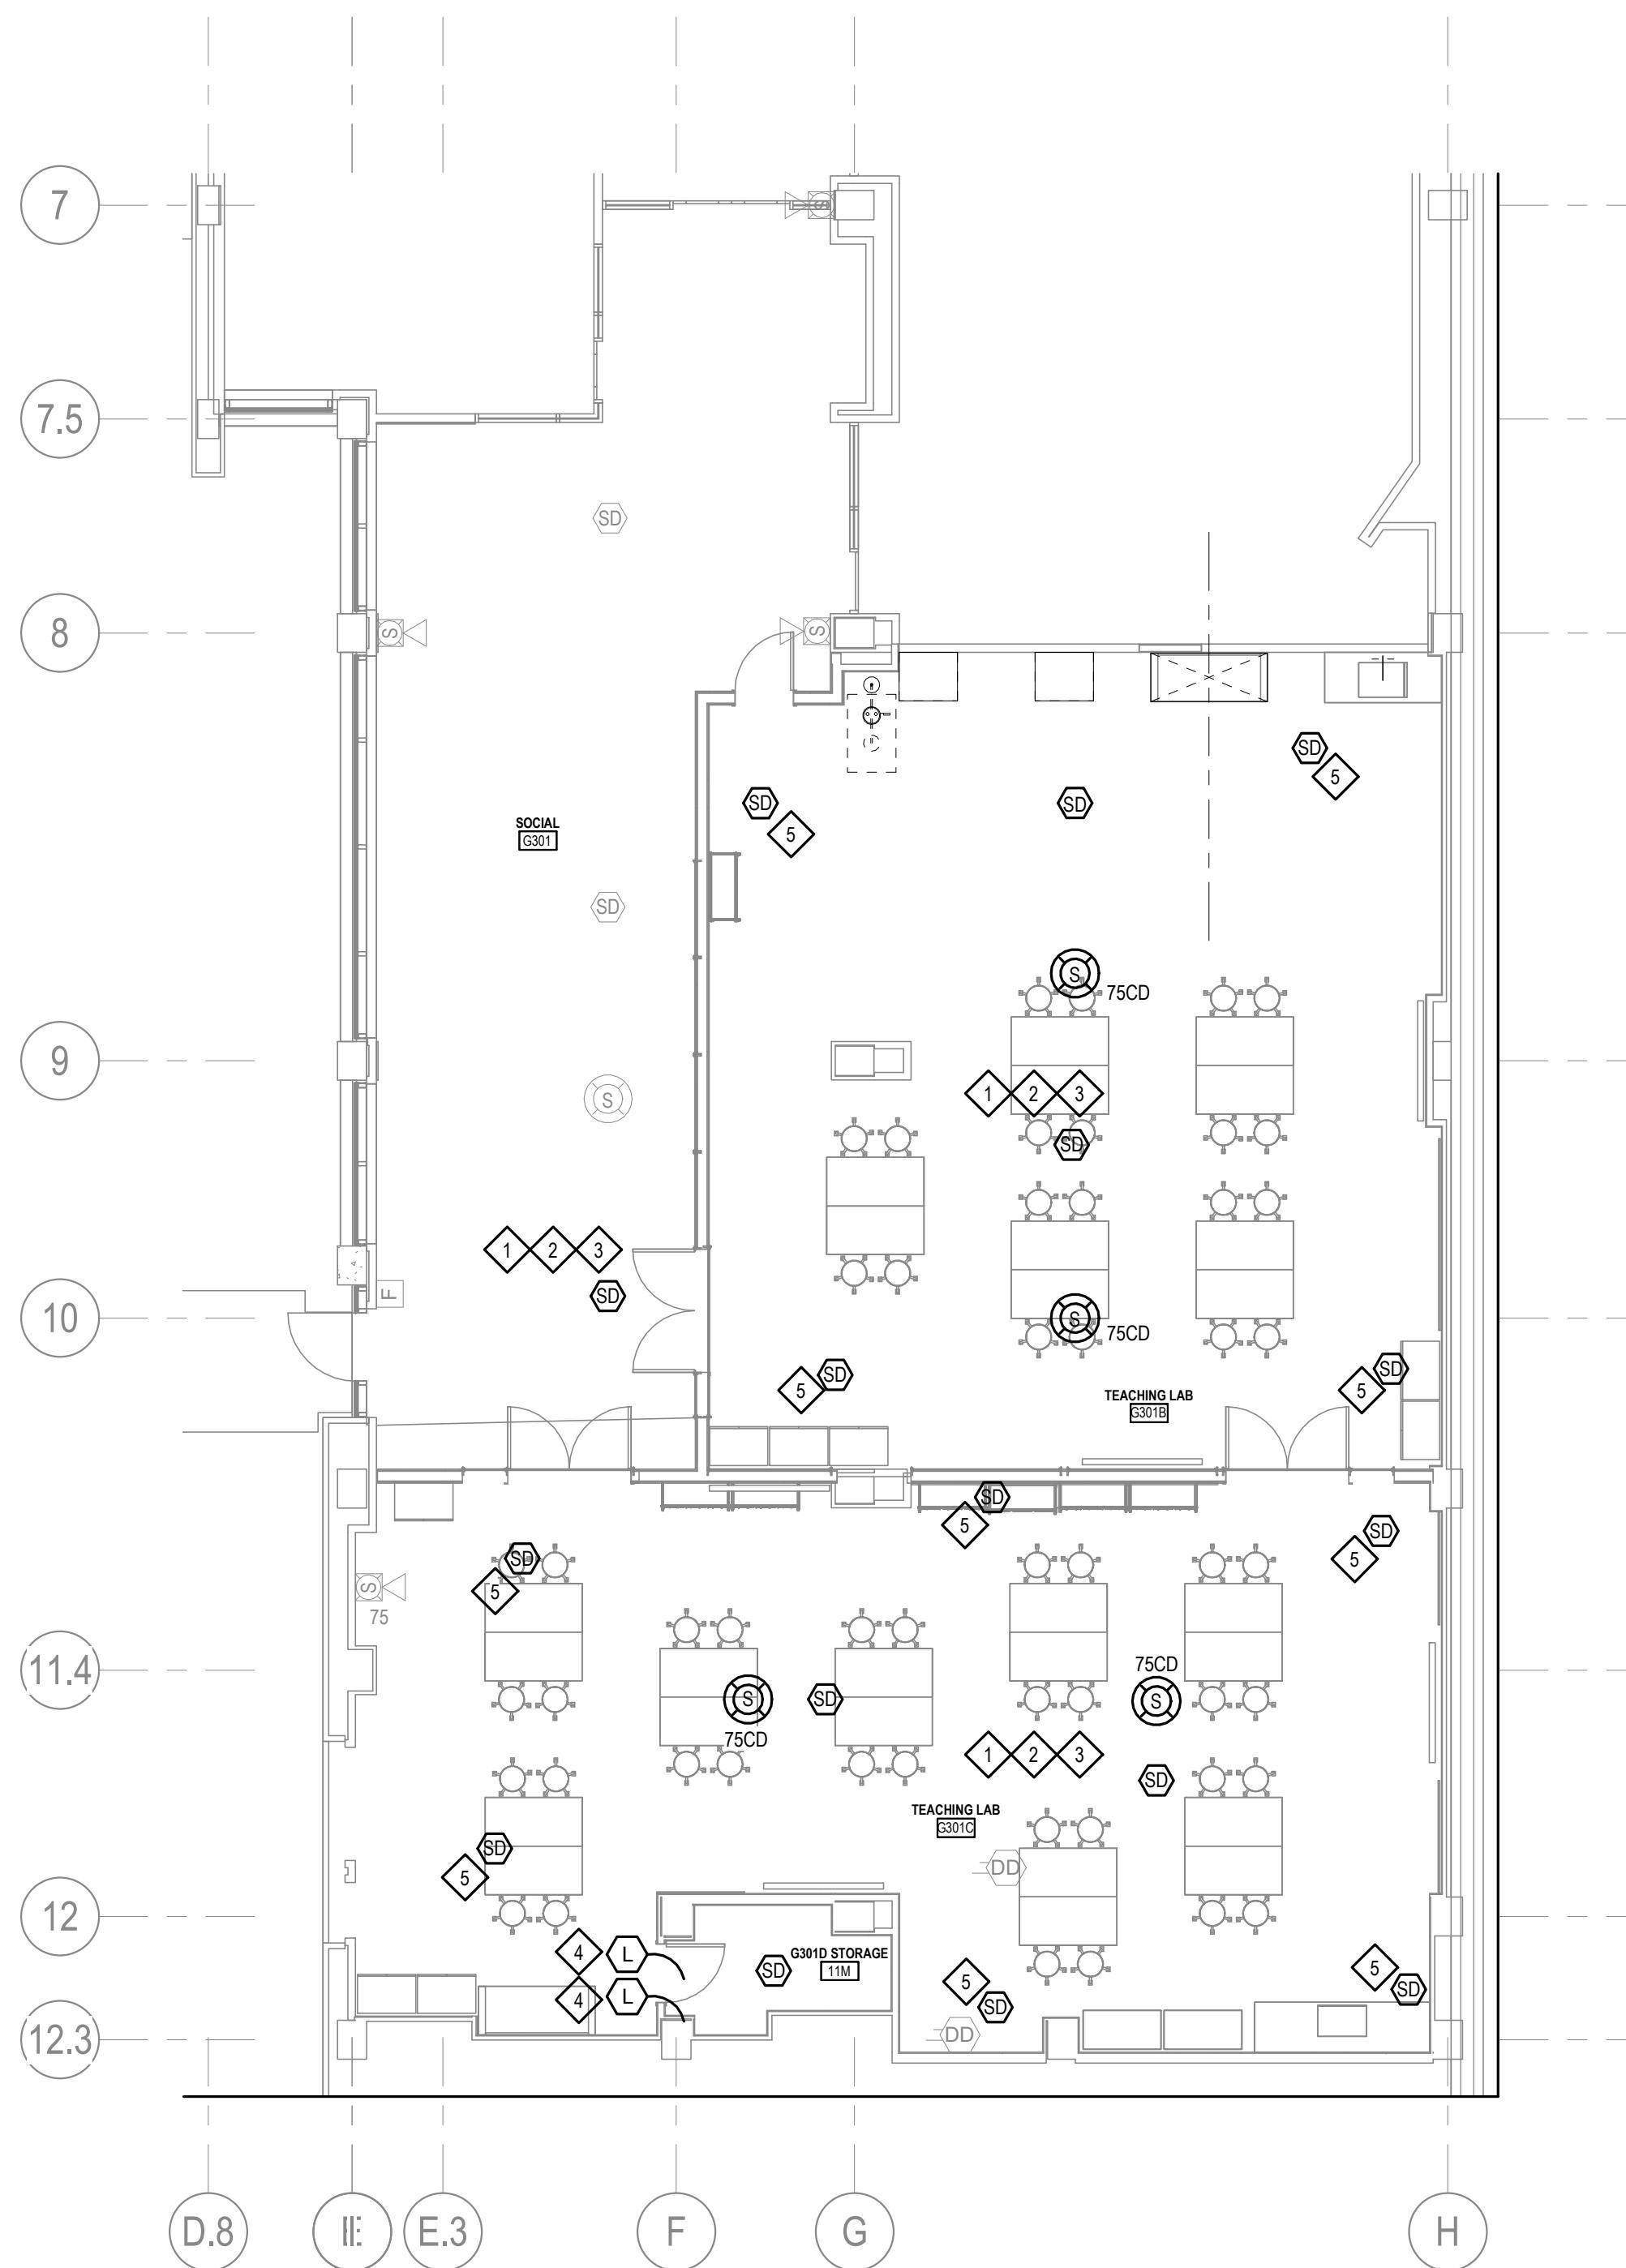

2 GROUND FLOOR NEW WORK PLAN - FIRE ALARM

SCALE: 1/8" = 1'-0"


CLIENT NAME: THE UNIVERSITY OF NORTH CAROLINA AT CHAPEL HILL  
JOB NAME: UNC VENABLE HALL LOWER LEVEL UPLIFT

LOCATION: 101 South RD  
CHAPEL HILL, NC 27514


SCO ID: 24-28389-01A

**FA100**

FIRE ALARM DEMO  
AND NEW WORK  
PLANS

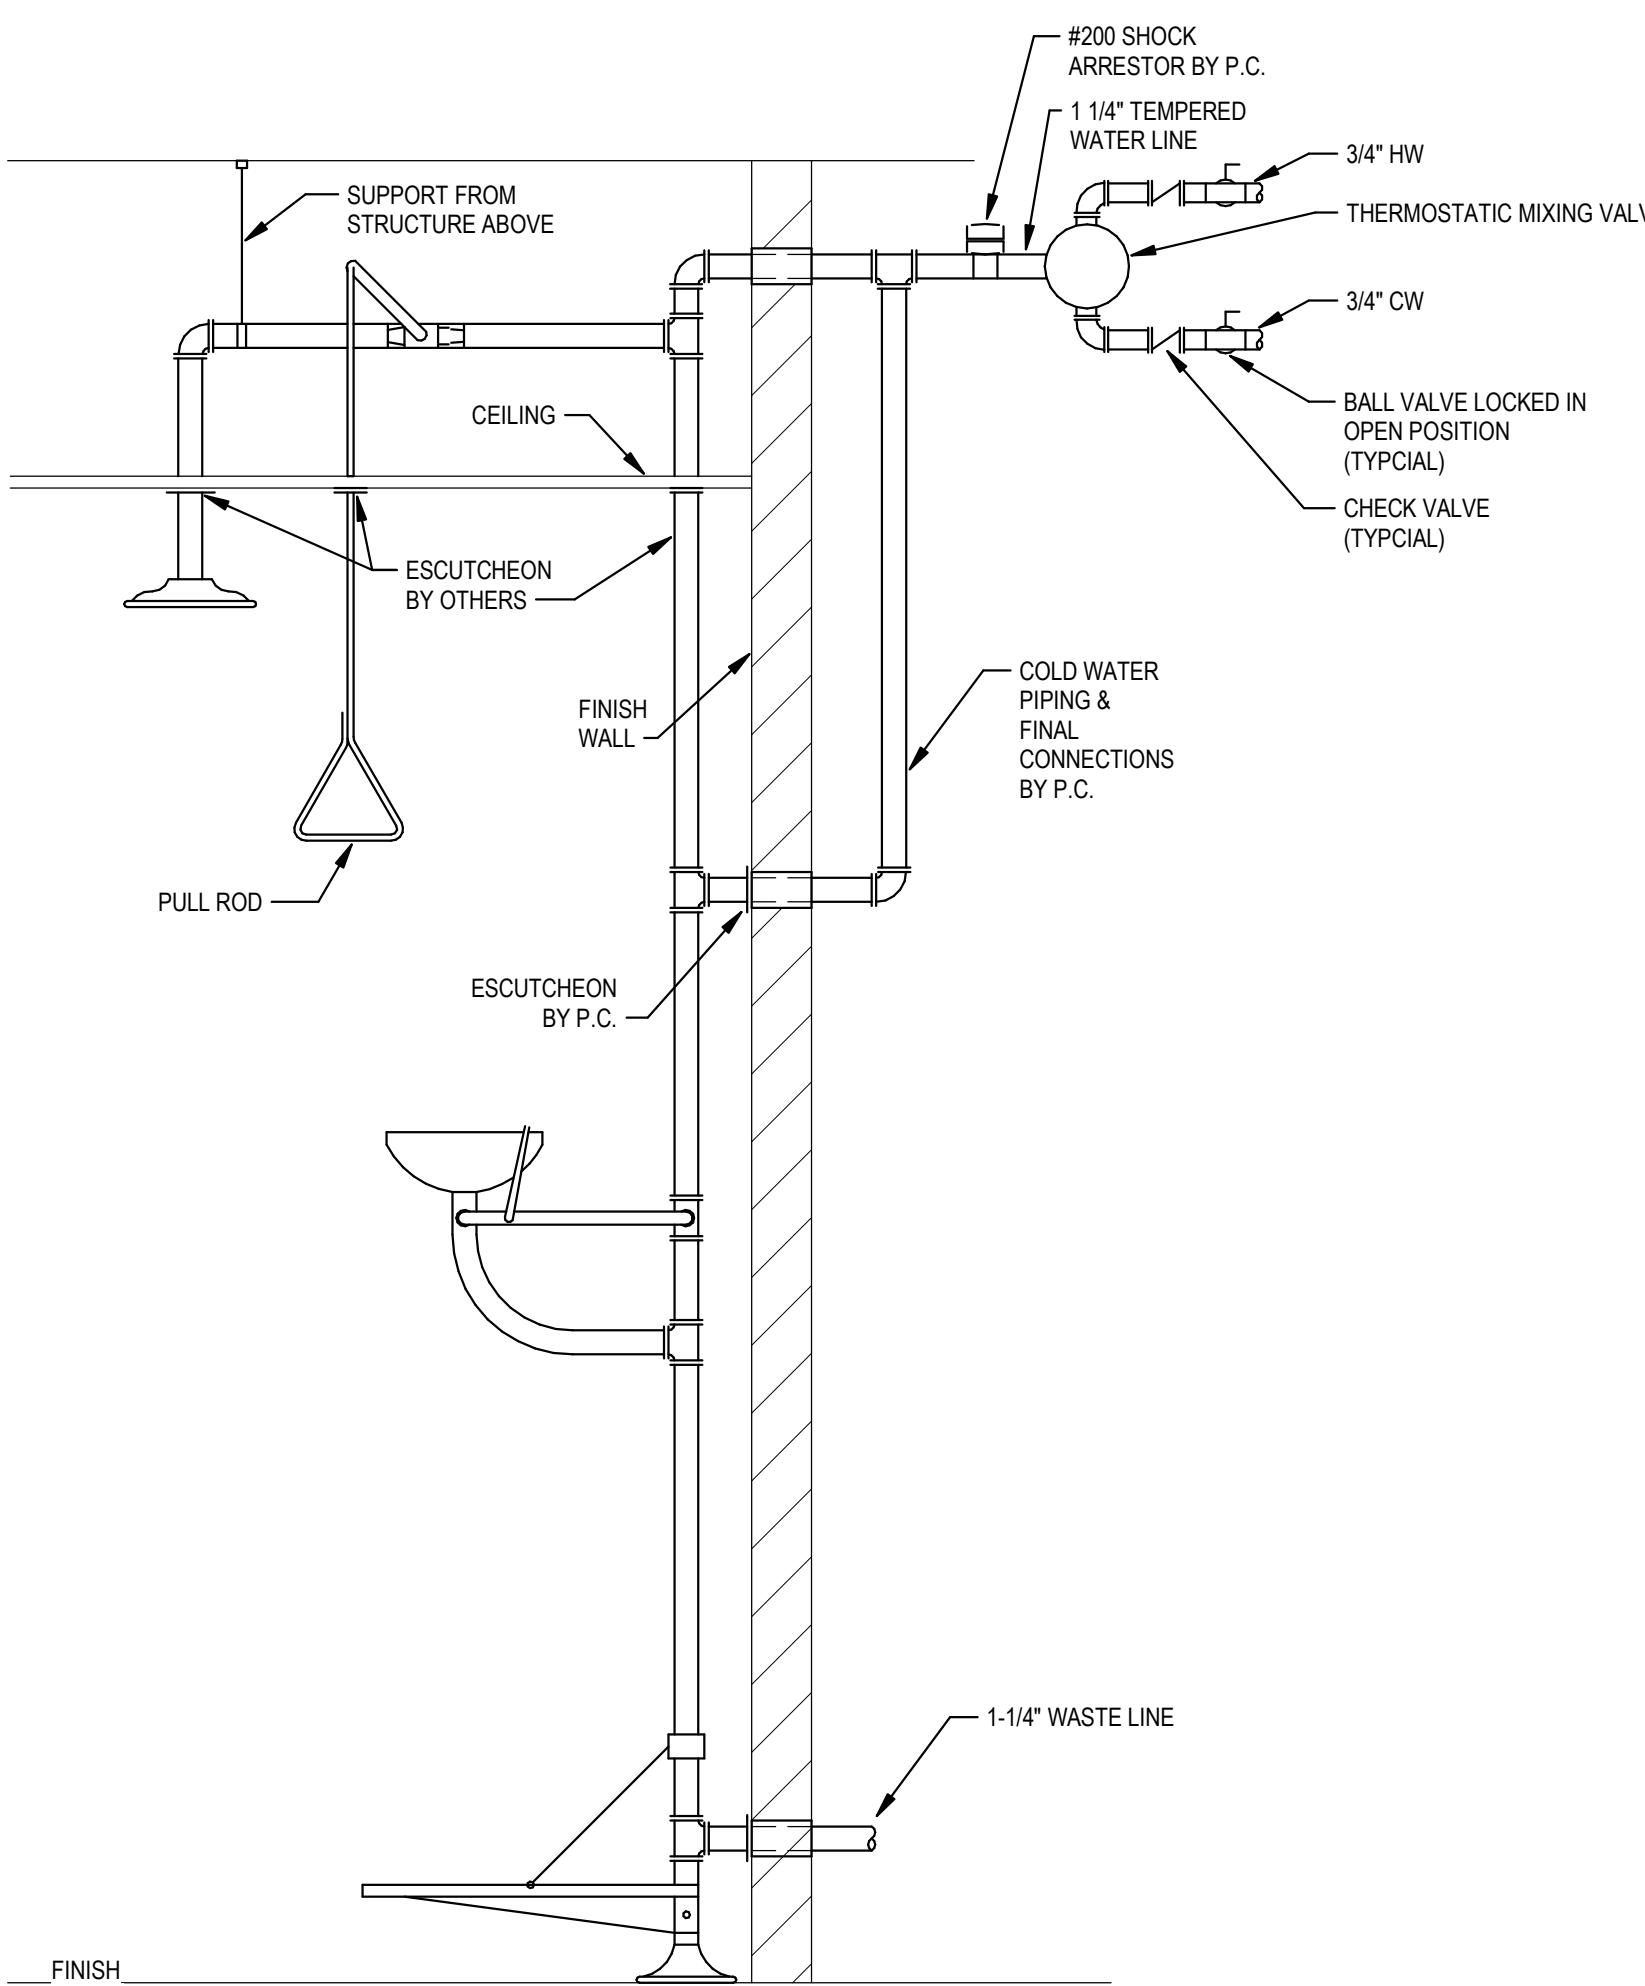

1 EMERGENCY SHOWER/EYEWASH WITH THERMOSTATIC MIXING VALVE

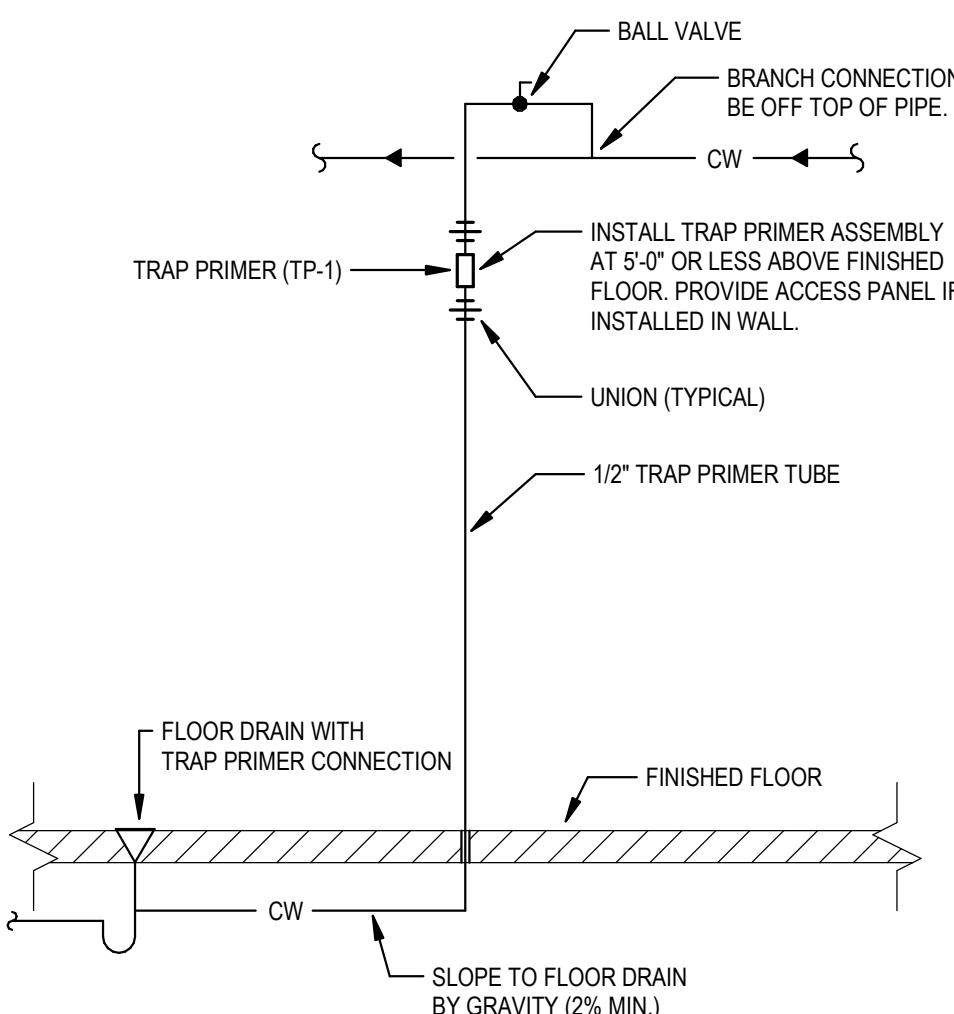

NOTES:

1. PROVIDE MULTIPLE OUTLET DISTRIBUTION AS REQUIRED.
2. IN FINISHED AREA, ROUTE PIPING WITHIN WALL AND LOCATE TRAP PRIMER IN A RECESSED BOX. BOX SHALL BE FULL SIZE TO SERVICE VALVE AND TRAP PRIMER ASSEMBLY. MINIMUM 12" X 12" FOR ONE ASSEMBLY.
3. ALL INACCESSIBLE PIPING, SUCH AS BURIED IN CONCRETE, SHALL BE SOFT COPPER WITH MECHANICAL CONNECTIONS. ALL OTHER PIPING SHALL BE HARD COPPER.

Tag	Manufacturer	Model	Description	Waste	Vent	CW	HW	Specification
S-1	ELKAY	ELUHAD281655PD	LAB SINK	1-1/2"	1-1/2"	1/2"	1/2"	30-1/2" x 18-1/2" x 5-3/8", UNDERMOUNT SINGLE COMPARTMENT ADA COMPLIANT SINK. SINK SHALL BE FULLY SOUND-DEADENED, EIGHTEEN (18) GAUGE, TYPE 304 STAINLESS STEEL. PROVIDE SINK COMPLETE WITH CHROME PLATED SEMI-CAST BRASS P-TRAP WITH CLEANOUT, CHROME PLATED BRASS WASTE TO WALL WITH CHROME PLATED BRASS ESCUTCHEON, STAINLESS STEEL PERFORATED GRID STRAINER WITH CHROME PLATED BRASS TAILPIECE. PROVIDE INSULATION KIT FOR OFFSET DRAIN ASSEMBLY. PROVIDE WITH CONSEALED DECK-MOUNTED DUAL INLET FAUCET, 8" CENTERS WITH 8" RIGID/SWIVEL GOOSENECK SPOUT WITH VACUUM BREAKER, SERRATED NOZZLE WITH FLOW CONTROL AND 4" ADA COMPLIANT WRIST BLADE HANDLES, CHICAGO FAUCETS MODEL LWM2-B43-F OR APPROVED EQUAL. PROVIDE WITH DECK MOUNTED LAB FAUCET FOR PURE WATER, SINGLE CONTROL, RIGID GOOSENECK, SERRATED TIP, 3/8" NPT FEMALE INLET, CHICAGO 830-PVDF OR APPROVED EQUAL.
EWS-1	GUARDIAN	GBF1909	COMBINATION EYEWASH/EMERGENCY SHOWER	1-1/4"	-	1-1/4"	-	GUARDIAN BARRIER-FREE SAFETY STATION WITH WIDEAREA EYE/FACE WASH, PLASTIC SHOWER HEAD. 10" DIAMETER SHOWER HEAD WITH 1" IPS CHROMES PLATED BRASS STAY-OPEN BALL VALVE WITH STAINLESS STEEL ACTUATING ARM AND 47-1/2" STAINLESS STEEL PULL ROD. 11-1/2" STAINLESS STEEL; EYE/FACE WASH BOWL WITH 1/2" IPS CHROME PLATED BRASS STAY-OPEN BALL VALVE WITH FLAG HANDLE. PROVIDE WITH G6040 THERMOSTATIC MIXING VALVE WITH 3/4" HW & CW INLETS TO THE SINGLE 1-1/4" TEMPERED WATER OUTLET.
FD-1	ZURN	ZN415-4NH	4" FLOOR DRAIN WITH TRAP PRIMER CONNECTION	4"	-	-	-	ZURN 4" HEAVY-DUTY CAST IRON FLOOR DRAIN WITH 5" ROUND STRAINER INCLUDED WITH 1/2" TRAP PRIMER CONNECTION. PROVIDE WITH ZURN Z1022 TRAP PRIMER.

PLUMBING SYMBOLS		
PIPE DROP	PIPE UP	HB HOSE BIBB
AV ACID VENT		WH WALL HYDRANT
AW ACID WASTE		NFWH NON-FREEZE WALL HYDRANT
COLD WATER		■ MEDICAL COMPRESSED AIR OUTLET
CA COMPRESSED AIR		▼ MEDICAL VACUUM OUTLET W/SLIDE
DI DEIONIZED WATER		● OXYGEN OUTLET
EXISTING TO BE REMOVED		FH FIRE HYDRANT
FD FOUNDATION DRAIN		MH MANHOLE
G GAS		GV GAS VALVE BOX
GW GREASE LADEN WASTE BELOW GRADE		WV WATER VALVE BOX
GW GREASE LADEN WASTE ABOVE GRADE		AD AREA DRAIN (No. indicates type)
HOT WATER SUPPLY (120°)		FD FLOOR DRAIN (No. indicates type)
HOT WATER RETURN (120°)		FS FLOOR SINK (No. indicates type)
140° HOT WATER SUPPLY (140°)		RD ROOF DRAIN
140° HWR HOT WATER RETURN (140°)		CO CLEAN OUT
IA INSTRUMENT AIR		CO FLOOR CLEANOUT
LA LABORATORY AIR		WHA WATER HAMMER ARRESTOR
LW LABORATORY WASTE		AVTR ACID VENT THRU ROOF
LPG LIQUEFIED PETROLEUM GAS (PROPANE)		CSS CLINIC SERVICE SINK
MCA MEDICAL COMPRESSED AIR		DD DECK DRAIN (No. indicates type)
MVAC MEDICAL VACUUM / SUCTION		DF DRINKING FOUNTAIN (No. indicates type)
N NITROGEN GAS		ES EMERGENCY SHOWER
NO NITROUS OXIDE GAS		ES/EW EMER SHOWER/EYEWASH COMBINATION
ORC OVERFLOW RAIN CONDUCTOR		EEW EMERGENCY EYEWASH
O2 MEDICAL OXYGEN GAS		EWC ELECTRIC WATER COOLER (No. indicates type)
PS PRESSURE SANITARY SEWER		EX EXISTING
PD PUMP DISCHARGE		IMOB ICE MAKER OUTLET BOX (No. indicates type)
RWC RAIN WATER CONDUCTOR		L LAVATORY (No. indicates type)
SAN SANITARY SEWER BELOW GRADE		MR MOP RECEPTOR
SAN SANITARY SEWER ABOVE GRADE		MV MIXING VALVE (No. indicates type)
V SANITARY VENT PIPING		NFRH NON-FREEZE ROOF HYDRANT
ST STORM SEWER ABOVE GRADE		NFWH NON-FREEZE WALL HYDRANT
ST STORM SEWER BELOW GRADE		ORC OVERFLOW RAIN CONDUCTOR
TW TEMPERED WATER		RD ROOF DRAIN (No. indicates type)
VAC VACUUM LINE		S COUNTER SINK (No. indicates type)
WAGD WASTE ANESTHETIC GAS DISPOSAL		SAN SANITARY
AIR VENT	PLUG VALVE	SH SHOWER (No. indicates type)
BALANCING VALVE	P.G. PRESSURE GAUGE	UR URINAL (No. indicates type)
BFP BACKFLOW PREVENTER	PRESSURE REGULATING VALVE	V VENT
BALL VALVE	P-TRAP	V.C. VALVE CABINET
BUTTERFLY VALVE	RELIEF VALVE	VTR VENT THRU ROOF
CAPPED CONNECTION	SOLENOID VALVE	W WASTE
CHECK VALVE	STRAINER	WC WATER CLOSET (No. indicates type)
GAS PRESSURE REGULATOR	THERMOMETER	WMSD WASHING MACHINE SUPPLY & DRAIN
GATE VALVE	UNION	Z.V.B. MEDICAL GAS ZONE VALVE BOX
MIXING VALVE	VALVE IN RISER	CONNECT TO EXISTING PIPING

## PLUMBING SYSTEM NOTES

A. ALL PLUMBING WORK SHALL BE IN ACCORDANCE WITH THE 2018 NORTH CAROLINA PLUMBING CODE. ALL PLUMBING WORK SHALL BE INSPECTED AND APPROVED BY THE LOCAL AUTHORITY HAVING JURISDICTION. THE PLUMBING CONTRACTOR SHALL PROVIDE ALL NECESSARY FEES AND PERMITS, INCLUDING THE CERTIFICATE OF PLUMBING INSPECTION.

B. THE PLUMBING CONTRACTOR SHALL BE RESPONSIBLE FOR CONSTRUCTION SAFETY. ARCHITECT AND/OR ENGINEER SHALL ASSUME NO RESPONSIBILITY FOR WORKMAN'S, OR PEDESTRIAN'S SAFETY. NOTHING IN THE CONTRACT DOCUMENTS SHALL BE CONSTRUED TO INSTRUCT PROCEDURES OR COMPONENTS FOR PROJECT SAFETY.

C. NOTHING CONTAINED IN THE CONTRACT DOCUMENTS SHALL BE CONSTRUED TO CONFLICT WITH ANY NATIONAL, STATE, MUNICIPAL, OR LOCAL LAWS OR REGULATIONS GOVERNING THE WORK INDICATED OR SPECIFIED. ALL SUCH REQUIREMENTS SHALL BE SATISFIED BY THE PLUMBING CONTRACTOR AT NO ADDITIONAL EXPENSE TO THE OWNER.

D. WHERE A CONFLICT ARISES BETWEEN PLANS, SPECIFICATIONS, DETAILS, SCHEDULES, APPLICABLE CODES OR REGULATIONS; THE MOST STRINGENT SHALL APPLY.

E. THE CONTRACT DOCUMENTS ARE COMPRISED OF DRAWINGS AND SPECIFICATIONS. EACH PLUMBING BIDDER SHALL VISIT SITE TO DETERMINE EXISTING CONDITIONS PRIOR TO SUBMITTING BID PROPOSAL. BIDS SHALL BE BASED ON THE COMPLETE EXAMINATION OF THE DRAWINGS, SPECIFICATIONS AND EXISTING CONDITIONS. NO CONSIDERATION WILL BE GIVEN ANY CONTRACTOR WHO FAILS TO DO SO.

F. THE WORK UNDER THIS CONTRACT SHALL INCLUDE THE FURNISHING OF ALL NECESSARY MATERIALS, TOOLS, AND LABOR FOR A COMPLETE, AND WORKING INSTALLATION AS DEFINED BY THE PLANS AND SPECIFICATIONS. THE PLUMBING CONTRACTOR SHALL WARRANT THE WORK INDICATED AND SPECIFIED. THE WORK SHALL FUNCTION AS INTENDED, BE COMPLETE IN ALL DETAILS, AND SHALL INCLUDE ALL INDICATED, SPECIFIED, OR REQUIRED ACCESSORIES FOR A FUNCTIONING SYSTEM.

G. PLUMBING CONTRACTOR SHALL COORDINATE HIS WORK WITH ALL OTHER TRADES.

H. CONTRACTOR SHALL REMOVE DEMOLITION DEBRIS COMPLETELY. CONTRACTOR SHALL SCHEDULE WITH THE CONSTRUCTION MANAGER THE TIME, LOCATION, ELEVATOR AND HAULING ROUTE.

I. THE PLUMBING CONTRACTOR SHALL CLEAN UP ALL DEBRIS AT THE END OF EACH WORK DAY.

J. HORIZONTAL DRAINAGE PIPING SHALL BE INSTALLED IN UNIFORM ALIGNMENT AT UNIFORM SLOPES NOT LESS THAN 1/4 INCH PER FOOT FOR THREE (3) INCH DIAMETER AND LESS, AND NOT LESS THAN 1/8 INCH PER FOOT FOR DIAMETERS OF FOUR (4) INCHES OR MORE.

K. ALL PIPING IS SCHEMATIC; SUPPORTS, UNIONS, VIBRATION ISOLATION, VALVES, INSULATION, ETC. SHALL BE AS REQUIRED FOR A COMPLETE AND OPERATING SYSTEM.

L. ALL PIPING IS TO BE CONCEALED IN WALLS OR ABOVE CEILING UNLESS NOTED OTHERWISE.

M. THE PLUMBING CONTRACTOR SHALL COORDINATE WITH THE GENERAL CONTRACTOR PRIOR TO AND FOR SCHEDULING ANY INTERRUPTION OF ANY BUILDING UTILITY.

N. ALL EQUIPMENT PROVIDED OR INSTALLED BY THIS CONTRACTOR SHALL BE INSTALLED IN ACCORDANCE WITH THE MANUFACTURER'S INSTALLATION INSTRUCTIONS.

O. ALL PIPING SHALL BE RUN AT THE SLOPES INDICATED. WHERE ELEVATIONS ARE NOT INDICATED, COORDINATE THE PIPE ROUTING WITH THE DUCT ROUTING INDICATED ON THE MECHANICAL PLANS, AS WELL AS ALL OTHER TRADES.

P. FINAL LOCATION OF ALL PLUMBING FIXTURES, SINKS, ELECTRIC WATER COOLERS, CLEANOUTS, AND THE LIKE, SHALL BE VERIFIED AND COORDINATED WITH THE ARCHITECTURAL DRAWINGS.

Q. ALL WORK SHOWN ON THE PLUMBING DRAWINGS SHALL BE BY THE PLUMBING CONTRACTOR UNLESS SPECIFICALLY NOTED OTHERWISE.

R. ALL SANITARY PIPING CONNECTIONS TO FIXTURES SHALL BE SIZED AS SCHEDULED. ALL OTHER SANITARY PIPING SHALL BE 4" UNLESS NOTED OTHERWISE.

S. ALL INVERT ELEVATIONS SHOWN ON THE DRAWINGS ARE APPROXIMATE AND MUST BE VERIFIED BY THE CONTRACTOR PRIOR TO INSTALLATION.

T. PROVIDE CLEANOUTS AT LEAST EVERY 100 FT IN SANITARY PIPING IN ADDITION TO THOSE SHOWN ON THE DRAWINGS. PROVIDE A CLEANOUT AT EACH CHANGE IN DIRECTION OF 90 DEGREES IN A SINGLE FITTING.

U. PROVIDE A CLEAN OUT AT EACH CHANGE IN DIRECTION GREATER THAN 45 DEGREES.

V. ALL VENT PIPING CONNECTIONS TO FIXTURES SHALL BE SIZED AS SCHEDULED. ALL OTHER VENT PIPING SHALL BE 2" UNLESS NOTED OTHERWISE.

W. PROVIDE 1/4 TURN STOP VALVES AT ALL FIXTURES.

X. PROVIDE APPROPRIATE BACKFLOW PREVENTION DEVICES WHERE REQUIRED BY CODE.

Y. SEE SPECIFICATION SECTION 011000 FOR TIMING OF ALL WORK AND COORDINATE.



# CONSTRUCTION SET



No

CLIENT NAME **THE UNIVERSITY OF NORTH CAROLINA AT CHAPEL HILL**

UNC VENABLE HALL LOWER LEVEL UPFIT  
LOCATION: VENABLE HALL LOWER LEVEL  
1101 South RD

SC0 ID: 24-28389-01A

PLUMBING SHEET INDEX	
P001	PLUMBING DATA SHEET
P111	SANITARY - GROUND FLOOR PLAN
P211	DOMESTIC - GROUND FLOOR PLAN
P311	PLUMBING - 1ST FLOOR PLAN

CLIENT NAME THE UN  
JOB NAME UNC VE  
LOCATION VENABI  
101 So CHAPEI  
SCO ID.

ISSUE DATE  
11-17-25

---

JOB. NO.  
10021-0001

---

DWG. NO.

**P001**

# PLUMBING DATA SHEET



**NOTCH**  
NOTCH DESIGN, PLLC  
212 W MAIN ST, SUITE E,  
CARRBORO, NC  
www.notchdesign.us  
info@notchdesign.us



www.mckimcreed.com  
4300 Edwards Mill Rd Suite 200  
Raleigh, NC 27612  
(919) 223-8091  
(919) 233-8031 Fax

NC License# F-1222

REVISION  
SCO REVIEW 9/15/25  
2nd SCO REVIEW 10/24/25  
Construction Set 11/17/25

## CONSTRUCTION SET



© 2024  
Notch Design

CLIENT NAME: THE UNIVERSITY OF NORTH CAROLINA AT CHAPEL HILL  
JOB NAME: UNC VENABLE HALL LOWER LEVEL UPGRADE  
LOCATION: 101 South RD  
CHAPEL HILL, NC 27514

SCO ID: 24-28389-01A

ISSUE DATE: 11-17-25  
JOB NO.: 10021-0001  
DWG. NO. \_\_\_\_\_



**P111**

SANITARY -  
GROUND FLOOR  
PLAN

1/8"=1'-0" 8' 4' 0' 8' 16'

## 1 SANITARY GROUND PLAN

SCALE: 1/8" = 1'-0"

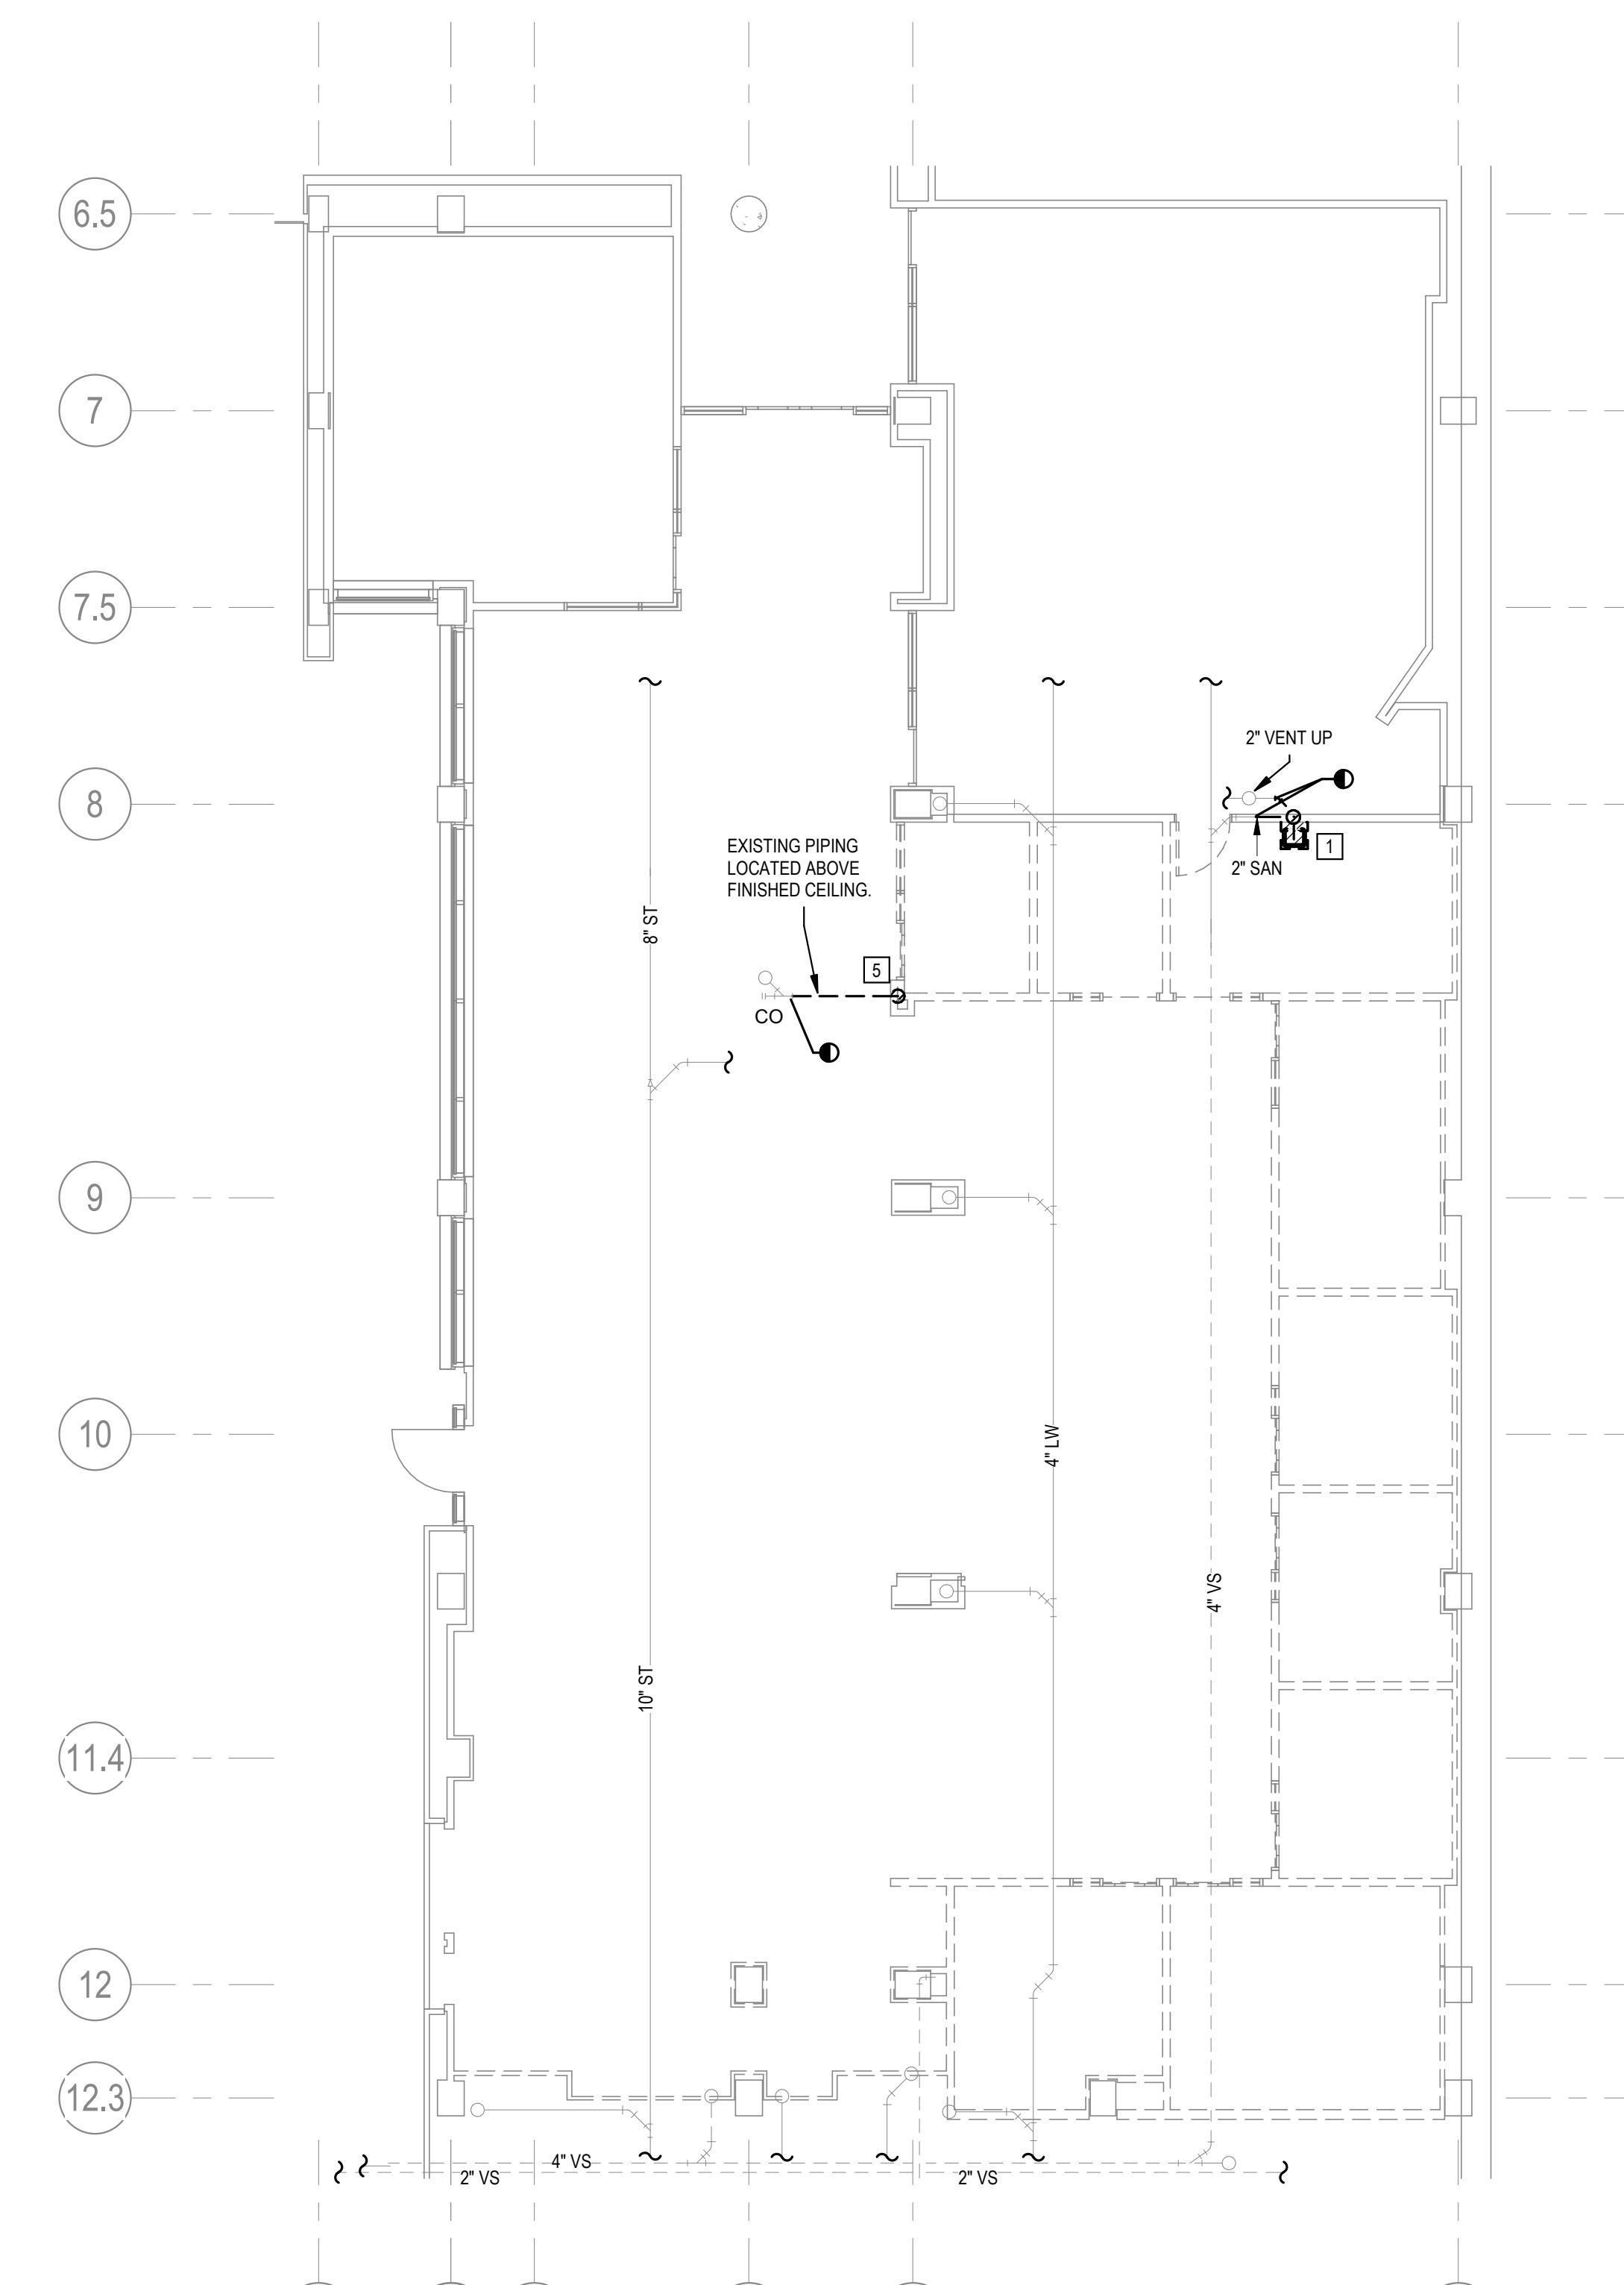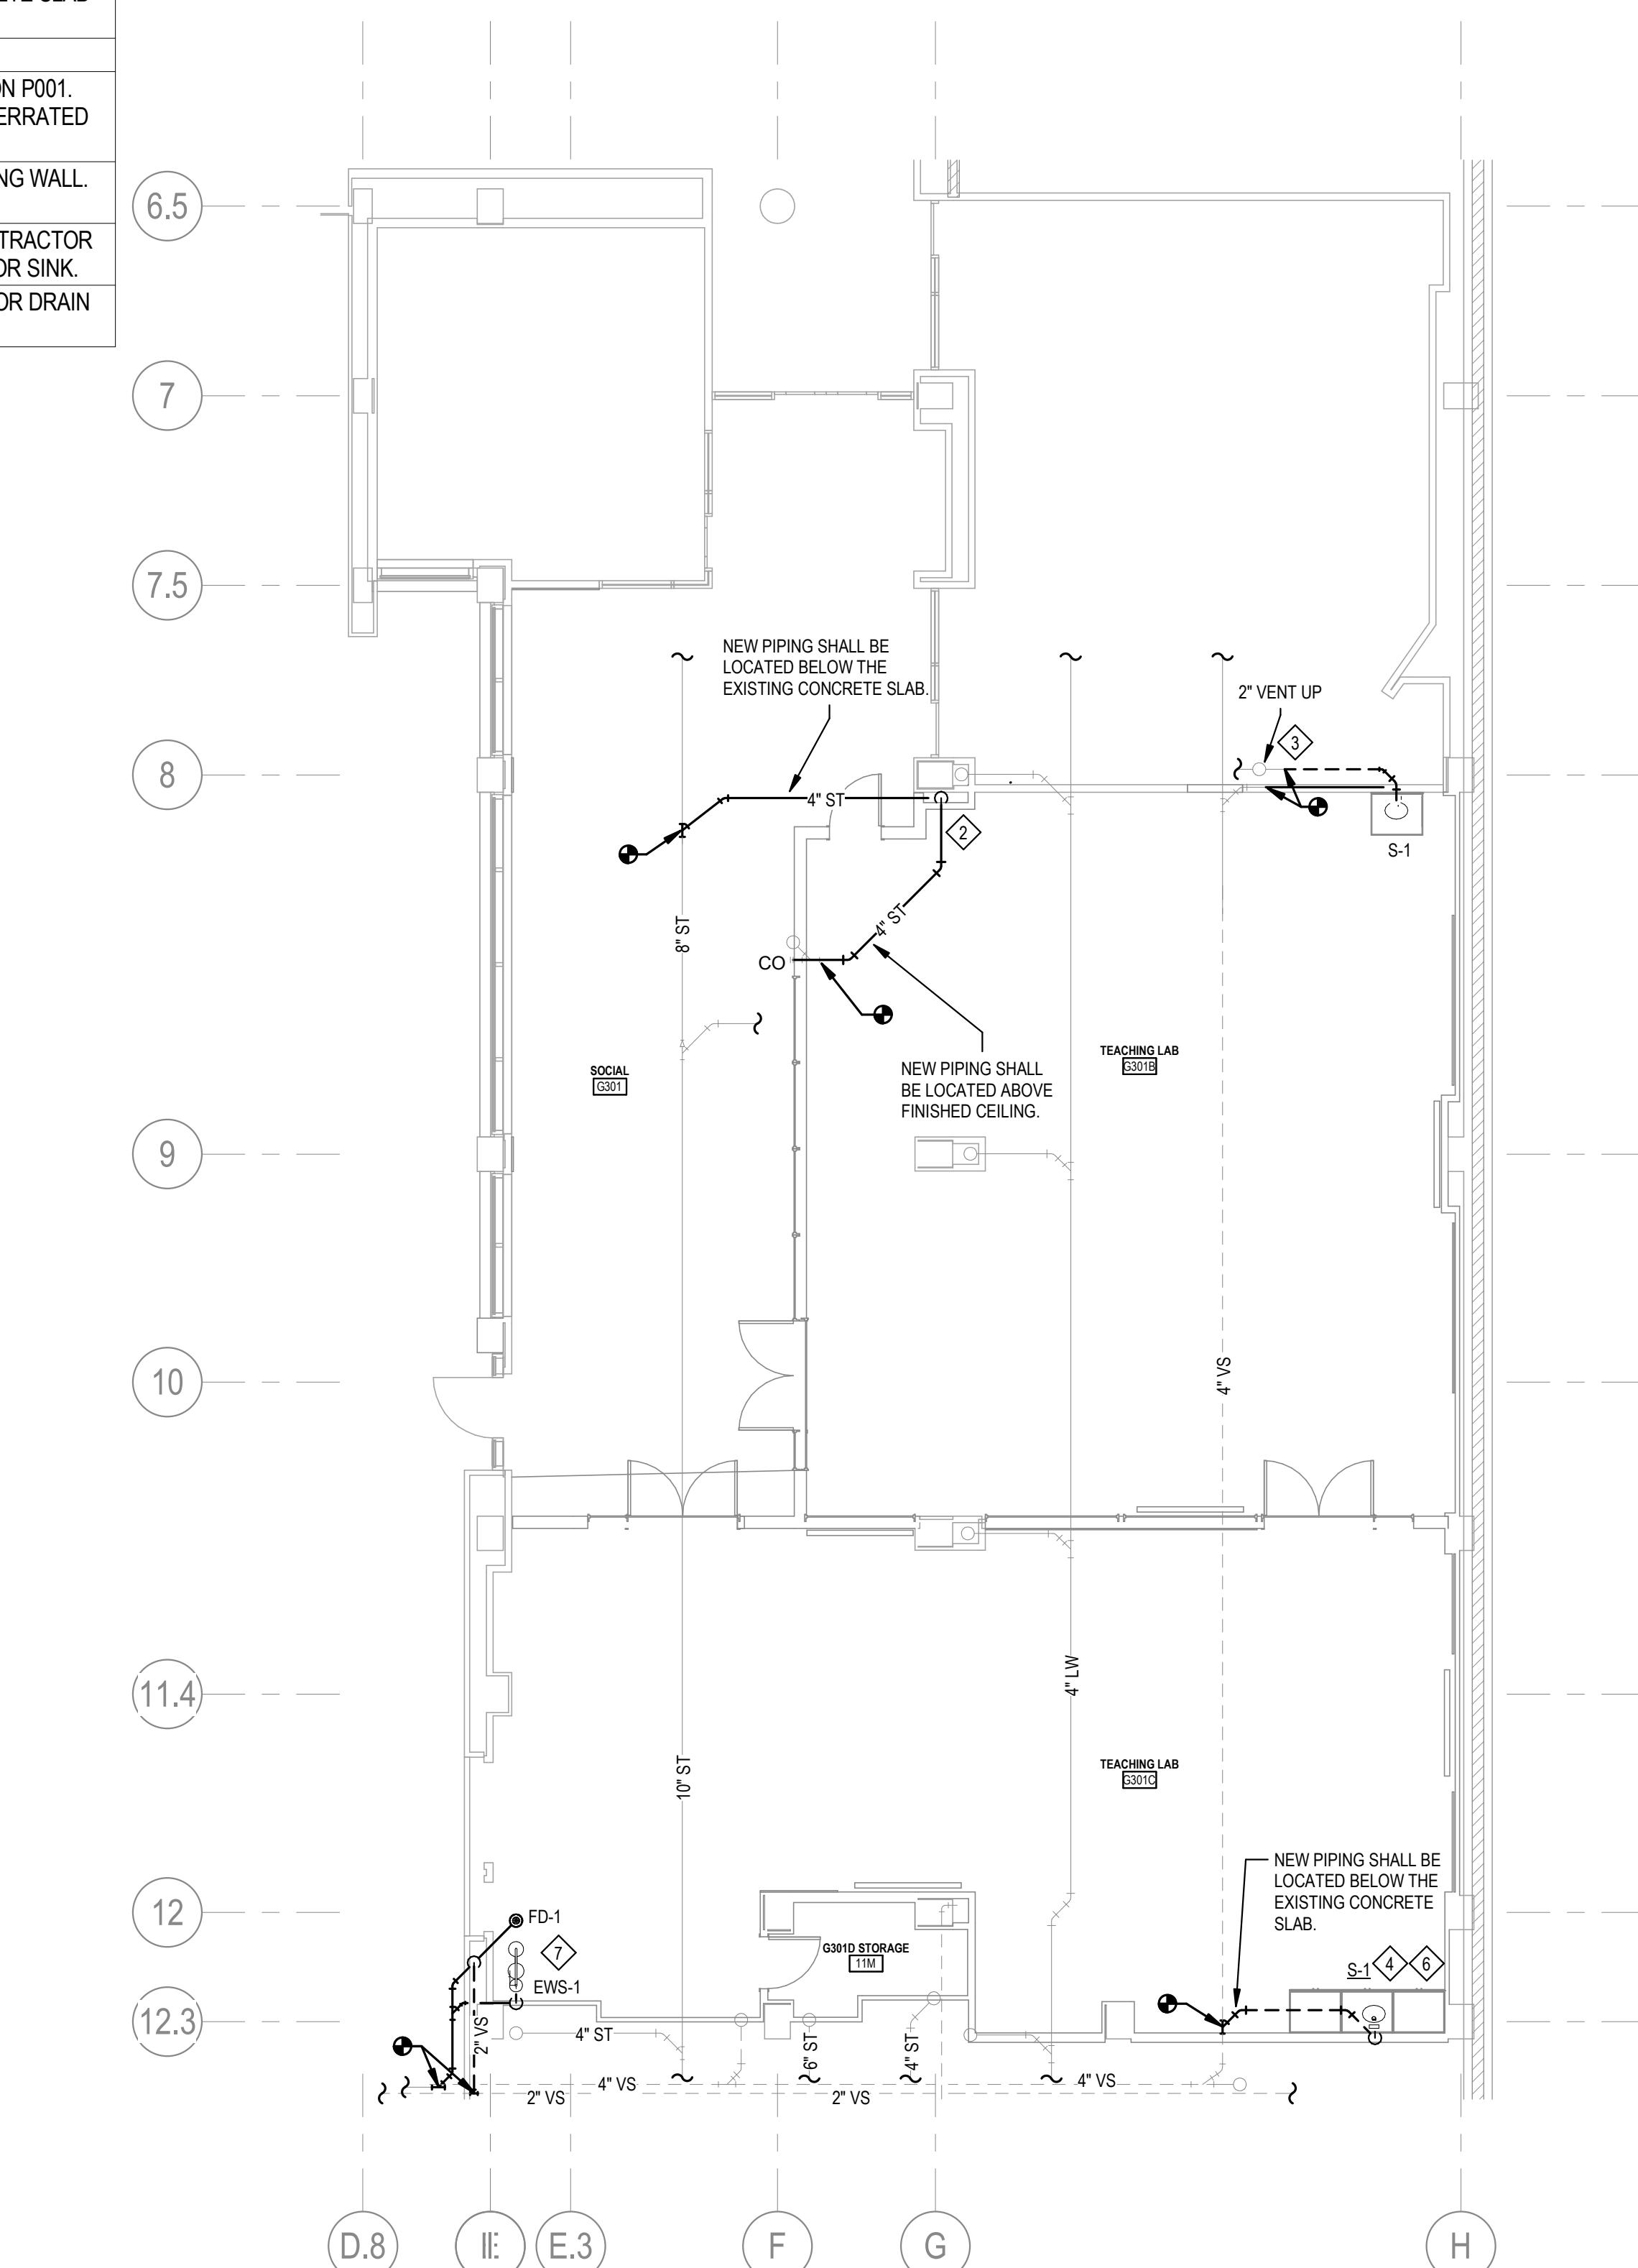

## 2 SANITARY GROUND DEMOLITION PLAN

SCALE: 1/8" = 1'-0"

KEYED NOTES	
1	REMOVE EXISTING FIXTURE AND ALL CONNECTED PIPING BACK TO MAIN OR LAST FIXTURE SERVED AS SHOWN ON PLANS. COORDINATE EXTENTS OF DEMOLITION WITH NEW WORK PLANS.
2	PROVIDE NEW 4" STORM LINE. NEW LINE SHALL DROP DOWN TO BELOW CONCRETE SLAB. ROUTE NEW LINE BELOW THE EXISTING CONCRETE SLAB AND CONNECT TO THE EXISTING 4" STORM DRAIN LINE.
3	CONNECT NEW LINE OF SIZE INDICATED INTO MAIN AS SHOWN.
4	PROVIDE AND INSTALL NEW PLUMBING FIXTURE AS SCHEDULED ON P001. PROVIDE NEW DECK MOUNTED PVC GOOSENECK FAUCET WITH SERRATED NOZZLE AND HANDLE. MOUNT ADJACENT TO NEW SINK.
5	REMOVE EXISTING 4" STORM DRAIN THAT DROPS DOWN IN EXISTING WALL. REMOVE EXISTING LINE BELOW CONCRETE SLAB AND CAP.
6	PROVIDE AND INSTALL NEW AAV IN CASEWORK BELOW SINK. CONTRACTOR TO VERIFY INSTALLATION HEIGHT OF AAV TO BE ABOVE P-TRAP FOR SINK.
7	PROVIDE NEW EMERGENCY EYEWASH/SHOWER (EWS-1) AND FLOOR DRAIN AND ASSOCIATED BRANCH PIPING.



**NOTCH**  
NOTCH DESIGN, PLLC  
212 W MAIN ST, SUITE E,  
CARRBORO, NC  
www.notchdesign.us  
info@notchdesign.us



www.mckimcreed.com  
4300 Edwards Mill Rd Suite 200  
Raleigh, NC 27612  
(919) 223-8091  
(919) 233-8031 Fax

NC License# F-1222

REVISION:  
SCO REVIEW 9/15/25  
2nd SCO REVIEW 10/24/25  
Construction Set 11/17/25

## CONSTRUCTION SET




© 2024  
Notch Design

CLIENT NAME: THE UNIVERSITY OF NORTH CAROLINA AT CHAPEL HILL  
JOB NAME: UNC VENABLE HALL LOWER LEVEL UPGRADE  
LOCATION: 101 South RD  
CHAPEL HILL, NC 27514  
ISSUE DATE: 11-17-25  
JOB NO.: 10021-0001  
DWG. NO.: SCO ID: 24-28389-01A


**P211**

DOMESTIC -  
GROUND FLOOR  
PLAN

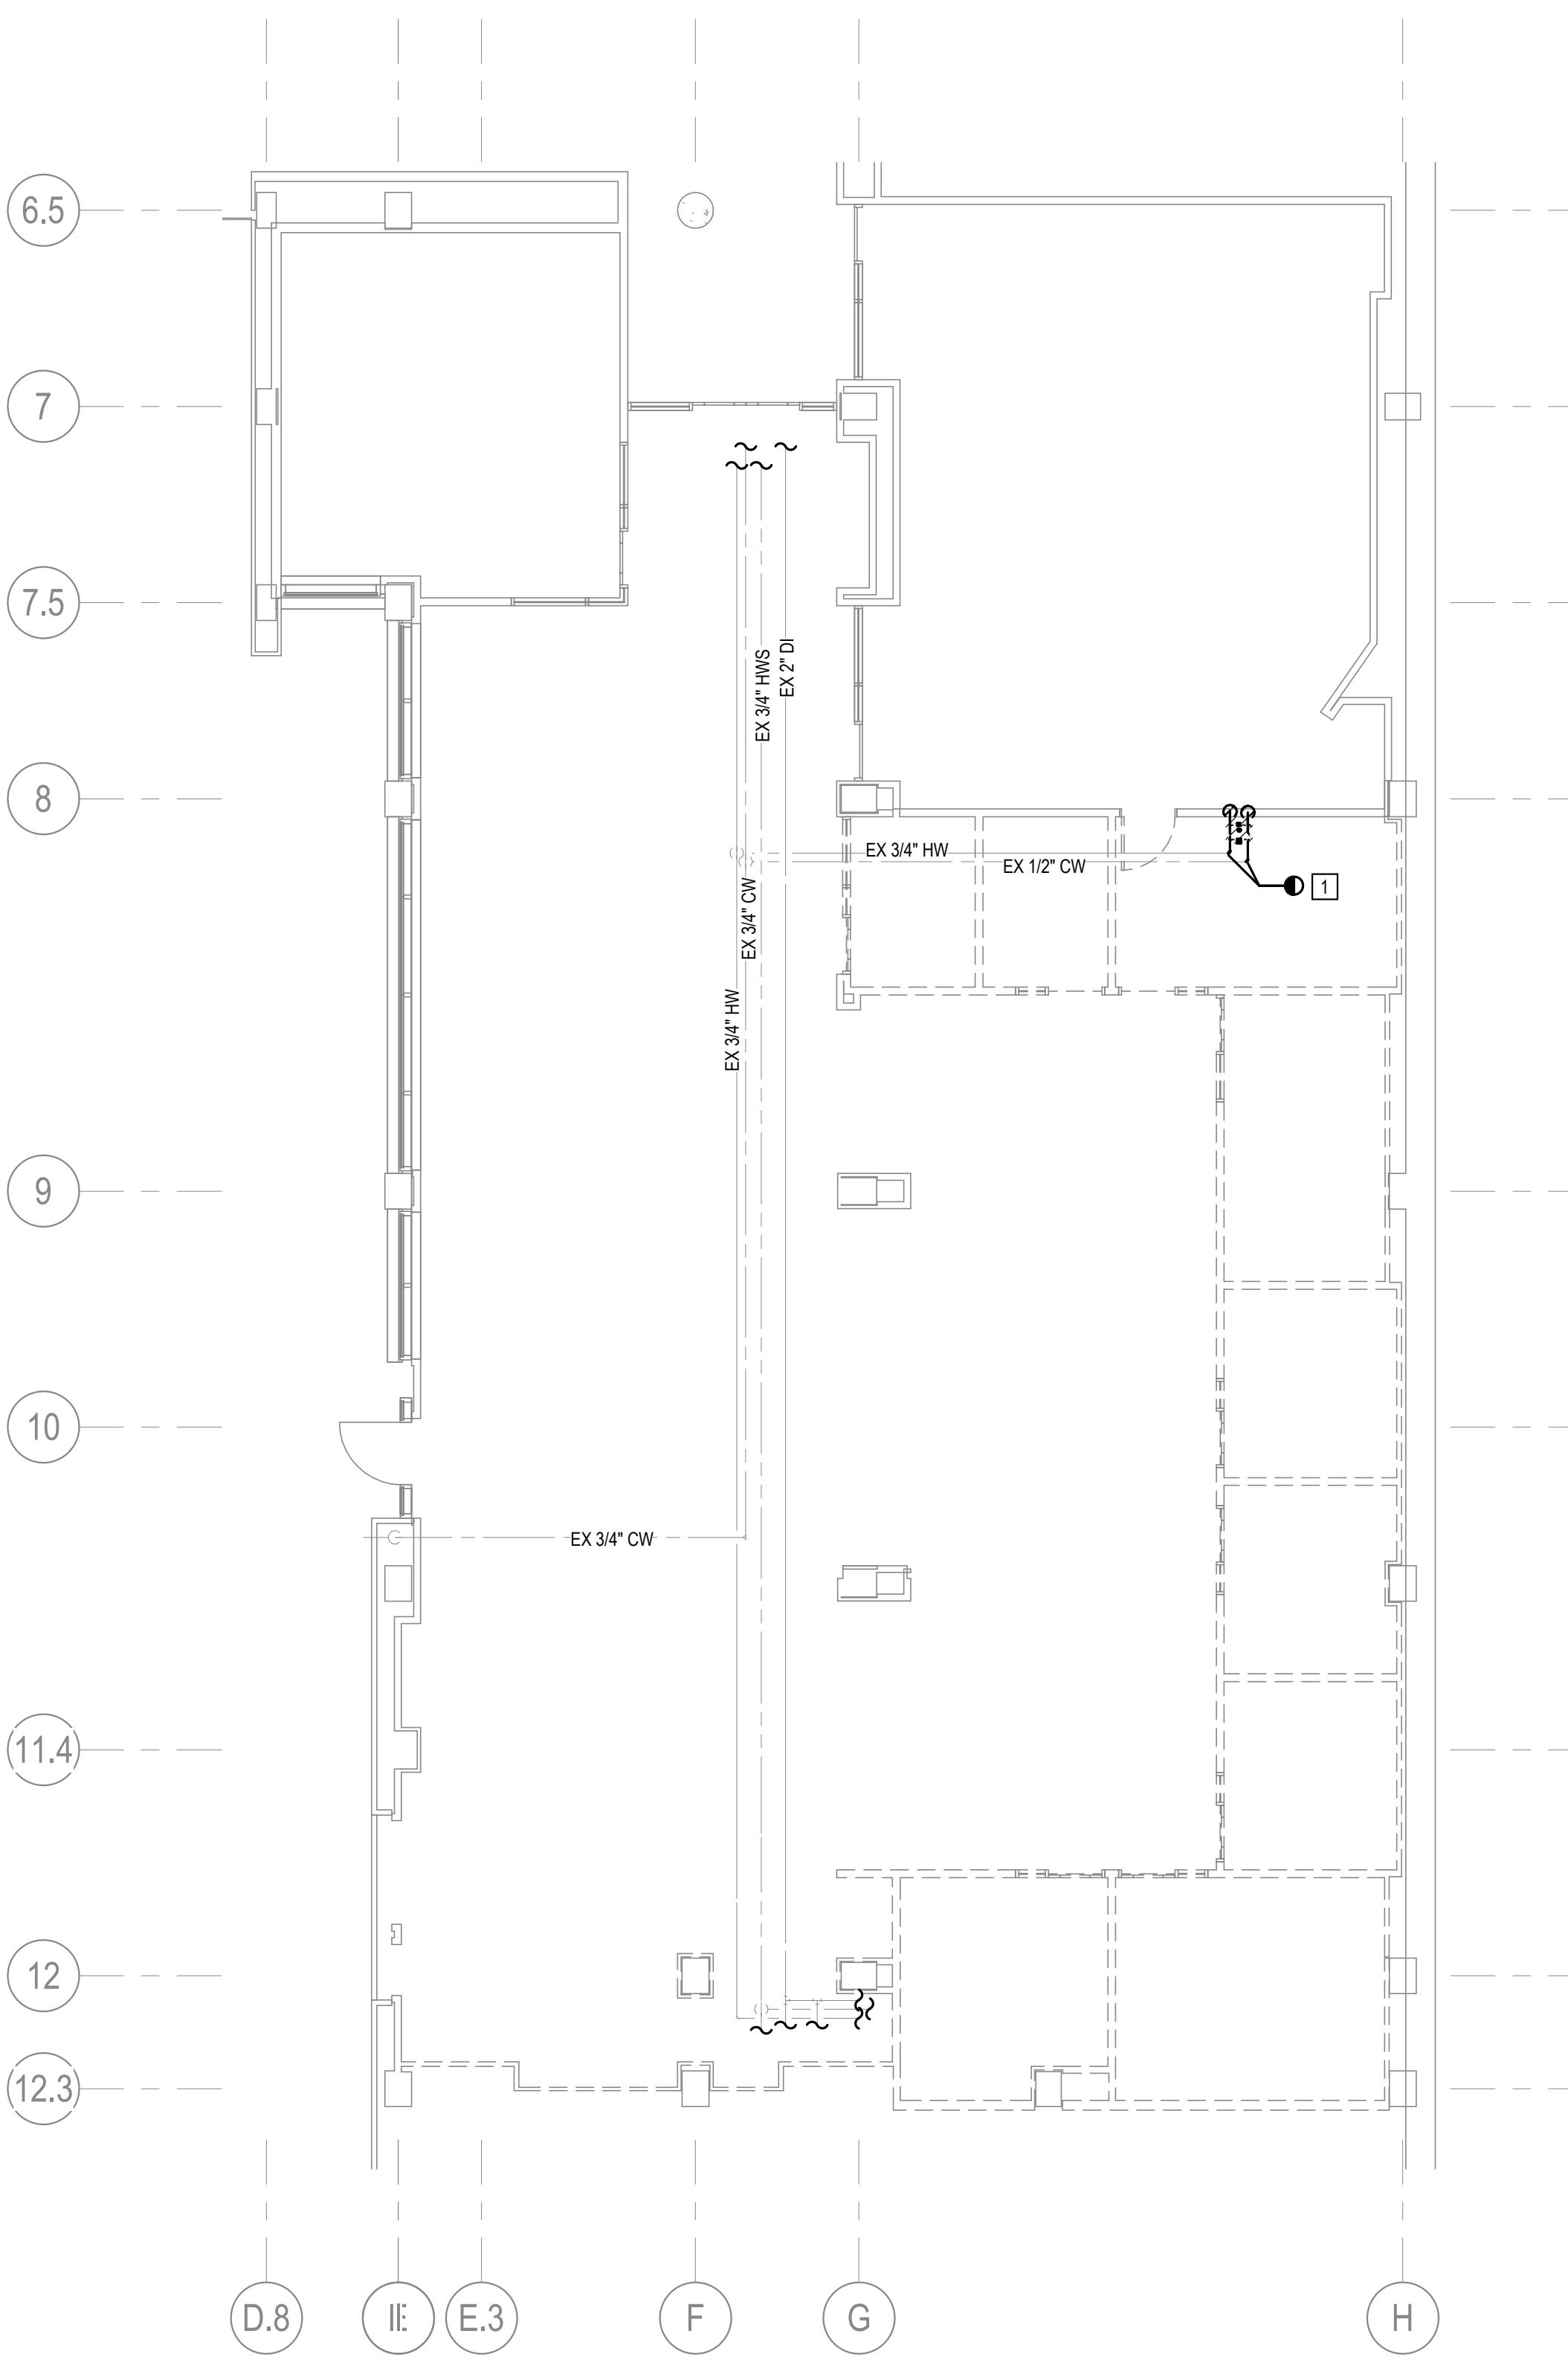

**2** PRESSURE PIPING GROUND DEMOLITION PLAN

SCALE: 1/8" = 1'-0"

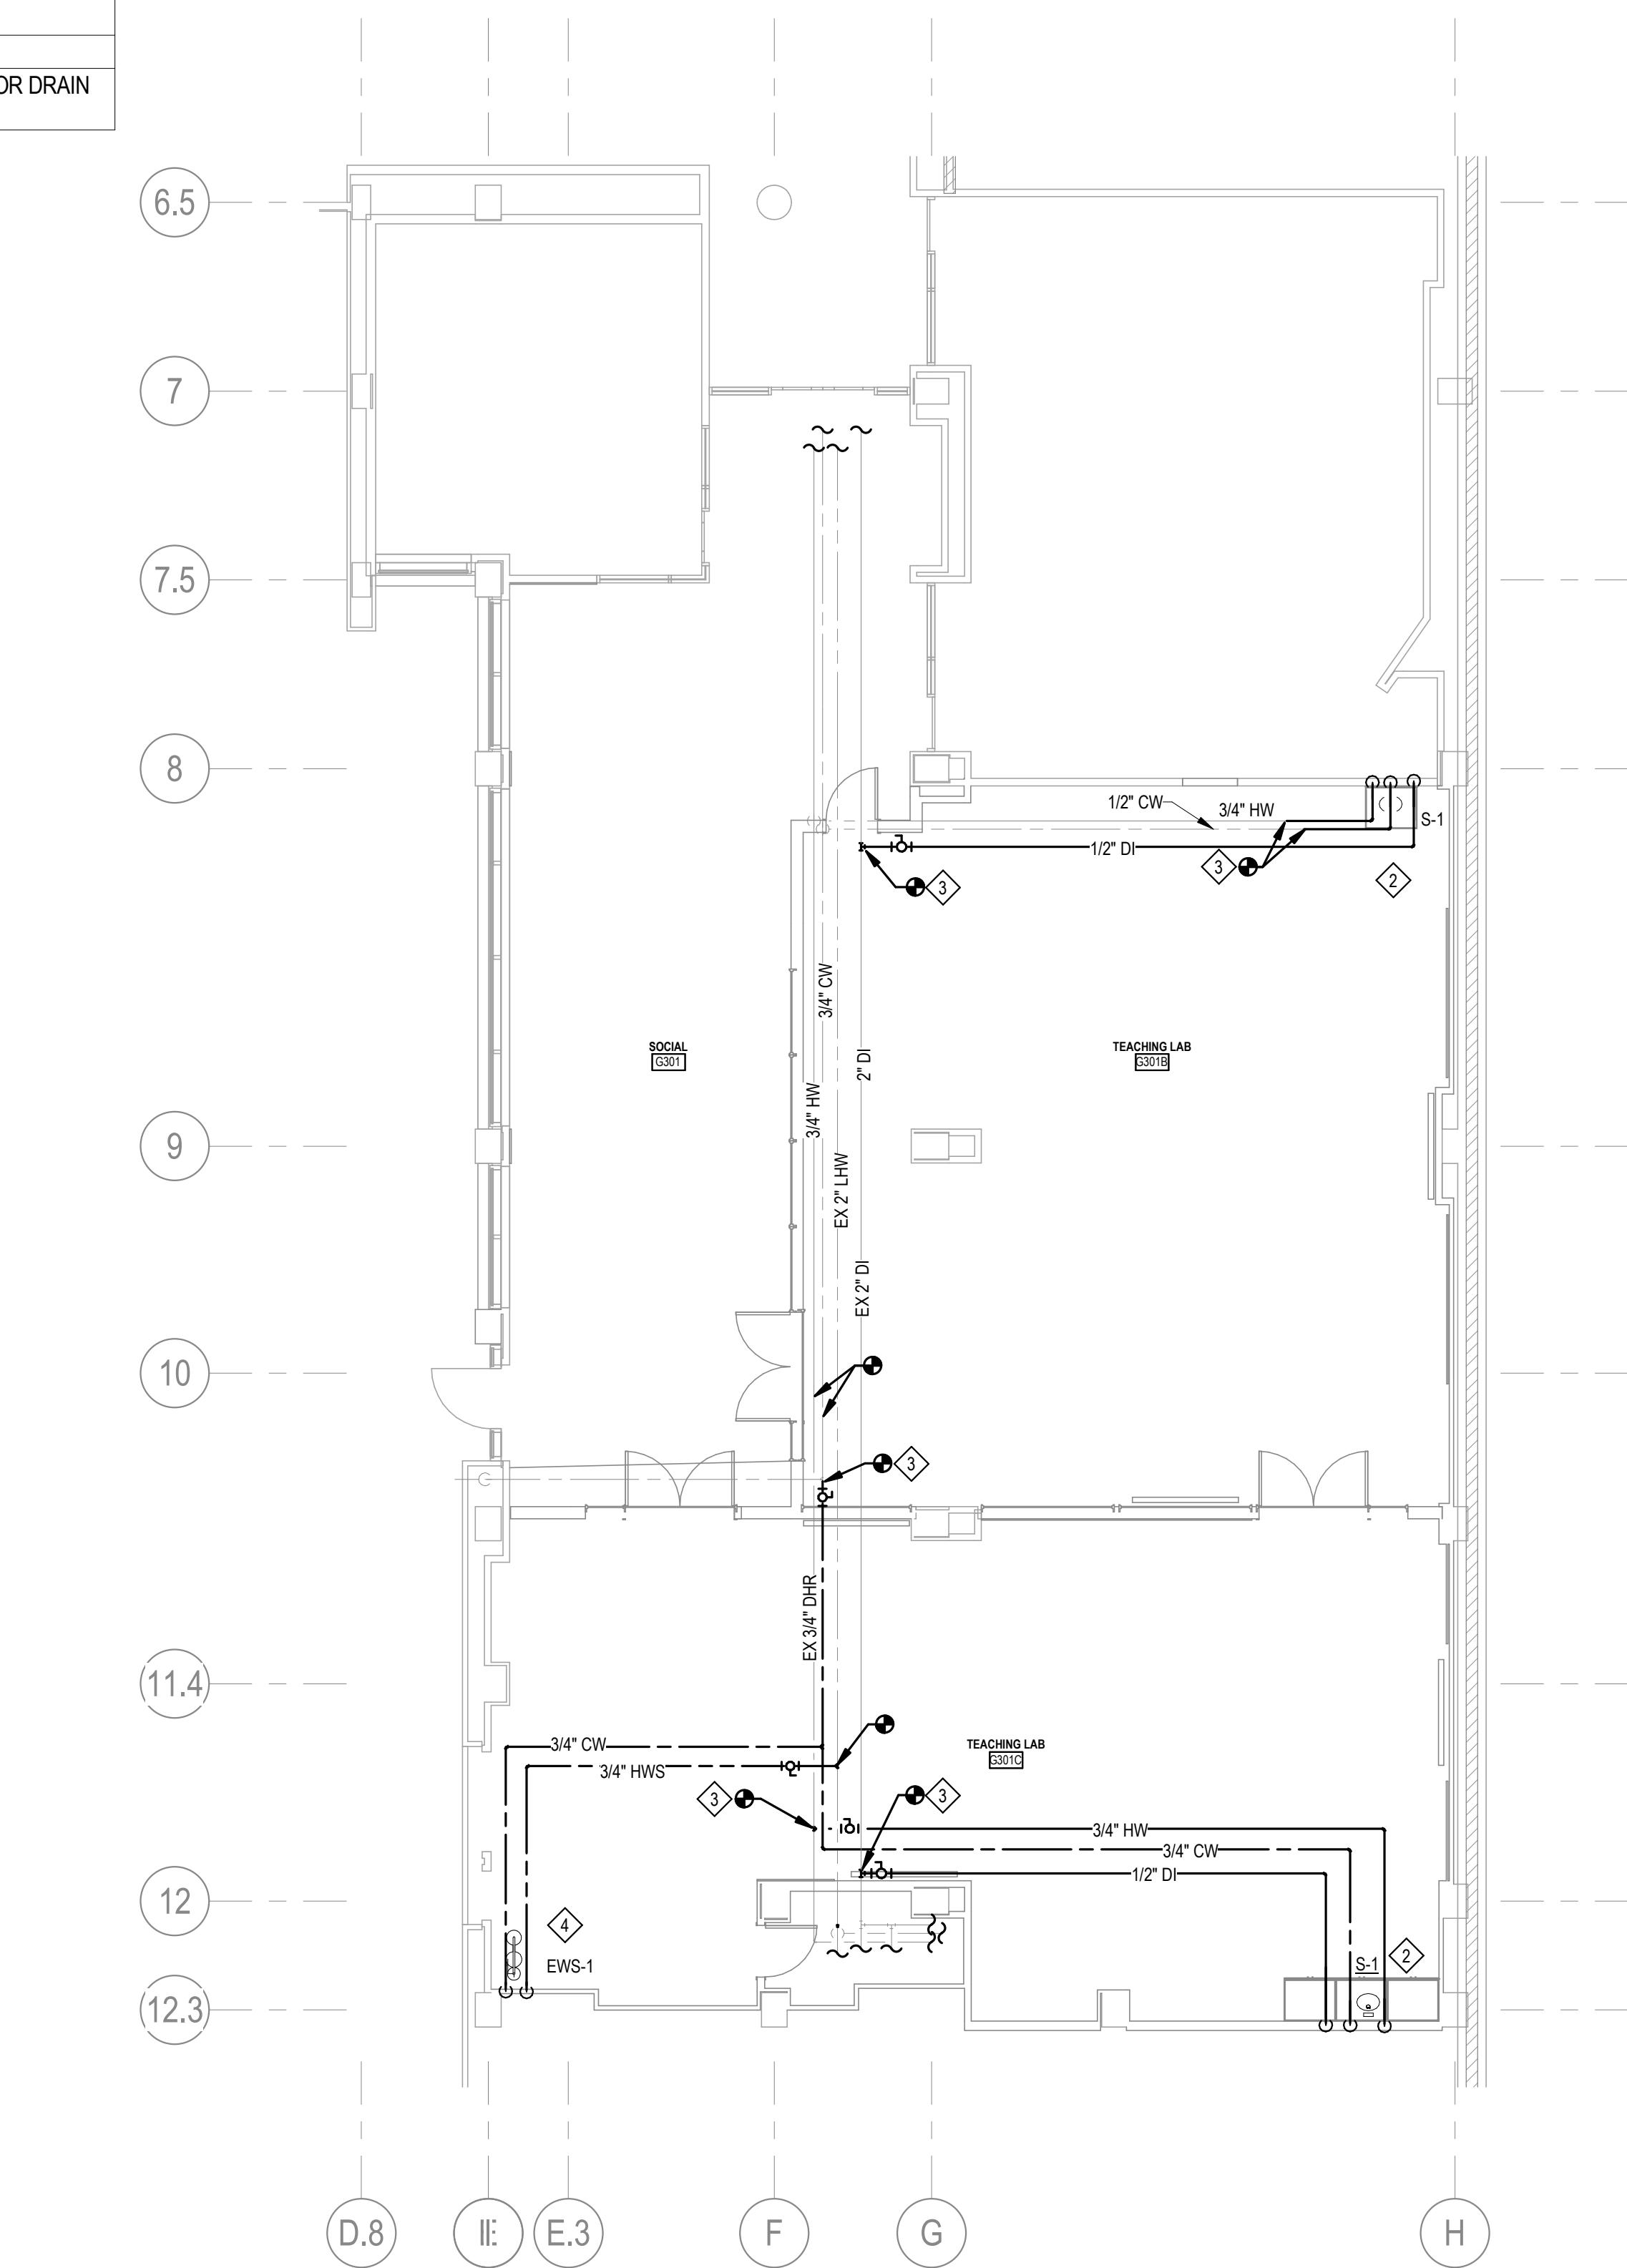

**1** PRESSURE PIPING GROUND PLAN

SCALE: 1/8" = 1'-0"

1/8" = 1'-0" 8' 4' 0 8' 16'







**NOTCH**  
NOTCH DESIGN, PLLC  
212 W MAIN ST, SUITE E,  
CARRBORO, NC  
www.notchdesign.us  
info@notchdesign.us




www.mckimcreed.com  
4300 Edwards Mill Rd Suite 200  
Raleigh, NC 27612  
(919) 223-8091  
(919) 233-8031 Fax

NC License# F-1222

REVISION  
SCO REVIEW 9/19/25  
2nd SCO REVIEW 10/24/25  
Construction Set 11/17/25

## CONSTRUCTION SET

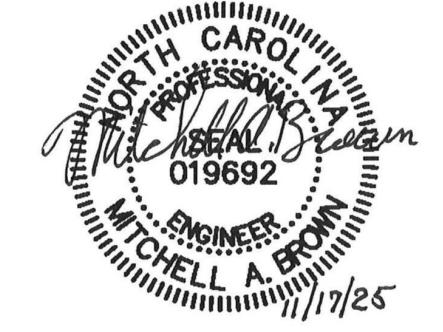

© 2024  
Notch Design

CLIENT NAME: THE UNIVERSITY OF NORTH CAROLINA AT CHAPEL HILL  
JOB NAME: UNC VENABLE HALL LOWER LEVEL UPGRADE

LOCATION: 101 South RD  
CHAPEL HILL, NC 27514

SCO ID: 24-28389-01A

ISSUE DATE: 11-17-25

JOB NO. 10021-0001

DWG. NO.

**FP111**

FIRE PROTECTION  
- GROUND FLOOR  
PLAN



### 1 FIRE PROTECTION GROUND PLAN

SCALE: 1/8" = 1'-0"

1/8" = 1'-0" 8' 4' 0 8' 16'