
Window Replacements for

Morehead City Middle School

Carteret County Schools
NCDSP Unit 160 - School 318

400 Barbour Rd / Morehead City / North Carolina

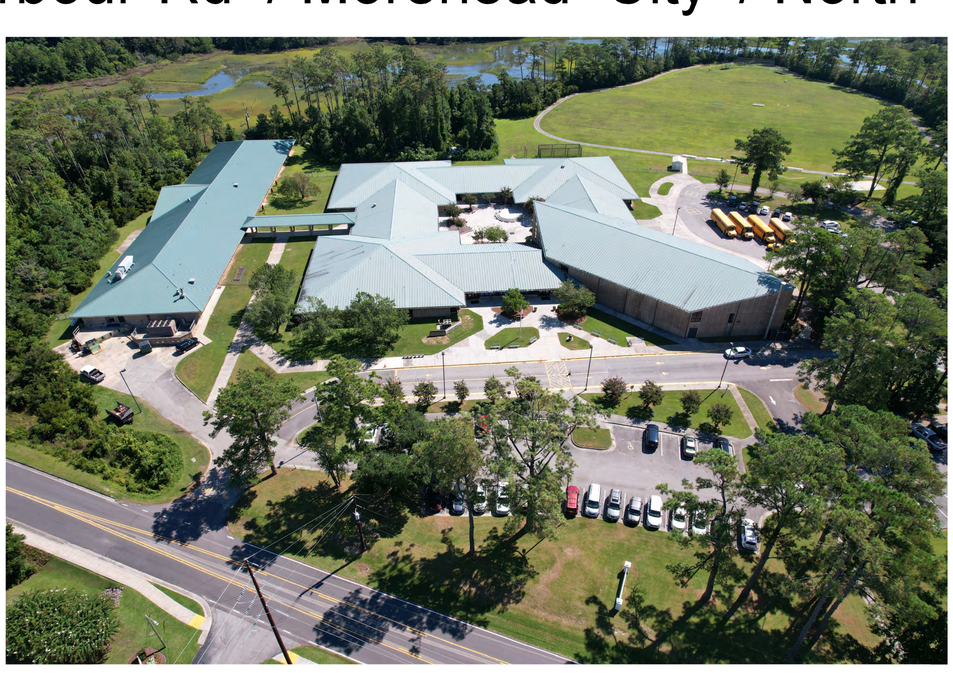

ABBREVIATIONS

AFF	ABOVE FINISH FLOOR
L	ANGLE
AB	ANCHOR BOLT
@	AT
B/B	BACK TO BACK (CURB)
BRG	BEARING
BD	BOARD
BC	BRICK COURSE
BLDG	BUILDING
CI	CAST IRON
CPT	CARPET
CB	CATCH BASIN
CLG	CEILING
CT	CEILING TILE
CB	CHALKBOARD
CJ	CONSTRUCTION JOINT
CONC	CONCRETE
CMU	CONCRETE MASONRY UNIT
CG	CORNER GUARD
CMP	CORRUGATED METAL PIPE
CONT.	CONTINUOUS
C & R	CURTAIN & ROD
C & T	CURTAIN & TRACK
DIA	DIAMETER
DIM	DIMENSION
DS	DOWNSPOUT
DWR	DRAWER
EA	EACH
EC	ELECTRICAL CONTRACTOR
EIFS	EXTERIOR INSULATION & FIN SYSTEM
ELECT	ELECTRICAL
EWC	ELECTRIC WATER COOLER
ELEV	ELEVATION
EQ	EQAUL
ETR	EXISTING TO REMAIN
EXIST	EXISTING
EXP	EXPOSED, EXPANSION
EJ	EXPANSION JOINT
F/F	FACE TO FACE (CURB)
FIN	FINISH
FE	FIRE EXTINGUISHER
FEC	FIRE EXTINGUISHER CABINET
FHC	FIRE HOSE CABINET
FTG	FOOTING
FD	FLOOR DRAIN
FL	FLOOR
FSR	FLEXIBLE SHEET ROOFING
GB	GYPSUM WALLBOARD
GC	GENERAL CONTRACTOR
HM	HOLLOW METAL
HOR	HORIZONTAL
INSUL	INSULATION
INV	INVERT
JT	JOINT
LAV	LAVATORY
MAS	MASONRY
MAX	MAXIMUM
MB	MARKER BOARD
MET	METAL
MC	MECHANICAL CONTRACTOR
MT	METAL THRESHOLD
MIN	MINIMUM
MISC	MISCELLANEOUS
NOM	NOMINAL
N	NORTH
NIC	NOT IN CONTRACT
NTS	NOT TO SCALE
OC	ON CENTER
OPG	OPENING
OPP	OPPOSITE
PC	PLUMBING CONTRACTOR
PLAS	PLASTER
PL	PLATE
PT	PRESSURE TREATED
R	RADIUS
REF	REFERENCE
RENIF	REINFORCED
RCP	REINFORCE CONCRETE PIPE
REQ'D	REQUIRED
RFS	RUBBER FASTENING STRIP
RI	RIGID INSULATION
R/W	RIGHT OF WAY
RD	ROOF DRAIN
RDL	ROOF DRAIN LEADER
RGH	ROUGH
SCHED	SCHEDULED
SCJ	SAW CUT JOINT
SH	SHELF
SHTG	SHEATHING
SIM	SIMILAR
SPEC	SPECIFIED
SPECS	SPECIFICATIONS
STD	STANDARD
SUSP	SUSPENDED
TB	TACKBOARD
TYP	TYPICAL
TJC	TYPICAL CONTROL JOINT
UON	UNLESS OTHERWISE NOTED
UR	URINAL
VB	VAPOR BARRIER
VERT	VERTICAL
VCT	VINYL COMPOSITION TILE
WC	WATER CLOSET
WWF	WELDED WIRE FABRIC
W/	WITH

Hite associates

ARCHITECTURE / PLANNING / TECHNOLOGY

2600 Meridian Drive / Greenville, N.C. 27834 / tel 252-757-0333

DRAWING INDEX

BCS-101	BUILDING CODE SUMMARY
A-101	WINDOW ELEVATIONS / DETAILS

ORIGINAL BUILDING DRAWINGS (ANNOTATIONS FOR NEW WORK IN RED):

00	COVER SHEET
01	OVERALL FLOOR PLAN
02	EXTERIOR ELEVATIONS / WALL DETAILS
03	COURTYARD ELEVATIONS / WALL SECTIONS / DETAILS
04	BUILDING SECTION / INTERIOR ELEVATIONS / WALL DETAILS
05	ENLARGED TOILET PLAN / INTERIOR ELEVATIONS
06	DOOR & WINDOW ELEVATIONS & DETAILS
07	PLAN & SCHEDULES - NORTHWEST CLASSROOM QUADRANT
08	BUILDING SECTION / INTERIOR ELEVATIONS / WALL DETAILS
09	ENLARGED HOME ARTS PLAN & INTERIOR ELEVATIONS
10	MUSIC & BAND SECTIONS & INTERIOR ELEVATIONS
11	PLAN & SCHEDULES - NORTHEAST CLASSROOM QUADRANT
12	BUILDING SECTION / INTERIOR ELEVATIONS / WALL DETAILS
13	PLAN & SCHEDULES - SOUTHEAST CLASSROOM QUADRANT
14	ENLARGED ART CLASSROOM PLAN / INTERIOR ELEVATIONS
15	SHOP CLASSROOM BUILDING SECTION / INTERIOR ELEVATIONS
16	PLAN & SCHEDULES - GYM & COMMONS AREA
17	ENLARGED LOCKER FLOOR PLAN / INTERIOR ELEVATIONS
18	GYMNASIUM SECTIONS & DETAILS
19	GYMNASIUM & COMMONS INTERIOR ELEVATIONS
20	FOUNDATION PLAN / DETAILS / FOOTING SCHEDULE
21	2ND FLOOR FRAMING PLAN / DETAILS / LINTEL SCHEDULE
22	ROOF FRAMING PLAN / SCHEDULE / DETAILS

copyright 2023 Hite associates

Building Code Summary
Window Replacement Existing Building

Name of Project: Broad Creek Middle School
Address: 2382 Highway 24, Newport, NC
Proposed Use: Education
Owner or Authorized Agent: James G. Hite Phone No. (252) 757-0333 e-mail jgh@hiteassoc.com
Owned by: [X] City/County [ ] Private [ ] State
Code Enforcement Jurisdiction: [ ] City [X] County [ ] State

LEAD DESIGN PROFESSIONAL: James G. Hite, AIA

Designer	Firm	Name	License #	Telephone #	e-mail
Architectural	Hite Associates	James G. Hite, AIA	NC 3754	(252) 757-0333	jgh@hiteassoc.com
Civil	NA				
Electrical	NA				
Fire Alarm	NA				
Plumbing	NA				
Mechanical	NA				
Sprinkler-Standpipe	NA				
Structural	NA				
Retaining Walls>5' High	NA				
Other	NA				

2018 NC BUILDING CODE:
[ ] New Building [ ] Shell / Core [ ] 1st Time Interior Completions
[ ] Addition [ ] Phased Construction - Shell Core

2018 NC EXISTING BUILDING CODE:
[ ] Prescriptive [X] Alteration Level I [ ] Historic Property
[ ] Repair [ ] Alteration Level II [ ] Change of Use
[ ] Chapter 14 [ ] Alteration Level III

CONSTRUCTED 1974 CURRENT USE EDUCATION
RENOVATED 2023 PROPOSED USE EDUCATION
OCCUPANCY CATEGORY (TABLE 1604.5): CURRENT: III PROPOSED: III

BUILDING DATA
Construction Type: [ ] I-A [ ] II-A [ ] III-A [ ] IV [ ] V-A
[ ] I-B [X] II-B [ ] III-B [ ] V-B
Mixed Construction: [X] No [ ] Yes Types
Sprinklers:
Ground Floor [X] No [ ] Yes [ ] Partial [ ] NFPA 13 [ ] NFPA 13R [ ] NFPA 13D
Equipment Platform [ ] No [X] Yes [ ] Partial [ ] NFPA 13 [ ] NFPA 13R [ ] NFPA 13D
Standpipes: [X] No [ ] Yes Class [ ] I [ ] II [ ] III Wet Dry
Fire District: [ ] No [X] Yes Flood Hazard Area: [X] No [ ] Yes
Building Height: Feet: 21' Number of Stories: 1
Special Inspections Required: [X] No [ ] Yes

Gross Building Area:

Floor	Existing (SQ FT)	New (SQ FT)	Sub-Total
Equipment Platform			
Third Floor			
Second Floor			
First Floor		98,167	
Total		98,167	

ALLOWABLE AREA
Primary Occupancy:
Assembly [ ] A-1 [ ] A-2 [ ] A-3 [ ] A-4 [ ] A-5
[ ] Business
[X] Educational
Factory [ ] F-1 Moderate [ ] F-2 Low
Hazardous [ ] H-1 Detonate [ ] H-2 Deflagrate [ ] H-3 Combust [ ] H-4 Health [ ] H-5 HPM
Institutional [ ] I-1 [ ] I-2 [ ] I-3 [ ] I-4
I-3 Condition [ ] 1 [ ] 2 [ ] 3 [ ] 4 [ ] 5
[ ] Mercantile
Residential [ ] R-1 [ ] R-2 [ ] R-3 [ ] R-4
Storage [ ] S-1 Moderate [ ] S-2 Low [ ] High-Piled
Parking Garage [ ] Open [ ] Enclosed [ ] Repair
[ ] Utility and Miscellaneous

Accessory Occupancy Classification(s): Assembly, Business, S-1
Incidental Uses (Table 509): NA
This Separation is not exempt as a Non-Separated Use (see exceptions)
Special Uses (Chapter 4 - List code Sections): NA
Special Provisions (Chapter 5 - List code Sections): NA

Mixed Occupancy: [ ] No [X] Yes Separation: Hr: Exception:

[ ] Non-Separated Use (508.3)
The required type of construction of the building shall be determined by applying the height and area limitations for each of the applicable occupancies to the entire building. The most restrictive type of construction, so determined, shall apply to the entire building.

[ ] Separated Use (508.4) - See below for area calculations
For each story, the area of the occupancy shall be such that the sum of the ratios of the actual floor area of each use divided by the allowable floor area for each use shall not exceed 1.

$$\frac{\text{Actual Area of Occupancy A}}{\text{Allowable Area of Occupancy A}} + \frac{\text{Actual Area of Occupancy B}}{\text{Allowable Area of Occupancy B}} \leq 1$$

$$\frac{0}{0} + \frac{0}{0} + 0 \leq 1.00$$

STORY NO.	DESCRIPTION AND USE	(A) BLDG AREA PER STORY (ACTUAL)	(B) TABLE 506.2 AREA a	(C) AREA FOR OPEN SPACE INCREASE 1.5	(D) ALLOWABLE AREA OR UNLIMITED 2,3

1 Frontage increases from Section 506.2 are computed thus:
a. Perimeter which fronts a public way or open space having 20 feet minimum width = 0 (F)
b. Total Building Perimeter = 0 (P)
c. Ratio (F/P) = 0 (F/P)
d. W= Minimum width of public way = 0 (W)
2 Unlimited area applicable under conditions of Section 507.
3 Maximum Building Area = total number of stories in the building x D (506.2)
4 The maximum area of parking garages must comply with 406.5.4. The maximum area of air traffic control towers must comply with 412.3.1.
5 Frontage increase is based on the unsprinkled area value in Table 506.2.

ALLOWABLE HEIGHT

	ALLOWABLE	SHOWN ON PLANS	CODE REFERENCE
Building Height in Feet (Table 504.3)	Feet 75	21	
Building Height in Stories (Table 504.4)	Stories 3	1	

FIRE PROTECTION REQUIREMENTS

BUILDING ELEMENT	FIRE SEPARATION DISTANCE (FEET)	RATING REQ'D	RATING PROVIDED (W/ REDUCTION) *	DETAIL NO. AND SHEET NO.	DESIGN NO. FOR RATED ASSEMBLY	DESIGN NO. FOR RATED PENETRATION	DESIGN NO. FOR RATED JOIST
Structural frame, including columns, girders, trusses		NA	NA	NA	NA	NA	NA
Bearing walls							
Exterior							
North	NA	NA	NA	NA	NA	NA	NA
East	NA	NA	NA	NA	NA	NA	NA
West	NA	NA	NA	NA	NA	NA	NA
South	NA	NA	NA	NA	NA	NA	NA
Interior	NA	NA	NA	NA	NA	NA	NA
Nonbearing walls and partitions Exterior							
North	NA	NA	NA	NA	NA	NA	NA
East	NA	NA	NA	NA	NA	NA	NA
West	NA	NA	NA	NA	NA	NA	NA
South	NA	NA	NA	NA	NA	NA	NA
Interior		NA	NA	NA	NA	NA	NA
Floor construction including support beams and joist		NA	NA	NA	NA	NA	NA
Above Corridor		NA	NA	NA	NA	NA	NA
Columns Supporting Floors							
Roof construction including support beams and joist		NA	NA	NA	NA	NA	NA
Roof Ceiling Assembly		NA	NA	NA	NA	NA	NA
Columns Supporting Roof		NA	NA	NA	NA	NA	NA
Shafts - Exit		NA	NA	NA	NA	NA	NA
Shafts - Other		NA	NA	NA	NA	NA	NA
Corridor Separation		NA	NA	NA	NA	NA	NA
Occupancy Separation		NA	NA	NA	NA	NA	NA
Party/Fire Wall Separation		NA	NA	NA	NA	NA	NA
Fire Barrier Separation		NA	NA	NA	NA	NA	NA
Smoke Partition		NA	NA	NA	NA	NA	NA
Tenant Separation		NA	NA	NA	NA	NA	NA
Incidental Use Separation		NA	NA	NA	NA	NA	NA

* ICC Approved Assembly

PERCENTAGE OF WALL AREA CALCULATIONS

FIRE SEPARATION DISTANCE FROM PROPERTY LINES	DEGREE OF OPENINGS PROTECTION (TABLE 705.8)	ALLOWABLE AREA	ACTUAL SHOWN ON PLANS
>30	Unprotected	No Limit	NA
10 < 15	Unprotected	NA	NA

WIND DESIGN DATA / REQUIREMENTS FOR REPLACEMENT WINDOWS

1. Ultimate wind speed, Vult (3-second gust), miles per hour and normal wind speed, Vasp	Vult = 123 mph;, 3 sec. Gust Vasp = 95.3 mph		
2. Risk category:	III		
3. Wind exposure category:	C		
4. Application internal pressure coefficient:	+/- .018		
5. Design wind pressures to be used for exterior component and cladding materials which are not specifically designed by the registered design professional responsible for the design of the structure:		Positive (PSF)	Negative (PSF)
	ZONE 4	22.9	-24.9
	ZONE 5	22.9	-30.7

LIFE SAFETY SYSTEM REQUIREMENTS

Emergency Lighting:	[ ] No	[X] Yes
Exit Signs:	[ ] No	[X] Yes
Fire Alarm:	[ ] No	[X] Yes
Smoke Detection Systems:	[ ] No	[X] Yes
Carbon Monoxide Detection:	[ ] No	[X] Yes

Life Safety Plan Sheet #: NA
[ ] Fire and/or smoke rated wall locations (Chapter 7)
[ ] Assumed and real property line locations
[ ] Exterior wall opening area with respect to distance to assumed property lines (705.8)
[ ] Occupancy types for each area as it relates to occupant load calculation (Table 1004.1.2)
[ ] Occupant loads for each area
[ ] Exit access travel distances (1017)
[ ] Common path of travel distances (Tables 1006.2.1 & 1006.3.2(1))
[ ] Dead end lengths (1020.4)
[ ] Clear exit widths for each exit door
[ ] Maximum calculated occupant load capacity each exit door can accommodate based on egress width (1005.3)
[ ] Actual occupant load for each exit door
[ ] A separate schematic plan indicating where fire rated floor/ceiling and/or roof structure is provided for purposes of occupancy separation
[ ] Location of doors with panic hardware (1010.1.10)
[ ] Location of doors with delayed egress locks and the amount of delay (1010.1.9.7)
[ ] Location of doors with electromagnetic egress locks (1010.1.9.9)
[ ] Location of doors equipped with hold-open devices
[ ] Location of emergency escape windows (1030)
[ ] The square footage of each fire area (202)
[ ] The square footage of each smoke compartment for Occupancy Classification I-2 (407.5)
[ ] Note any code exceptions or table notes that may have been utilized regarding the items above

ACCESSIBLE DWELLING UNITS (SECTION 1107)

LOT OR PARKING AREA	ACCESSIBLE UNITS REQUIRED	ACCESSIBLE UNITS PROVIDED	TYPE A UNITS REQUIRED	TYPE A UNITS PROVIDED	TYPE B UNITS REQUIRED	TYPE B UNITS PROVIDED	TOTAL ACCESSIBLE UNITS PROVIDED

ACCESSIBLE PARKING (SECTION 1106)

LOT OR PARKING AREA	TOTAL NO. OF PARKING SPACES		NO. OF ACCESSIBLE SPACES REQUIRED / PROVIDED			TOTAL NO. ACCESSIBLE PROVIDED
	REQUIRED	PROVIDED	REGULAR WITH 5' ACCESS AISLE	VAN SPACES WITH 132" ACCESS AISLE	VAN SPACES WITH 8' ACCESS AISLE	
Existing						
New						
TOTAL						

PLUMBING FIXTURE REQUIREMENTS - ENTIRE FACILITY

USE		WATERCLOSETS		URINALS	LAVATORIES		SHOWERS/ TUBS	DRINKING FOUNTAINS	
		MALE	FEMALE		MALE	FEMALE		REGULAR	ACCESSIBLE
	NEW								
	EXISTING								
	REQ'D								
	NEW								
	EXISTING								
	REQ'D								
	NEW								
	EXISTING								
	REQ'D								

SPECIAL APPROVALS
Special approval: (Local Jurisdiction, Department of Insurance, SBCCI, ICC, etc., describe below)
None

ENERGY SUMMARY
ENERGY REQUIREMENTS:
The following data shall be considered minimum and any special attribute required to meet the energy code shall also be provided. Each Designer shall furnish the required portions of the project information for the plan data sheet. If performance method, state the annual energy cost for the standard reference design vs. annual energy cost for the proposed design.

Climate Zone:
[X] 3 [ ] 4 [ ] 5

Method of Compliance:
[X] Prescriptive (Energy Code)
[ ] Performance (Energy Code)
[ ] Prescriptive (ASHRAE 90.1)
[ ] Performance (ASHRAE 90.1)

THERMAL ENVELOPE

Roof/ceiling Assembly (each assembly)
Description of assembly N/A
U-Value of total assembly N/A
R-Value of insulation N/A
Skylights in each assembly NONE
U-Value of skylight N/A
total square footage of skylights in each assembly N/A

Exterior Walls (each assembly)
Description of assembly N/A
U-Value of total assembly N/A
R-Value of insulation N/A
Openings (windows or doors with glazing) Openings (windows)
U-Value of total assembly N/A
solar heat gain coefficient
projection factor
Door R-Value N/A

Exterior Walls (each assembly)
Description of assembly N/A
U-Value of total assembly N/A
R-Value of insulation N/A
Openings (windows or doors with glazing) Openings (windows)
U-Value of total assembly N/A
shading Coefficient
projection factor
Door R-Values N/A

Walls below grade - NOT USED
Description of assembly -
U-Value of total assembly
R-Value of insulation

Floor over unconditioned space (each assembly) - NOT USED
Description of assembly -
U-Value of total assembly -
R-Value of insulation -

Floor slab on grade
Description of assembly = 4" thick concrete slab
U-Value of total assembly = 0.21
R-Value of insulation = N/A
Horizontal/vertical requirement
slab heated - NO

Revision / Date / No.

Hite associates
ARCHITECTURE / PLANNING / TECHNOLOGY
2600 Meridian Drive / Greenville, NC 27834 / tel (252) 757-0333


HITE ASSOCIATES, P.C. CERTIFICATE OF INCORPORATION NUMBER C-0418 STATE OF NORTH CAROLINA GREENVILLE 3/23/1978

JAMES GRAY HITE REGISTERED ARCHITECT 3754 GREENVILLE

Window Replacement for
Morehead City Middle School
400 Barbour Rd. ● Morehead City, 28570
Carteret County Schools / North Carolina


Project No. 22310
Date: 12 April 2023
Drawing no. BCS 001

copyright 2023 Hite associates

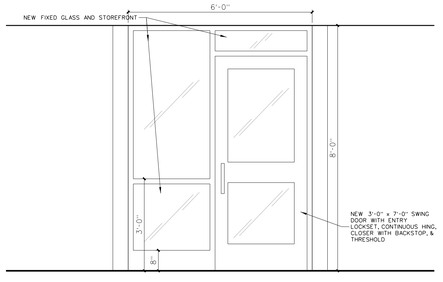

101.2 SLIDING DOOR REPLACEMENT WITH SWING DOOR AND SIDELIGHT AT PRINCIPAL DOOR #10

SCALE: 1/2" = 1'-0"

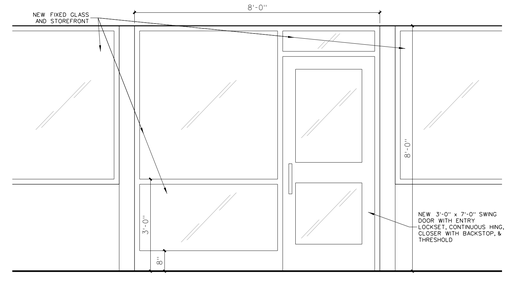

101.1 SLIDING DOOR REPLACEMENT WITH SWING DOOR AND SIDELIGHT AT HOME ARTS DOOR #40 AND ART DOOR #86

SCALE: 1/2" = 1'-0"

No.	Date:	Revision

Hite associates
ARCHITECTURE / PLANNING / TECHNOLOGY
2600 Meridian Drive / Greenville, NC 27834 / tel (252) 757-0333

HITE ASSOCIATES, P.C. REGISTERED ARCHITECTURAL CORPORATION LICENSE NUMBER C-418 GREENVILLE, N.C.

JAMES GRAY HITE REGISTERED ARCHITECT 3734 GREENVILLE, N.C.

Window Replacement for
Morehead City Middle School
400 Barbour Rd, Morehead City 28570
Carteret County Schools / North Carolina

Project No.: 22310

Date: 12 April 2023

Drawing no.: A 101

INDEX TO DRAWINGS

ARCHITECTURAL

	TITLE SHEET AND INDEX
1	KEY PLAN
2	EXTERIOR ELEVATIONS
3	COURTYARD ELEVATIONS
4	CLASSROOM INTERIOR ELEVATIONS
5	TYPICAL POD TOILET ROOMS
6	WALL, DOOR, AND WINDOW TYPES
7	MATH/SCIENCE POD PLAN
8	ADMINISTRATION SUITE INTERIOR ELEVATIONS
9	HOME ARTS SUITE PLAN
10	MUSIC SUITE INTERIOR ELEVATIONS
11	LAGS POD PLAN
12	MEDIA CENTER INTERIOR ELEVATIONS
13	SIXTH GRADE POD PLAN
14	ART SUITE PLAN
15	SHOP SUITE INTERIOR ELEVATIONS
16	GYMNASIUM/COMMONS PLAN
17	LOCKER ROOMS
18	GYMNASIUM/COMMONS INTERIOR ELEVATIONS
19	GYMNASIUM INTERIOR ELEVATIONS
20	FOUNDATION PLAN
21	SECOND FLOOR FRAMING PLAN
22	ROOF FRAMING PLAN
23	STRUCTURAL DETAILS

PLUMBING

P-1	PLUMBING SITE PLAN
P-2	MATH/SCIENCE POD PLUMBING PLAN
P-3	LAGS POD PLUMBING PLAN
P-4	SIXTH GRADE POD PLUMBING PLAN
P-5	GYM/COMMONS PLUMBING PLAN

MECHANICAL


M-1	MATH/SCIENCE POD MECHANICAL PLAN
M-2	LAGS POD MECHANICAL PLAN
M-3	SIXTH GRADE POD MECHANICAL PLAN
M-4	GYM/COMMONS FIRST FLOOR MECH. PLAN
M-5	GYM/COMMONS SECOND FLOOR MECH. PLAN
M-6	PIPING DIAGRAMS
M-7	EQUIPMENT SCHEDULES
M-8	ELECTRICAL CONNECTIONS SCHEDULE

ELECTRICAL

E-1	ELECTRICAL SITE PLAN
E-2	FIRE ALARM AND COMMUNICATIONS SYSTEM
E-3	MATH/SCIENCE POD ELECTRICAL PLAN
E-4	LAGS POD ELECTRICAL PLAN
E-5	SIXTH GRADE POD ELECTRICAL PLAN
E-6	GYM/COMMONS FIRST FLOOR ELECT. PLAN
E-7	GYM/COMMONS SECOND FLOOR ELECT. PLAN
E-8	COURTYARD ELECTRICAL PLAN
E-9	DISTRIBUTION DIAGRAM

LANDSCAPE

L-1	STAKING PLAN
L-2	GRADING AND DRAINAGE PLAN
L-3	STAKING PLAN
L-4	SITE PLAN AT BUILDING
L-5	COURTYARD PLAN
L-6	COURTYARD GRADING AND DRAINAGE PLAN
L-7	CONSTRUCTION DETAILS
L-8	CONSTRUCTION DETAILS
L-9	PLANT LIST AND DETAILS
L-10	SEDIMENTATION AND EROSION CONTROL PLAN
L-11	PLANTING PLAN

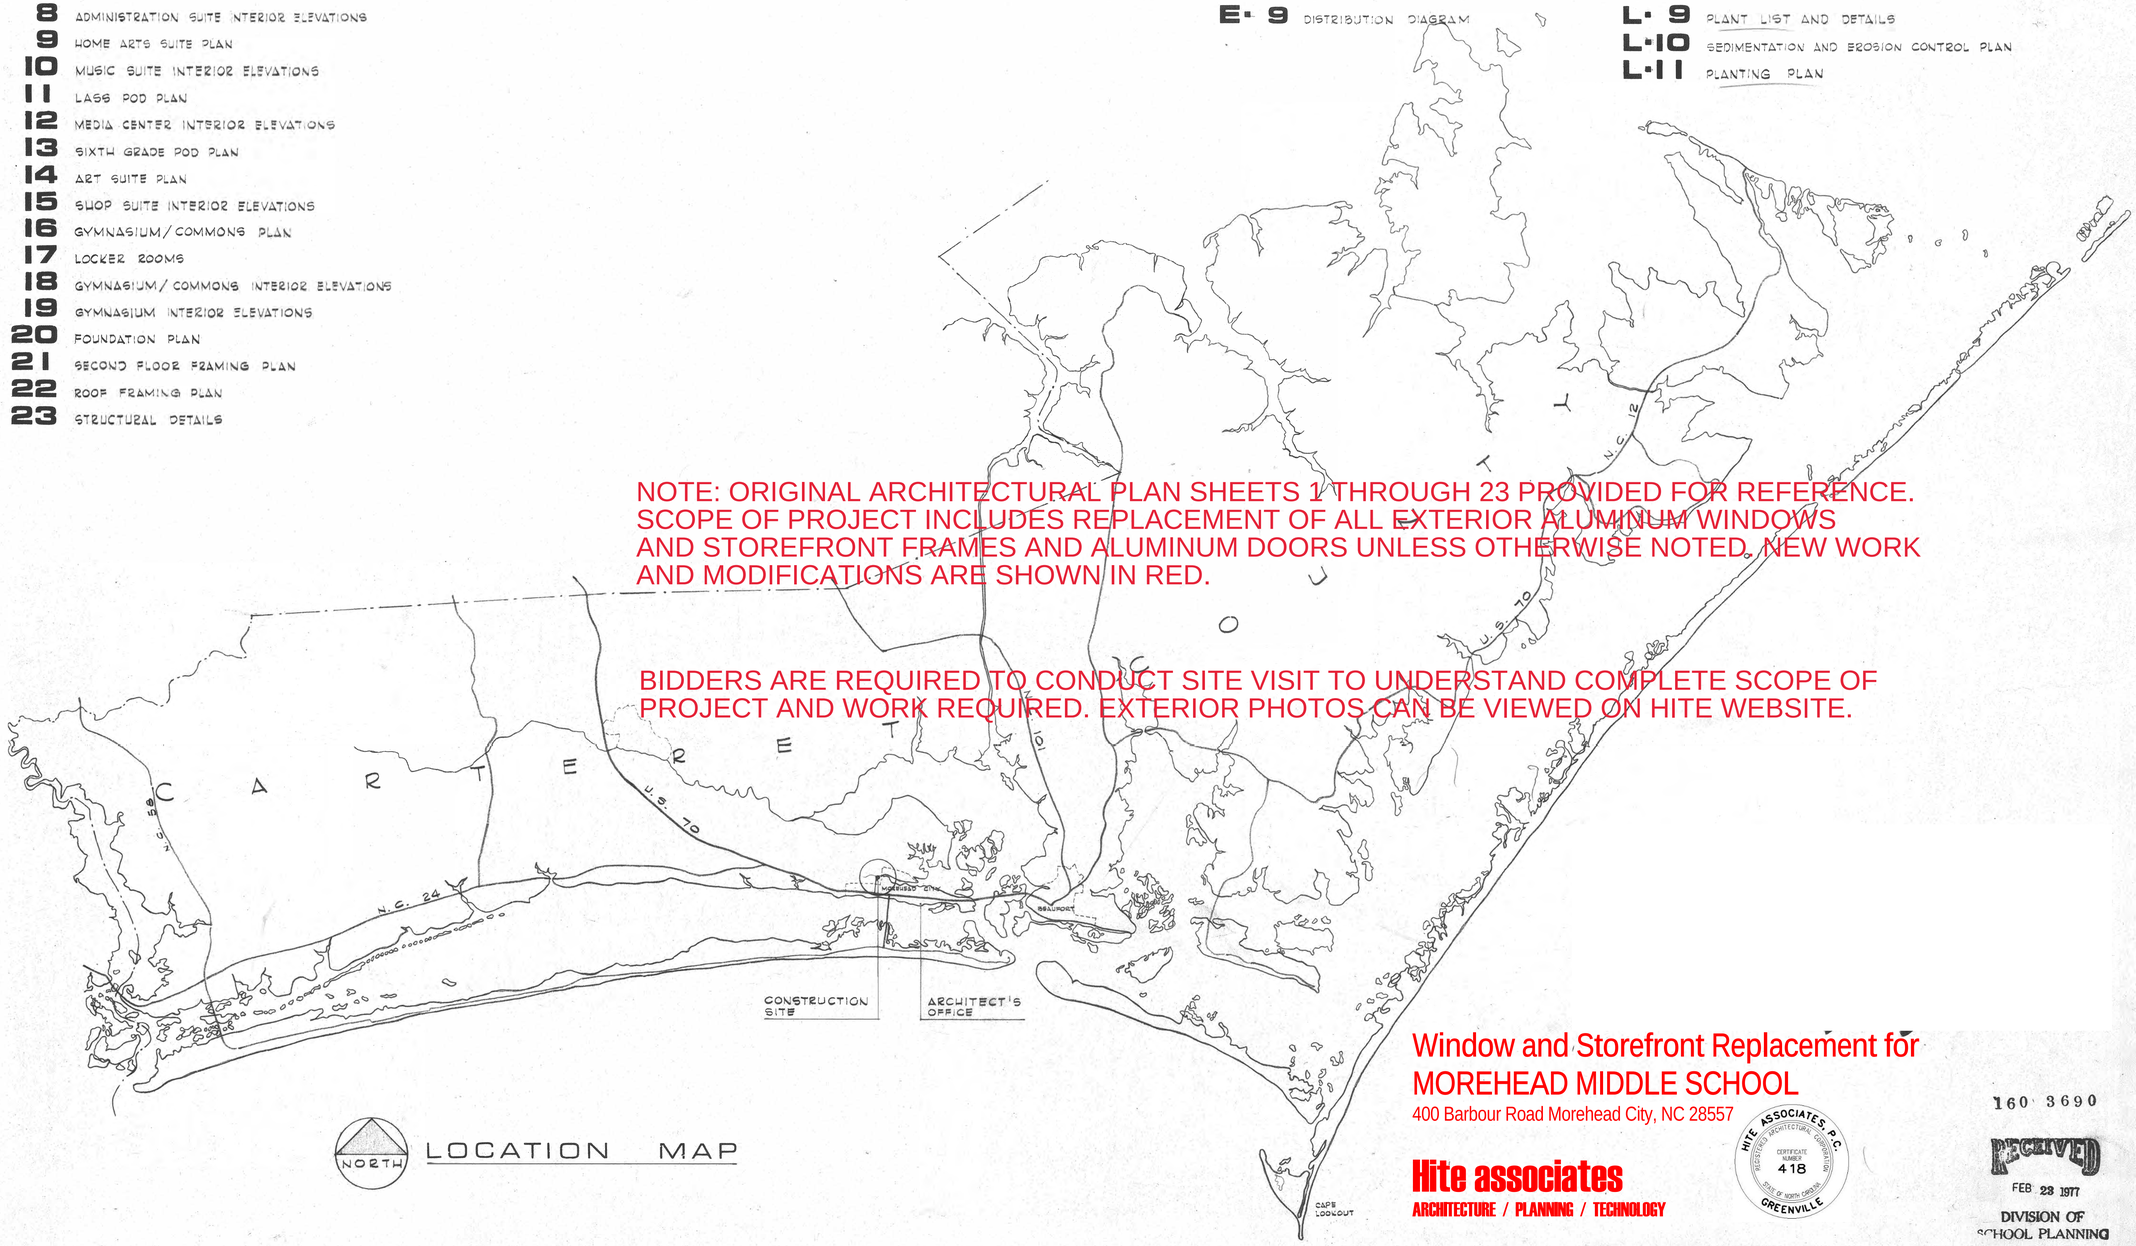

NORTH LOCATION MAP

NOTE: ORIGINAL ARCHITECTURAL PLAN SHEETS 1 THROUGH 23 PROVIDED FOR REFERENCE. SCOPE OF PROJECT INCLUDES REPLACEMENT OF ALL EXTERIOR ALUMINUM WINDOWS AND STOREFRONT FRAMES AND ALUMINUM DOORS UNLESS OTHERWISE NOTED. NEW WORK AND MODIFICATIONS ARE SHOWN IN RED.

BIDDERS ARE REQUIRED TO CONDUCT SITE VISIT TO UNDERSTAND COMPLETE SCOPE OF PROJECT AND WORK REQUIRED. EXTERIOR PHOTOS CAN BE VIEWED ON HITE WEBSITE.

Window and Storefront Replacement for
MOREHEAD MIDDLE SCHOOL
400 Barbour Road Morehead City, NC 28557

Hite associates
ARCHITECTURE / PLANNING / TECHNOLOGY

HITE ASSOCIATES, P.A. REGISTERED ARCHITECTURAL CORPORATION CERTIFICATE NUMBER 418 STATE OF NORTH CAROLINA GREENVILLE

160 3690

RECEIVED
FEB 23 1977
DIVISION OF SCHOOL PLANNING

MOREHEAD CENTRAL SCHOOL
CARTERET COUNTY BOARD OF EDUCATION, OWNER
R.B. PARKER CHAIRMAN N. GILLIKEN VICE CHAIRMAN M. HOLCOMB D. FRESHWATER B. SALTER T.L. LEE SUPERINTENDANT

james b willis jr / architect
401 S 13TH STREET NUMBER ONE BOGUE SOUND PO BOX 808
MOREHEAD CITY NORTH CAROLINA 28557 919-726-7091

fenner and proffitt
125 WEST BARNES ST.
WILSON, NC 27893

bell design group
RALEIGH-DURHAM HWY.
RALEIGH, NC 27612

DRAWN BY CT CHECKED BY JW DATE 12/2/76 PROJECT DESIGNER

SET NO. 8 JOB 75-2

N2476

DRAWING SYMBOLS

MATERIALS

- EARTH
- CRUSHED STONE
- CONCRETE
- CONCRETE BLOCK
- BRICK
- STEEL
- WOOD - FRAMING
- WOOD - BLOCKING
- WOOD - FINISH
- PLYWOOD
- INSULATION - BATT
- INSULATION - RIGID
- GYPSUM BOARD
- PLASTER
- GLASS

CONVENTIONS

- 37'-5" — EXISTING PLAN ELEVATION
- 37'-5" — NEW PLAN ELEVATION
- 37'-5" — SECTION ELEVATION
- 18 — EXISTING CONTOUR
- 18 — NEW CONTOUR
- 2/6 — DETAIL NO. / SHEET NO. — DETAIL OR SECTION CUT
- 4 — DOOR NUMBER
- 4 — WINDOW TYPE
- 13 — WALL TYPE
- 29 — SPACE NUMBER
- Z/4 — ELEV. SHEET — INTERIOR ELEVATION
- BOUNDARY LINE
- CENTERLINE
- HIDDEN LINE OR OVERHANG
- FOLD LINE ON INTERIOR ELEVATIONS
- B — FOOTING TYPE
- 12 RUN / 4 RISE — PITCH

FINISHES

INTERIOR FINISHES ARE SHOWN ON INTERIOR ELEVATIONS OF EACH SPACE, WHICH APPEAR IN CONSECUTIVE NUMERICAL SEQUENCE THROUGH OUT THE DRAWINGS. EXCEPT AS NOTED OTHERWISE ON THE INTERIOR ELEVATIONS

INTERIOR FINISHES ARE GENERALLY AS FOLLOWS:

FLOORS – RESILIENT TILE (R.T.) IN CLASSROOMS, STORAGE AND WORK ROOMS
CERAMIC TILE IN TOILETS AND LOCKER ROOMS
CARPET IN ADMINISTRATIVE OFFICES, HOME ARTS, MUSIC ROOMS AND MEDIA CENTER
COMPOSITION WOOD IN GYM
CONCRETE (SURFACE HARDENED) IN MECHANICAL SPACES, BOILER ROOM AND SHOP
TERRAZZO IN CORRIDORS

BASE – GLAZED CONCRETE BLOCK TYP.


WALLS – CONCRETE BLOCK, SCORED TO 8x8 FACE TYP.
PAINT AS PER COLOR (PCN) SHOWN ON INTERIOR ELEVATIONS AND DESCRIBED IN PAINT SCHEDULE

CEILINGS – LAY-IN ACOUSTIC TILE TYP. EXCEPT FOR GYM AND COMMONS
CEMENT PLASTER AT PERIMETER CLASSROOMS
EXPOSED ROOF DECK AT GYM AND COMMONS

DOORS – FACTORY FINISHED SOLID CORE TYP. AT INTERIOR EXCEPT FOR FIRE DOORS
ANODIZED ALUMINUM EXTERIOR DOORS AND FRAMES

WINDOWS – ANODIZED ALUMINUM FRAMES

CASEWORK: FLOOR PLANS AND INTERIOR ELEVATIONS DESCRIBE THE EXTENT OF CABINET WORK AND SHELVING. A TWO LINE NOTATION BENEATH CABINET ELEVATION DENOTES THE WIDTH (IN INCHES) AND THE MODEL NO. (HAUSERMAN EDUCATORS AND WILSON ART INTER ROYAL) IS SHOWN BELOW OR ABOVE EACH CABINET, STORAGE. WALL COMPONENTS SHOWN ON SHT. 5 SHALL HAVE SAME PLASTIC LAM. AS THAT USED BY SELECTED CASEWORK SUBCONTR. FINISH HDWE. FOR COMPONENTS TO BE FURNISHED BY SAME.

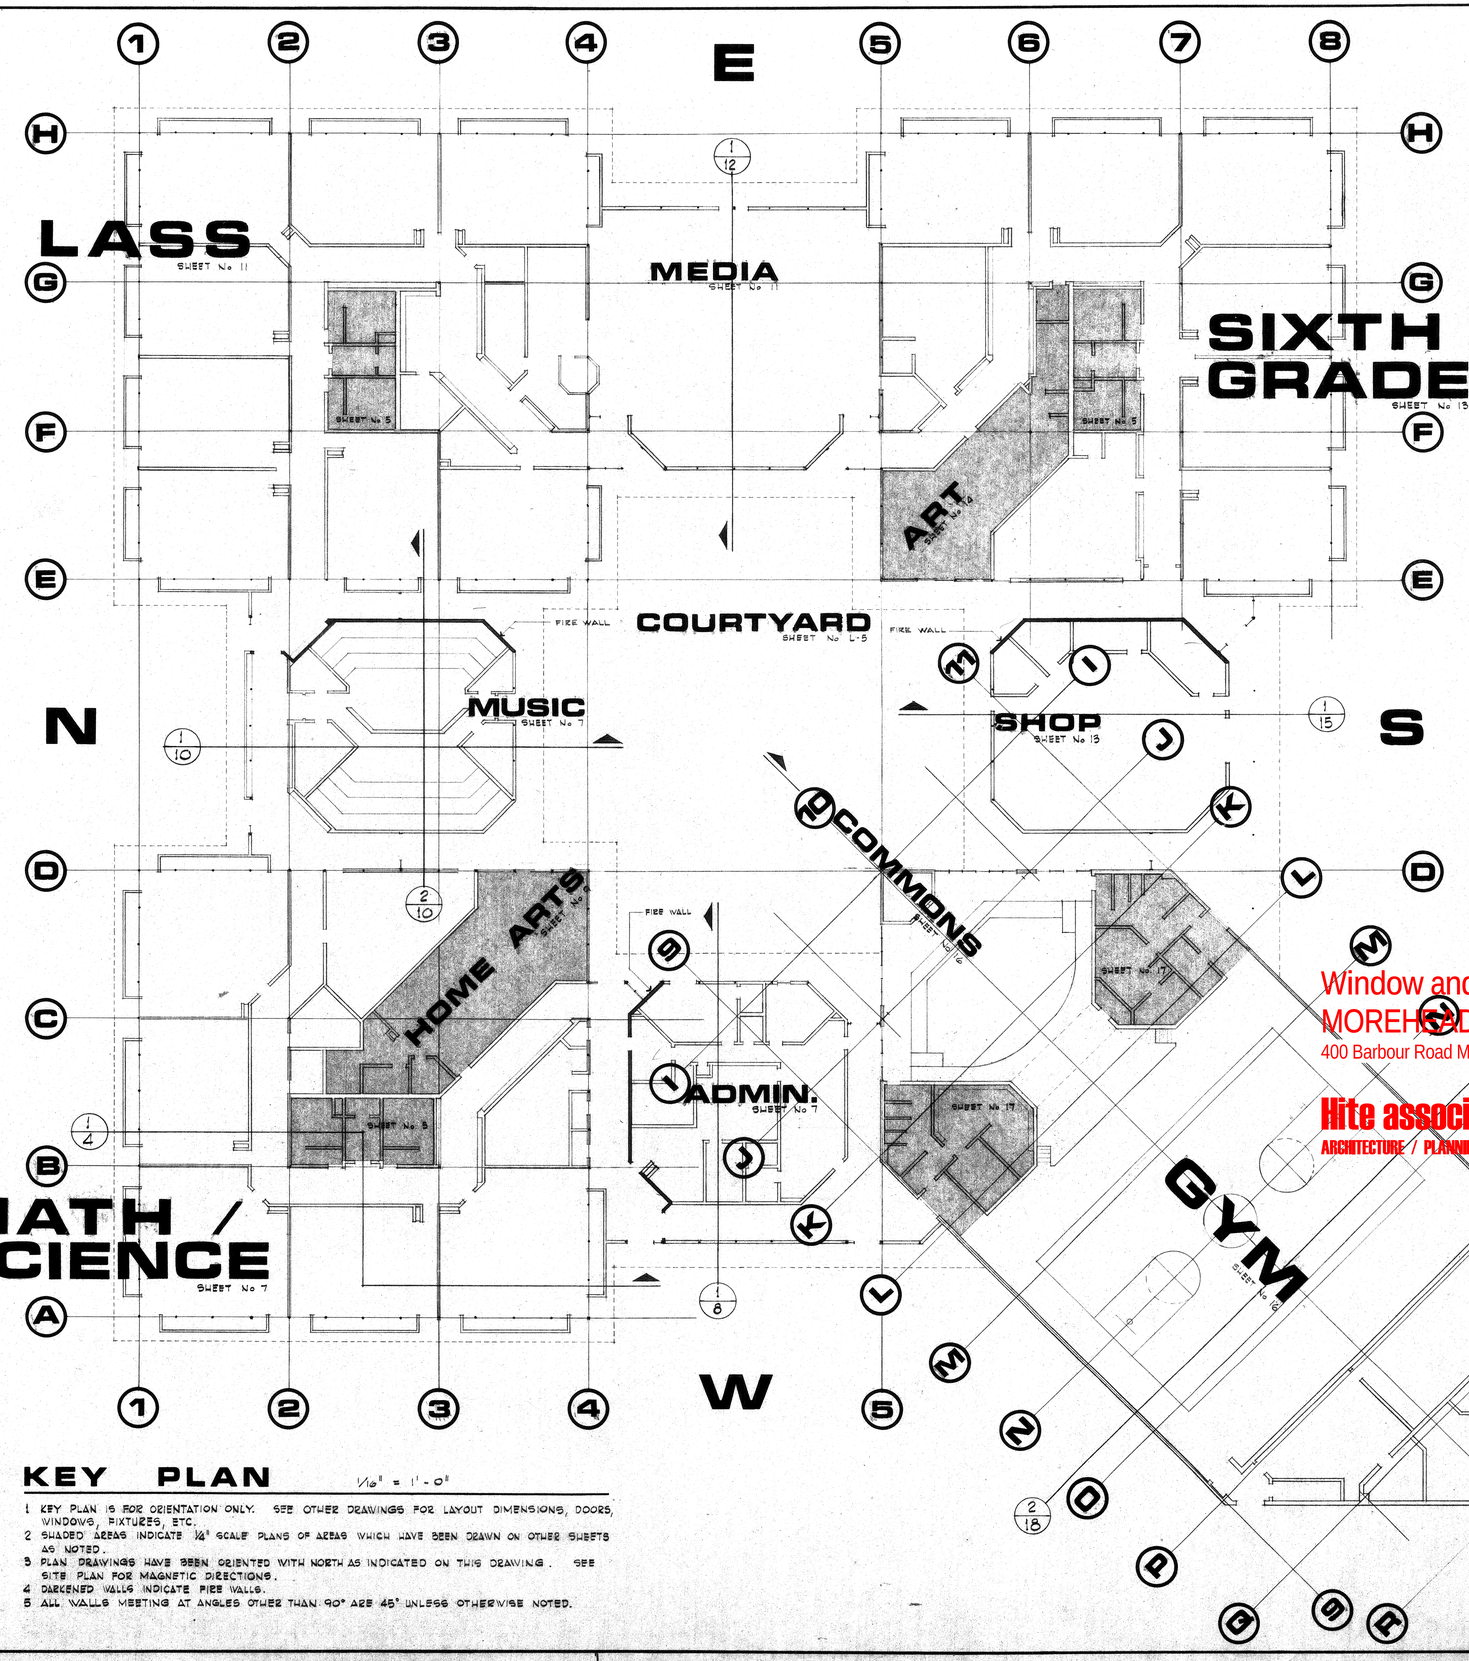

KEY PLAN

1/16" = 1'-0"

1 KEY PLAN IS FOR ORIENTATION ONLY. SEE OTHER DRAWINGS FOR LAYOUT DIMENSIONS, DOORS, WINDOWS, FIXTURES, ETC.
2 SHADED AREAS INDICATE ¼" SCALE PLANS OF AREAS WHICH HAVE BEEN DRAWN ON OTHER SHEETS AS NOTED.
3 PLAN DRAWINGS HAVE BEEN ORIENTED WITH NORTH AS INDICATED ON THIS DRAWING. SEE SITE PLAN FOR MAGNETIC DIRECTIONS.
4 DARKENED WALLS INDICATE FIRE WALLS.
5 ALL WALLS MEETING AT ANGLES OTHER THAN 90° ARE 45° UNLESS OTHERWISE NOTED.

COLOR

PAINT SCHEDULE

PCN	COLOR NO.	TYPE	MFR
1	DB-7	ENAMEL	S.W.
2	AC-58	ENAMEL	S.W.
3	16-610	EPOXY SEMI-FLAT	PITTSBURGH PAINTS
4	O-BR-11	FLAT LATEX	S.W.
5	T-27	EPOXY SEMI-FLAT	S.W.
6	AC-59	DO	S.W.
7	TW-1726	DO	S.W.
8	G-DB-15	DO	S.W.
9	Y-BR-14	DO	S.W.
10	AC-69	DO	S.W.
11	AC-32	FLAT LATEX	S.W.
12	AC-31	FLAT LATEX	S.W.
13	AC-30	EPOXY SEMI-FLAT	S.W.
14	AC-80	GLOSS ENAMEL HI GLOSS ENAMEL	S.W.
15	AC-10	DO	S.W.
16	AC-34	DO	S.W.

BASE SCHEDULE

№	COLOR	TYPE	MFR
TYP	SPECIAL BLACK	GLAZED BLK.	SPECTRA GLAZE
V.B	BLACK	VINYL BASE	

GLAZED WALL SCHEDULE

№	COLOR	TYPE	MFR
1	DEEP KINGSTON BLUE	GLAZED BLK.	SPECTRA GLAZE
2	DEEP LEAF GREEN	DO	DO
3	DEEP CAPRI YELLOW	DO	DO

FLOOR SCHEDULE

№	COLOR	TYPE	MFR
1	S104	TERRAZZO	
2	BONE № 121	CERAMIC TILE	AMERICAN OLEAN
3	GOLDEN ROD 123	DO.	DO.
4	SEAL № 124	DO.	DO.
5			
6	№ 56721	VINYL ASBESTOS TILE	ARMSTRONG
7	№ 56771	DO	DO.
8	№ 51134	DO	DO.
9	HOPTON WOOD BLACK, MAHOGANY, ICE BLUE SAME LINE / CIRCLE	COMPOSITION WOOD	GRANWOOD
10	№ P28	CERAMIC TILE	AMERICAN OLEAN
11	CLEAR	SEALER	

Window and Storefront Replacement for
MOREHEAD MIDDLE SCHOOL
400 Barbour Road Morehead City, NC 28557

Hite associates
ARCHITECTURE / PLANNING / TECHNOLOGY

HITE ASSOCIATES, P.C. REGISTERED ARCHITECTURAL CORPORATION CERTIFICATE NUMBER 418 STATE OF NORTH CAROLINA GREENVILLE

160 3690
RECEIVED
FEB 23 1977
DIVISION OF SCHOOL PLANNING


james b willis jr / architect
401 S 13TH STREET NUMBER ONE BOGUE SOUND PO BOX 808
MOREHEAD CITY NORTH CAROLINA 28557 919-726-7091

DRAWN BY JR. CT CHECKED BY JW DATE 12/21/76 PROJECT DESIGNER

KEY PLAN 1/16"

JOB 75-2

SHEET NO. 1 OF 23

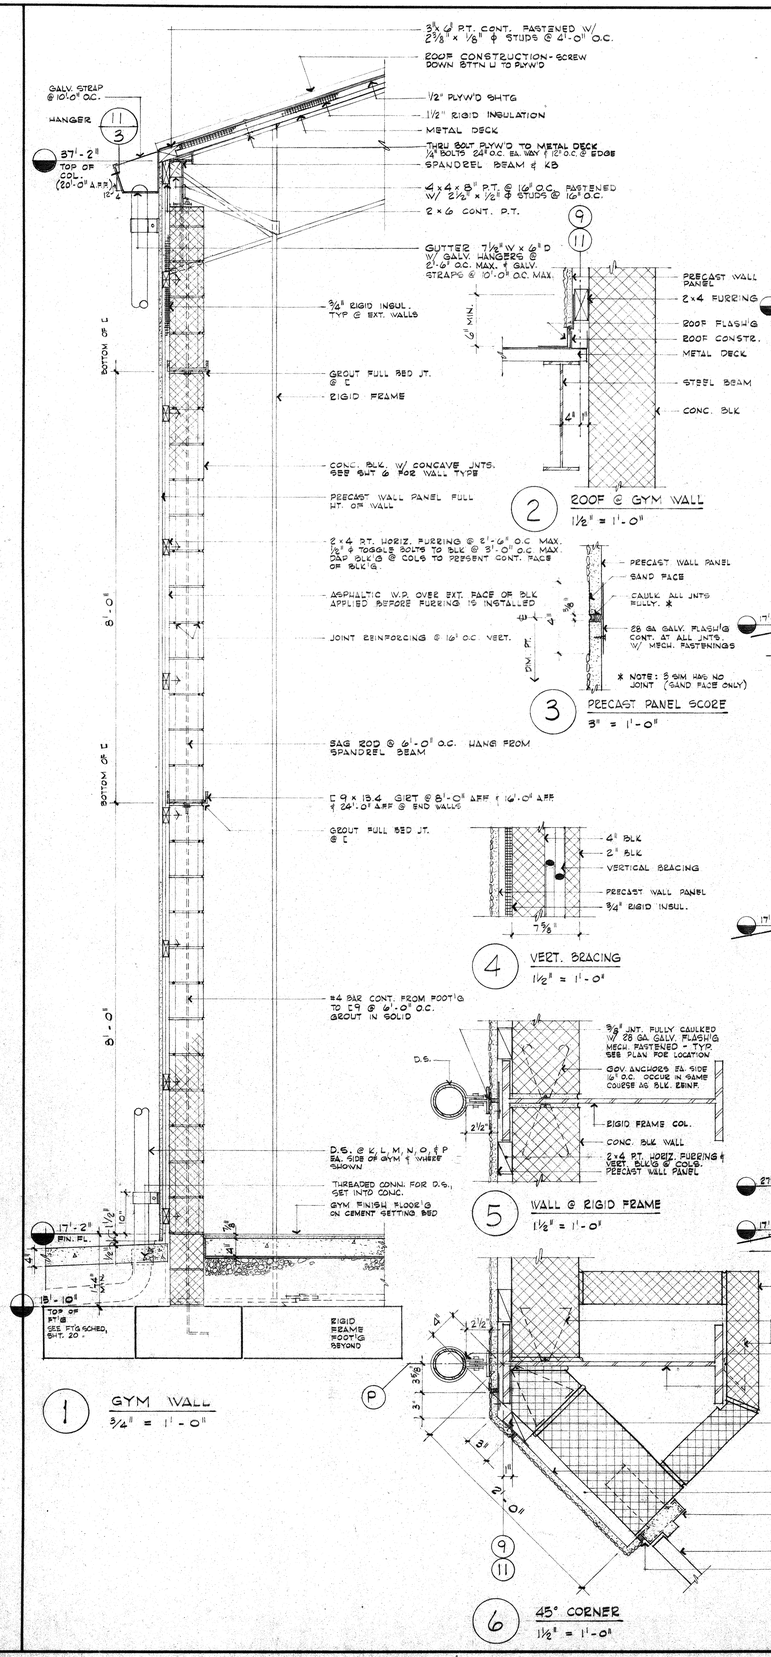

Window and Storefront Replacement for
MOREHEAD MIDDLE SCHOOL
400 Barbour Road Morehead City, NC 28557

Hite associates
ARCHITECTURE / PLANNING / TECHNOLOGY

HITE ASSOCIATES, P.C. REGISTERED ARCHITECTURAL CORPORATION CERTIFICATE NUMBER 418 STATE OF NORTH CAROLINA GREENVILLE

160 3690
RECEIVED
FEB 28 1977
DIVISION OF SCHOOL PLANNING

james b willis jr / architect
401 S 13TH STREET NUMBER ONE BOGUE SOUND PO BOX 808
MOREHEAD CITY NORTH CAROLINA 28557 919-726-7091


DRAWN BY C.T. CHECKED BY J.W. DATE 12/2/76 PROJECT DESIGNER

EXTERIOR ELEVATIONS & DETAILS

1/16" & 1/2" 3/4" & 1 1/2"

JOB 75-2

SHEET NO. 2 OF 23

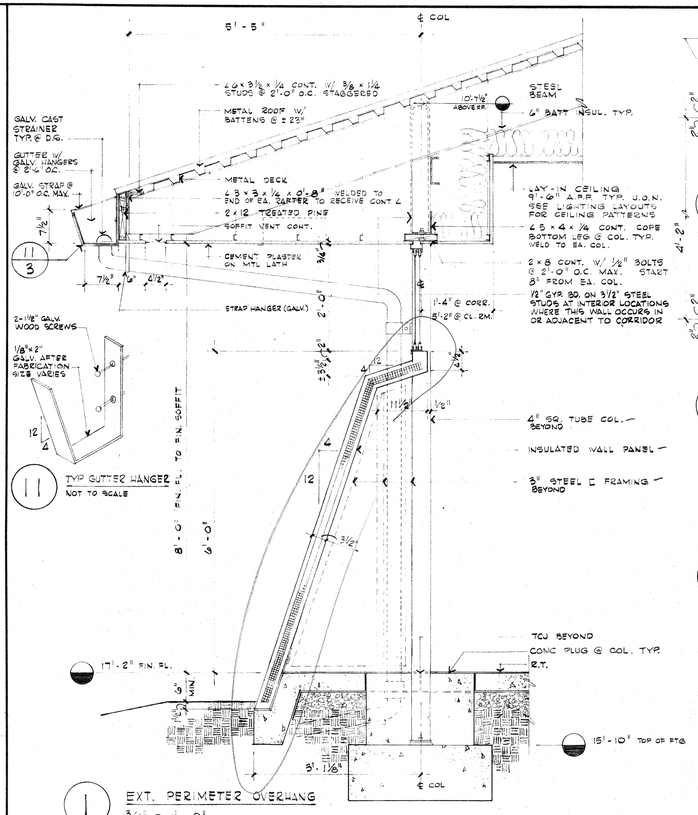

james b willis jr / architect
401 S 13TH STREET NUMBER ONE BOGUE SOUND PO BOX 808
MOREHEAD CITY NORTH CAROLINA 28557 919-726-7091


DRAWN BY CT CHECKED BY JW DATE 12/21/76 PROJECT DESIGNER

COURTYARD ELEVATIONS & DETAILS

SCALE AS NOTED


JOB 75-2

SHEET NO. 3 OF 23

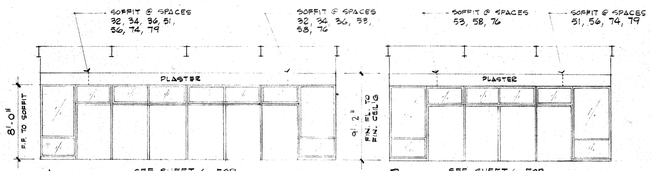


A

B

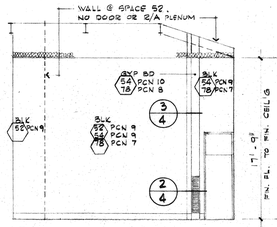


C

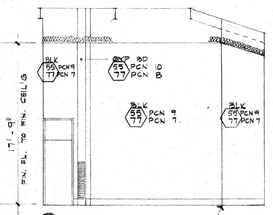


D

D SIM - OP. HAND @ SPACE 55

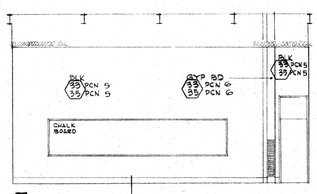


E

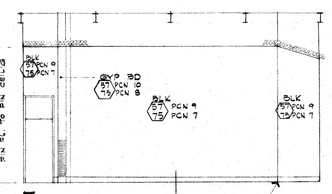


F


F SIM - OP. HAND @ SPACE 75

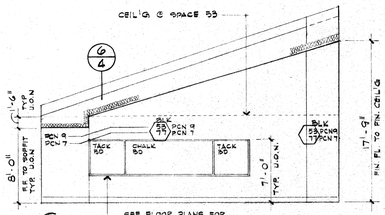


G

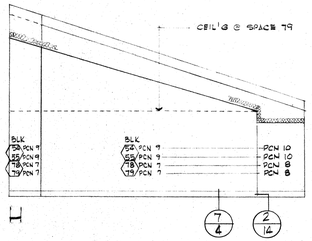


H

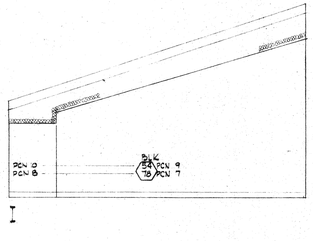


I

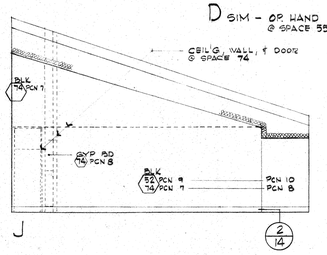


J

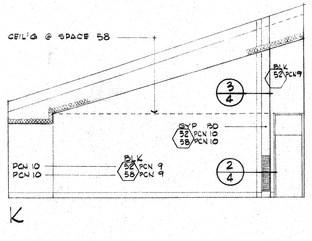


K

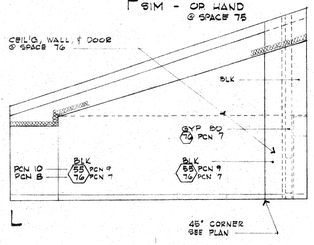


L

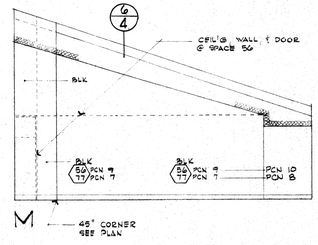


M

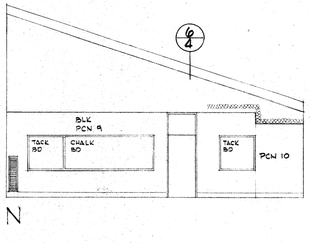


N

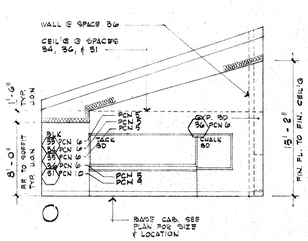


O

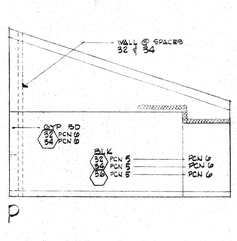


P

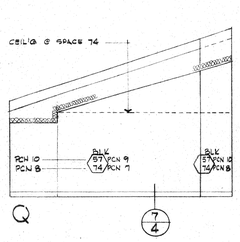


Q

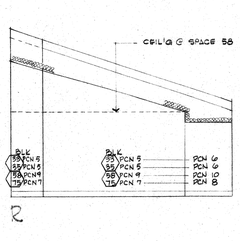


R

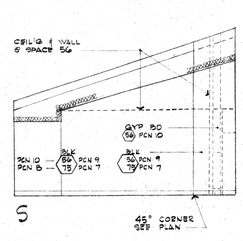

S

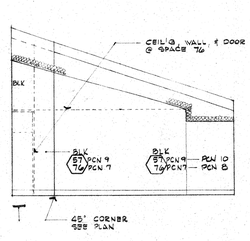


T

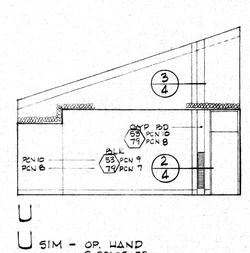

U

U SIM - OP. HAND @ SPACE 55

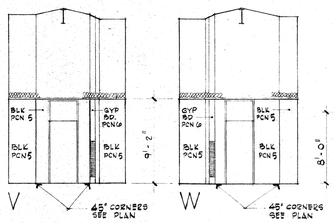


V

45° CORNERS SEE PLAN


W

45° CORNERS SEE PLAN

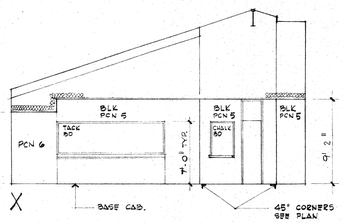


X


45° CORNERS SEE PLAN

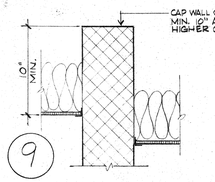



9

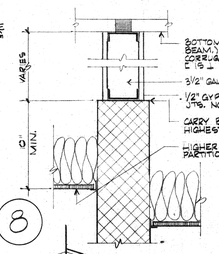

8

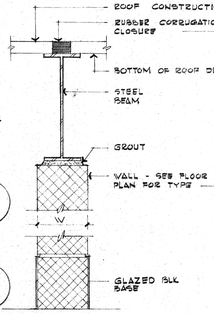


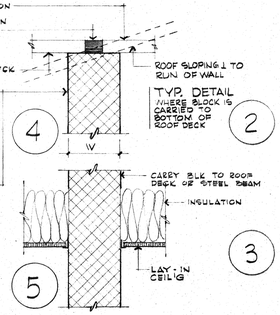

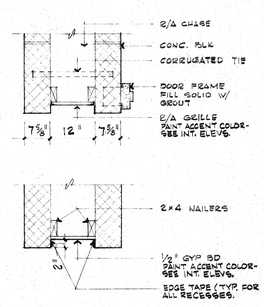

NOTES

1. SEE FLOOR PLANS FOR LOCATION AND SIZE OF ALL CHALK BOARDS, TACK BOARDS, TEACHERS' CABINETS, AND BASE CABINETS.
2. TOP OF ALL CHALK AND TACK BOARDS 7'-0" A.F.F. U.O.N.
3. SEE DOOR SCHEDULE FOR PCN OF DOORS.

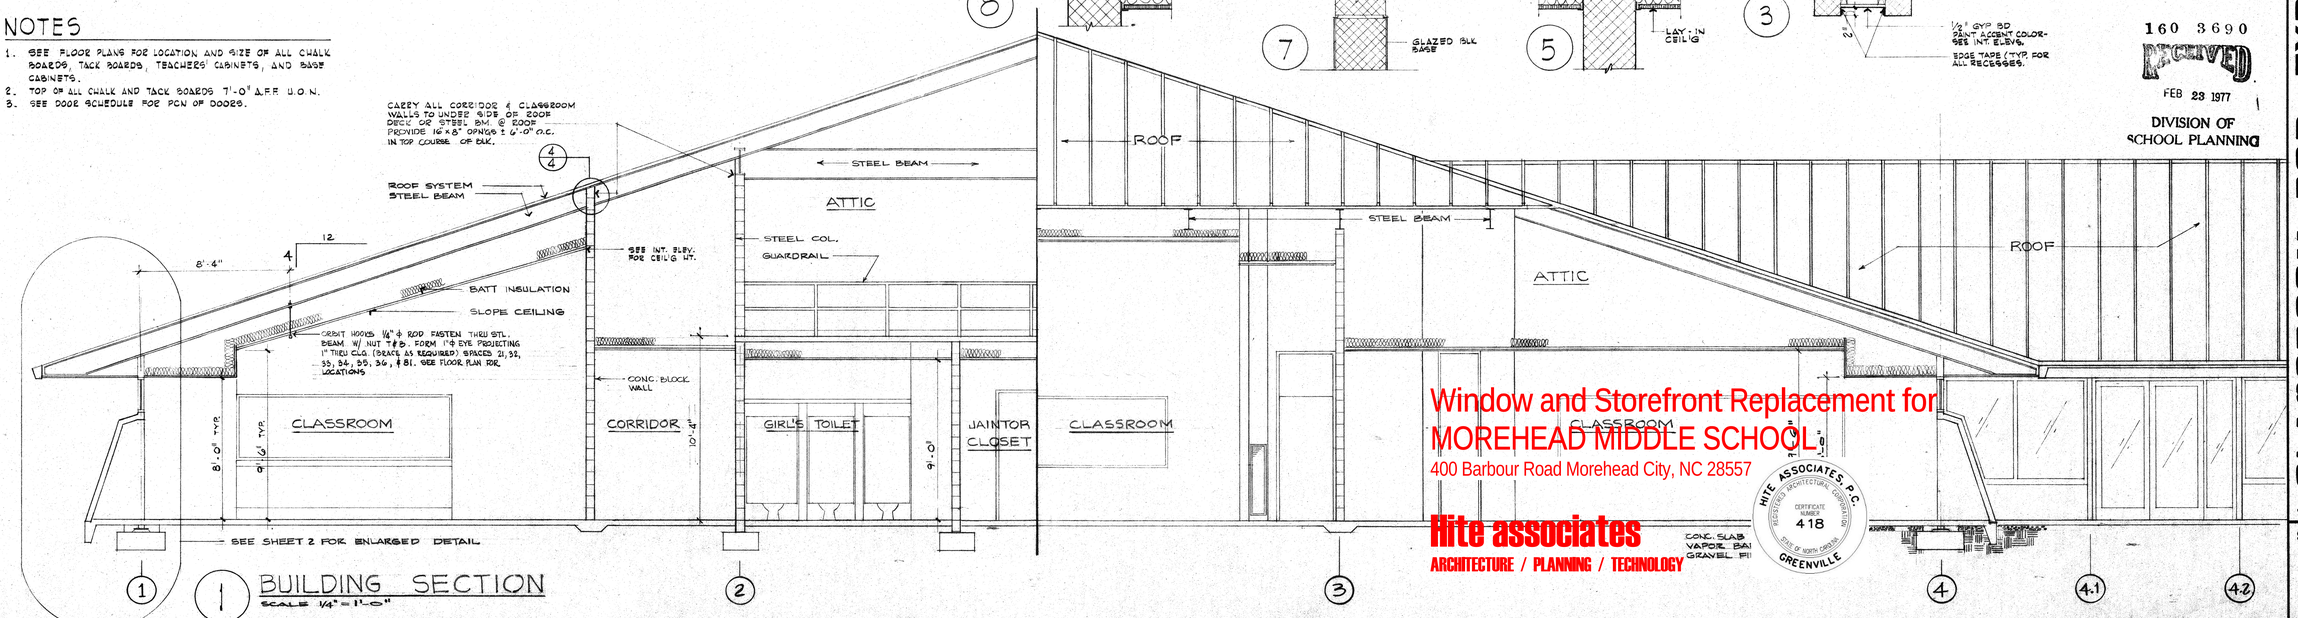

1 BUILDING SECTION
SCALE 1/4" = 1'-0"

160 3690
RECEIVED
FEB 23 1977
DIVISION OF SCHOOL PLANNING

Window and Storefront Replacement for
MOREHEAD MIDDLE SCHOOL
400 Barbour Road Morehead City, NC 28557

Hite associates
ARCHITECTURE / PLANNING / TECHNOLOGY

HITE ASSOCIATES, P.C. REGISTERED ARCHITECTURAL CORPORATION CERTIFICATE NUMBER 418 STATE OF NORTH CAROLINA GREENVILLE

CONC. SLAB
VAPOR BAR
GRAVEL FI

james b willis jr / architect
401 S 13TH STREET NUMBER ONE BOGUE SOUND PO BOX 808
MOREHEAD CITY NORTH CAROLINA 28557 919-726-7091


DRAWN BY CT CHECKED BY JJW DATE 12/21/76 PROJECT DESIGNER

CLASSROOM POD - TYP.
SECTION 1/4"
INTERIOR ELEV./FINISHES 1/4"
DETAILS 3/4"

JOB 75-2

SHEET NO. 4 OF 23


N2474

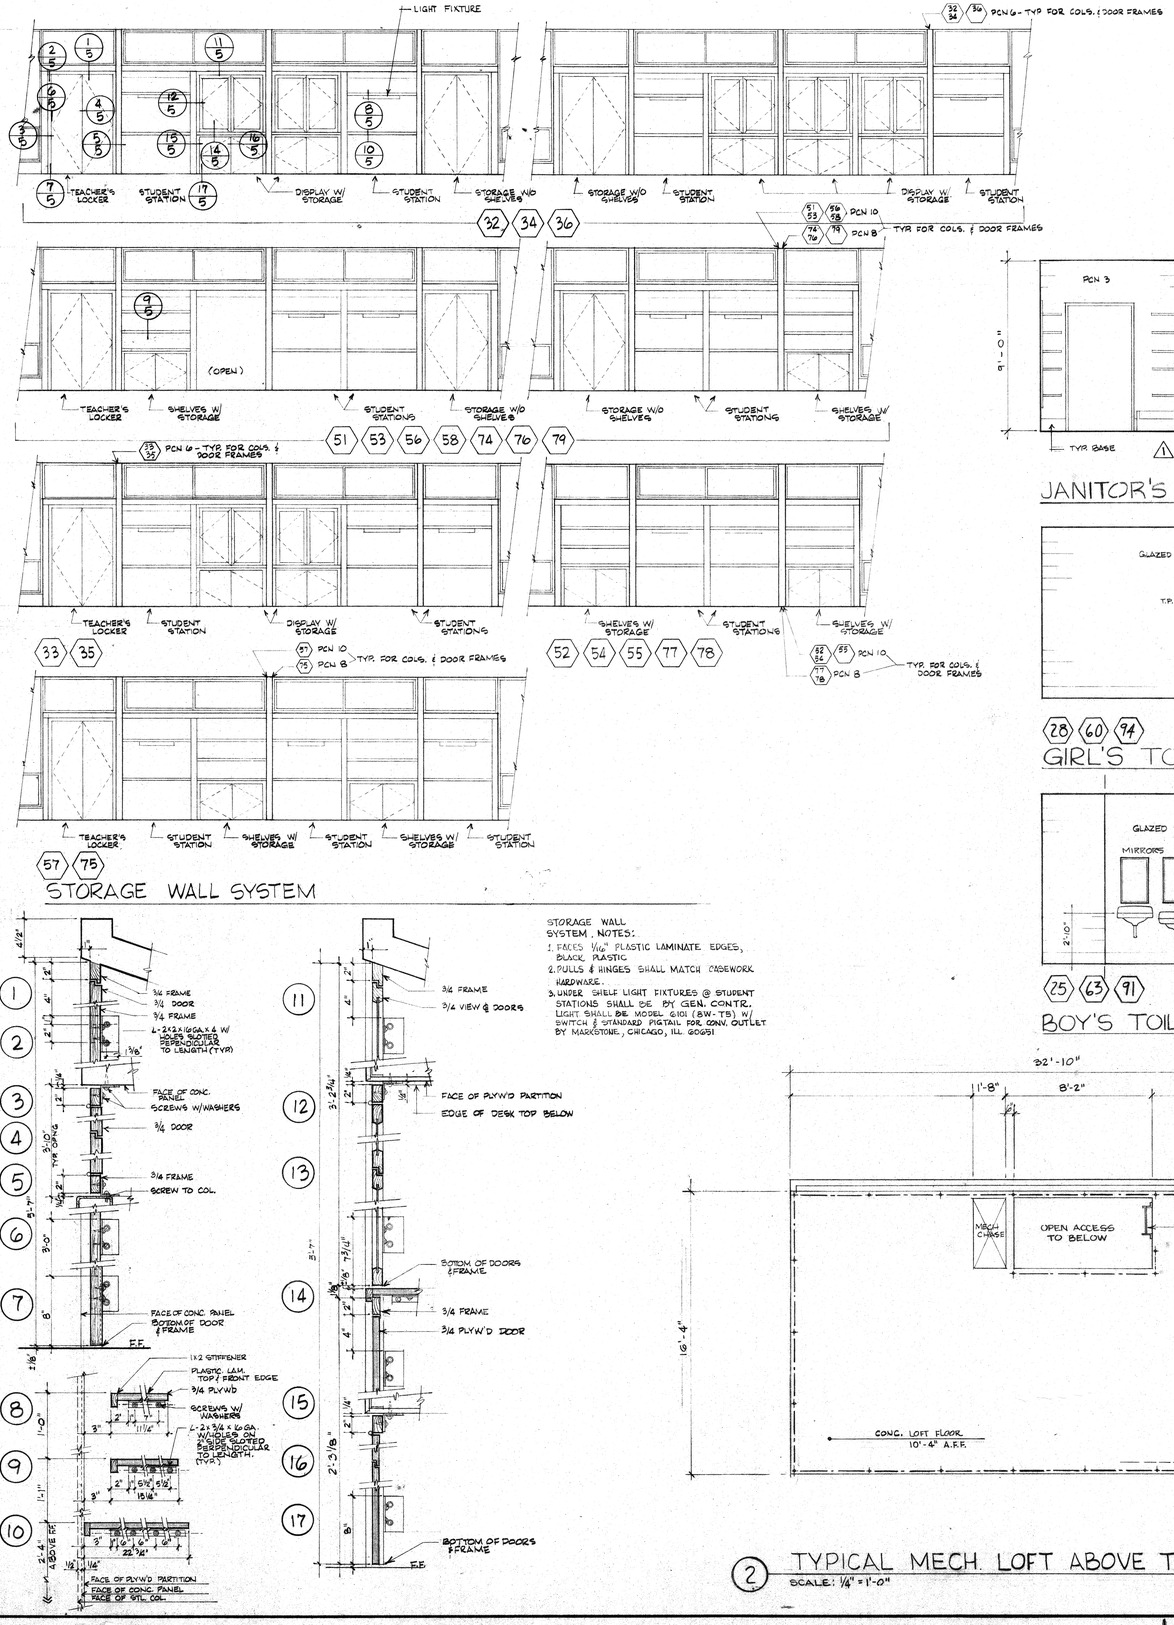

57 75


STORAGE WALL SYSTEM

STORAGE WALL SYSTEM, NOTES:
1. FACES 1/16" PLASTIC LAMINATE EDGES, BLACK PLASTIC
2. PULLS & HINGES SHALL MATCH CASEWORK HARDWARE.
3. UNDER SHELF LIGHT FIXTURES @ STUDENT STATIONS SHALL BE BY GEN. CONTR. LIGHT SHALL BE MODEL 6101 (8W-TS) W/ SWITCH & STANDARD PIGTAIL FOR CONN. OUTLET BY MARKSTONE, CHICAGO, ILL. 60651

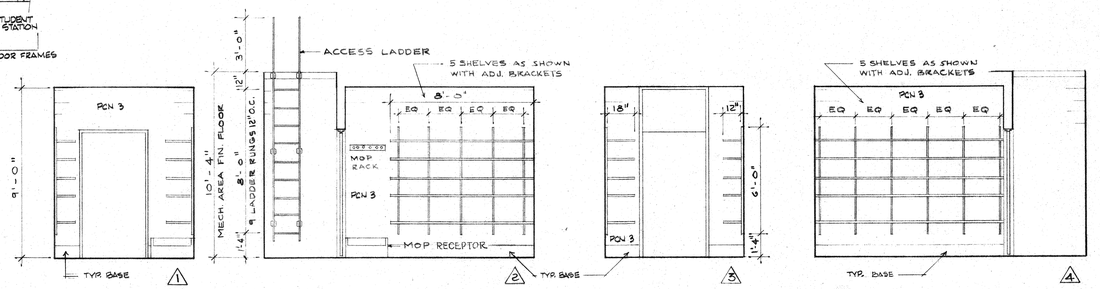

JANITOR'S


FLOOR: C.T. F.F.3
CEILG: GBM. PLASTER - PCN 6

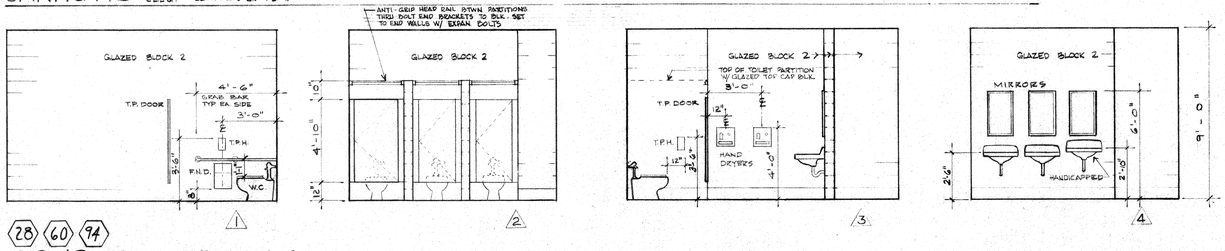

28 60 94

GIRL'S TOILET

FLOOR: C.T. 3
CEILG: GBM. PLASTER - PCN 6

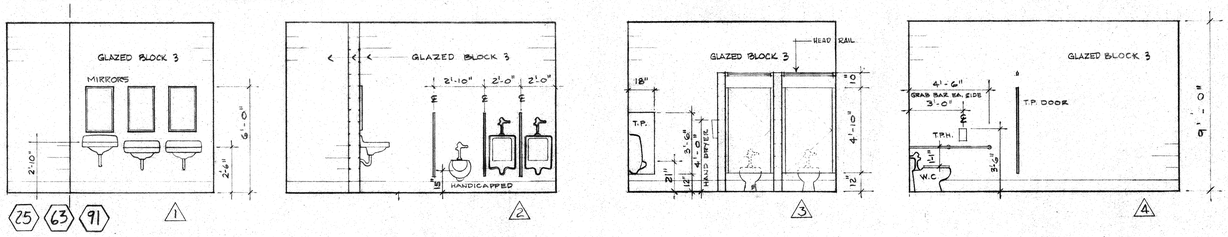


25 63 91

BOY'S TOILET

FLOOR: C.T. 3
CEILG: GBM. PLASTER - PCN 6

2 TYPICAL MECH. LOFT ABOVE TOILETS
SCALE: 1/4" = 1'-0"

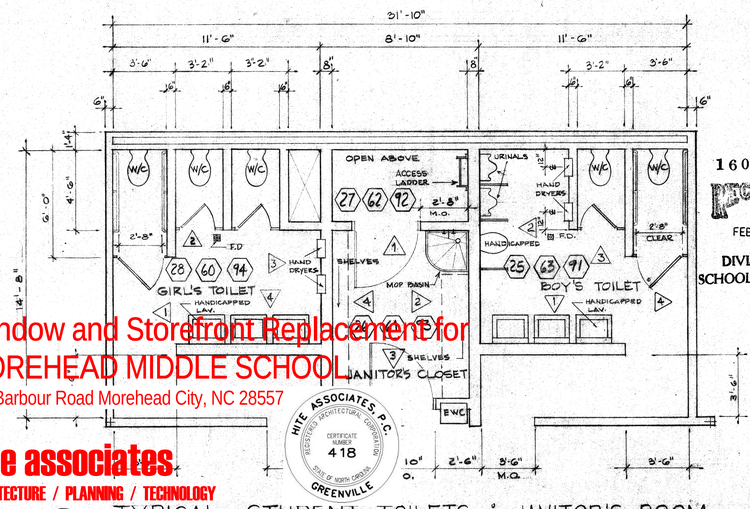

1 TYPICAL STUDENT TOILETS & JANITOR'S ROOM
SCALE: 1/4" = 1'-0"

160 3690
RECEIVED
FEB 23 1977
DIVISION OF SCHOOL PLANNING

Window and Storefront Replacement for
MOREHEAD MIDDLE SCHOOL
400 Barbour Road Morehead City, NC 28557
Hite associates
ARCHITECTURE / PLANNING / TECHNOLOGY

HITE ASSOCIATES, P.A. REGISTERED ARCHITECTURAL CORPORATION CERTIFICATE NUMBER 418 STATE OF NORTH CAROLINA GREENVILLE

james b willis jr / architect
401 S 13TH STREET NUMBER ONE BOGUE SOUND PO BOX 808
MOREHEAD CITY NORTH CAROLINA 28557 919-726-7091

DRAWN BY B.F. JR CHECKED BY J.W. DATE 12/2/76 PROJECT DESIGNER

CLASSROOM POD T'LTS. - TYP. PLAN & ELEVATIONS 1/4" DETAILS 1/2"

JOB 75-2

SHEET NO. 5 OF 23

NOTE: UNLESS OTHERWISE NOTED, MATCH MULLION PATTERN WITH ALL NEW WORK

BLOCKING AS REQUIRED

SIM TO DETAIL 1

SIMILAR TO DETAIL 1

NEW GLASS AND FRAMING - TYP

PROVIDE EXTRUSION 1/4" PROUD OF FRAMING - TYP

.040" SILL FLASHING - TYP

NEW GLASS AND FRAMING - TYP

PROVIDE EXTRUSION 1/4" PROUD OF FRAMING - TYP

.040" SILL FLASHING - TYP

NEW GLASS AND FRAMING - TYP

.040" SILL FLASHING - TYP

.040" OUTSIDE COLUMN COVER - TYP

SIMILAR TO DETAIL 1

SIMILAR TO DETAIL 1

SIMILAR TO DETAIL 1

SIMILAR TO DETAIL 1

SIMILAR TO DETAIL 1

PROVIDE EXTRUSION 1/4" PROUD OF FRAMING - TYP

PROVIDE NARROW EXTRUSION TO MAINTAIN DOOR WIDTH

NEW GLASS AND FRAMING - TYP

NEW GLASS AND FRAMING - TYP

NEW SPECIALITE DOOR - SEE A-101 DETAIL

PROVIDE SIMILAR PROFILE WITH NEW FRAMING SYSTEM

PROVIDE EXTRUSION 1/4" PROUD OF FRAMING - TYP

THESE PAIRS SLIDING DOORS (3) CHANGED TO SWING DOOR WITH SIDELIGHTS AND TRANSOM SEE PLANS AND A-101

PROVIDE NARROW EXTRESION TO MAINTAIN DOOR WIDTH

ADD MULLION AT BROKEN ANGLE GLASS - TYPICAL

ADD MULLION AT BROKEN ANGLE GLASS - TYPICAL

WALL TYPES

NOT TO SCALE
SEE FLOOR PLANS FOR LOCATIONS

1 PRECAST INSULATED WALL PANEL - SLOPE AS DETAILED

2 DIM. PT. ON PLANS; ¾" PRECAST PANEL; 3" RIGID INSULATION; 8" C.M.U.; 2×4 WOOD FURRING PT.

2F 8" C.M.U. 75% SOLID

3 DIM. PT. ON PLANS; 4" C.M.U.; ¾" PRECAST PANEL; ¾" RIGID INSULATION; 2×4 WOOD FURRING PT. 1×4 @ 3 SIM. REINF. @ EA. COURSE

4 4" C.M.U.

5 6" C.M.U.; GLAZED C.M.U. IN TOILETS; PLUMBING CHASE

6 6" C.M.U.

7 12" C.M.U.

7S FILL CORES WITH SAND

8 8" C.M.U.

8F 8" C.M.U. 75% SOLID

9 DIM. PT. ON PLANS; 12" C.M.U.; ¾" PRECAST PANEL; ¾" RIGID INSULATION; 2×4 WOOD FURRING PT.

9S FILL CORES WITH SAND

9F 12" C.M.U. 75% SOLID FILL CORES WITH SAND

10 DIM. PT. ON PLANS; 6" C.M.U.; ¾" PRECAST PANEL; ¾" RIGID INSULATION; 2×4 WOOD FURRING PT.

11 DIM. PT. ON PLANS; 6" GLAZED C.M.U.; 8" C.M.U.; ¾" RIGID INSULATION; ¾" PRECAST PANEL; 2×4 WOOD FURRING PT.; PLUMBING CHASE

WINDOWS

NOT TO SCALE
SEE SCHEDULED ASSEMBLIES FOR LOCATIONS
SEE ELEVATIONS FOR LOCATIONS

1 4'-0" × 7'-4" SINGLE-HUNG ½" INSUL. ⊄ VIFE ⊄ WHERE NOTED

2 4'-0" × 6'-0" FIXED

3 8'-0" × 2'-0" SLIDER
SINGLE GLAZED - TINTED TYP.
WIRE GLASS WHERE NOTED ON ELEV.

4 8'-0" × 4'-8" SLIDER ½" INSUL. ⊄

4A FIXED HALF OF 4 ONLY ½" INSUL. ⊄

5 8'-0" × 8'-0" SLIDING DOOR ⅝" INSUL. ⊄ - TEMPERED

5A 6'-0" × 8'-0" SLIDING DOOR ⅝" INSUL. ⊄ - TEMPERED

6 8'-0" × 6'-8" SLIDER ⅝" INSUL. ⊄ - TEMPERED

6A ±8'-0" × 6'-8", VERIFY IN FIELD SLIDER ⅝" INSUL. ⊄ - TEMPERED

7 8'-0" × 4'-8" SLIDER ½" INSUL. ⊄

7A 8'-0" × 6'-8" SLIDER ⅝" INSUL. ⊄ - TEMPERED

8 4'-8" × 4'-8" SLIDER ½" INSUL. ⊄

9 2'-6" × 4'-8" SINGLE-HUNG ½" INSUL. MIRROR ⊄

10 3'-6" × 7'-4" SINGLE-HUNG ½" INSUL. ⊄

11 FIELD DIMENSION FIXED, ALUM TUBE ½" INSUL. ⊄

12 FIELD DIMENSION FIXED, ALUM TUBE ½" INSUL. ⊄

13 SEE ELEV. FOR WIDTH FIXED - H.M.TL. SINGLE GLAZED U.O.N.

13A SEE ELEV. FOR WIDTH FIXED - WOOD SINGLE GLAZED U.O.N.

14 FIELD DIMENSION FIXED, ALUM TUBE ½" INSUL. ⊄

DOORS

NOT TO SCALE
SEE DOOR SCHEDULES FOR LOCATIONS

A FULL ⊄ ALUM

B MTL
H SC WOOD

C SC WOOD

D SC WOOD

E MTL
F SC WOOD

G SC WOOD

I MTL

J SC WOOD

K OVERHEAD DOOR

L SC WOOD

DOOR FRAMES

NOT TO SCALE
SEE DOOR SCHEDULES FOR LOCATIONS

F-1 H. MTL.

F-2 H. MTL.

F-3 H. MTL.

F-4 H. MTL.

F-5 ALUM.

F-6 ALUM. ½" INSUL. ⊄ - TEMPERED

F-7 ALUM. ½" INSUL. ⊄ - TEMPERED

F-8 ALUM.

F-9 ALUM. ½" INSUL. ⊄ - TEMPERED

F-10 ALUM. ½" INSUL. ⊄ - TEMPERED

F-11 ALUM. ½" INSUL. ⊄ - TEMPERED

THRESHOLDS

NOT TO SCALE
SEE DOOR SCHEDULES FOR LOCATIONS

T-1 * CARPET TO STOP AT EDGE OF DOOR AND FRAME STOP

T-2

T-3

T-4

T-5 FLOORINGS TO MEET AT EDGE OF DOOR AND FRAME STOP

T-6

Window and Storefront Replacement for
MOREHEAD MIDDLE SCHOOL
400 Barbour Road Morehead City, NC 28557

Hite associates
ARCHITECTURE / PLANNING / TECHNOLOGY

HITE ASSOCIATES, P.C. REGISTERED ARCHITECTURAL CORPORATION CERTIFICATE NUMBER 418 STATE OF NORTH CAROLINA GREENVILLE

james b willis jr / architect
401 S 13TH STREET NUMBER ONE BOGUE SOUND PO BOX 808
MOREHEAD CITY NORTH CAROLINA 28557 919-726-7091

DRAWN BY CT CHECKED BY JW/JB DATE 12/21/76 PROJECT DESIGNER

DOORS, WINDOWS, WALLS ELEVATIONS 1/4" DETAILS 3"

JOB 75-2

SHEET NO. 6 OF 23


160 3 6
RECEIVED
FEB 23 1977
DIVISION OF ... PLANNING


N24794

DOOR SCHEDULE

DOOR NO.	TYPE	SIZE	FRAME TYPE	T'HOLD TYPE	LABEL	HDWE SET	IDENTIFICATION SEE ELEVATION	FINISH *	REMARKS
1	A	PR 3'-0"x7'-10"	F-7	T-4	—	1	——		SEE ELEV. FOR SIDELIGHT
2	F	PR 3'-0"x7'-10"	F-2	—	A	2	——		A LABEL FRAME
3	A	PR 3'-0"x7'-10"	F-7	T-4	—	1	——		SEE ELEV. FOR SIDELIGHT
4	D	3'-0" x 7'-0"	WD	T-1	—	4	OFFICE		SEE SH.8 FOR DET.
5	C	3'-0"x7'-0"	F-4	T-1	—	7	HEALTH		
6	F	3'-0"x7' 10"	F-2	T-3	—	7	——		
7	C	3'-0" x 7'-0"	F-3	T-1	—	4	WORK ROOM		
8	D	3'-0" x 7'-0"	WD	T-1	—	4	OFFICE		SEE SH.8 FOR DET.
9	A	PR 3'-0" x 7'-10"	F-7	T-4	—	1	——		SIDELIGHT EA. SIDE
10	5A	6'-0" x 8'-0"	ALUM	—	—	11	——		
11	F	2'-8" x 7'-10"	F-2	T-2	—	7	——		
12	L	3'-0" x 7'-10"	F-2	—	—	4	PRINCIPAL		
13	F	2'-8" x 7'-10"	F-2	T-2	—	7	STAFF		
14	L	3'-0" x 7'-10"	F-2	—	—	4	ASSIT. PRINCIPAL		
15	F	2'-6" x 7'-10"	F-2	—	—	5	COATS		
16	E	3'-0" x 7'-2"	F-1	—	A	5	RECORDS	PAINT	
17	L	3'-0" x 7'-10"	F-2	—	—	4	CONFERENCE		
18	L	3'-0" x 7'-10"	F-2	—	—	4	GUIDANCE		
19	D	3'-0" x 7'-0"	F-4	T-1	A	4	GUIDANCE		
20	A	PR 3'-0"x7'-10"	F-7	T-4	—	1	——		F.H SIDELIGHT
21	D	3'-0" x 7'-0"	F-3	T-5	A	4	WORK ROOM		
22	D	2'-6" x 7'-0"	F-4	T-3	—	7	FACULTY MEN		
23	D	2'-6" x 7'-0"	F-4	T-3	—	7	FACULTY WOMEN		
24	D	3'-0" x 7'-0"	F-4	T-5	—	3	STAFF		
24 A	F	PR 3'-0" x 7'-2"	F-1	—	—	9	——		
25	D	3'-0" x 7'-0"	F-3	T-3	—	5	JANITOR		
26	C	3'-0" x 7'-0"	F-4	T-1	—	3	1		
27	C	3'-0" x 7'-0"	F-3	T-1	—	4	OFFICE		
28	D	3'-0" x 7'-0"	F-3	T-1	—	5	DRESSING ROOM		
29	D	3'-0" x 7'-0"	F-3	T-1	—	5	PROJECTS		UNDERCUT 5/8"
30	D	3'-6" x 7'-0"	F-3	T-3	—	5	JANITOR		
31	E	3'-6" x 7'-2"	F-1	—	—	5	——		
32	G	3'-0" x 7'-0"	F-3	T-5	—	3	2		
33	G		F-3	T-5	—	3	3		
34	G		F-3	T-5	—	3	4		
35	G		F-3	T-5	—	3	5		
36	G		F-3	T-5	—	3	6		
37	G		F-3	T-5	—	3	7		
38	D		F-4	T-5	—	5	PROJECT		
39	D		F-4	T-5	—	5	BOOKS		UNDERCUT 3/8"
40	5	8'-0" x 8'-0"	ALUM	—	—	11	——		
41	A	PR 3'-0" x 7'-10"	F-7	T-4	—	1	——		SEE ELEV. FOR SIDELIGHT
42	A	PR 3'-0" x 7'-10"	F-7	T-4	—	1	——		"
43	D	3'-0" x 7'-0"	F-3	—	—	5	8 STRINGS		SOUND STRIPPING
44	H	PR 2'-6" x 7'-10"	F-2	—	—	2	MUSIC		
45	—	—	—	—	O	M	I T T E	D	—
46	F	3'-0" x 7'-2"	F-1	T-1	—	3	9 BAND		SOUND STRIPPING
47	F	3'-0" x 7'-2"	F-1	T-1	—	3	9 BAND		SOUND STRIPPING
48	C	3'-0" x 7'-0"	F-3	T-1	—	3	INST. STORAGE		
49	B	PR 2'-6" x 7'-10"	F-8	T-4	—	1	MUSIC	PAINT	6" x 36" VIEW PANEL
50	D	3'-0" x 7'-0"	F-3	T-5	—	3	MECHANICAL		
51	F	3'-0" x 7'-2"	F-1	T-1	—	3	10 CHORUS		SOUND STRIPPING
52	F	3'-0" x 7'-2"	F-1	T-1	—	3	10 CHORUS		SOUND STRIPPING
53	D	3'-0" x 7'-0"	F-3	T-5	—	5	ELECTRICAL		
54	F	PR 3'-0" x 7'-10"	F-2	—	A	2	——		
55	A	PR 3'-0" x 7'-10"	F-7	T-4	—	1	——		SEE ELEV. FOR SIDELIGHT
56	A	PR 2'-6" x 7'-10"	F-6	T-4	—	1	——		

* ALL DOORS NATURAL FIN. UNLESS OTHERWIRE NOTED

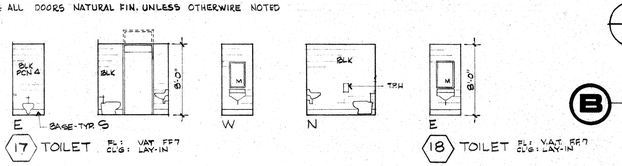

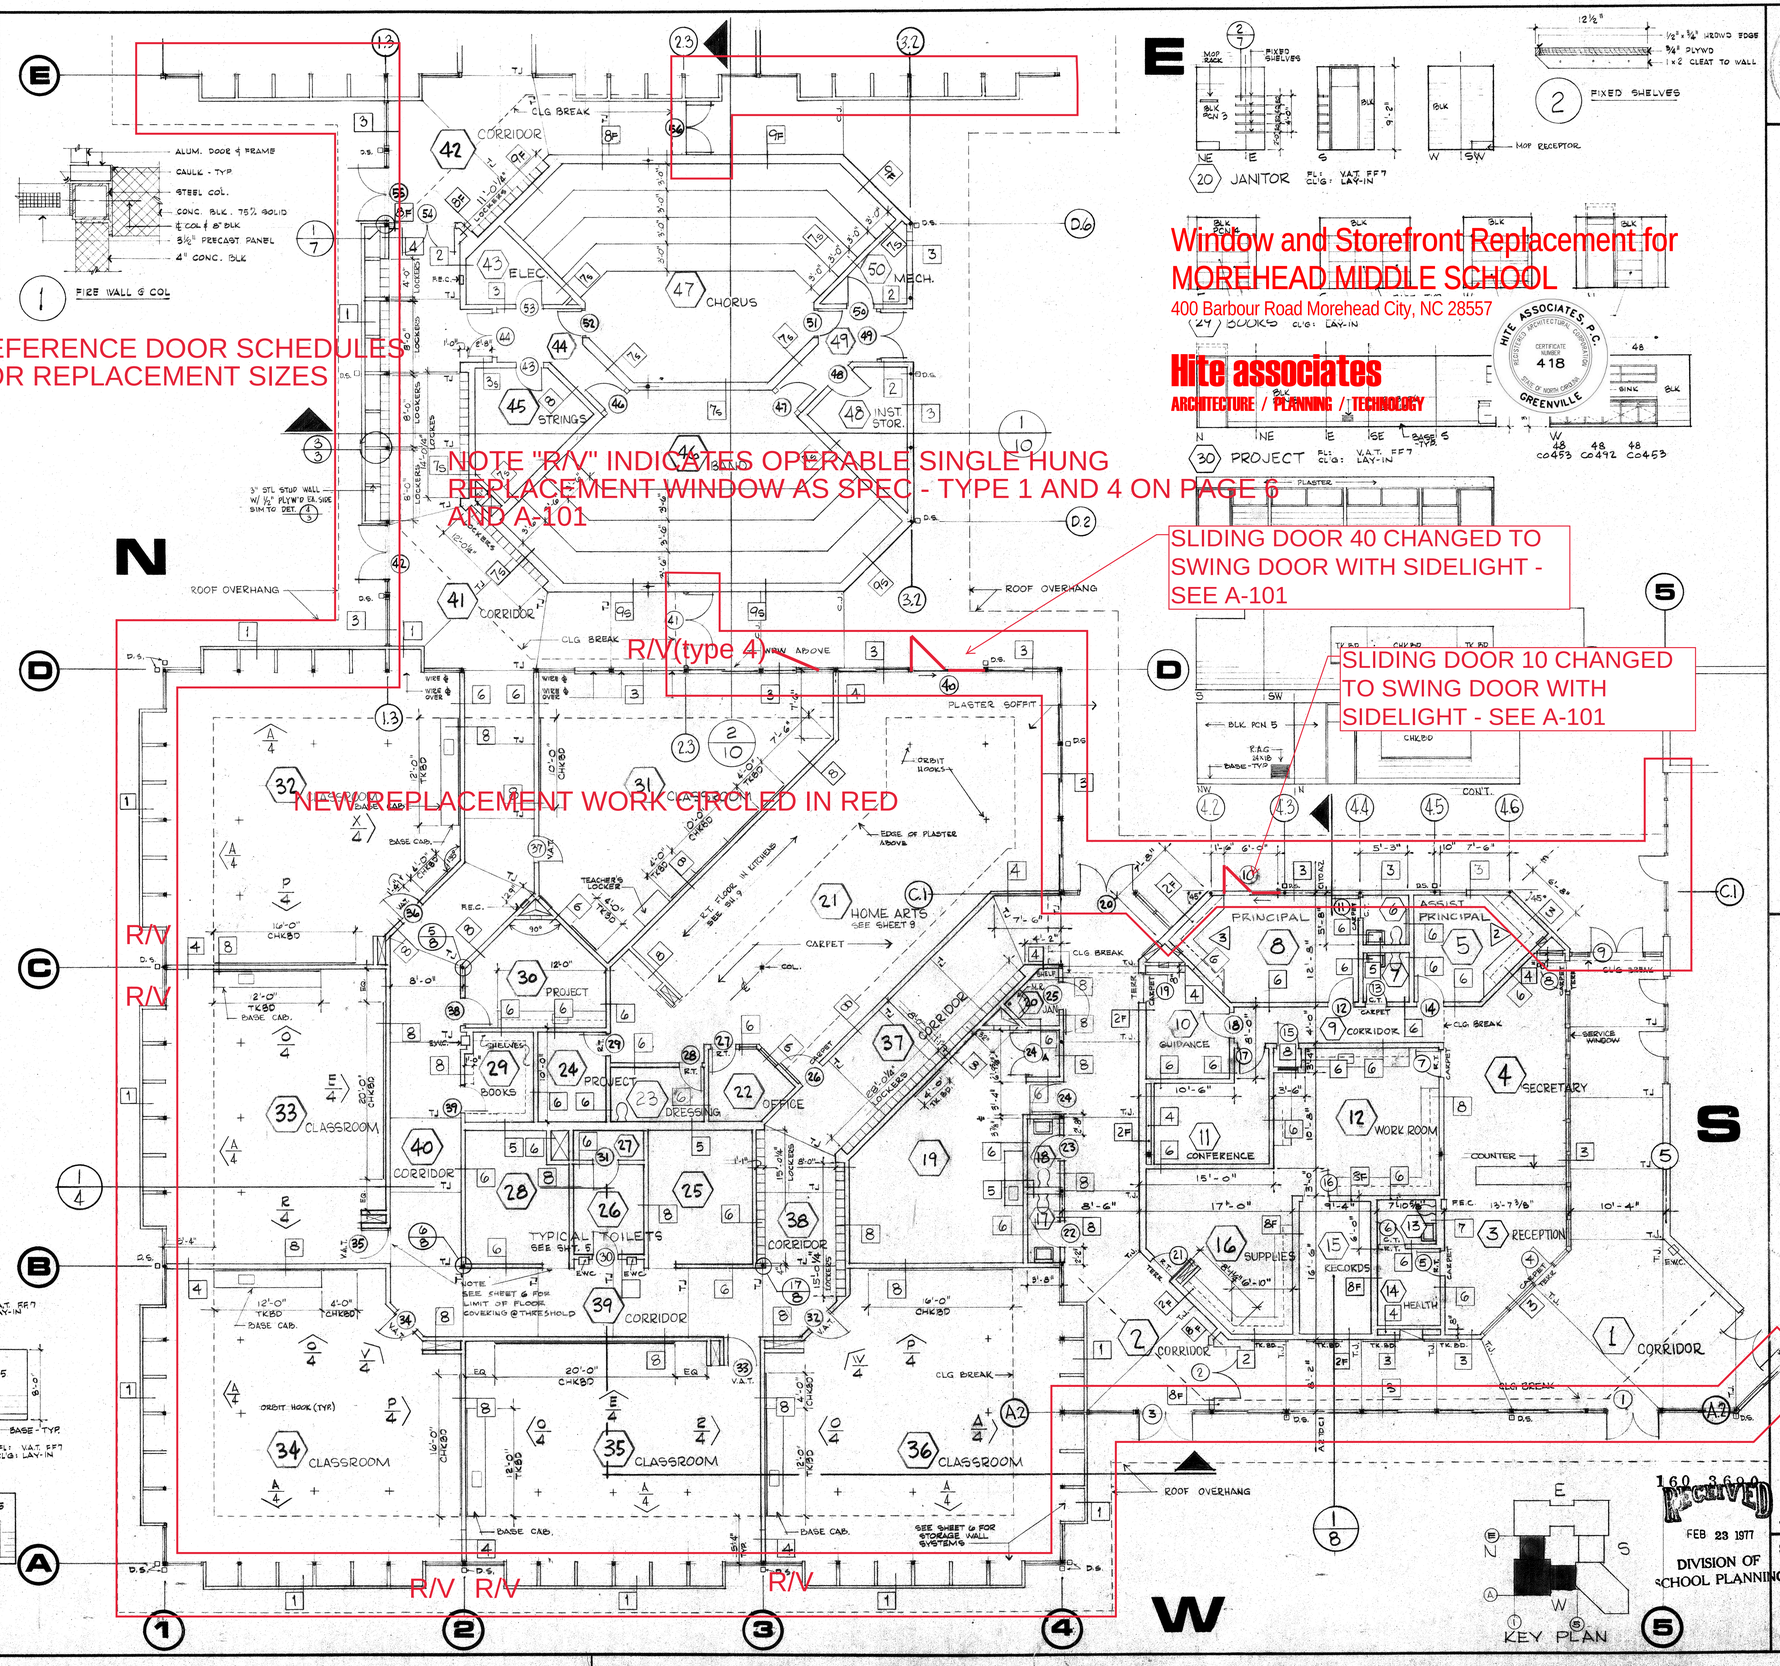

Window and Storefront Replacement for
MOREHEAD MIDDLE SCHOOL
400 Barbour Road Morehead City, NC 28557

Hite associates
ARCHITECTURE / PLANNING / TECHNOLOGY

HITE ASSOCIATES, P.C. REGISTERED ARCHITECTURAL ENGINEERING CORPORATION CERTIFICATE NUMBER 418 STATE OF NORTH CAROLINA GREENVILLE

james b willis jr / architect
401 S 13TH STREET NUMBER ONE BOGUE SOUND PO BOX 808
MOREHEAD CITY NORTH CAROLINA 28557 919-726-7091


DATE 12/21/76 PROJECT DESIGNER
DRAWN BY CB JR CHECKED BY JW


RECEIVED
FEB 23 1977
DIVISION OF SCHOOL PLANNING


MATH/SCI. POD, ADMIN., MUSIC
PLAN
DOOR SCHEDULE


JOB 75-2


SHEET NO. 7 OF 23

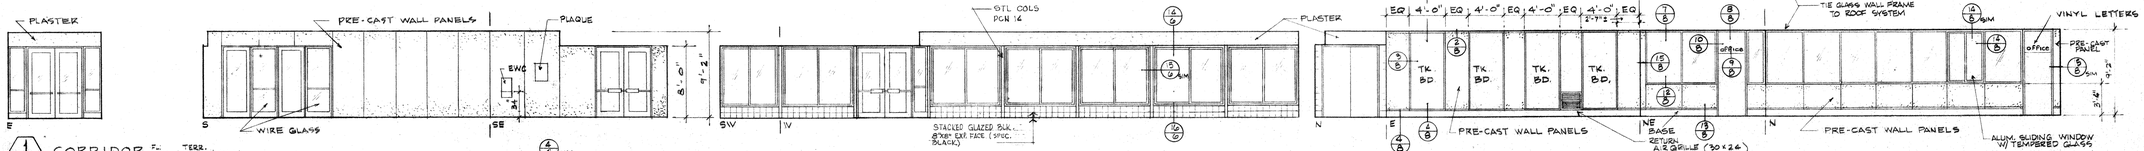


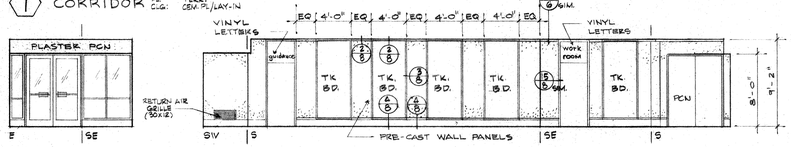


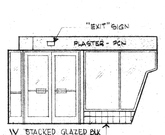


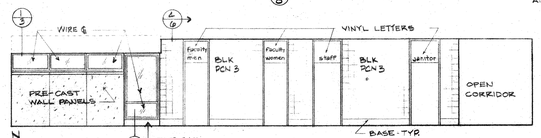


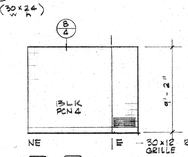

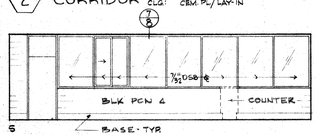


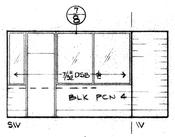


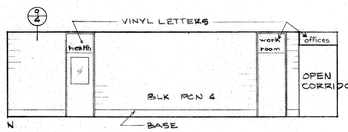


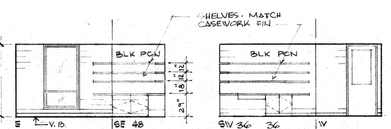





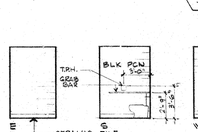


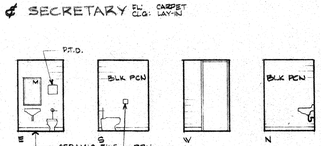


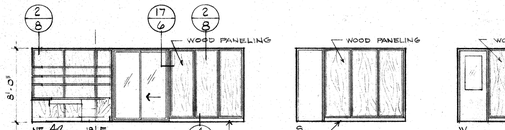


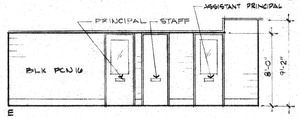


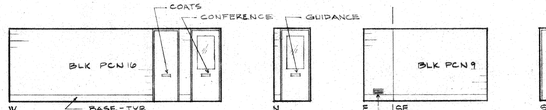


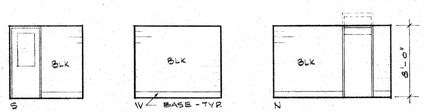


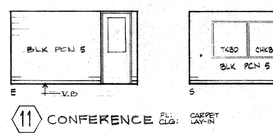


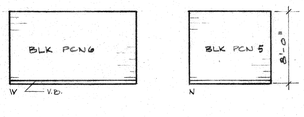

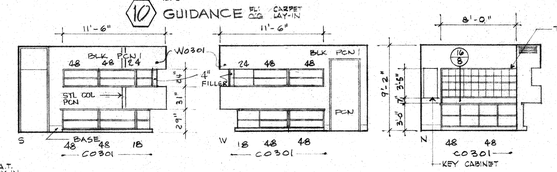

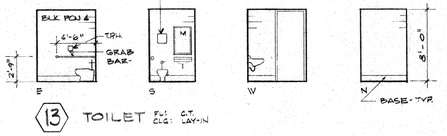

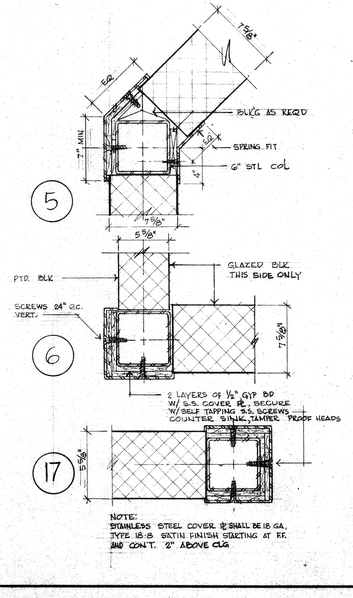

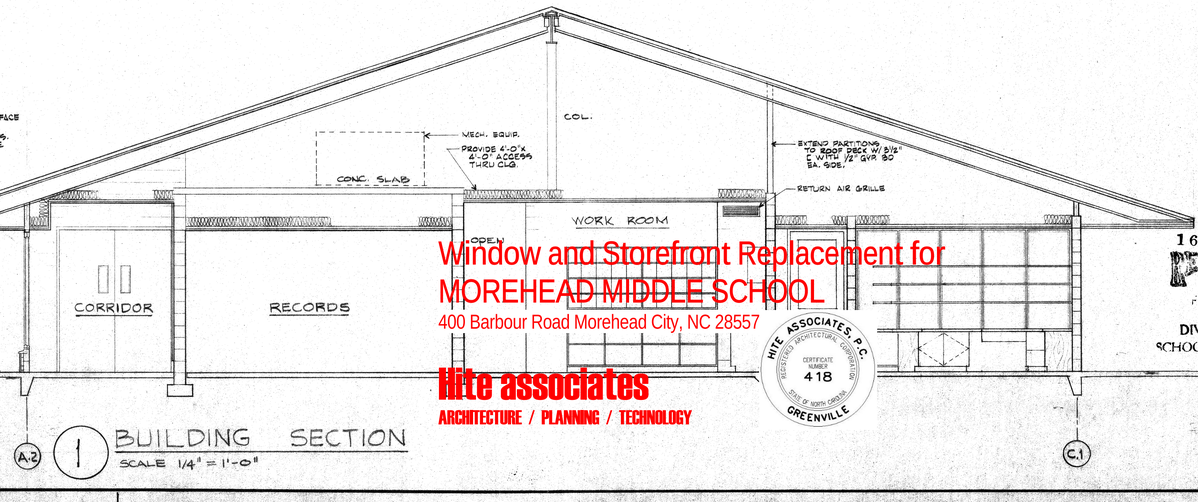

160 3690
RECEIVED
FEB 23 1977
DIVISION OF SCHOOL PLANNING

Window and Storefront Replacement for
MOREHEAD MIDDLE SCHOOL
400 Barbour Road Morehead City, NC 28557

hite associates
ARCHITECTURE / PLANNING / TECHNOLOGY

HITE ASSOCIATES, P.A. REGISTERED ARCHITECTURE, CORPORATION CERTIFICATE NUMBER 418 STATE OF NORTH CAROLINA GREENVILLE


james b willis jr / architect
401 S 13TH STREET NUMBER ONE BOGUE SOUND PO BOX 808
MOREHEAD CITY NORTH CAROLINA 28557 919-726-7091


DRAWN BY JJR CHECKED BY JW DATE 12/21/76 PROJECT DESIGNER

ADMINISTRATION SUITE
SECTION 1/4"
INTERIOR ELEVATIONS 1/4"
DETAILS 1/2"


JOB 75-2


SHEET NO. 8 OF 23

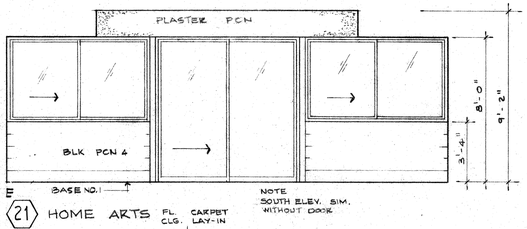


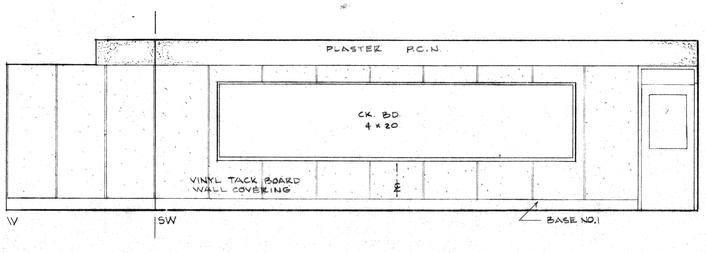



21 HOME ARTS FL. CARPET CLG. LAY-IN

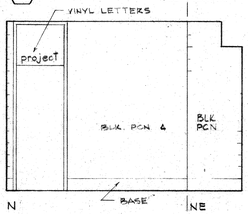


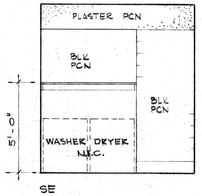


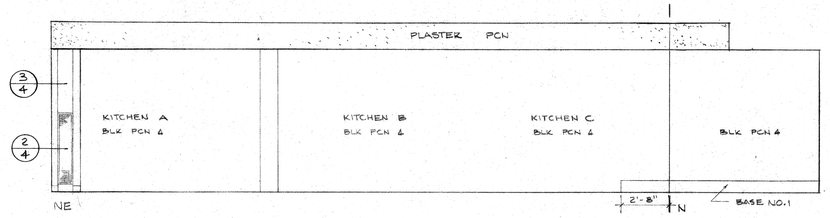


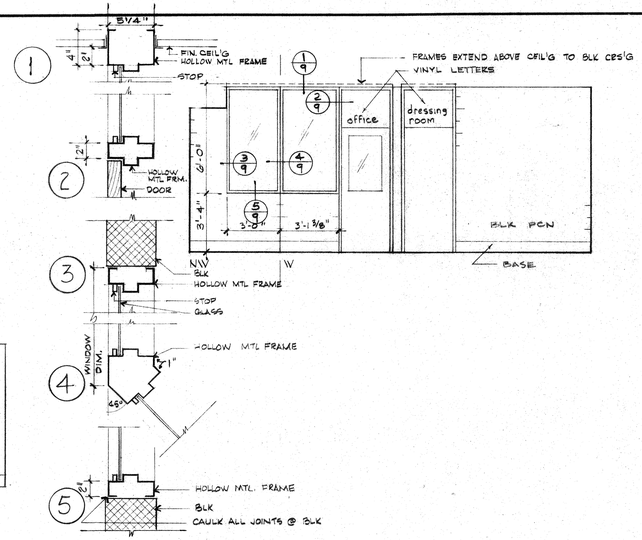


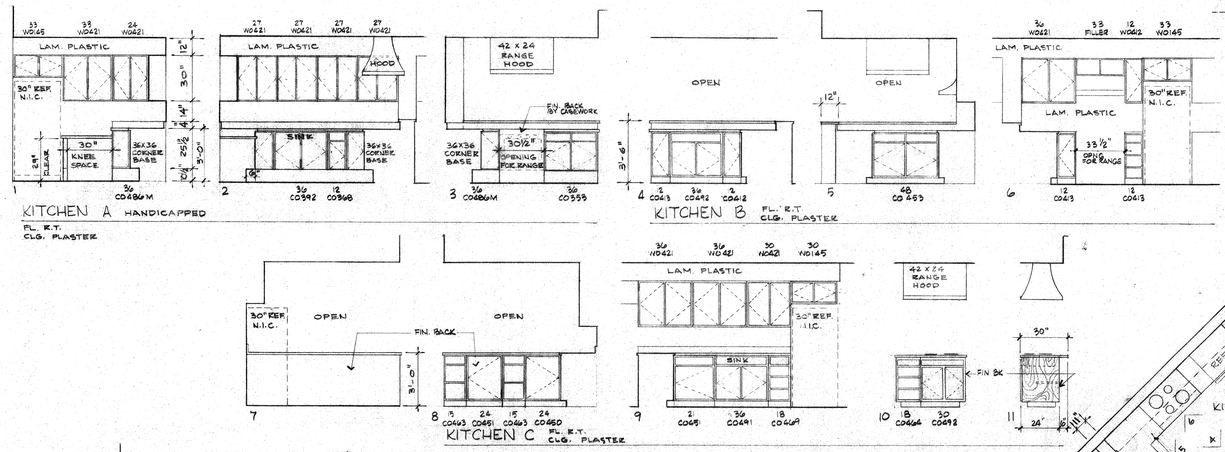

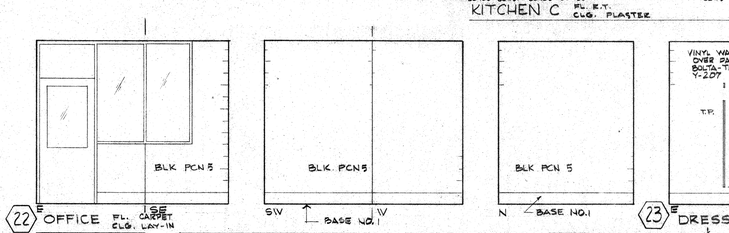

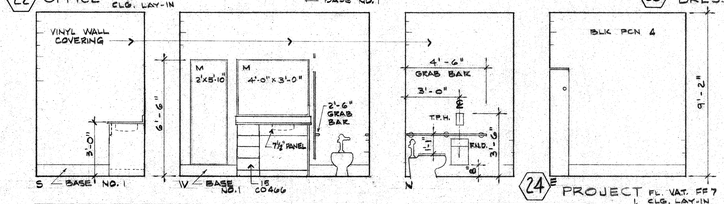

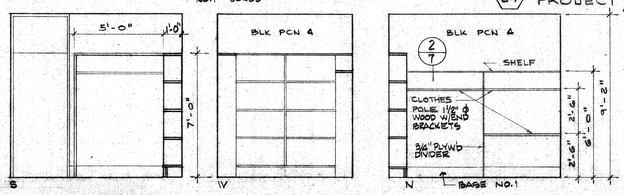

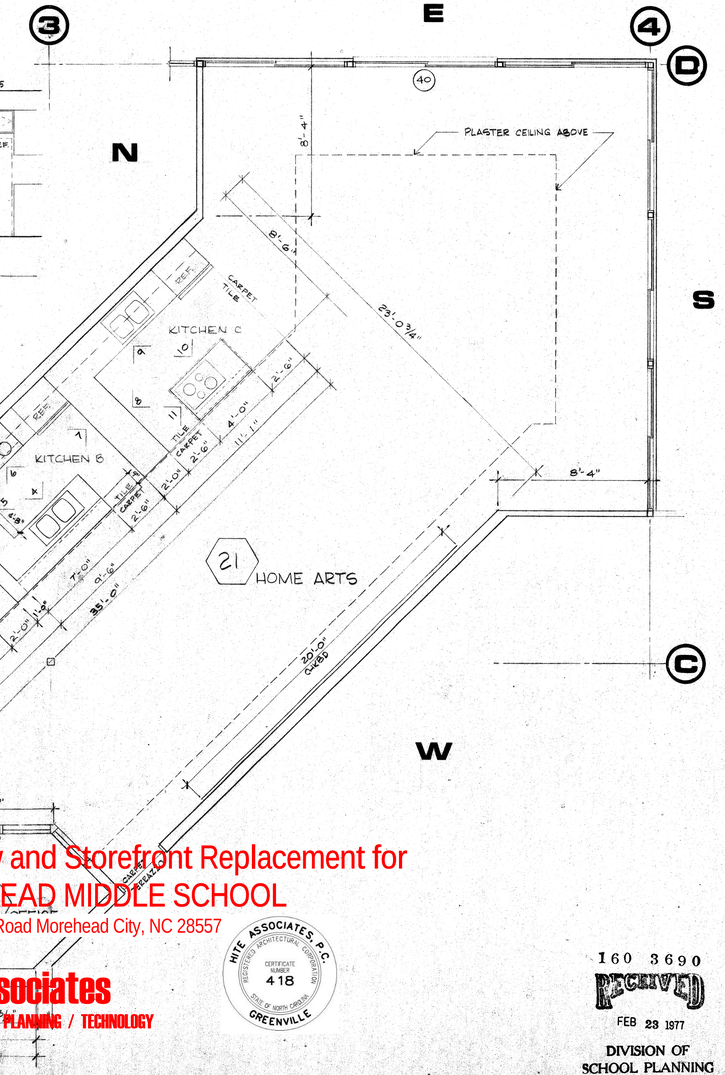

Window and Storefront Replacement for
MOREHEAD MIDDLE SCHOOL
400 Barbour Road Morehead City, NC 28557

Hite associates
ARCHITECTURE / PLANNING / TECHNOLOGY

HITE ASSOCIATES, P.A. REGISTERED ARCHITECTURAL CORPORATION CERTIFICATE NUMBER 418 STATE OF NORTH CAROLINA GREENVILLE

160 3690
RECEIVED
FEB 23 1977
DIVISION OF SCHOOL PLANNING

JAMES B. WILLIS JR. REGISTERED ARCHITECT 1409 NORTH CAROLINA MOREHEAD CITY

james b willis jr/ architect
401 S 13TH STREET NUMBER ONE BOGUE SOUND PO BOX 808
MOREHEAD CITY NORTH CAROLINA 28557 919-726-7091


DRAWN BY JR, BF CHECKED BY J.W. DATE 12/21/76 PROJECT DESIGNER

HOME ARTS SUITE
PLAN ¼"
INTERIOR ELEVATIONS ¼"
DETAILS 1½"


JOB 75-2

SHEET NO.
9
OF 23


N3474

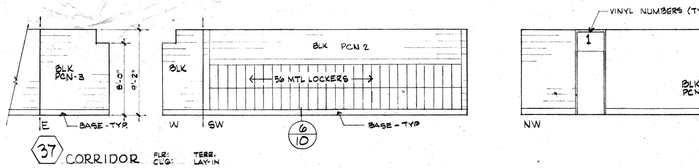


37 CORRIDOR FLR: CLG: TERR. LAY-IN

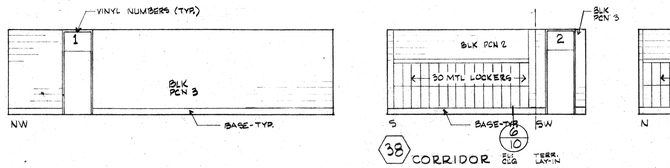



38 CORRIDOR FLR: CLG: TERR. LAY-IN

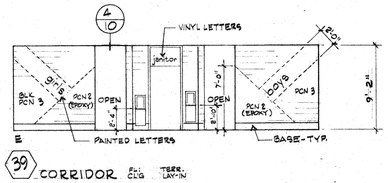



39 CORRIDOR FLR: CLG: TERR. LAY-IN

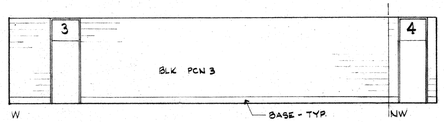

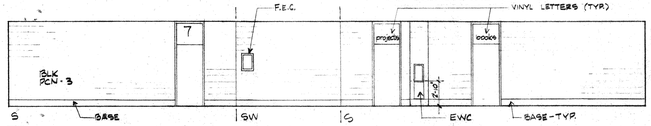

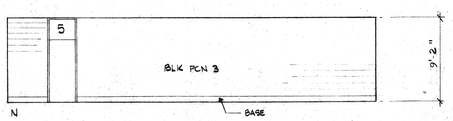


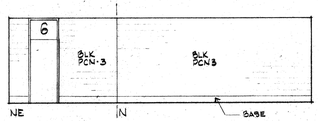


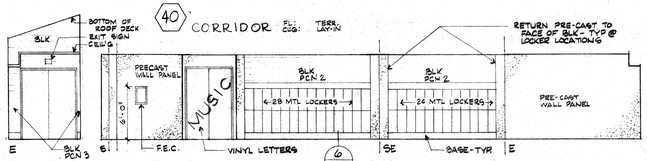


41 CORRIDOR FLR: CLG: TERR. LAY-IN



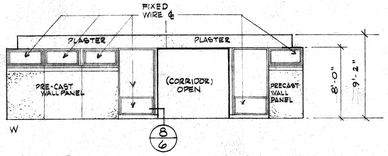


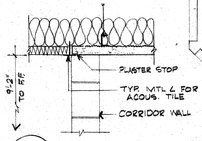


4

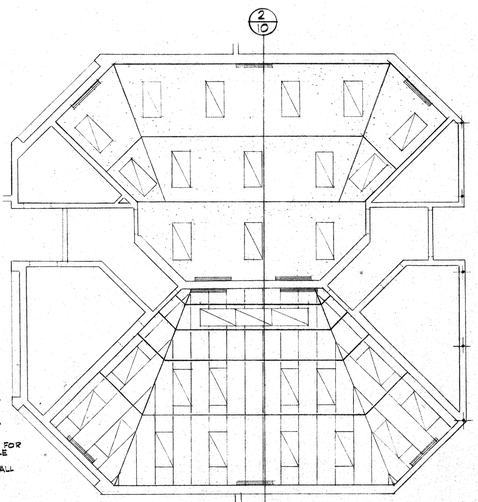

3 REFLECTED CL'G PLAN

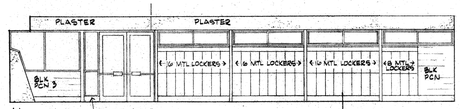


8/10

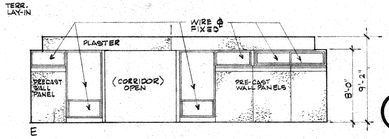


42 CORRIDOR FLR: CLG: TERR. LAY-IN




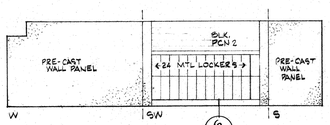


6/10

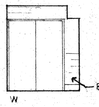




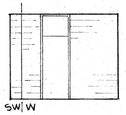


43 ELECTRICAL FLR: VA.T. CLG: LAY-IN FF 7

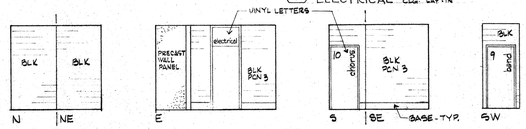

44 CORRIDOR FLR: TERR. CLG: LAY-IN

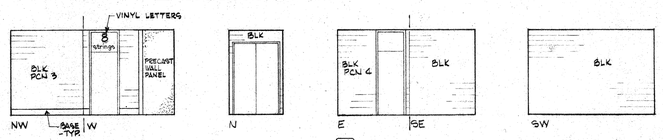


45 STRINGS FLR: CARPET CLG: LAY-IN

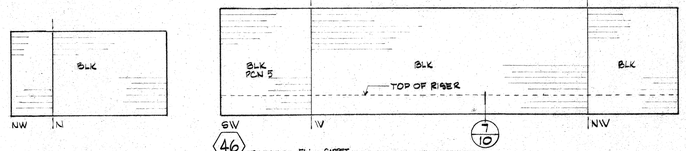


7/10


46 BAND FLR: CARPET CLG: LAY-IN

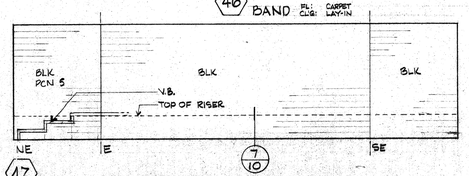


7/10

47 CHORUS FLR: CARPET CLG: SYP. BD. PCN 6

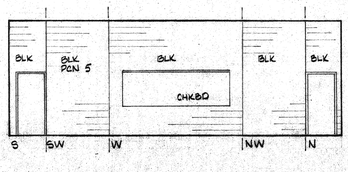

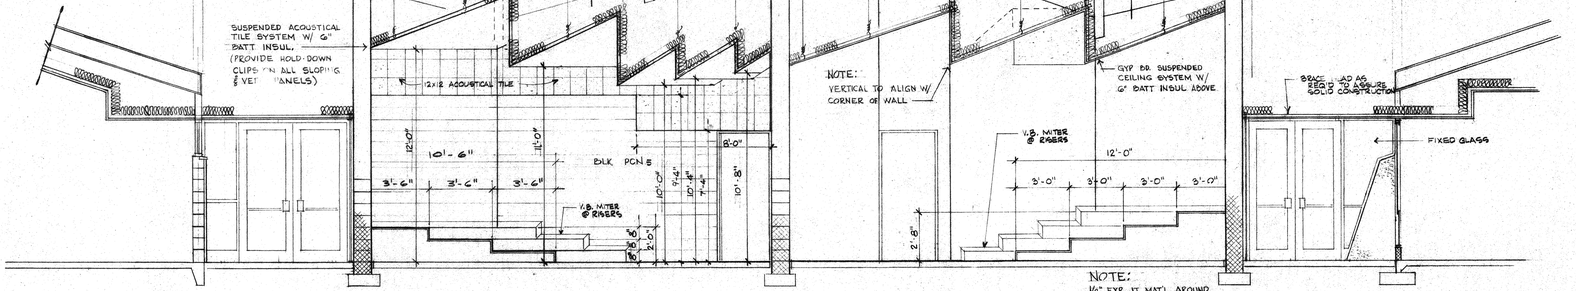


2 BUILDING SECTION
SCALE 1/4" = 1'-0"

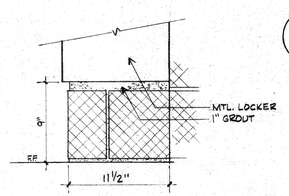

6 LOCKER BASE


8 LOCKER BASE
BASE TO BE 6" HGT. BLK. ALONG NORTH WALL ONLY

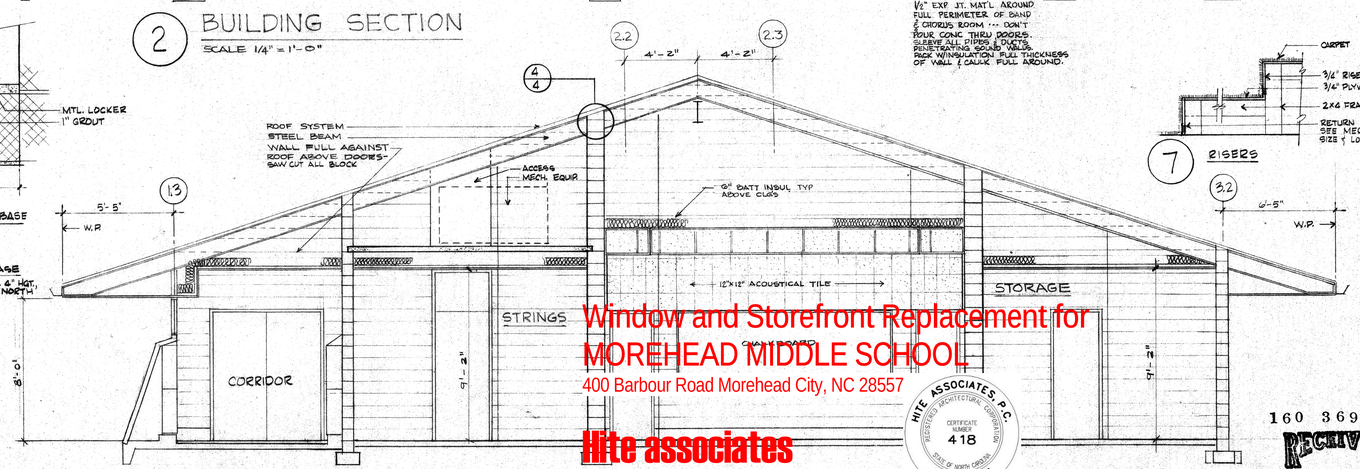

1 BUILDING SECTION
SCALE 1/4" = 1'-0"

NOTE:
½" EXP. JT. MAT'L AROUND FULL PERIMETER OF BAND & CHORUS ROOM ··· DON'T POUR CONC. THRU DOORS. SLEEVE ALL PIPES & DUCTS PENETRATING SOUND WALLS. PACK W/INSULATION. FULL THICKNESS OF WALL & CAULK FULL AROUND.

7 RISERS

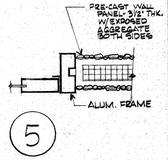

5

Window and Storefront Replacement for
MOREHEAD MIDDLE SCHOOL
400 Barbour Road Morehead City, NC 28557

Hite associates
ARCHITECTURE / PLANNING / TECHNOLOGY

HITE ASSOCIATES, P.A. ARCHITECTURAL CORPORATION CERTIFICATE NUMBER 418 STATE OF NORTH CAROLINA GREENVILLE

160 3690
RECEIVED
FEB 23 1977
DIVISION OF SCHOOL PLANNING

JAMES B. WILLIS JR. REGISTERED ARCHITECT 1409 North Carolina Morehead City, N. C.

james b willis jr / architect
401 S 13TH STREET NUMBER ONE BOGUE SOUND PO BOX 808
MOREHEAD CITY NORTH CAROLINA 28557 919-726-7091

DRAWN BY CB CHECKED BY JW DATE 12/21/76 PROJECT DESIGNER BF

MUSIC SECTIONS ¼" INTERIOR ELEVATIONS ¼" DETAILS 3/4"

JOB 75-2


SHEET NO. 10 OF 23


DOOR SCHEDULE

DOOR NO.	TYPE	SIZE	FRAME TYPE	T'HOLD TYPE	LABEL	HDWE SET	IDENTIFICATION SEE ELEVATION	FINISH *	REMARKS
60	G	3'-0" x 7'-0"	F-3	T-5	—	3	11		
61	G		F-3	T-5	—	3	12		
62	G		F-3	T-5	—	3	13		
63	G		F-3	T-5	—	3	14		
64	G		F-3	T-5	—	3	15		
65	G		F-3	T-5	—	3	16		
66	G		F-3	T-5	—	3	17		
67	D		F-3	T-5	—	5	STORAGE		
68	D	3'-6" x 7'-0"	F-3	T-3	—	5	JANITOR		
69	E	3'-6" x 7'-2"	F-1	—	—	5	—		
70	D	3'-0" x 7'-0"	F-3	T-5	—	5	BOOKS		UNDERCUT 5/8"
71	C		F-3	T-5	—	5	TEACHERS AID		UNDERCUT 5/8"
72	G		F-3	T-5	—	3	18		
73	A	PR 3'-0" x 7'-0"	F-8	T-4	—	1	—		F-II SIDELIGHT
74	D	3'-0" x 7'-0"	F-3	T-5	—	4	PROCESSING		
75	C	3'-0" x 7'-0"	F-3	—	—	4	A.V.		
76	L	3'-0" x 7'-10"	WD	T-1	—	4	—		
77	A	3'-0" x 7'-10"	ALUM	T-4	—	1	—		
78	A	3'-0" x 7'-10"	ALUM	T-4	—	1	—		
79	A	PR 3'-0" x 7'-10"	F-7	T-4	—	1	—		SEE ELEV. FOR SIDELIGHT
80	A	PR 3'-0" x 7'-10"	F-7	T-4	—	1	—		"
81	A	PR 3'-0" x 7'-10"	F-8	T-4	—	1	—		F-II SIDELIGHT

* ALL DOORS NATURAL FINISH UNLESS OTHERWISE NOTED

REFERENCE DOOR SCHEDULES FOR REPLACEMENT SIZES

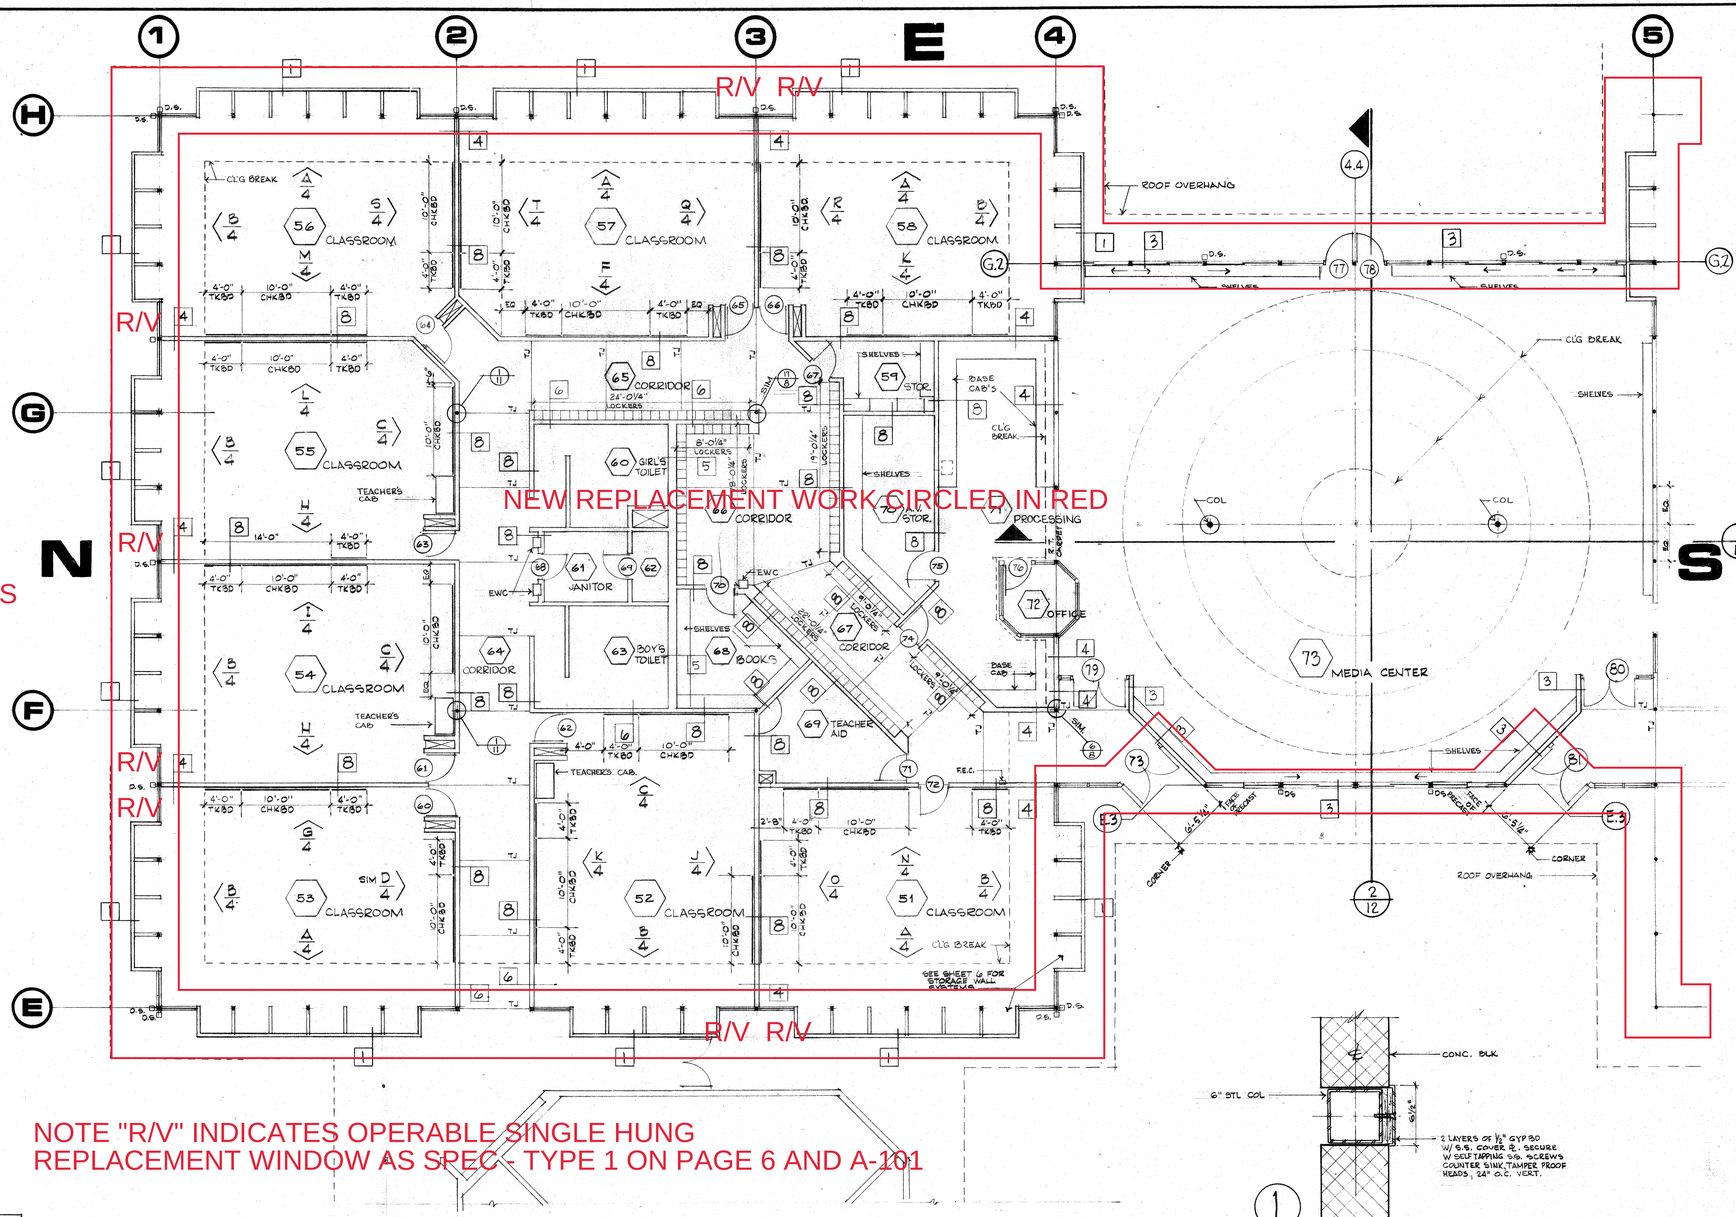

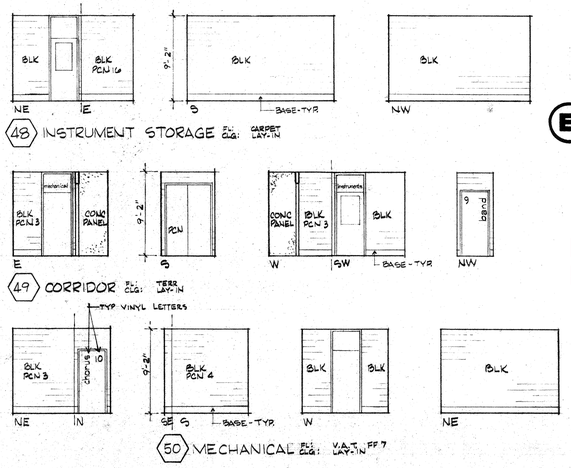


NOTE "R/V" INDICATES OPERABLE SINGLE HUNG REPLACEMENT WINDOW AS SPEC - TYPE 1 ON PAGE 6 AND A-101

160 3690
RECEIVED
FEB 23 1977
DIVISION OF SCHOOL PLANNING

Window and Storefront Replacement for
MOREHEAD MIDDLE SCHOOL
400 Barbour Road Morehead City, NC 28557

Hite associates
ARCHITECTURE / PLANNING / TECHNOLOGY

HITE ASSOCIATES, P.C. REGISTERED ARCHITECTURAL CORPORATION CERTIFICATE NUMBER 418 STATE OF NORTH CAROLINA GREENVILLE

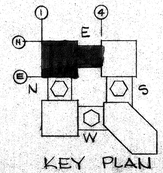


james b willis jr / architect
401 S 13TH STREET NUMBER ONE BOGUE SOUND PO BOX 808
MOREHEAD CITY NORTH CAROLINA 28557 919-726-7091

DRAWN BY CB CHECKED BY JJW DATE 12/21/76 PROJECT DESIGNER


LASS POD
MEDIA CENTER
PLAN 1/8"
DOOR SCHEDULE

JOB 75-2


SHEET NO. 11 OF 23

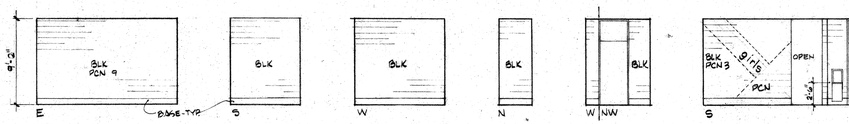


59 STORAGE FL: VAT, FF B CLG: LAY-IN

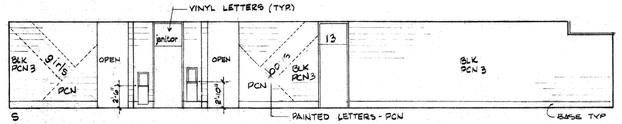

64 CORRIDOR FL: TERR CLG: LAY-IN

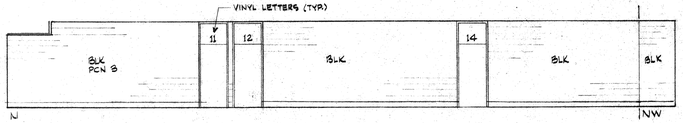


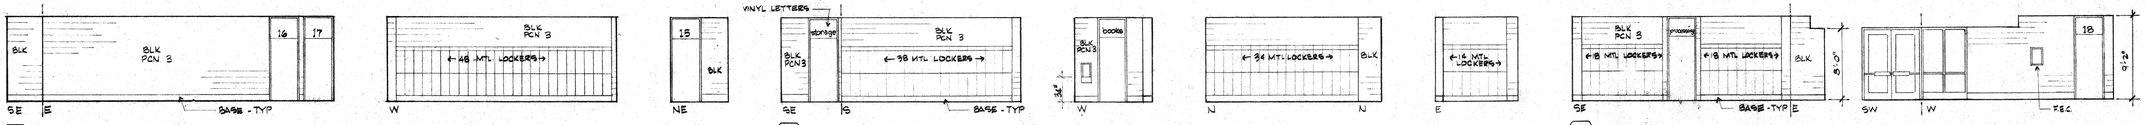

65 CORRIDOR FL: CLG TERR LAY-IN

66 CORRIDOR FL: CLG TERR LAY-IN


67 CORRIDOR FL: CLG TERR LAY-IN

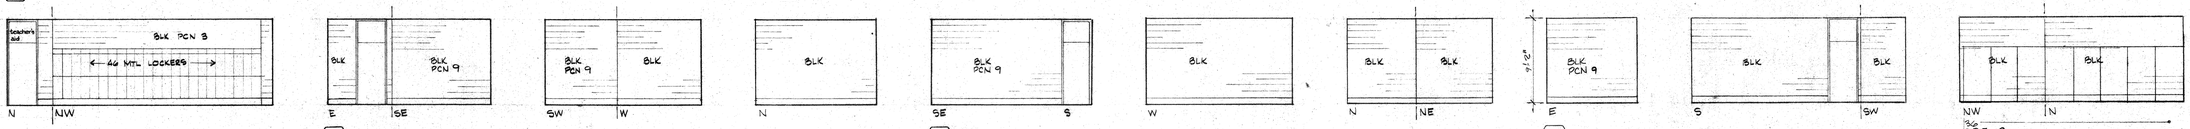


68 BOOKS FL: CLG VAT, LAY-IN FF B

69 TEACHER'S AID FL: CLG VAT, LAY-IN


70 A.V. STORAGE FL: CLG VAT, LAYIN FF B

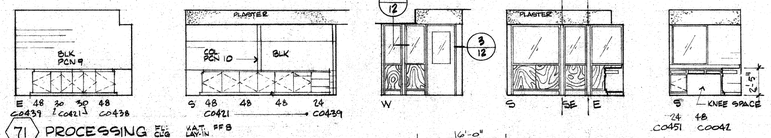


71 PROCESSING FL: CLG VAT, LAY-IN FF B

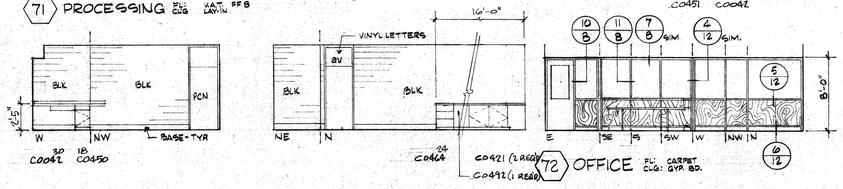



72 OFFICE FL: CARPET CLG: GYP. BD.

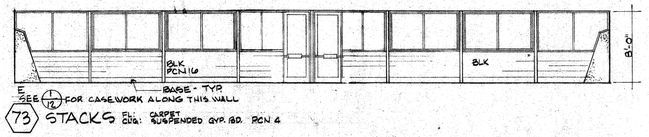



73 STACKS FL: CLG: CARPET SUSPENDED GYP. BD. PCN 4

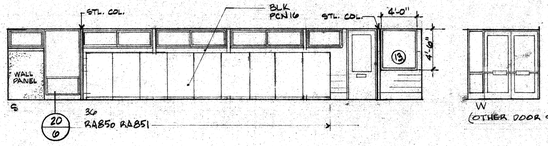

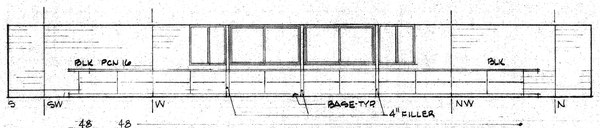

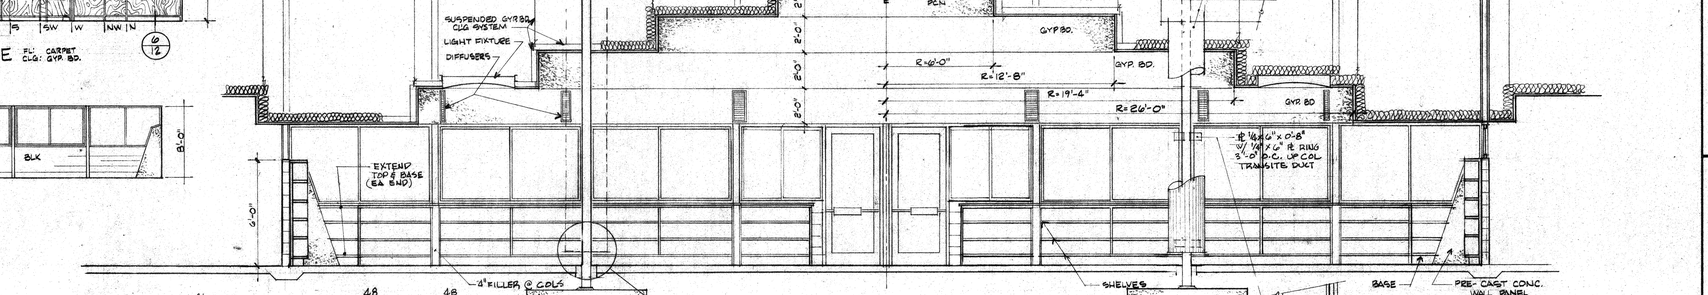

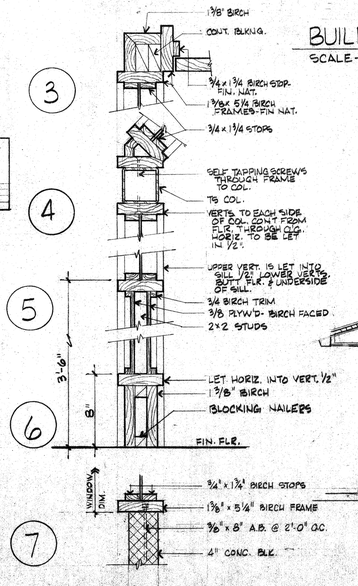

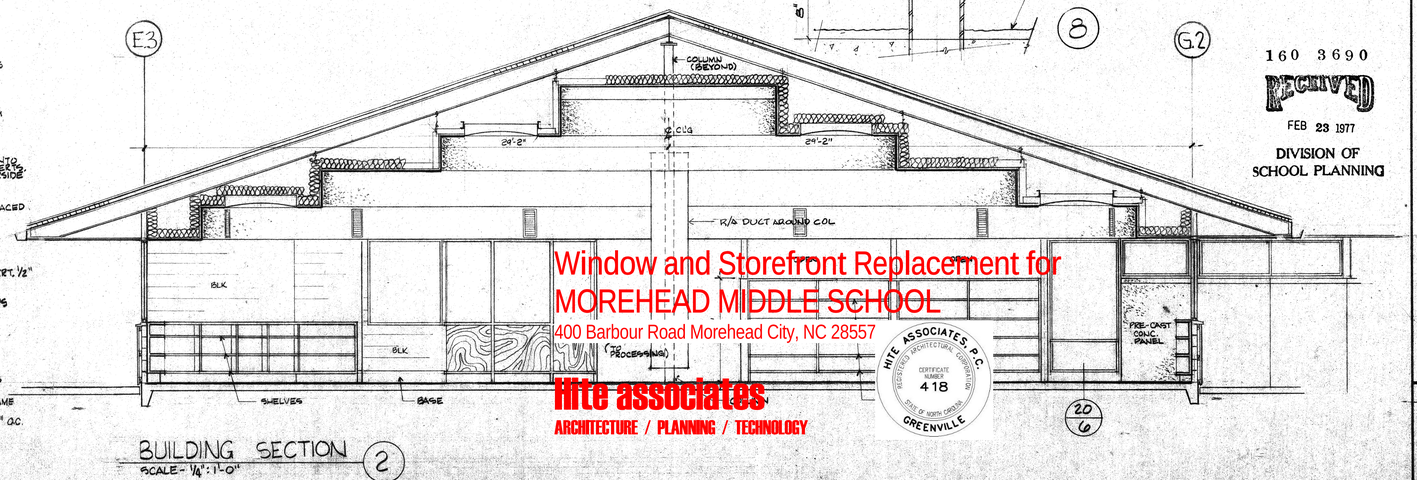

BUILDING SECTION
SCALE - 1/4" : 1'-0"
2

160 3690
RECEIVED
FEB 23 1977
DIVISION OF SCHOOL PLANNING

Window and Storefront Replacement for
MOREHEAD MIDDLE SCHOOL
400 Barbour Road Morehead City, NC 28557

Hite associates
ARCHITECTURE / PLANNING / TECHNOLOGY

HITE ASSOCIATES, P.A. REGISTERED ARCHITECTURE CORPORATION CERTIFICATE NUMBER 418 STATE OF NORTH CAROLINA GREENVILLE

JAMES B. WILLIS REGISTERED ARCHITECT 1409 NORTH CAROLINA Morehead City, N. C.


james b willis jr / architect
401 S 13TH STREET NUMBER ONE BOGUE SOUND PO BOX 808
MOREHEAD CITY NORTH CAROLINA 28557 919-726-7091

DRAWN BY CB CHECKED BY JW DATE 12/21/76 PROJECT DESIGNER

MEDIA CENTER SECTIONS 1/4" INTERIOR ELEVATIONS 1/8" DETAILS 1/2"

JOB 75-2

SHEET NO. 12 OF 23

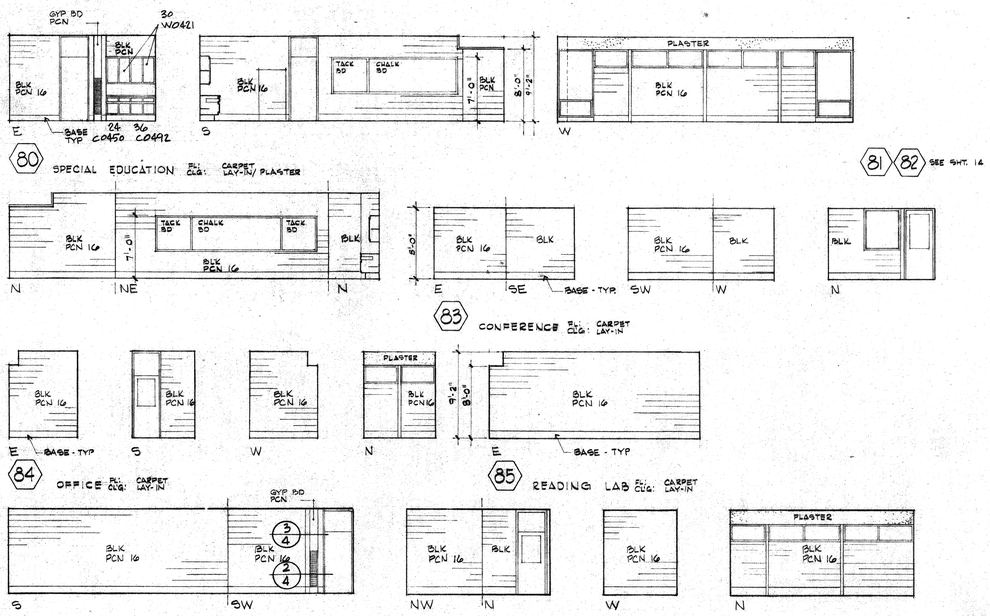

NOTE "R/V" INDICATES OPERABLE SINGLE HUNG REPLACEMENT WINDOW AS SPEC - TYPE 1 AND TYPE 4 ON PAGE 6 AND A-101


NEW REPLACEMENT WORK CIRCLED IN RED

REFERENCE DOOR SCHEDULES FOR REPLACEMENT SIZES

DOOR SCHEDULE

DOOR NO.	TYPE	SIZE	FRAME TYPE	T'HOLD TYPE	LABEL	HDWE SET	IDENTIFICATION SEE ELEVATION	FINISH *	REMARKS
82	L	3'-0" x 7'-10"	F-2	—	—	4	CONFERENCE		
83	C	3'-0" x 7'-0"	F-3	—	—	4	OFFICE		
84	G	3'-0" x 7'-0"	F-3	T-1	—	3	20		
85	C	3'-0" x 7'-0"	F-4	T-5	—	3	19		
86	B	8'-0" x 8'-0"	ALUM	—	—	11	—		
87	D	3'-0" x 7'-0"	F-3	—	—	5	PROJECT		
88	D	3'-0" x 7'-0"	F-3	T-5	—	5	STORAGE		
89	G		F-3	T-5	—	3	21		
90	G		F-3	T-5	—	3	22		
91	G		F-3	T-5	—	3	23		
92	G		F-3	T-5	—	3	24		
93	G		F-3	T-5	—	3	25		
94	G		F-3	T-5	—	3	27		
95	G	↓	F-3	T-1	—	3	26		
95 A	D	3'-0" x 7'-0"	F-4	T-2	—	3	—		
96	D	3'-6" x 7'-0"	F-3	T-3	—	5	—		
97	E	3'-6" x 7'-2"	F-1	—	—	5	—		
98	A	PR 3'-0" x 7'-10"	F-8	T-4	—	1	—		
99	E	3'-0" x 7'-10"	F-8	T-4	—	3A	—		
100	B	3'-0" x 7'-10"	F-2	T-5	—	4	OFFICE		
101	E		F-2	—	—	5	PAINT		
102	E		F-2	—	—	5	TOOLS		
103	E		F-2	—	—	5	SUPPLY		
104	E	↓	F-8	T-4	—	3A	—		
105	K	10'-0" x 7'-10"	—	—	—	—	—	PAINT	
106	A	PR 3'-0" x 7'-10"	F-7	T-4	—	1	—		F-11 SIDELIGHT
107	A	PR 3'-0" x 7'-10"	F-7	T-4	—	1	—		SEE ELEV. FOR SIDELIGHT

* ALL DOORS NATURAL FINISH UNLESS OTHERWISE NOTED.

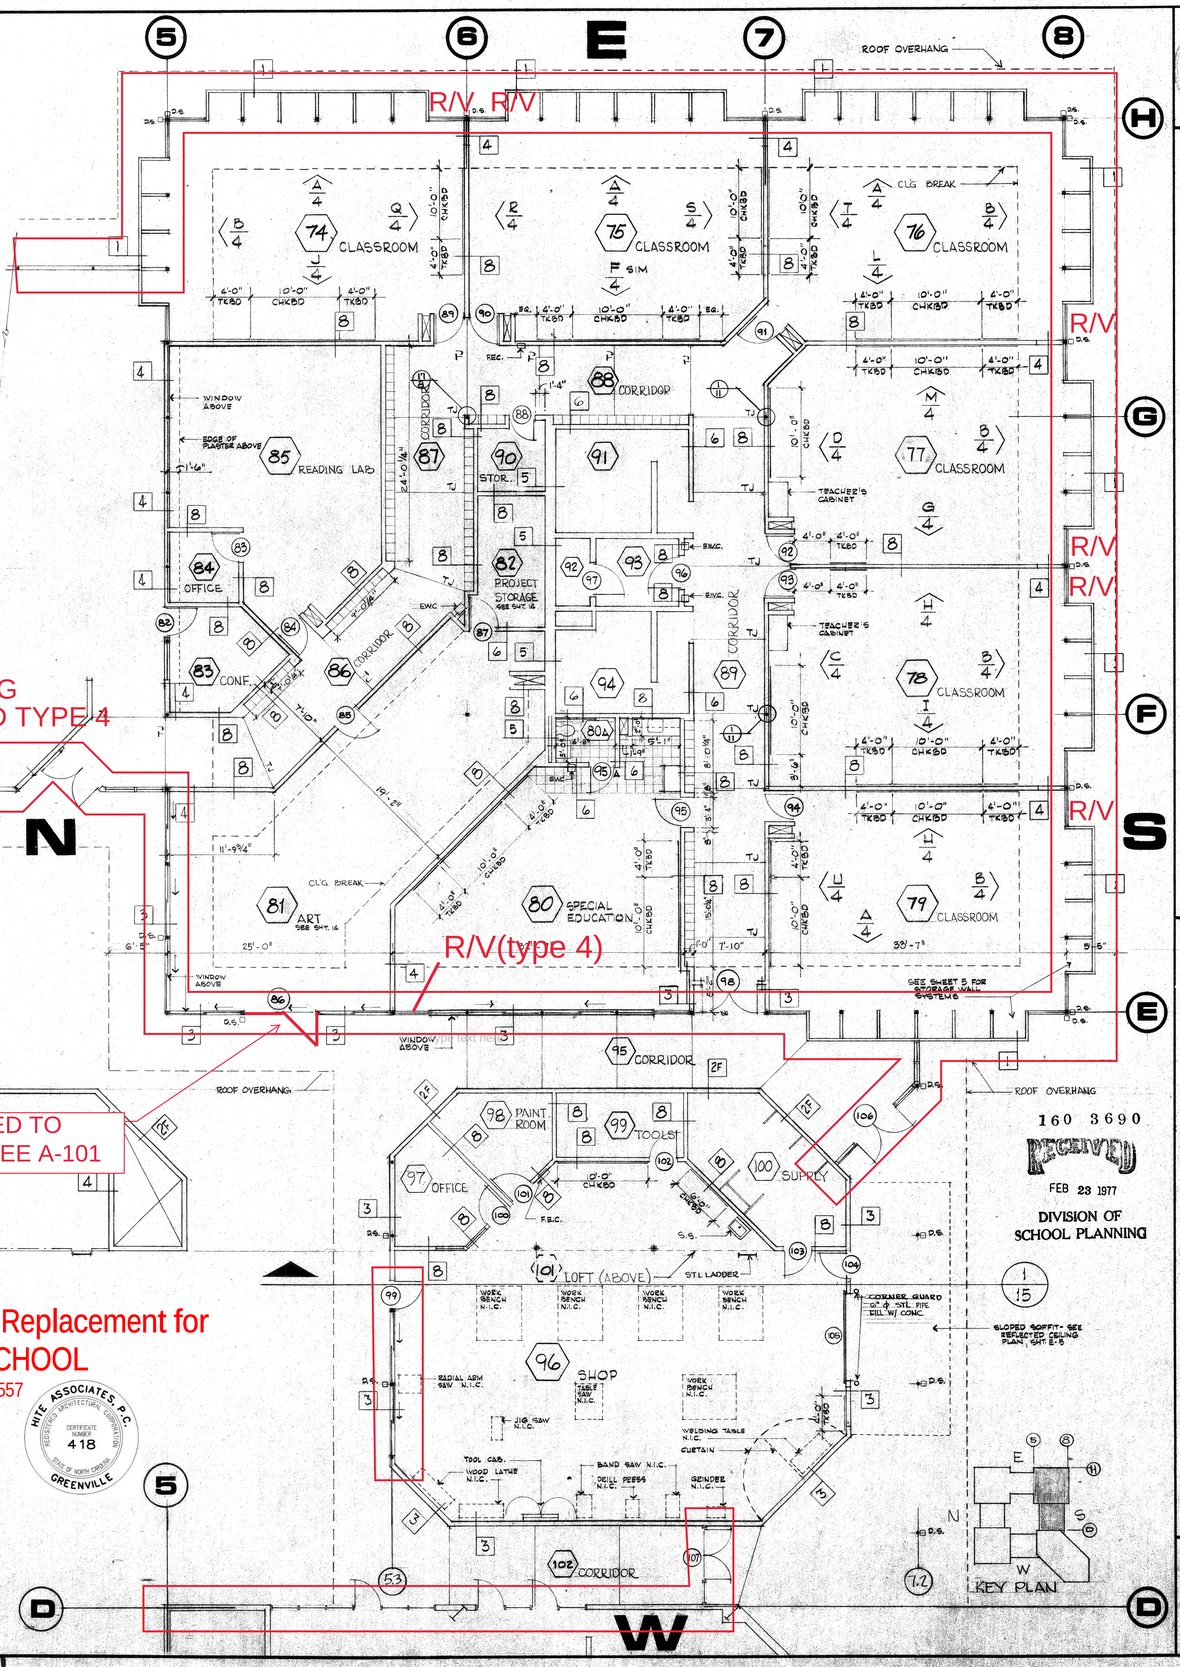

Window and Storefront Replacement for
MOREHEAD MIDDLE SCHOOL
400 Barbour Road Morehead City, NC 28557

HITE ASSOCIATES, P.C. REGISTERED ARCHITECTURE CORPORATION CERTIFICATE NUMBER 418 STATE OF NORTH CAROLINA GREENVILLE

Hite associates
ARCHITECTURE / PLANNING / TECHNOLOGY

160 3690
RECEIVED
FEB 23 1977
DIVISION OF SCHOOL PLANNING


james b willis jr / architect
401 S 13TH STREET NUMBER ONE BOGUE SOUND PO BOX 808
MOREHEAD CITY NORTH CAROLINA 28557 919-726-7091


DRAWN BY CB CT CHECKED BY JW DATE 12/21/76 PROJECT DESIGNER


SIXTH GRADE POD
INDUSTRIAL ARTS
PLAN
DOOR SCHEDULE


JOB 75-2


SHEET NO. 13 OF 23

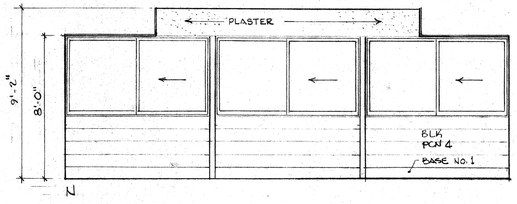

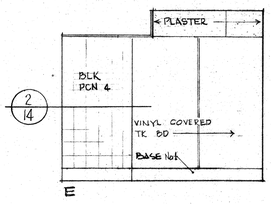

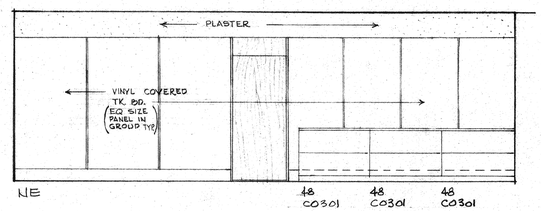


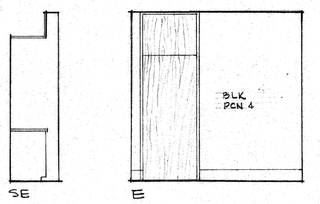

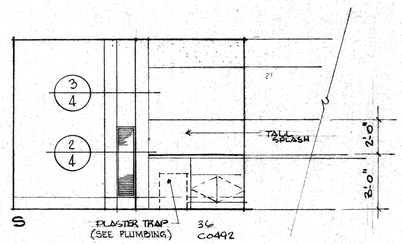



81 ART FL : CONC F.F.II
CLG LAY-IN/PLASTER


NOTE:
CARRY BASE AROUND FULL PERIMETER OF ROOM

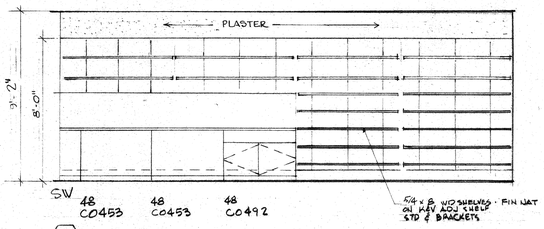


81 CONT'D

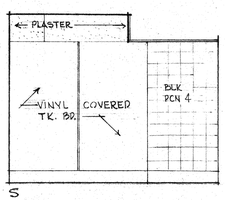


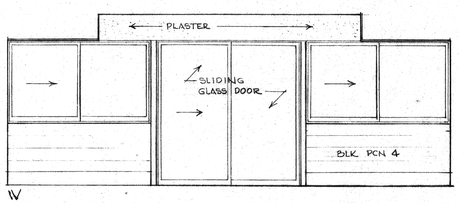


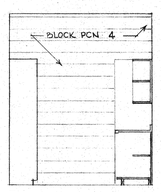

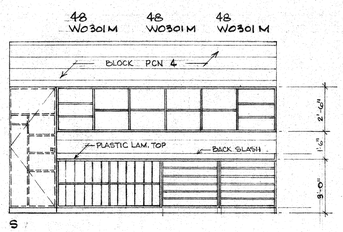


82 PROJECT STORAGE FL. CONC FF II
CLG LAY IN

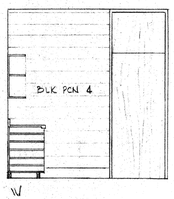


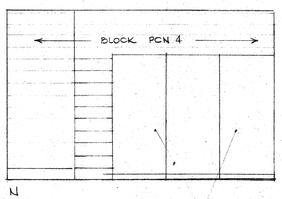



82 CONT'D

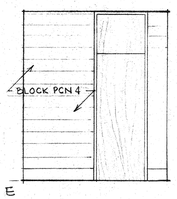


90 STORAGE FL R.T.
CLG LAY-IN

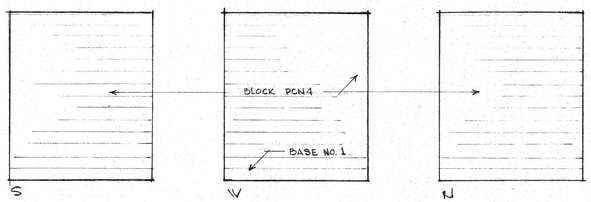

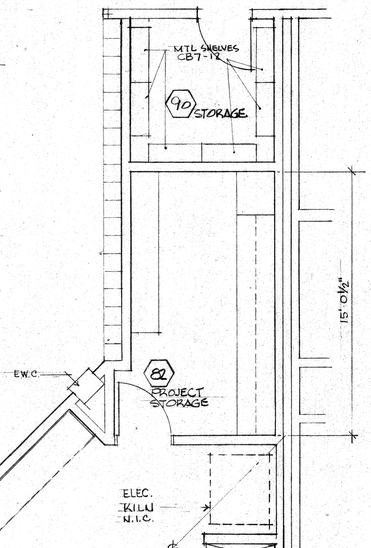

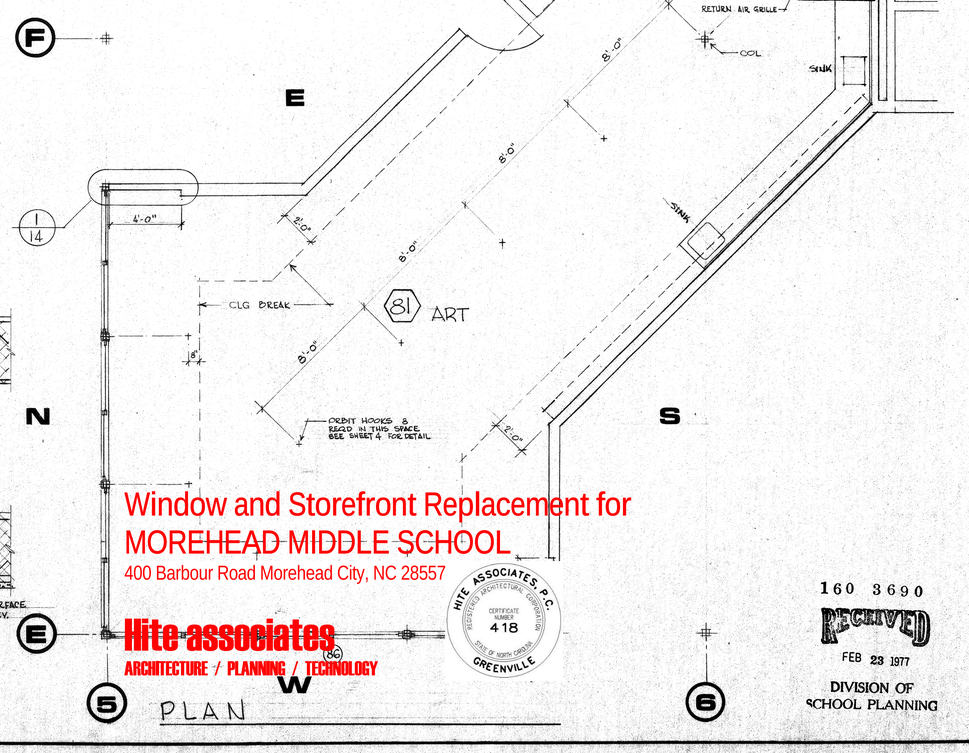

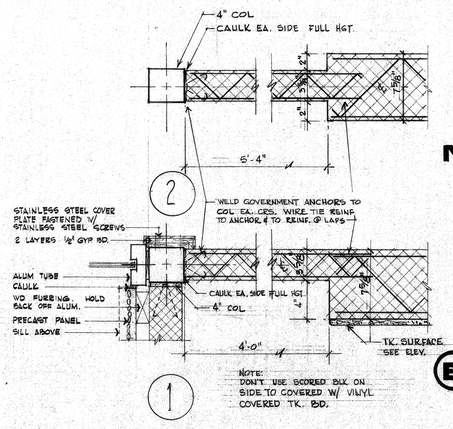

Window and Storefront Replacement for
MOREHEAD MIDDLE SCHOOL
400 Barbour Road Morehead City, NC 28557

Hite associates
ARCHITECTURE / PLANNING / TECHNOLOGY

HITE ASSOCIATES, P.C.
REGISTERED ARCHITECTURAL CORPORATION
CERTIFICATE NUMBER 418
STATE OF NORTH CAROLINA
GREENVILLE

160 3690
RECEIVED
FEB 23 1977
DIVISION OF SCHOOL PLANNING

James B. Willis, Jr.
REGISTERED ARCHITECT
1409
NORTH CAROLINA
No. 2
City,


james b willis jr / architect
401 S 13TH STREET NUMBER ONE BOGUE SOUND PO BOX 808
MOREHEAD CITY NORTH CAROLINA 28557 919-726-7091

DRAWN BY CB CHECKED BY JW DATE 12/2/76 PROJECT DESIGNER


ART PLAN 1/4" INTERIOR ELEVATIONS 1/4" DETAILS

JOB 75-2


SHEET NO. 14 OF 23

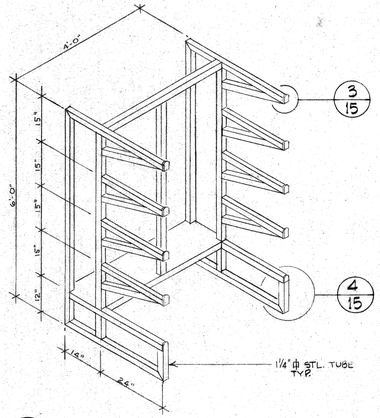


1 STORAGE UNIT

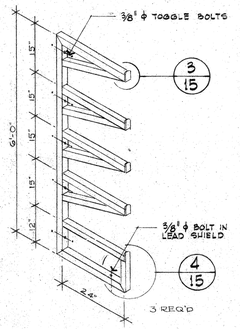


2 SHELF UNIT

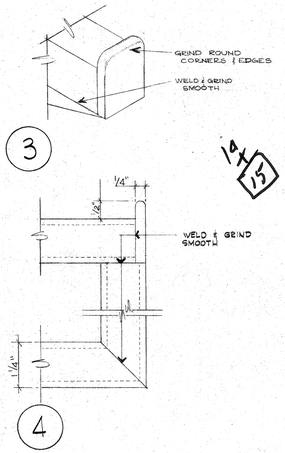


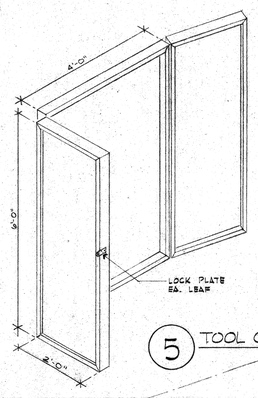



5 TOOL CABINET

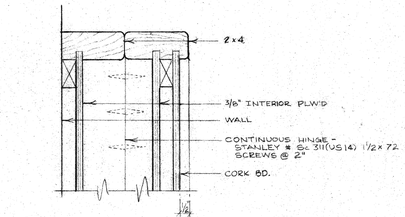



6 CABINET DETAIL

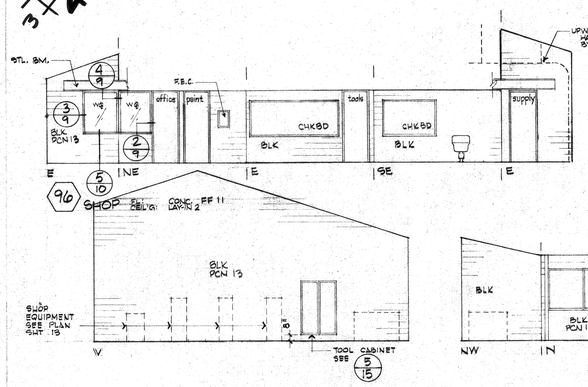


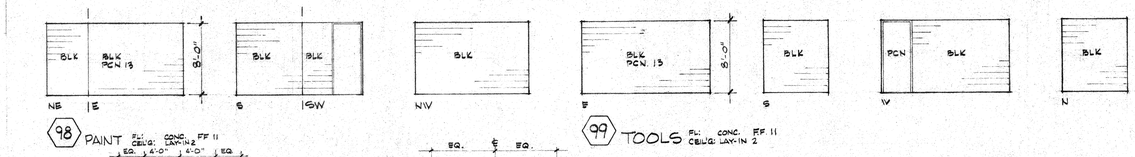


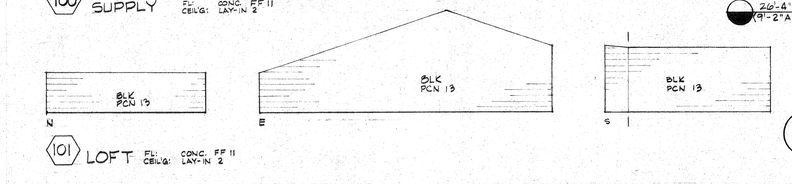


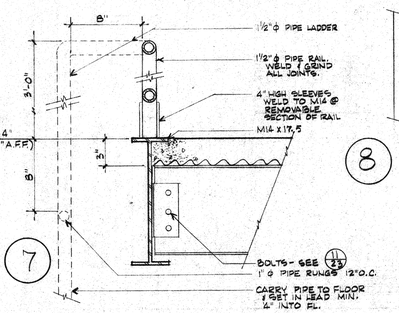


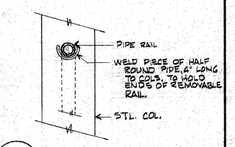


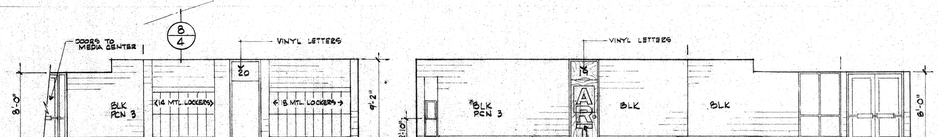


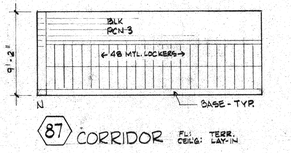

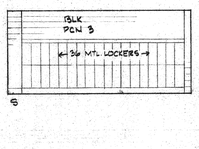

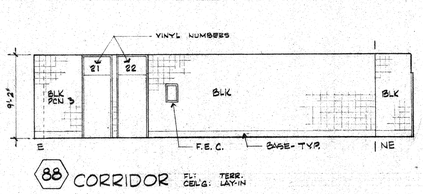

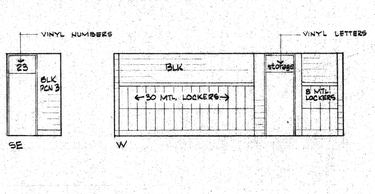

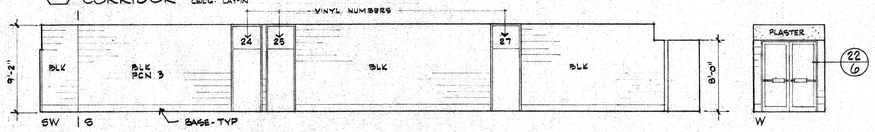



1 BUILDING SECTION
SCALE - 1/4" : 1'-0"

160 3690
RECEIVED
FEB 23 1977
DIVISION OF SCHOOL PLANNING

Window and Storefront Replacement for
MOREHEAD MIDDLE SCHOOL
400 Barbour Road Morehead City, NC 28557

Hite associates
ARCHITECTURE / PLANNING / TECHNOLOGY

HITE ASSOCIATES, P.A. REGISTERED ARCHITECTURAL CORPORATION CERTIFICATE NUMBER 418 STATE OF NORTH CAROLINA GREENVILLE

JAMES B. WILLIS, JR. REGISTERED ARCHITECT 1409 NORTH CAROLINA MOREHEAD CITY, N. C.

james b willis jr / architect
401 S 13TH STREET NUMBER ONE BOGUE SOUND PO BOX 808
MOREHEAD CITY NORTH CAROLINA 28557 919-726-7091

DRAWN BY CT CHECKED BY JW DATE 12/21/76 PROJECT DESIGNER

SHOP SECTION INTERIOR ELEVATIONS 1/4" 1/2" DETAILS

JOB 75-2

SHEET NO. 15 OF 23

DOOR SCHEDULE

DOOR NO.	TYPE	SIZE	FRAME TYPE	T'HOLD TYPE	LABEL	HDWE SET	IDENTIFICATION SEE ELEVATION	FINISH *	REMARKS
137	H	3'-0" x 7'-2"	F-1	-	B	6	STAIRS		
138	F	3'-0" x 7'-2"	F-1	T.5	—	5	MECHANICAL		
139	C	3'-0" x 7'-2"	F-1	—	—	4	OFFICE		
140	C	3'-0" x 7'-2"	F-1	—	—	4	OFFICE		
141	F	3'-0" x 7'-2"	F-1	T.5	—	3	30		
142	F	3'-0" x 7'-2"	F-1	T.5	—	5	MECHANICAL		
143	F	3'-0" x 7'-2"	F-1	—	—	3	TEAM ROOM		
144	H	3'-0" x 7'-2"	F-1	—	B	6	STAIRS		
145	F	PR. 3'-0" x 7'-2"	F-1	T.6	—	13	—		
146	F	PR. 3'-0" x 7'-2"	F-1	T.6	—	13	—		

* ALL DOORS NATURAL FINISH UNLESS OTHERWISE NOTED.

REFERENCE DOOR SCHEDULES FOR REPLACEMENT SIZES

DOOR SCHEDULE

DOOR NO.	TYPE	SIZE	FRAME TYPE	T'HOLD TYPE	LABEL	HDWE SET	IDENTIFICATION SEE ELEVATION	FINISH *	REMARKS
108	A	3'-0" x 7'-10"	F-10	T-4	—	1	—		
109	A	3'-0" x 7'-10"	F-9	T-4	—	1	—		
110	A	3'-0" x 7'-10"	F-9	T-4	—	1	—		
111	E	3'-0" x 7'-10"	F-2	T-3	—	8	BOYS		
112	E	3'-0" x 7'-10"	F-2	T-3	—	8	BOYS		
113	E	3'-0" x 7'-10"	F-2	—	—	8	LOCKERS		
114	E	3'-0" x 7'-10"	F-2	T.5	—	5	JANITOR		
115	A	PR. 3'-0" x 7'-10"	F-8	T-4	—	1	—		
116	H	PR 3'-0" x 7'-10"	F-2	T-5	B	2A	—		WIRE GLASS
117	E	PR. 3'-0" x 7'-10"	F-8	T-4	—	1	—		
118	H	3'-0" x 7'-10"	F-2	—	B	6	STAIRS		WIRE GLASS
119	H	3'-0" x 7'-10"	F-2	—	B	3	28		WIRE GLASS
120	H	3'-0" x 7'-10"	F-2	T.5	—	3	—		
121	E	4'-0" x 7'-2"	F-5	T-4	—	3A	—		
122	I	PR. 3'-0" x 7'-2"	F-5	T-4	—	9	—		FULL LOUVERS
122A					OMITTED				
123	E	PR 3'-0" x 7'-10"	F-8	T-4	—	1	—		
124	H	3'-0" x 7'-10"	F-2	—	B	6	STAIRS		WIRE GLASS
125	E	3'-0" x 7'-2"	F-1	—	—	5	STORAGE		
126	H	3'-0" x 7'-10"	F-2	T.5	B	3	29		WIRE GLASS
127	H	PR 3'-0" x 7'-10"	F-2	T.5	B	2A	—		WIRE GLASS
128	A	PR. 3'-0" x 7'-10"	F-8	T-4	—	1	—		
129	E	3'-0" x 7'-10"	F-2	T-3	—	8	GIRLS		
130	E	3'-0" x 7'-10"	F-2	—	—	8	LOCKERS		
131	E	3'-0" x 7'-10"	F-2	T-3	—	8	GIRLS		
132	A	3'-0" x 7'-10"	F-9	T-4	—	1	—		
133	A	3'-0" x 7'-10"	F-9	T-4	—	1	—		
134	A	3'-0" x 7'-10"	F-10	T-4	—	1	—		
135	J	3'-0" x 7'-10"	F-2	T-5	—	12	—		DUTCH DOOR
136	F	3'-0" x 7'-2"	F-1	—	—	5	—		

* ALL DOORS NATURAL FINISH UNLESS OTHERWISE NOTED

NEW REPLACEMENT WORK CIRCLED IN RED

Window and Storefront Replacement for
MOREHEAD MIDDLE SCHOOL
400 Barbour Road Morehead City, NC 28557

Hite associates
ARCHITECTURE / PLANNING / TECHNOLOGY

HITE ASSOCIATES, P.C. REGISTERED ARCHITECTURE ENGINEERING CERTIFICATE NUMBER 418 STATE OF NORTH CAROLINA GREENVILLE

JAMES B. WILLIS REGISTERED SURVEYOR 1409 Morehead City, N.C.

james b willis jr / architect
401 S 13TH STREET NUMBER ONE BOGUE SOUND PO BOX 808
MOREHEAD CITY NORTH CAROLINA 28557 919-726-7091

DRAWN BY SB/BF CHECKED BY JW DATE 2/2/76 PROJECT DESIGNER


GYMNASIUM & COMMONS
PLAN 1/8"
DOOR SCHEDULE

JOB 75-2


SHEET NO. 16 OF 23

160 3690
RECEIVED
FEB 23 1977
DIVISION OF SCHOOL PLANNING


N24794

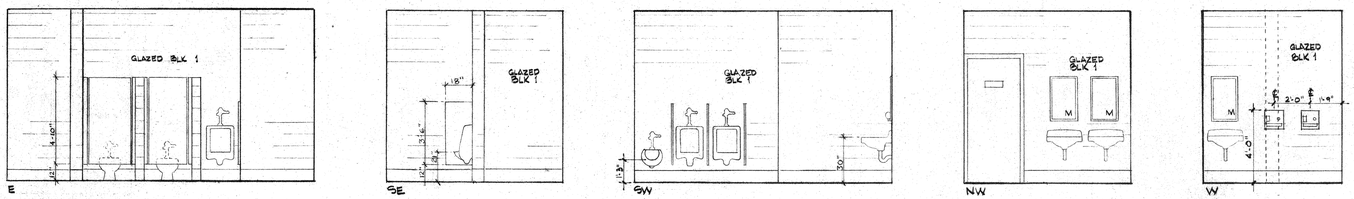

104 BOYS' TOILET FL: CERAMIC TILE CLG: LAY-IN F.F. 10

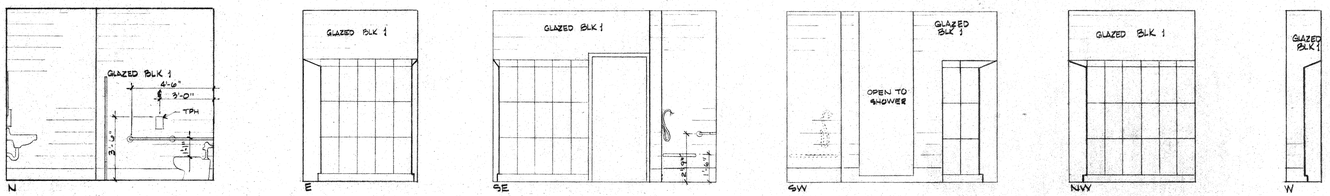


105 LOCKERS FL: CERAMIC TILE CLG: LAY-IN F.F. 10

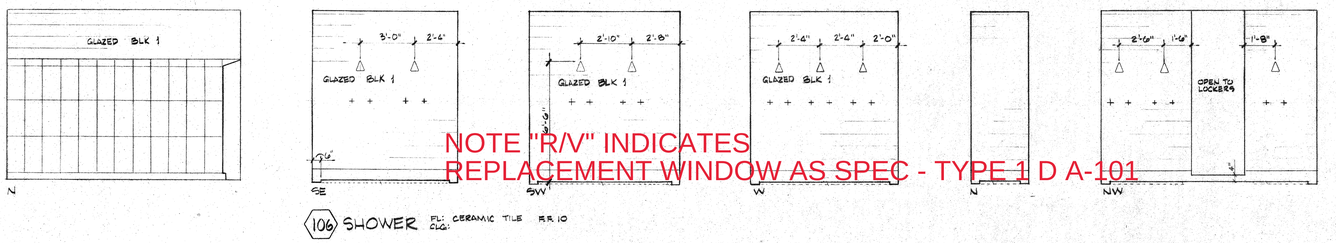


106 SHOWER FL: CERAMIC TILE CLG: F.F. 10

BOYS' LOCKER ROOM

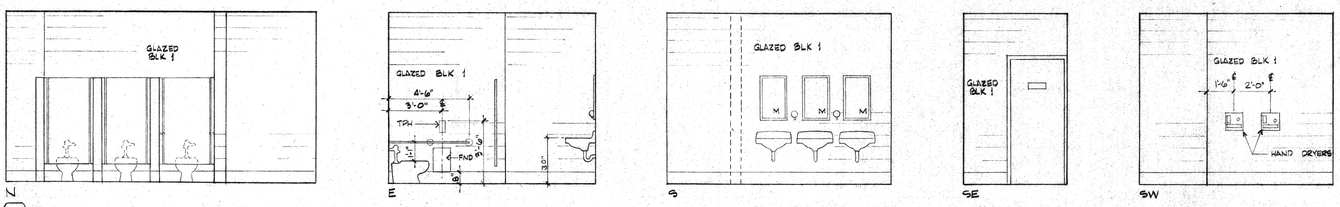


110 GIRLS' TOILET FL: CERAMIC TILE CLG: LAY-IN F.F. 10

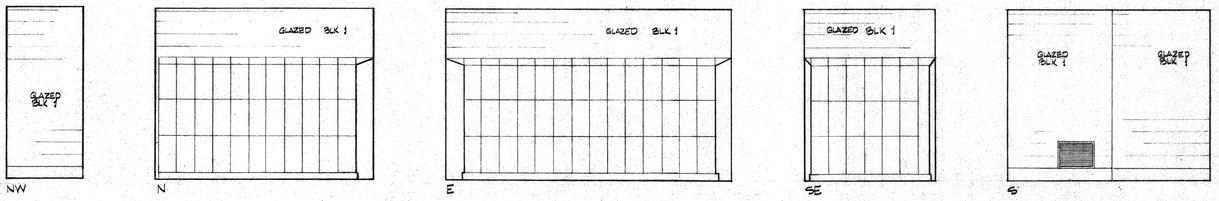

111 LOCKERS FL: CERAMIC TILE CLG: F.F. 10


112 SHOWER FL: CERAMIC TILE CLG:

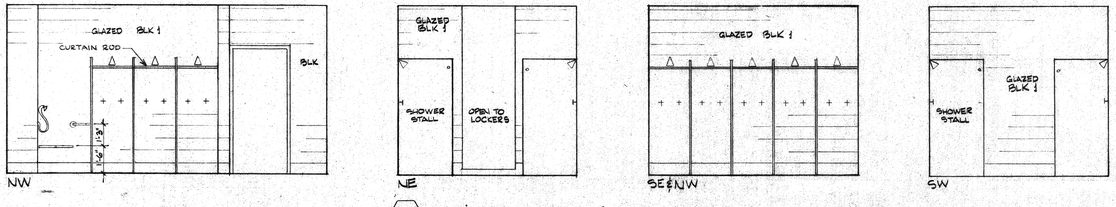

113 SHOWER FL: CERAMIC TILE CLG: F.F. 10

GIRLS' LOCKER ROOM

NOTE "R/V" INDICATES
REPLACEMENT WINDOW AS SPEC - TYPE 1 D A-101

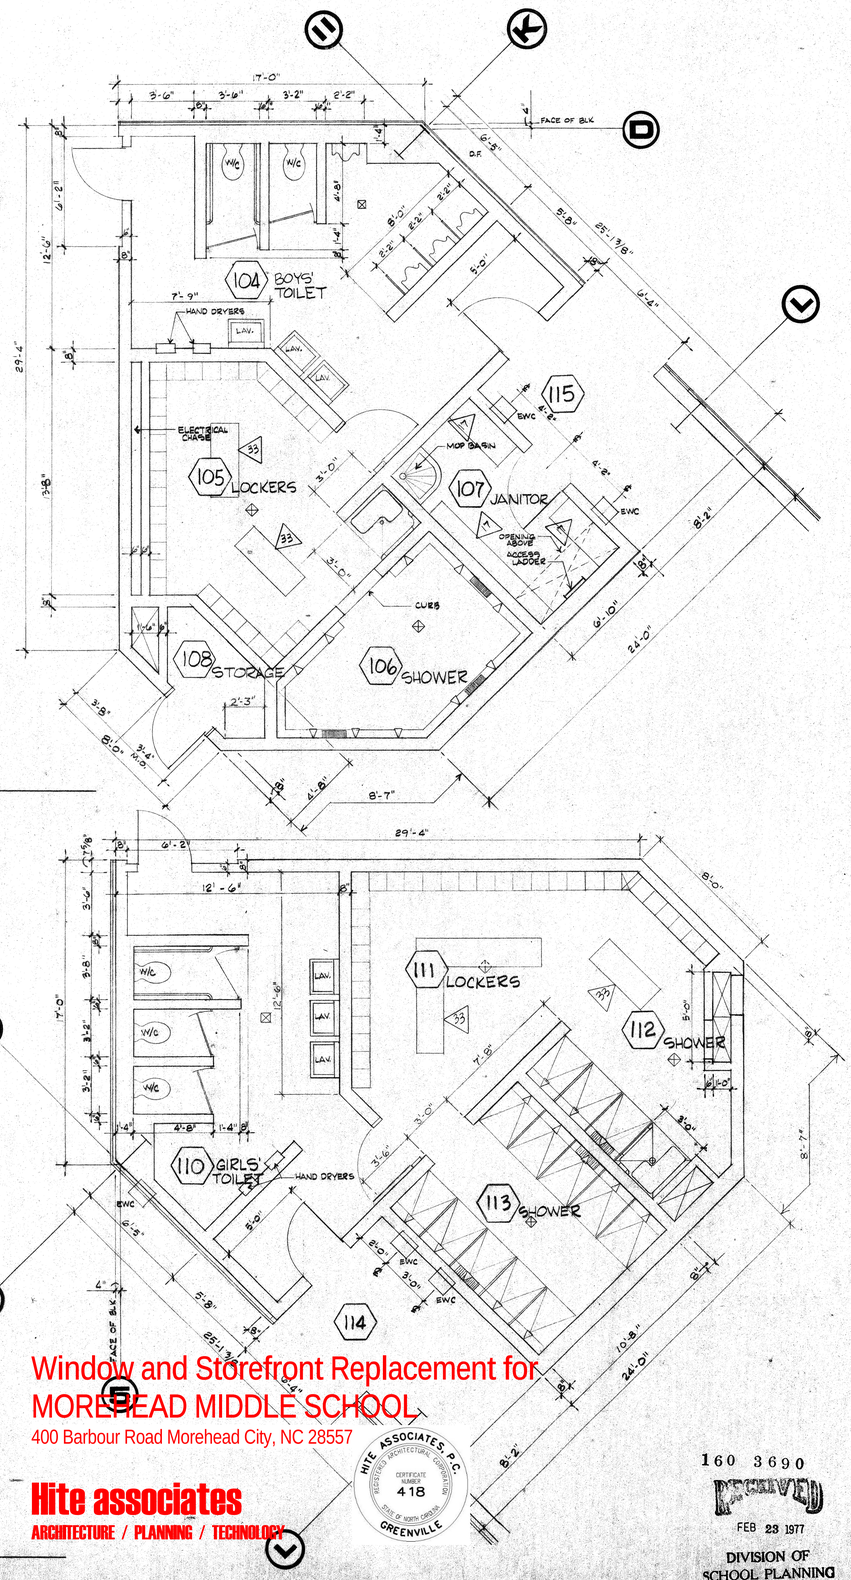

Window and Storefront Replacement for
MOREHEAD MIDDLE SCHOOL
400 Barbour Road Morehead City, NC 28557

Hite associates
ARCHITECTURE / PLANNING / TECHNOLOGY

HITE ASSOCIATES, P.C. REGISTERED ARCHITECTURAL CORPORATION CERTIFICATE NUMBER 418 STATE OF NORTH CAROLINA GREENVILLE

160 3690
RECEIVED
FEB 23 1977
DIVISION OF SCHOOL PLANNING

JAMES B. WILLIS, JR. REGISTERED ENGINEER 1409 MOREHEAD CITY, N. C.


james b willis jr / architect
401 S 13TH STREET NUMBER ONE BOGUE SOUND PO BOX 808
MOREHEAD CITY NORTH CAROLINA 28557 919-726-7091

DRAWN BY CB CHECKED BY JW DATE 12/21/76 PROJECT DESIGNER BF

LOCKER ROOMS
PLANS 1/4" INTERIOR ELEVATIONS 1/4"
DETAILS


JOB 75-2

SHEET NO.
17
OF 23

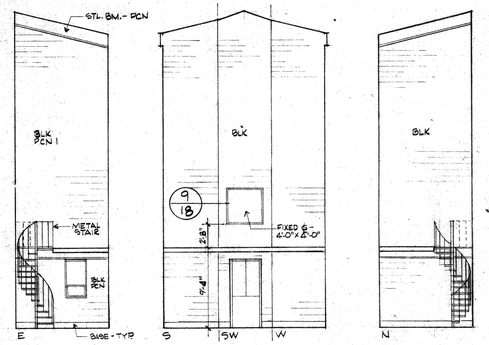



103 A STUDENT STORE & FL: CLG:


103 B STORAGE FL: CONC. CLG: EXPOSED ROOF CONSTR.

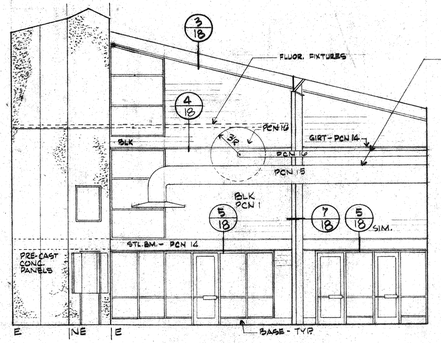

103 COMMONS FL: CLG: TERRAZZO, CARPET, CONC. W/REF 11 (SEE PLAN) EXPOSED ROOF CONSTR.

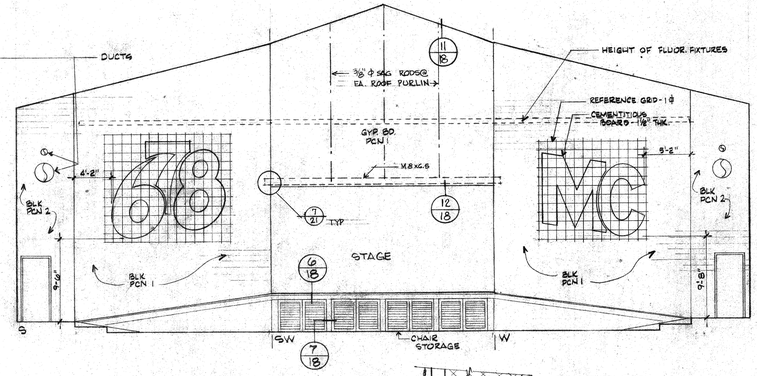


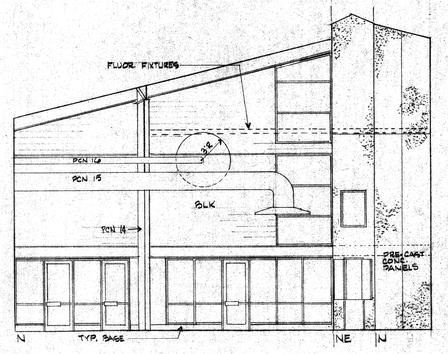

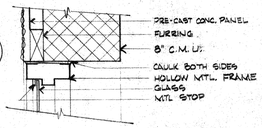

9


NOTE:
1. FILL WALL SOLID WITH CONC. AT VERT. REINF. FROM LINTEL BM. TO ROOF BM. CONC. TO BE 3000 PSI W/MAX. AGGREGATE SIZE: 3/8". SLOT 09 GIRT FOR REINF. TO PASS. WELD REINF. TO TOP FLG. OF W16 LINTEL.
2. CONNECT W16 TO COL. 110 SIM. TO

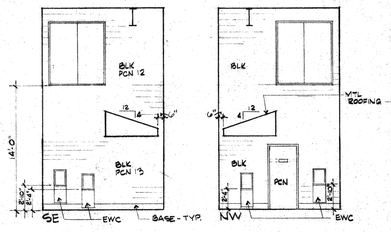



114 FL:
NOTE: OTHER ELEVATIONS INCLUDED W/GYMNASIUM ELEVATIONS.


115 FL:
NOTE: OTHER ELEVATIONS INCLUDED W/GYMNASIUM ELEVATIONS.

117 GYMNASIUM FL: COMPOSITION WOOD F.F.9 CLG: EXPOSED ROOF CONSTR.

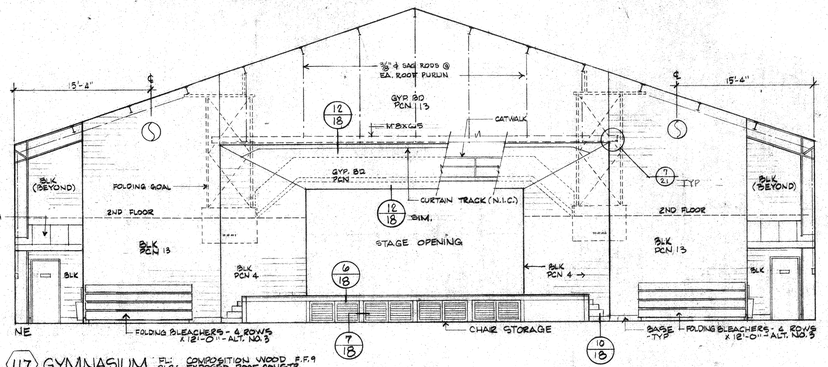


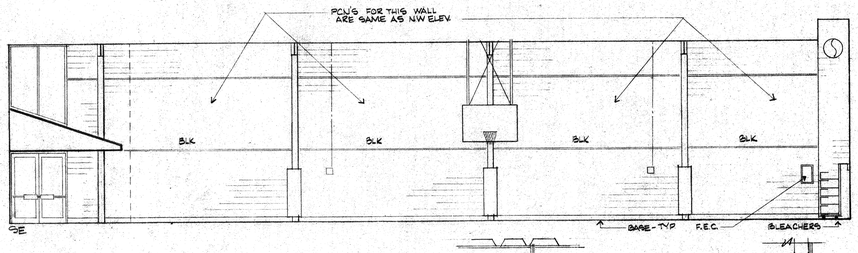

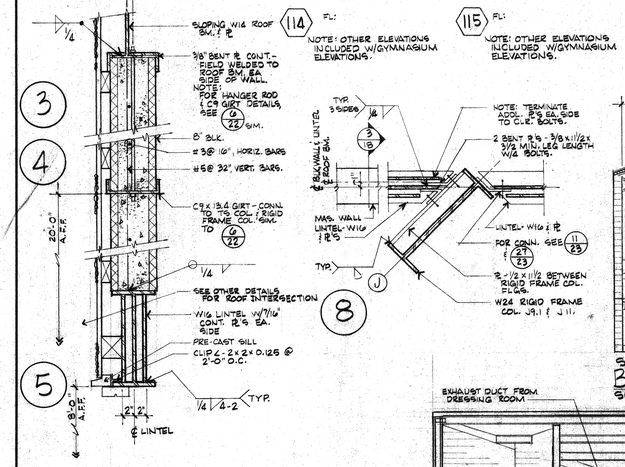


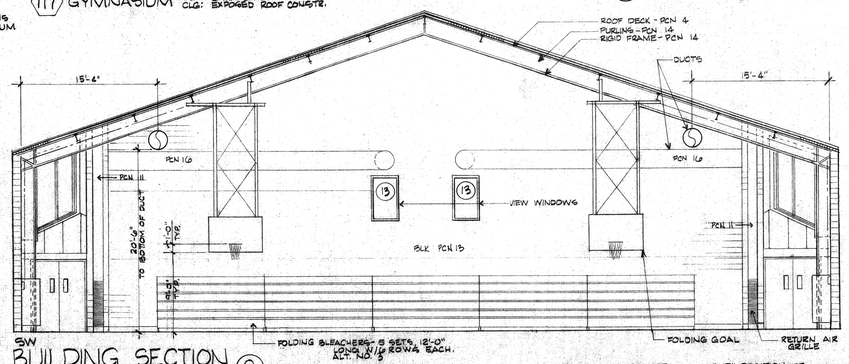


BUILDING SECTION 2
SCALE - ⅛" : 1'-0"

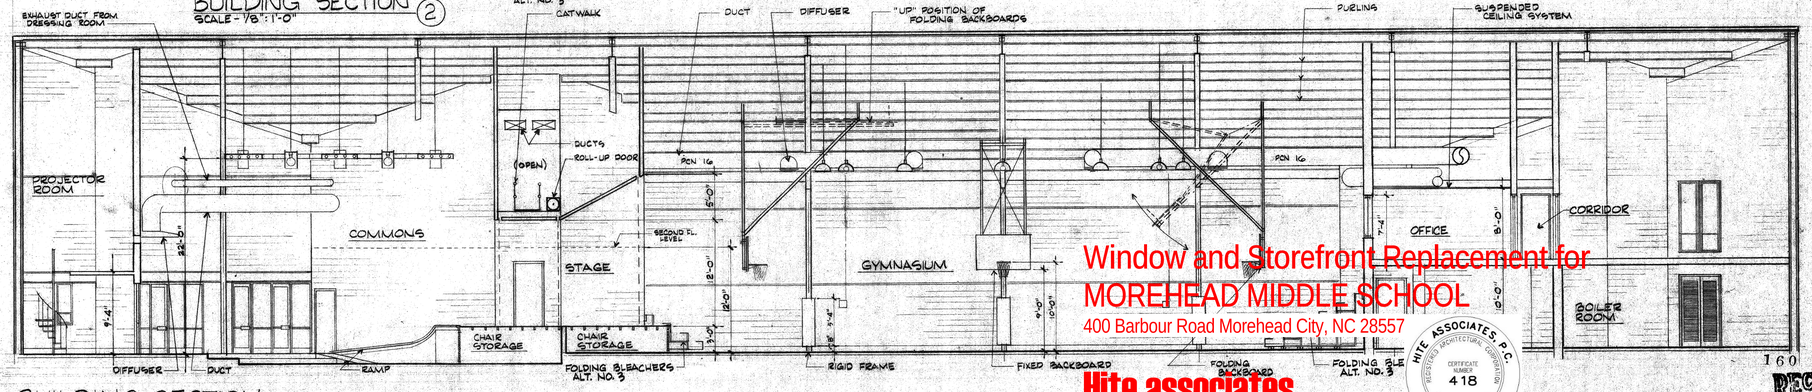


BUILDING SECTION 1
SCALE - ⅛" : 1'-0"

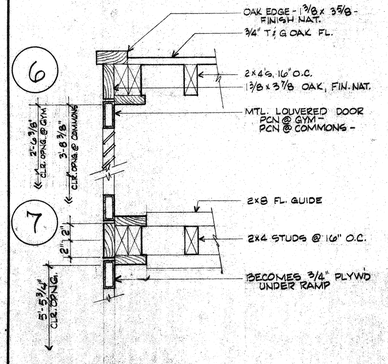


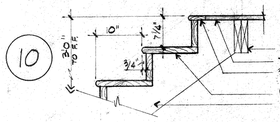

10 11

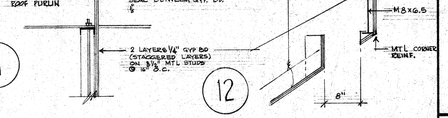

12

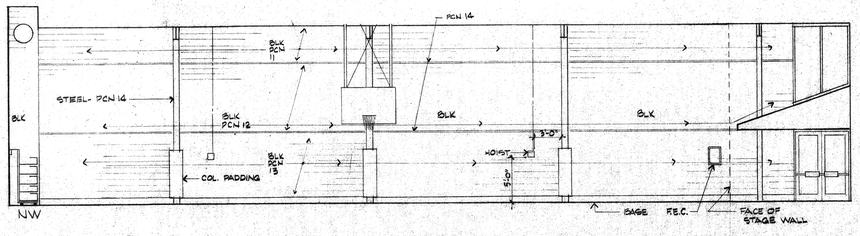

Window and Storefront Replacement for
MOREHEAD MIDDLE SCHOOL
400 Barbour Road Morehead City, NC 28557

Hite associates
ARCHITECTURE / PLANNING / TECHNOLOGY

HITE ASSOCIATES, P.A. REGISTERED ARCHITECTURAL CORPORATION CERTIFICATE NUMBER 418 STATE OF NORTH CAROLINA GREENVILLE


160 3690
RECEIVED
FEB 23 1977
DIVISION OF SCHOOL PLANNING

James B. Willis Jr. REGISTERED ARCHITECT 1409 SOUTH CAROLINA
Morehead City, N.C.

james b willis jr / architect
401 S 13TH STREET NUMBER ONE BOGUE SOUND PO BOX 808
MOREHEAD CITY NORTH CAROLINA 28557 919-726-7091


DRAWN BY BF CHECKED BY JJW DATE 12/21/76 PROJECT DESIGNER

GYMNASIUM SECTIONS DETAILS
JOB 75-2
SHEET NO. 18 OF 23

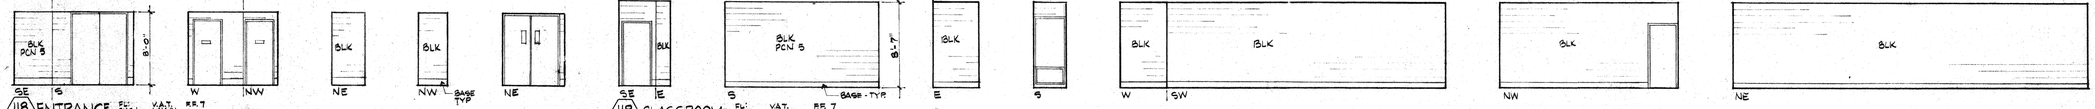

118 ENTRANCE FLR CLG: VAT LAY-IN FF 7


119 CLASSROOM FLR CLG: VAT LAY-IN FF 7

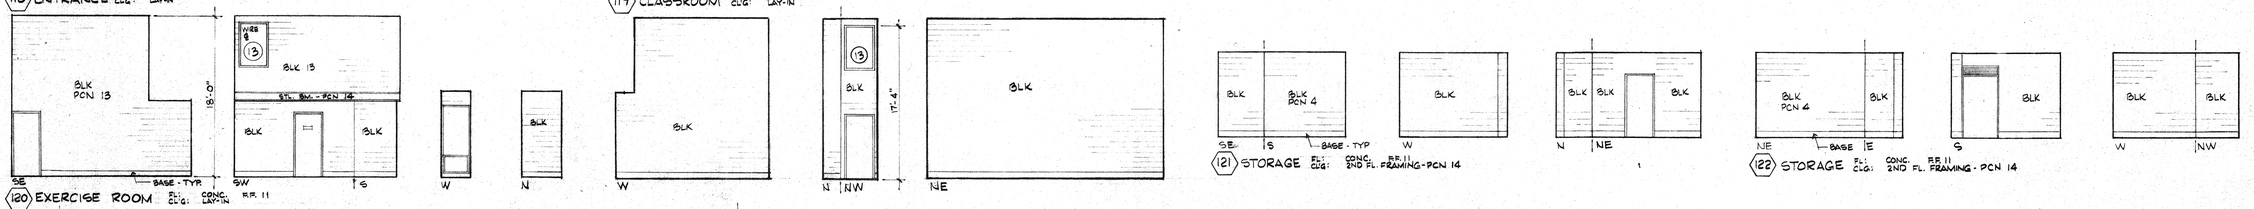

120 EXERCISE ROOM FLR CLG: CONC LAY-IN FF 11


121 STORAGE FLR CLG: CONC. 2ND FL. FRAMING - PCN 14 FF 11

122 STORAGE FLR CLG: CONC. 2ND FL. FRAMING - PCN 14 FF 11

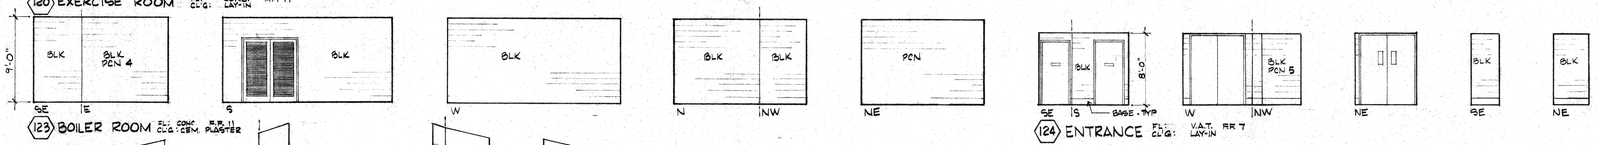


123 BOILER ROOM FLR CLG: CONC. CEM. PLASTER FF 11

124 ENTRANCE FLR CLG: VAT LAY-IN FF 7

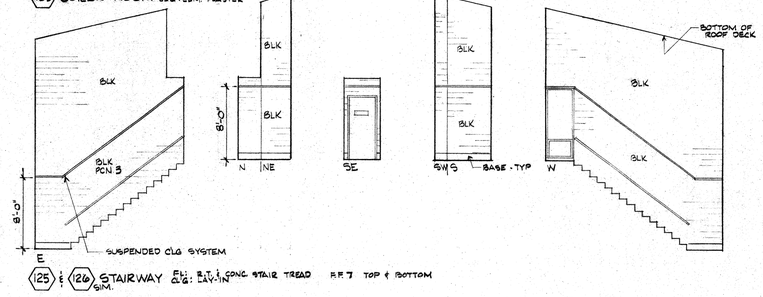


125 & 126 SIM. STAIRWAY FLR CLG: VAT LAY-IN CONC. STAIR TREAD FF 7 TOP & BOTTOM

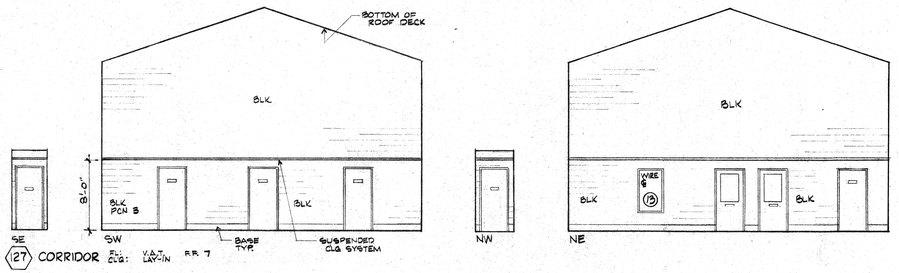

127 CORRIDOR FLR CLG: VAT LAY-IN FF 7


128 MECHANICAL ROOM FLR CLG: CONC. LAY-IN FF 11

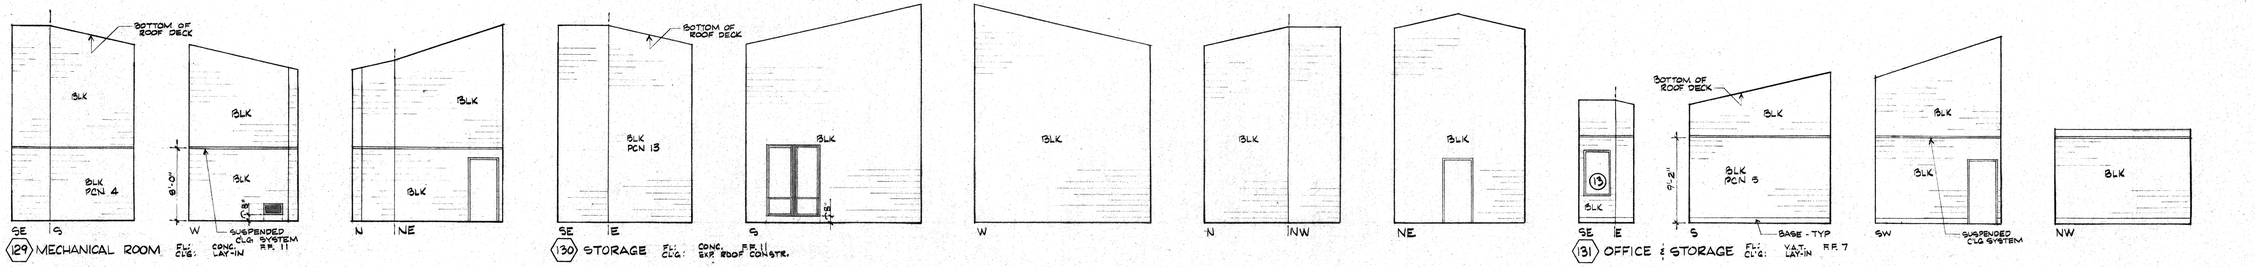

129 MECHANICAL ROOM FLR CLG:


130 STORAGE FLR CLG: CONC. EXP. ROOF CONSTR. FF 11

131 OFFICE & STORAGE FLR CLG: VAT LAY-IN FF 7

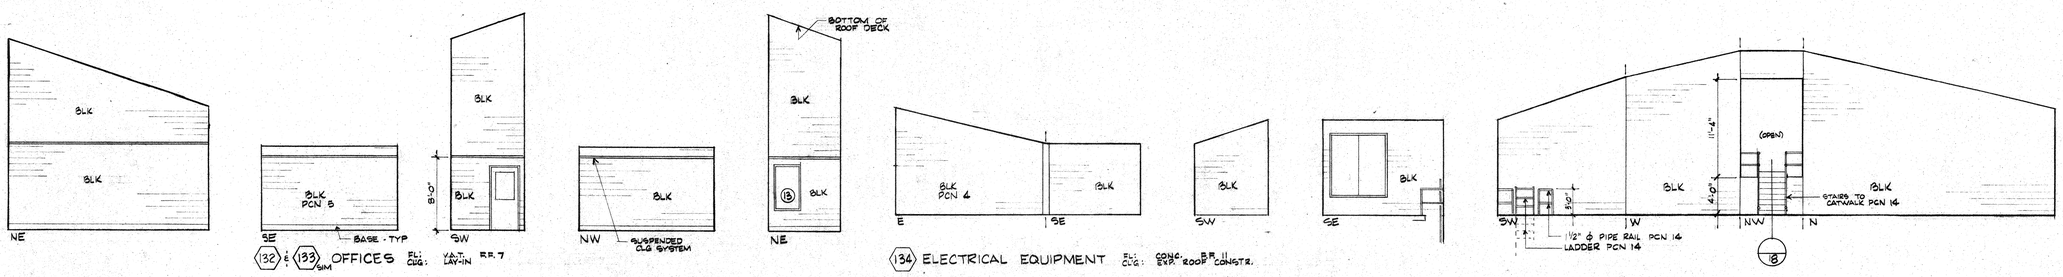

132 & 133 SIM. OFFICES FLR CLG: VAT LAY-IN FF 7

134 ELECTRICAL EQUIPMENT FLR CLG: CONC. EXP. ROOF CONSTR. FF 11

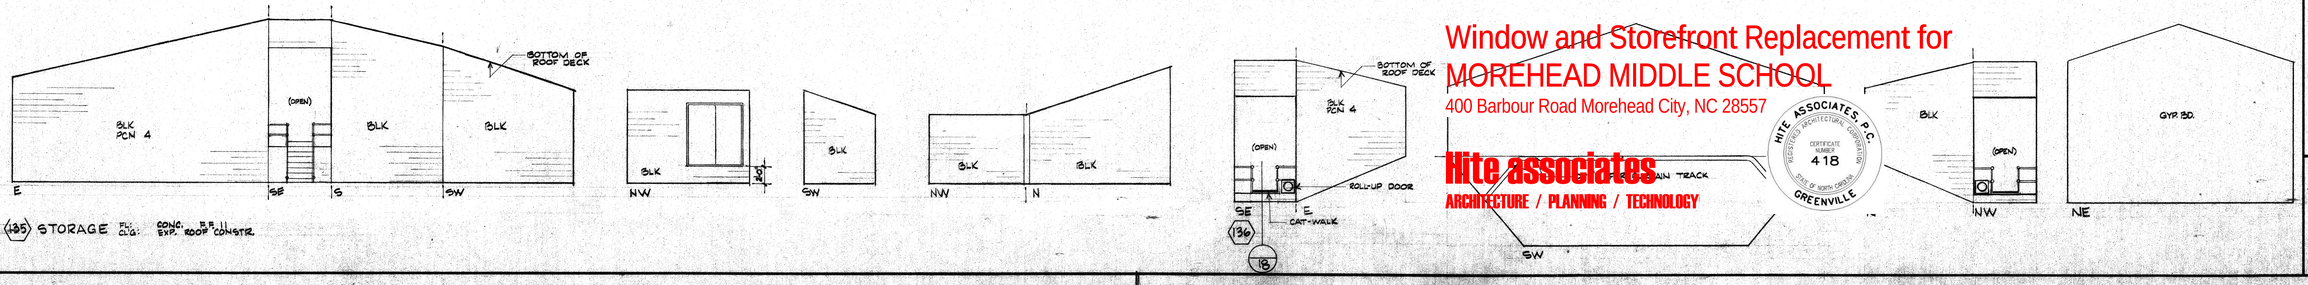

135 STORAGE FLR CLG: CONC. EXP. ROOF CONSTR. FF 11

136

160 3690
RECEIVED
FEB 23 1977
DIVISION OF SCHOOL PLANNING

Window and Storefront Replacement for
MOREHEAD MIDDLE SCHOOL
400 Barbour Road Morehead City, NC 28557

Hite associates
ARCHITECTURE / PLANNING / TECHNOLOGY

HITE ASSOCIATES, P.A. REGISTERED ARCHITECTURAL CORPORATION CERTIFICATE NUMBER 418 STATE OF NORTH CAROLINA GREENVILLE

JAMES B. WILLIS JR. 1409 North Carolina Morehead City, N.C.

james b willis jr / architect
401 S 13TH STREET NUMBER ONE BOGUE SOUND PO BOX 808
MOREHEAD CITY NORTH CAROLINA 28557 919-726-7091

DRAWN BY BF CHECKED BY JW DATE 12/21/76 PROJECT DESIGNER


GYMNASIUM & COMMONS
INTERIOR ELEVATIONS 1/8

JOB 75-2


SHEET NO. 19 OF 23

FOOTING SCHEDULE


MARK	A	B	C	D	E	
SIZE	2'-8"x2'-8"	3'-0"x3'-0"	6'-8"x6'-8"	4'-0"x4'-0"		
DEPTH	12"	12"	16"	12"		
REINF. E.W.	3-#4	4-#4	8-#6	5-#4		
ELEV. @ TOP OF FTG.	TYP. 15'-10"	TYP. 15'-10"	TYP. 15'-10" (J-10.1) 13'-10" (J-9.1) 14'-6"	TYP. 15'-10"		

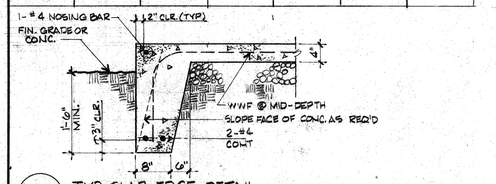

1 TYP. SLAB EDGE DETAIL

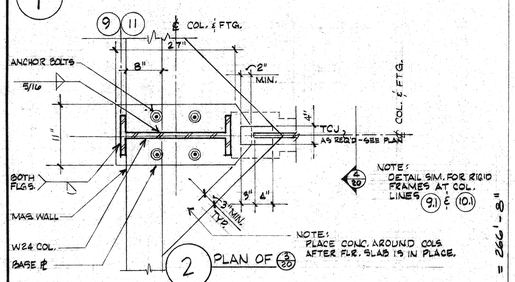

2 PLAN OF (3/20)

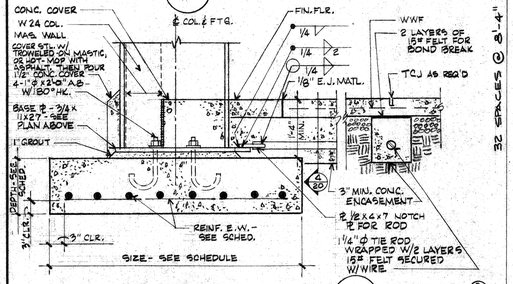


ELEVATION

4 SECTION OF (3/20)


NOTE: PROVIDE TURNBUCKLES FOR TIGHTENING TIE ROD. TURNBUCKLE TO DEVELOP FULL STRENGTH OF TIE ROD.

3 TYP. RIGID FRAME BASE DETAIL

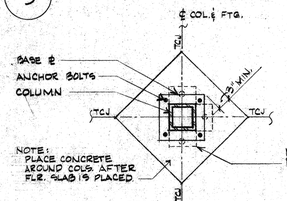


TS COL. BASE PL SCHEDULE	
COL.	BASE PL
TS 4 x 4	3/4 x 10 x 4
TS 6 x 6	3/4 x 12 x 12
TS 8 x 8	3/4 x 16 x 14

5 PLAN OF (5/20)

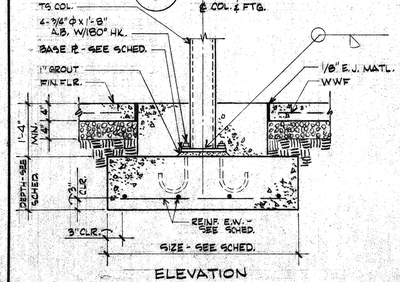

ELEVATION

6 TYP. TS COL. BASE DETAIL

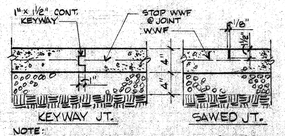

NOTE:
1. TYPE OF JOINT IS OPTIONAL WITH CONTRACTOR. SAWED JOINT SHALL BE MADE WITHIN 24 HOURS AFTER PLACING CONCRETE.
2. WHEN KEYWAY JOINT IS SELECTED THE SLAB SHALL BE PLACED IN A CHECKERBOARD PATTERN.
3. AT THE CONTRACTOR'S OPTION, A METAL PRE-FORMED JOINT OF APPROVED DESIGN WILL BE ACCEPTABLE AT EACH TCJ IN LIEU OF THE ABOVE JOINT TYPES.
4. WHERE SAWED JOINT WILL BE LEFT PERMANENTLY EXPOSED TO VIEW, FILL THE JOINT FLUSH WITH "GARDOX" FLEXIBLE JOINT SEALING COMPOUND MANUFACTURED BY W.R. MEADOWS, INC., OR EQUIVALENT.

7 TYP. CONTROL JOINT (TCJ) AT SLAB-ON-GRADE

FOUNDATION PLAN NOTES

1. SEE DETAILS FOR TOP OF COL.'S WALL FTG. BELOW FIN. FLR.
2. SEE ARCH. DWGS. FOR LOCATION OF FLOOR FINISHES REQUIRING DEPRESSED FLOOR SLABS AND FOR LOCATION OF MASONRY PARTITIONS ON THICKENED SLABS.
3. SEE ARCH. DWGS. FOR LOCATION OF MASONRY WALLS NOT DIMENSIONED.
4. ALL SLABS SHALL BE 4" THICKNESS U.O.N.
5. ALL SLABS SHALL BE PLACED OVER VAPOR BARRIER AND 4" COMPACTED STONE AND REINFORCED W/ 6x6 - W1.4 x W1.4 WWF, U.O.N.
6. FIN. FLOOR ELEV. = 17.16, U.O.N.

NOTE: USE KEYWAY OR PREMOLDED T&G JOINT MATL AT ALL TCJ'S WHICH OCCUR AT THICKENED SLABS

8 TYP. THICKENED SLAB UNDER MASONRY PARTITIONS

9 TYP. WALL FOOTING REINF.

10 TYP. STEPPED FOOTING DETAIL

11 TYP. THICKENED SLAB @ TERRAZZO & CERAMIC TILE JOINTS

Window and Storefront Replacement for
MOREHEAD MIDDLE SCHOOL
400 Barbour Road Morehead City, NC 28557

Hite associates
ARCHITECTURE / PLANNING / TECHNOLOGY
HITE ASSOCIATES, P.C. ARCHITECTURAL CORPORATION CERTIFICATE NUMBER C-418 STATE OF NORTH CAROLINA GREENVILLE

160 3690
RECEIVED
FEB 23 1977
DIVISION OF SCHOOL PLANNING


James B. Willis, Jr. / architect
401 S. 13TH STREET NUMBER ONE BOGUE SOUND PO BOX 808
MOREHEAD CITY NORTH CAROLINA 28557 919-726-7091

DRAWN BY BF JR. CHECKED BY J.W. DATE 12/21/76 PROJECT DESIGNER


FOUNDATION PLAN 1/16"
DETAILS 3/4"
FOOTING SCHEDULE

JOB 75-2

SHEET NO. 20 OF 23

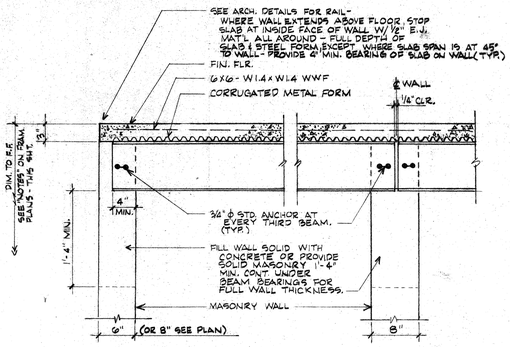

1 TYP. FLOOR BEAM BEARING DETAIL @ MASONRY WALLS

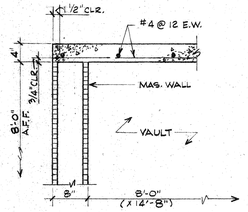

2 TYP. VAULT ROOF SLAB REINF.

GENERAL NOTES

A. FOUNDATIONS
1. MAXIMUM ALLOWABLE SOIL PRESSURE = 1000 PSF (WALL FOOTINGS) AND 1500 PSF (COLUMN FOOTINGS)
2. PLACE CONCRETE FOR WALL FOOTINGS MONOLITHICALLY WITH COLUMN FOOTINGS. CONSTRUCTION JOINTS IN WALL FOOTINGS SHALL BE MADE ONLY MIDWAY BETWEEN COLUMN FOOTINGS AND AT LEAST TWO FEET FROM THE INTERSECTION WITH ANOTHER WALL FOOTING.
3. ALL VERTICAL SURFACES FOR GRADE BEAMS, SLABS, FOOTINGS AND OTHER CONCRETE MEMBERS IN CONTACT WITH EARTH SHALL BE FORMED WITH WOOD OR METAL FORMING MATERIALS TO THE DIMENSIONS AS SHOWN ON THE DRAWINGS.

B. CONCRETE
1. CONCRETE WORK SHALL CONFORM TO "BUILDING CODE REQUIREMENTS FOR REINFORCED CONCRETE," ACI 318-71, INCLUDING SUPPLEMENTS.
2. PLACE ½" EXPANSION JOINT MATERIAL BETWEEN EDGES OF SLABS AND VERTICAL SURFACES UNLESS OTHERWISE NOTED. AT SLABS OVER JOISTS THE JOINT MATERIAL SHALL BE THE FULL DEPTH OF THE SLAB AND METAL FORMS.
3. CHAMFER EXPOSED EDGES OF CONCRETE ¾" UNLESS OTHERWISE NOTED.

C. REINFORCING STEEL
1. WELDED WIRE FABRIC SHALL CONFORM TO ASTM A 185.
2. REINFORCING STEEL TO BE PLACED SHALL BE REVIEWED BY THE ARCHITECT PRIOR TO PLACING CONCRETE.
3. PROVIDE BARS AT CORNERS AND INTERSECTIONS OF THE SAME NUMBER AND SIZE AS LONGITUDINAL BARS IN FOOTINGS, GRADE BEAMS AND WALLS.
4. PLACE 6'X6' - W1.4 x W1.4 WELDED WIRE FABRIC AT CENTER OF SLABS-ON-GRADE UNLESS OTHERWISE NOTED.
5. EMBED ALL CONTINUOUS BARS IN FOOTINGS AND GRADE BEAMS TO LONGEST PRACTICABLE LENGTH.

D. STRUCTURAL STEEL
1. ANCHOR BOLT LENGTHS SHOWN ON THE DRAWINGS SHALL INCLUDE HOOKS OF NOT LESS THAN 3" IN LENGTH. PROVIDE ONE NUT AND ONE WASHER WITH EACH ANCHOR BOLT UNLESS OTHERWISE NOTED.

E. STEEL ROOF DECK
1. "B" STEEL DECK OVER THE GYMNASIUM WING SHALL BE 1½" IN DEPTH, 22 GAUGE, WIDE RIB, ZINC COATED, ADJUSTED, AS MANUFACTURED BY INLAND - RYERSON CONSTRUCTION PRODUCTS COMPANY, OR EQUIVALENT WITH A NOISE REDUCTION FACTOR OF 0.70 OR BETTER.
2. ALL OTHER STEEL DECK SHALL BE 1½" IN DEPTH, 20 GAUGE, WIDE RIB, AND SHALL BE ZINC COATED.

F. CORRUGATED STEEL FORMS
1. USE 28 GAUGE, CORRUGATED STEEL FORMS, GALVANIZED, WITH NOMINAL 9/16" CORRUGATION PATTERN AT SECOND FLOOR AREAS OVER JOISTS.
2. FURNISH A MINIMUM OF 25 WELDING WASHERS PER 100 SQUARE FEET OF FORMS AND ATTACH SHEETS BY PUDDLE WELDING THE SHEETS AS FOLLOWS:
   A. END LAPS - WELD IN VALLEY OF SIDE LAPS AND MIDDLE OF SHEET (MIN. OF THREE WELDS AT EACH END OF SHEET).
   B. INTERMEDIATE SUPPORTS - WELD IN VALLEY OF SIDE LAPS ON EVERY OTHER JOIST AND IN THE VALLEY OF THE CENTER CORRUGATION ON THE REMAINING JOISTS (X-PATTERN).
3. TO PREVENT THE LEAKAGE OF CONCRETE AT SIDE LAPS, PLACE CONCRETE IN THE OPPOSITE DIRECTION TO WHICH THE SHEETS WERE ERECTED SO THAT TOP SHEET RECEIVES WEIGHT OF CONCRETE FIRST.

G. DESIGN LIVE LOADS
STRUCTURAL MEMBERS ARE DESIGNED FOR FULL DEAD LOADS AND THE FOLLOWING LIVE LOADS:
1. ROOF 20 PSF
2. WIND 40 PSF
3. MECHANICAL EQUIPMENT ROOMS 150 PSF

I. CONSTRUCTION SAFETY
THESE DRAWINGS DO NOT CONTAIN NECESSARY COMPONENTS FOR SAFETY DURING CONSTRUCTION.

LINTEL SCHEDULE


OPENING	LINTEL		BEARING
0'-0" TO 1'-4"	1 ℄ - 3/8 x 3½	*	8"
1'-4" TO 4'-0"	1 L - 3½ x 3½ x 5/16	*	8"
4'-0" TO 6'-8"	1 L - 4 x 3½ x 5/16	*	8"
6'-8" TO 8'-0"	1 L - 5 x 3½ x 5/16	*	8"

* PER 4" OF WALL THICKNESS

NOTE:
ALL UNSCHEDULED OPENINGS INCLUDING OPENINGS FOR MECHANICAL WORK SHALL BE PROVIDED WITH LINTELS IN ACCORDANCE WITH THIS SCHEDULE, USE THE FOLLOWING N.C. CONCRETE MASONRY ASSOCIATION STYLES OF LINTEL BLOCK: NCCMA - #4SB16-59, #6SB16-59, #12SB16-59.


OPENING	5⅝" OR 7⅝" WALL	11⅝" WALL	BEARING
2'-0" TO 4'-0"	2-#3, 2-#3	2-#3, 2-#3	8"
4'-0" - 5'-4"	2-#4, 2-#5	2-#4, 3-#4	8"
5'-4" TO 8'-0"	2-#5, 2-#6	2-#5, 3-#5	16"

REQUIRED LINTELS NOT OTHERWISE INDICATED ON THE DRAWINGS SHALL BE AS SHOWN IN THE ABOVE SCHEDULE.

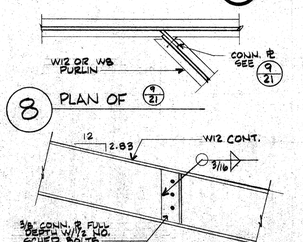


8 PLAN OF 9/21

9 TYP. SKEWED CONN. DETAIL

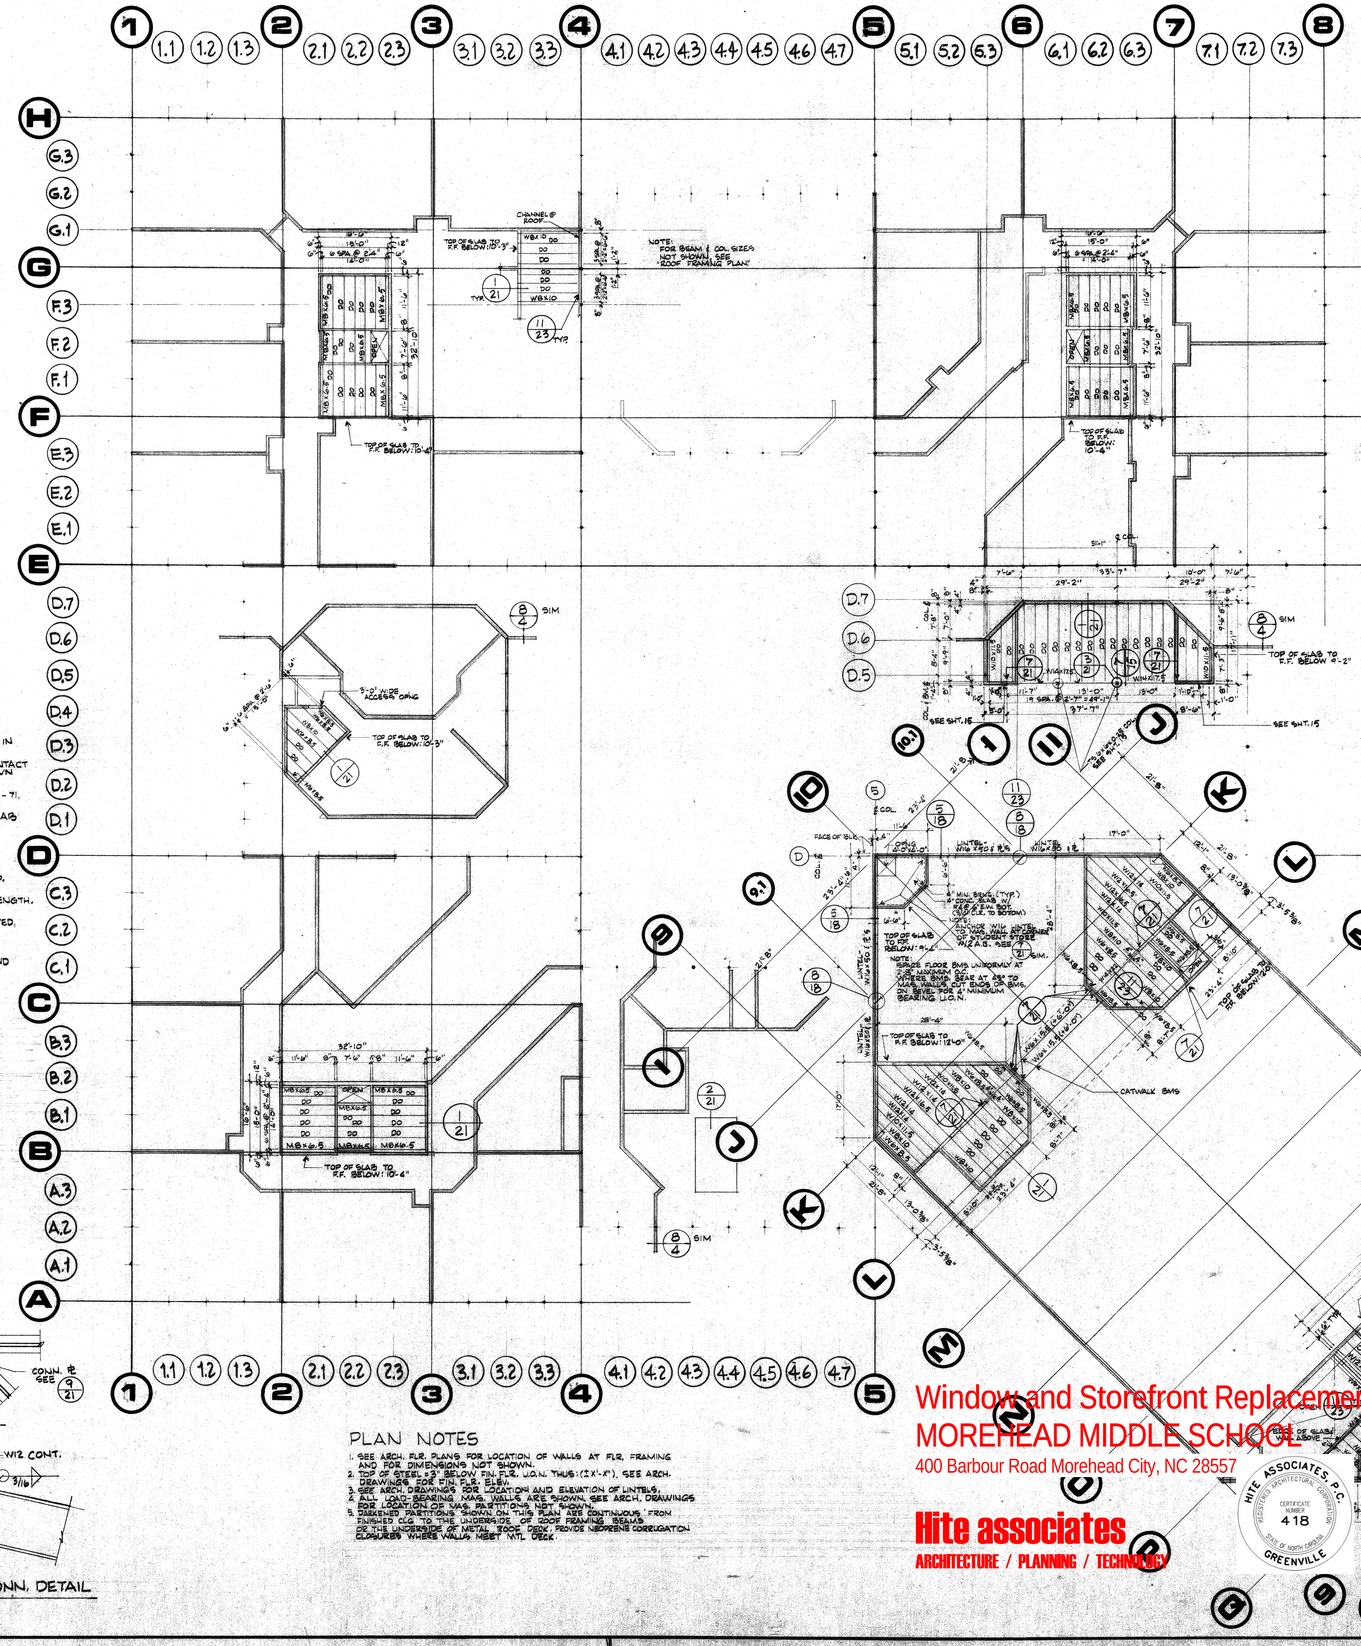


PLAN NOTES


1. SEE ARCH. FLR. PLANS FOR LOCATION OF WALLS AT FLR. FRAMING AND FOR DIMENSIONS NOT SHOWN.
2. TOP OF STEEL = 3" BELOW FIN. FLR. U.O.N. THUS: (3"-4"), SEE ARCH. DRAWINGS FOR FIN. FLR. ELEV.
3. SEE ARCH. DRAWINGS FOR LOCATION AND ELEVATION OF LINTELS.
4. ALL LOAD BEARING MAS. WALLS ARE SHOWN, SEE ARCH. DRAWINGS FOR LOCATION OF MAS. PARTITIONS NOT SHOWN.
5. DARKENED PARTITIONS SHOWN ON THIS PLAN ARE CONTINUOUS FROM FINISHED FLR. TO THE UNDERSIDE OF ROOF FRAMING BEAMS OR THE UNDERSIDE OF METAL ROOF DECK. PROVIDE NEOPRENE CORRUGATION CLOSURES WHERE WALLS MEET MTL. DECK

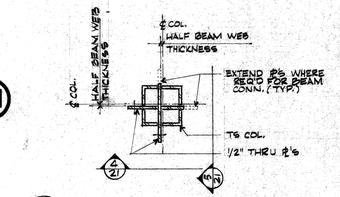


3 TYPICAL BEAM TO TS COL. CONN. @ FLOORS

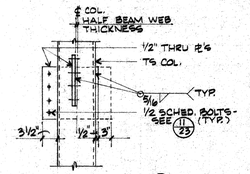


4 ELEVATION OF 5/21

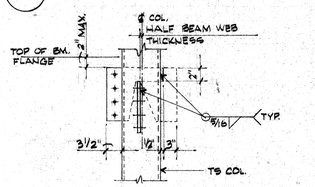

5 ELEVATION OF 3/21

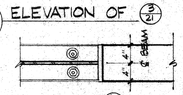

6 PLAN OF 7/21

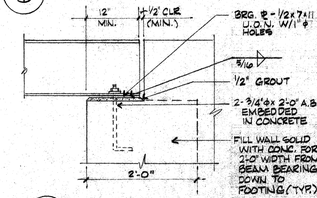

7 TYP. BEAM BEARING DETAIL @ WALLS

Window and Storefront Replacement for
MOREHEAD MIDDLE SCHOOL
400 Barbour Road Morehead City, NC 28557

Hite associates
ARCHITECTURE / PLANNING / TECHNOLOGY

HITE ASSOCIATES, P.C. REGISTERED ARCHITECTURE CORPORATION CERTIFICATE NUMBER 418 STATE OF NORTH CAROLINA GREENVILLE

160 3690
RECEIVED
FEB 23 1977
DIVISION OF SCHOOL PLANNING

JAMES B. WILLIS JR. REGISTERED ARCHITECT NO. 3690 NORTH CAROLINA

james b willis jr / architect
401 S 13TH STREET NUMBER ONE BOGUE SOUND PO BOX 808
MOREHEAD CITY NORTH CAROLINA 28557 919-726-7091

DRAWN BY BF JR CHECKED BY JW DATE 12/21/76 PROJECT DESIGNER

2ND FLOOR FRAMING PLAN DETAILS & LINTEL SCHEDULE

1/16"

JOB 75-2

SHEET NO. 21 OF 23

1 TYP. RIGID FRAME BEAM SPLICE

2 TYP. VERTICAL BRACE DETAILS (TYP.)

3 DETAIL A

4 DETAIL B

5 DETAIL C

NOTE:
1. ALL TIE RODS SHALL HAVE ADEQUATE TURNBUCKLES, PLATES & CLEVISES TO DEVELOP THE STRENGTH OF THE RODS.
2. VERTICAL BRACE LOCATIONS DENOTED ON PLAN THUS ⑤ TYP.
3. CONN. RODS TO RIGID FRAME COL. WEB AS SHOWN IN DETAIL C ABOVE.

6 TYP. SAG ROD & GIRT DETAIL AT GYM

7 GIRT TO COL. CONN.

8 TYP. RIDGE BM. TO COL. CONN. @ E.J. -(SJ-1) & (KB 3)

9 SECTION OF (8/22)

NOTE A:
NEOPRENE BEARING PADS SHALL BE 100% VIRGIN CHLOROPRENE DUROMETER GRADE 50 60 OR 70 MEETING THE REQUIREMENTS OF TABLE 3, SECTION 2.2.2 OF AASHO STANDARD SPECIFICATIONS FOR HIGHWAY BRIDGES, 1973.
CONTRACTOR TO FURNISH MANUFACTURER'S CERTIFICATION TO THE ARCHITECT FOR REVIEW.

32 SPACES @ 8'-4" = 266'-8"
8 SPACES @ 8'-4" = 66'-8"
100'-0"
33'-4"
℄ COL.
CONT. L
W12x16.5
C6x8.2
W12x19
W18x50
W18x45
W12x36
W12x31
W12x55
W12x65
W8x10
W8x40
W14x22
W10x12
W14x82
W14x2006241
W14x10344741
